INDEX TO DRAWINGS	
SHEET NO.	DESCRIPTION
1	TITLE SHEET
2	TYPICAL SECTIONS
3 - 6	PLANS
7 - 11	MISCELLANEOUS DETAILS
12	CROSS SECTION

STATE OF HAWAII
DEPARTMENT OF TRANSPORTATION
HIGHWAYS DIVISION
HONOLULU, HAWAII

"AS BUILT"
PLANS FOR

MIDDLE STREET WIDENING

LUNALILO FREEWAY TO KAMEHAMEHA HIGHWAY
PROJECT No. 65A-01-67

AND

PUULOA ROAD WIDENING

PROJECT No. 66A-01-67

DISTRICT OF HONOLULU
ISLAND OF OAHU

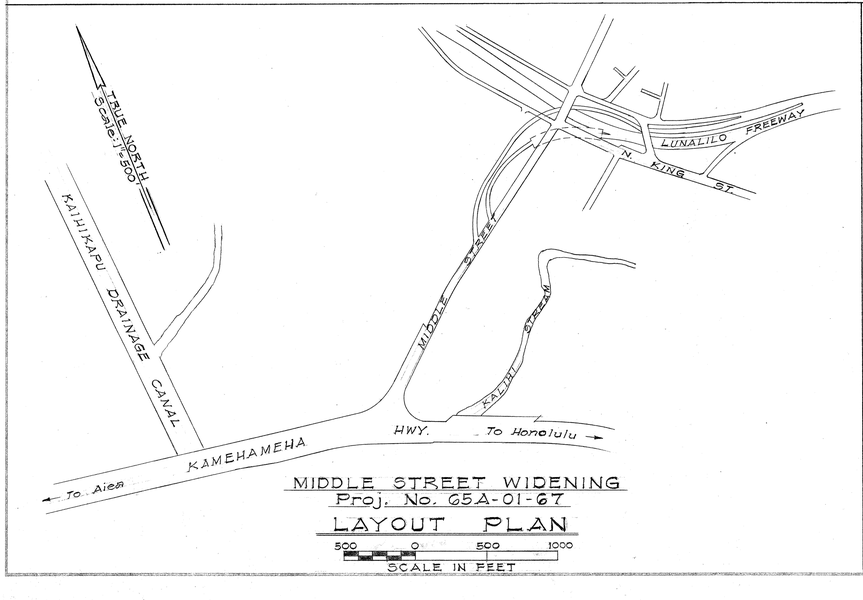

MIDDLE STREET WIDENING
Proj. No. 65A-01-67
LAYOUT PLAN
500 0 500 1000
SCALE IN FEET

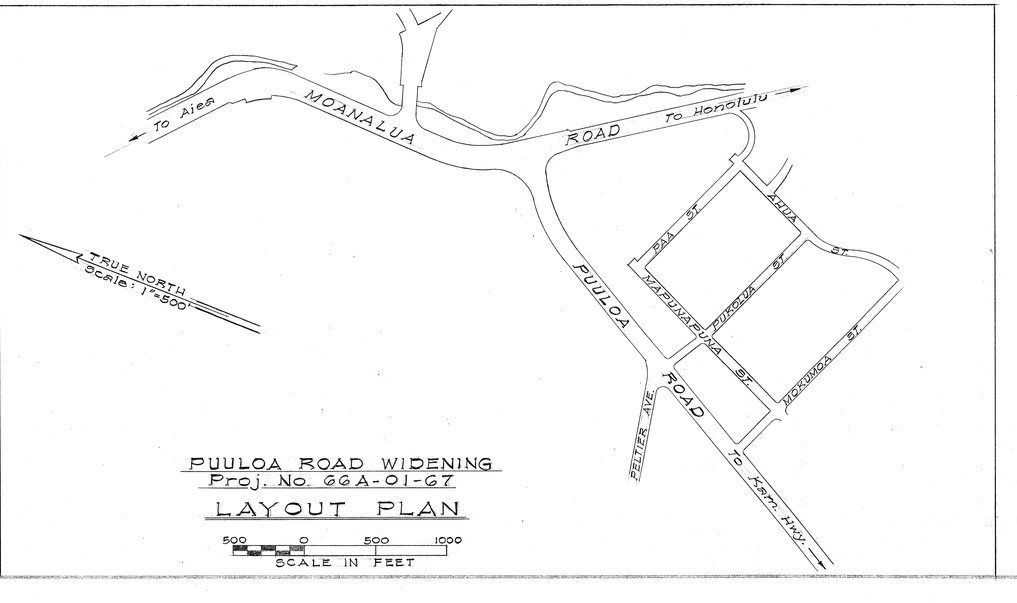

PUULOA ROAD WIDENING
Proj. No. 66A-01-67
LAYOUT PLAN
500 0 500 1000
SCALE IN FEET

NOTE: ALL CHANGES MADE DURING CONSTRUCTION HAVE BEEN NOTED IN RED ON THESE TRACINGS AND CHECKED BY:

Sterling H. Morikawa
PROJECT ENGINEER

14 September 1967
DATE

DEPARTMENT OF TRANSPORTATION
STATE OF HAWAII
APPROVED:
Luigi Contarino 15 Nov 66
DIR. OF TRANSPORTATION DATE