FED. ROAD DIST. NO.	STATE	FED. AID PROJ. NO.	FISCAL YEAR	SHEET NO.	TOTAL SHEETS
HAWAII	HAW	S-219(3)	1960	1	15

INDEX TO DRAWINGS	
SHEET NO.	DESCRIPTION
1	TITLE SHEET
2	PLAN & PROFILE
3	DETAILS
4 – 5	STANDARD DETAILS
6	STAND. BRIDGE DET.
7 – 11	BRIDGE
12	BRIDGE REPAIR DET.
13 – 15	CROSS SECTIONS

STATE OF HAWAII

DEPARTMENT OF TRANSPORTATION

DIVISION OF HIGHWAYS

"AS BUILT" PLANS OF

MOANALUA ROAD

HARRIET M. DAMON BRIDGE AND APPROACHES

FEDERAL AID SECONDARY PROJECT S-219(3)

DISTRICT OF HONOLULU

ISLAND OF OAHU

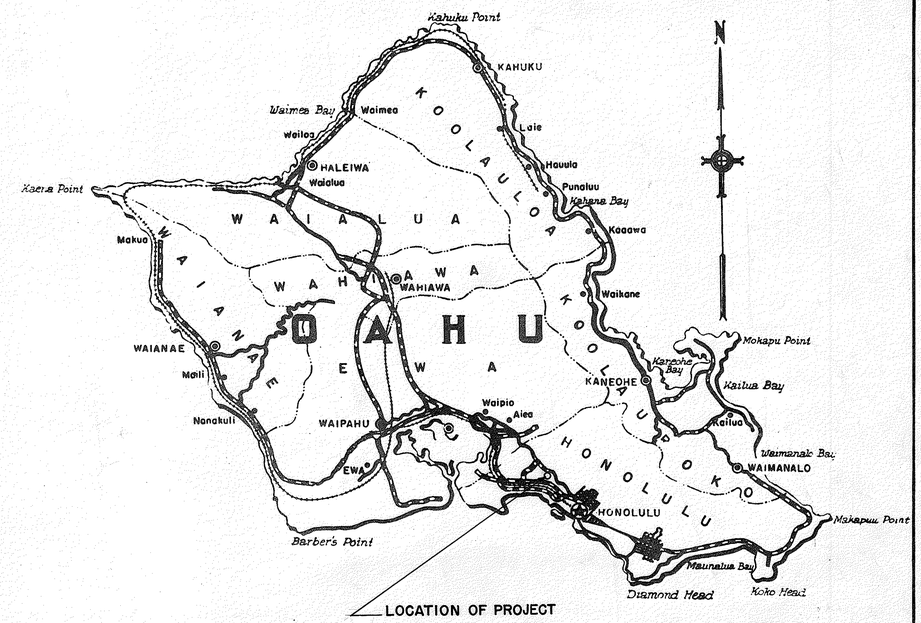

Federal Aid Projects Previously Constructed Or Under Construction

SCALES

PLAN ..... 1" = 40'

PROFILE ..... HOR. 1" = 40'
VER. 1" = 5'

CROSS SECTION ..... HOR. 1" = 10'
VER. 1" = 10'

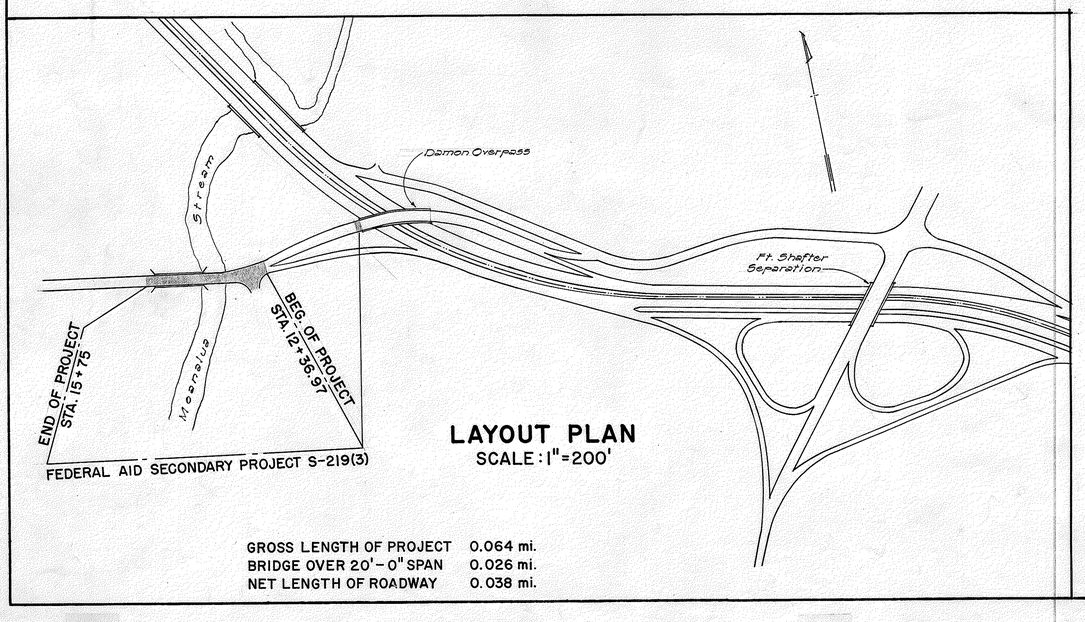

LAYOUT PLAN

SCALE: 1" = 200'

GROSS LENGTH OF PROJECT	0.064 mi.
BRIDGE OVER 20'-0" SPAN	0.026 mi.
NET LENGTH OF ROADWAY	0.038 mi.

NOTE:

ALL CHANGES MADE DURING CONSTRUCTION HAVE BEEN NOTED ON THESE TRACINGS IN RED AND CHECKED BY:

PROJECT ENGINEER

6/25/63
DATE

APPROVED: DATE 9/13/60

DIRECTOR OF TRANSPORTATION

DEPARTMENT OF COMMERCE
BUREAU OF PUBLIC ROADS

APPROVED:

DIVISION ENGINEER DATE

ORIGINAL PLAN	SURVEY PLOTTED BY	DATE
	DESIGNED BY	
	DRAWN BY	
	TRACED BY	
NOTE BOOK	QUANTITIES BY	
	QUANTITIES CHECKED BY	
No.	CHECKED BY	

S021903.1

BD-I-10