FED. ROAD DIST. NO.	STATE	FED. AID PROJ. NO.	FISCAL YEAR	SHEET NO.	TOTAL SHEETS
HAWAII	HAW.	STP-0300(32)	1994	1	21

INDEX TO DRAWINGS

SHEET NO.	DESCRIPTION
1	TITLE SHEET
2	STANDARD PLANS SUMMARY
3	GENERAL NOTES
4	LEGEND
5	TYPICAL SECTION
6	TYPICAL DETAILS
7 – 9	PLAN
10	RECONSTRUCTION GRADE PLAN & ROADWAY SECTION
11	PAVEMENT MARKING LEGEND & NOTES
12 – 14	PAVEMENT MARKING & SIGNING PLAN
15 – 17	LOOP DETECTOR PLAN
18 – 20	TRAFFIC DETAILS
① 21	MISC. TRAFFIC SUMMARIES

Plan Sht. Nos. ① C.O.2IS-1, C.O.2IS-2 and C.O.2IS-3 are supplementary sheets to this project.
TOTAL SHEET COUNT after "AS-BUILT" postings 25 Sheets.

STATE OF HAWAII

DEPARTMENT OF TRANSPORTATION

HIGHWAYS DIVISION
HONOLULU, HAWAII
"AS-BUILT"
PLANS FOR

RADFORD DRIVE AND BOUGAINVILLE DRIVE RESURFACING

KAMEHAMEHA HIGHWAY TOWARDS SALT LAKE BOULEVARD

FEDERAL AID PROJECT NO. STP-0300(32)

DISTRICT OF EWA
ISLAND OF OAHU

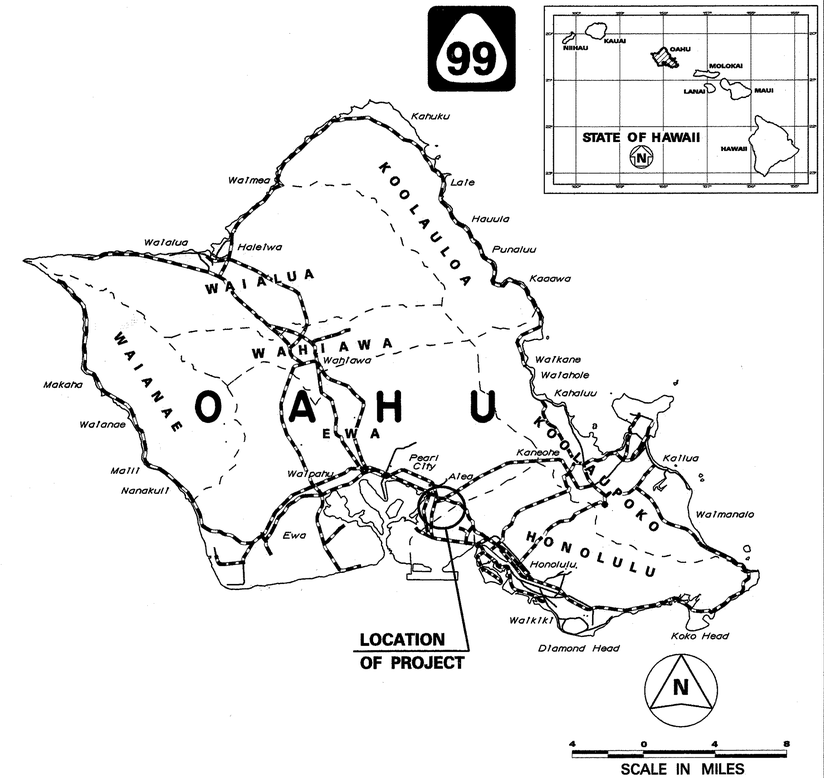

FEDERAL AID PROJECTS PREVIOUSLY CONSTRUCTED OR UNDER CONSTRUCTION

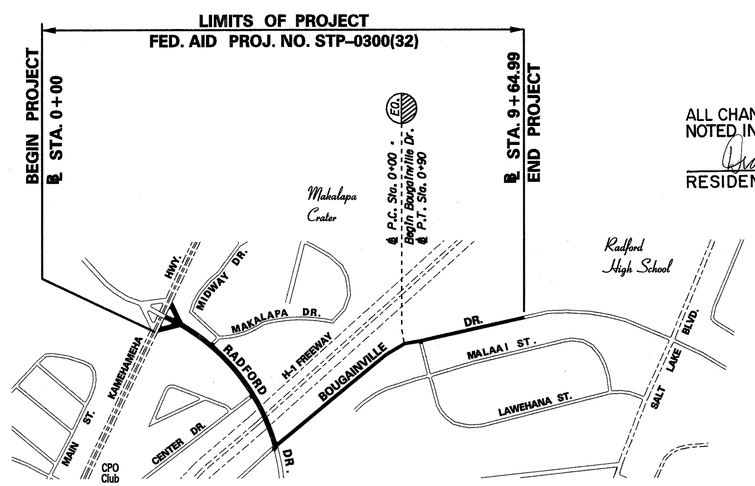

ALL CHANGES MADE DURING CONSTRUCTION HAVE BEEN NOTED IN RED ON THESE TRACINGS AND CHECKED BY.

Diane Lee 12/17/96
RESIDENT ENGINEER DATE

DESIGN DESIGNATION

	RADFORD DRIVE, KAMEHAMEHA HWY. TO BOUGAINVILLE DR.	BOUGAINVILLE DRIVE, RADFORD DR. TOWARDS SALT LAKE BLVD.
ADT (1994)	23,879	17,592
ADT (2014)	32,869	24,212
DHV	2,960	2,180
K	9.0	9.0
D	60/40	60/40
T	3.0 %	3.0 %
T_{24}	4.5 %	4.5 %

1 0 1 2 3
SCALE IN THOUSAND FEET

LAYOUT PLAN

LENGTH OF PROJECT ..... 0.50 MI.

DEPARTMENT OF TRANSPORTATION
STATE OF HAWAII
APPROVED:
for DIR. OF TRANSPORTATION 5/3/94
DATE

HWY-DD/UNIT "A" DESIGNED BY — JULIUS B. FRONDA P. S. & E. BY — 587-2246 PHONE — MAY 1994 DATE