FED. ROAD DIST. NO.	STATE	FED. AID PROJ. NO.	FISCAL YEAR	SHEET NO.	TOTAL SHEETS
HAWAII	HAW.	STP-0300(30)	1994	1	18

INDEX TO DRAWINGS

SHEET NO.	DESCRIPTION
1	TITLE SHEET
2	STANDARD PLANS SUMMARY
3	GENERAL NOTES AND LEGEND
4 – 5	TYPICAL SECTIONS & DETAILS
6	MISCELLANEOUS DETAILS
7 – 8	ROADWAY PLANS
9 – 10	GUARDRAIL DETAILS
11	PAVEMENT MARKING, LEGEND, DETAILS & NOTES
12 – 14	PAVEMENT MARKING & STRIPING PLAN
15	MISCELLANEOUS SIGN DETAILS
16	MISCELLANEOUS TRAFFIC DETAILS
17 – 18	MISCELLANEOUS TRAFFIC SUMMARIES

STATE OF HAWAII

DEPARTMENT OF TRANSPORTATION

HIGHWAYS DIVISION

HONOLULU, HAWAII

"AS-BUILT"

PLANS FOR

H–1 KAPIOLANI INTERCHANGE RAMPS AND OLD WAIALAE ROAD RESURFACING

FEDERAL AID PROJECT NO. STP–0300(30)

DISTRICT OF HONOLULU

ISLAND OF OAHU

7601

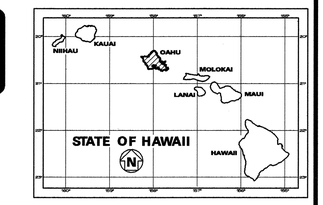

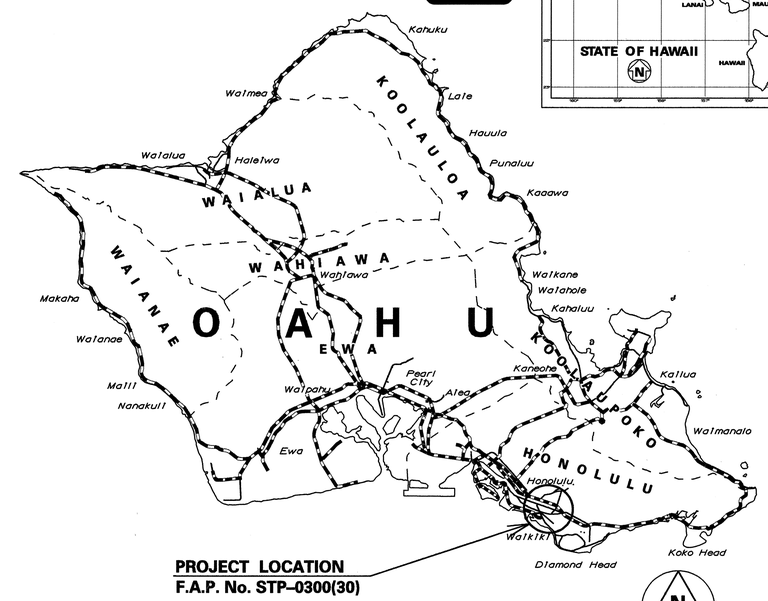

PROJECT LOCATION
F.A.P. No. STP–0300(30)

N

4 0 4 8
SCALE IN MILES

FEDERAL AID PROJECTS PREVIOUSLY CONSTRUCTED OR UNDER CONSTRUCTION

DESIGN DESIGNATION

ADT (1994) 34,000
ADT (2004) 41,500
DHV 3,650
D 75/25
T_{24} ..... 12.0 %

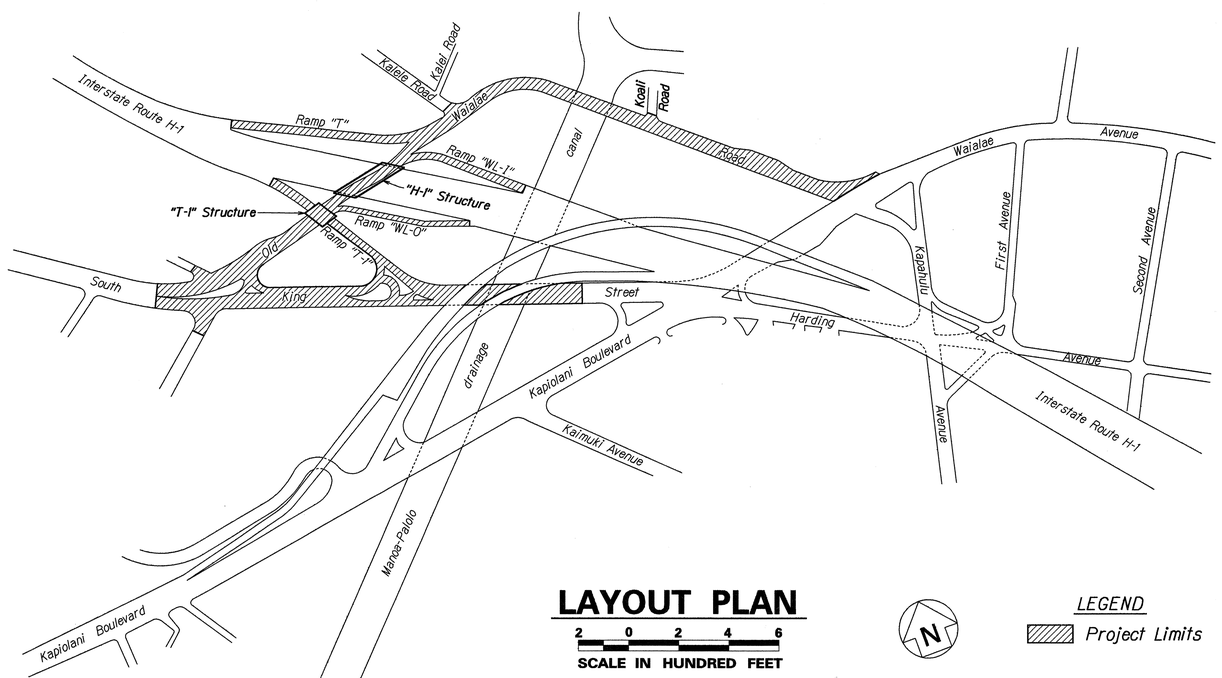

LAYOUT PLAN

2 0 2 4 6
SCALE IN HUNDRED FEET

N

LEGEND

Project Limits

CHANGES MADE DURING CONSTRUCTION HAVE BEEN INCORPORATED ON THESE PLANS EXCEPT CHANGES IN THE ORIGINAL THEORETICAL QUANTITIES. FOR ACTUAL QUANTITIES, REFER TO PROJECT LEDGER AND/OR COMPUTATION BOOK.

Robert Shin 8-12-99
RESIDENT ENGINEER DATE

DEPARTMENT OF TRANSPORTATION
STATE OF HAWAII

APPROVED:

A. Harano 5/6/94
for DIR. OF TRANSPORTATION DATE

UNIT "C" | DESIGNED BY | R. HIRONAKA P. S. & E. BY | 587-2250 PHONE | AUG., 1993 DATE

6thdrfsht.dgn log/ts mal 1-3-22-94