


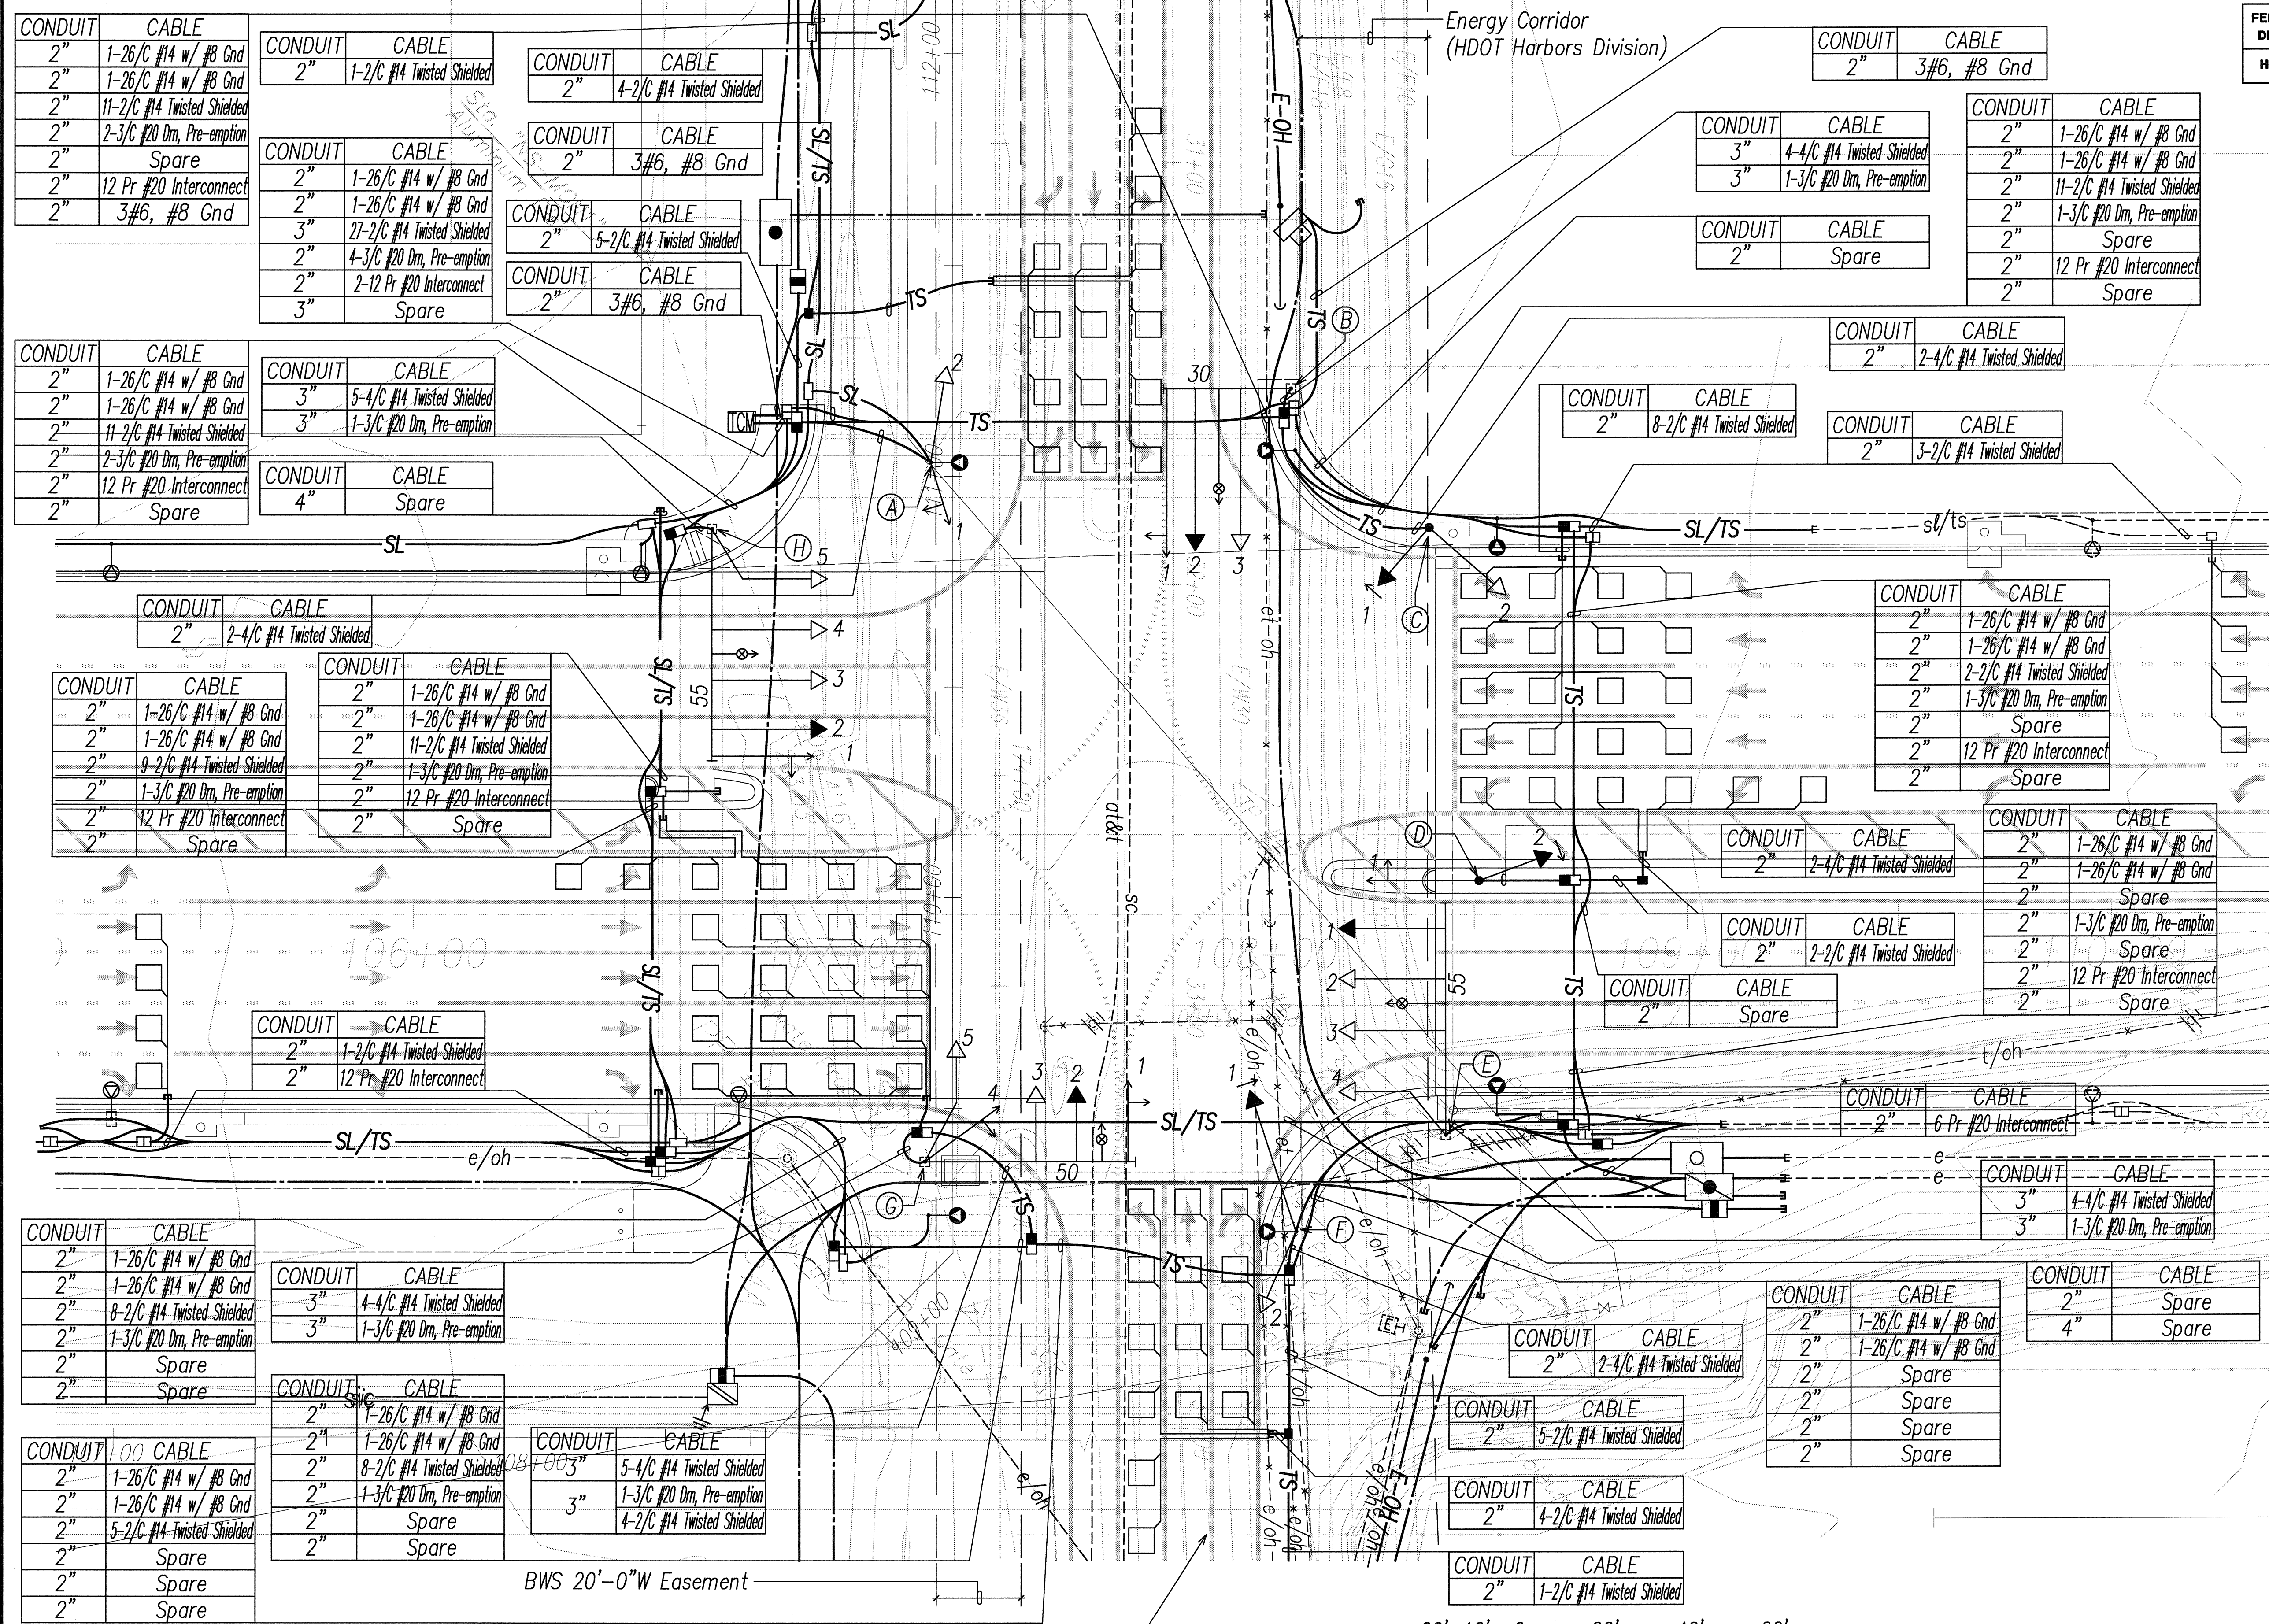


FED. ROAD DIST. NO.	STATE	FED. AID PROJ. NO.	FISCAL YEAR	SHEET NO.	TOTAL SHEETS
HAWAII	HAW.	STP-8930(2)	2007	281	331

TRAFFIC SIGNAL HEAD SCHEDULE	
TRAFFIC SIGNAL HEAD TYPE AND DESCRIPTION	POLE LETTER - SIGNAL HEAD NUMBER
	A-2 G-3
	B-3 G-5
	C-2 H-3
	E-2 H-4
	E-3 H-5
	E-4
12" RYG Traffic Signal Head	F-2
	A-1* G-4*
	B-1* H-1*
	C-1
	D-1*
	D-2
	F-1
	G-1*
	B-2
	E-1
	G-2
	H-2
* Indicates Programmed Visibility Traffic Signal Head	

DATE	
DESIGNED BY	
DRAWN BY	
CHECKED BY	
IN CHARGE	
NOTED BY	
QUANTITIES BY	
DATE	

STATE OF HAWAII
DEPARTMENT OF TRANSPORTATION
HIGHWAYS DIVISION
FARRINGTON HWY INTERSECTION
TRAFFIC SIGNAL PLAN
North-South Road
Phase 1B
F.A.I. Proj. No. STP-8930(2)
Scale: AS NOTED Date: Feb 21, 2007
SHEET No. E115 OF 62 SHEETS

THIS WORK WAS PREPARED BY ME OR UNDER MY SUPERVISION
92 FEB 2007
GARY I. FUNAKAWA
LICENSED PROFESSIONAL ENGINEER
No. 1185-E
HAWAII, U.S.A.

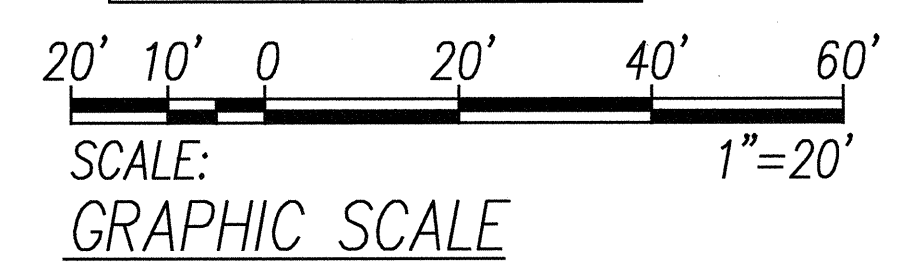

FARRINGTON HWY INTERSECTION TRAFFIC SIGNAL PLAN
SCALE: 1"=20'