FED. ROAD DIST. NO.	STATE	FED. AID PROJ. NO.	FISCAL YEAR	SHEET NO.	TOTAL SHEETS
HAWAII	HAW.	STP-8930(2)	2007	2	331

INDEX TO DRAWINGS

SHEET NO.	DESCRIPTION
2	TITLE SHEET
3–7	INDEX
8	STANDARD PLANS SUMMARY
9	LEGEND & ABBREVIATIONS
10–15	CONSTRUCTION NOTES
16	GENERAL PLAN
17–151	CIVIL PLANS ①
152–178	GEOTECH PLANS
179–256	STRUCTURAL PLANS ③
257–318	ELECTRICAL PLANS ②
319–331	LANDSCAPE PLANS

Sheet Nos. ① CO ADD15S-2, CO 101S-3, CO 104S-1, CO 104S-2, CO 104S-3, ② CO ADD307S-1, ③ CO 229S-1, CO 247S-1, CO 247S-2, CO 247S-3, CO 247S-4, CO 247S-5, CO 247S-6, 253S-1, 253S-2, 253S-3, CO 256S-1, CO 256S-2, CO 256S-3, CO 256S-4, CO 256S-5, CO 256S-6, CO 256S-7, CO 256S-8, ADD 256S-9, ADD 256S-10, ADD 256S-11, ADD 256S-12 are SUPPLEMENTARY sheets to this project, added during ADDENDUM & "AS-BUILT" postings. TOTAL SHEET COUNT after ADDENDUM & "AS-BUILT" postings is 464 shts.

STATE OF HAWAII

DEPARTMENT OF TRANSPORTATION

HIGHWAYS DIVISION

HONOLULU, HAWAII

"AS-BUILT"

PLANS FOR

PART A

NORTH-SOUTH ROAD

PHASE 1B

FEDERAL AID PROJECT NO. STP-8930(2)

DISTRICT OF EWA

ISLAND OF OAHU

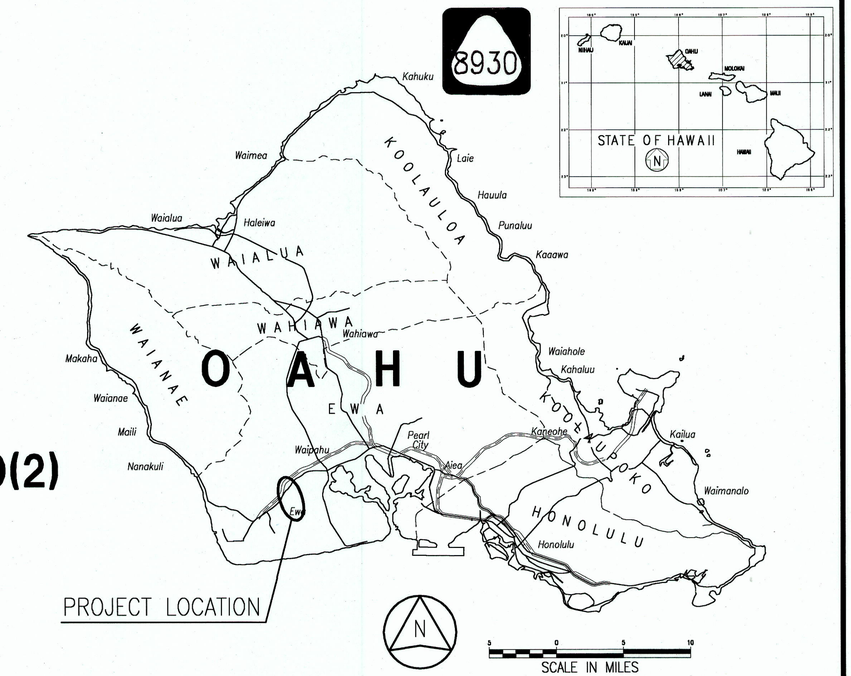

FEDERAL AID INTERSTATE PROJECTS PREVIOUSLY CONSTRUCTED OR UNDER CONSTRUCTION

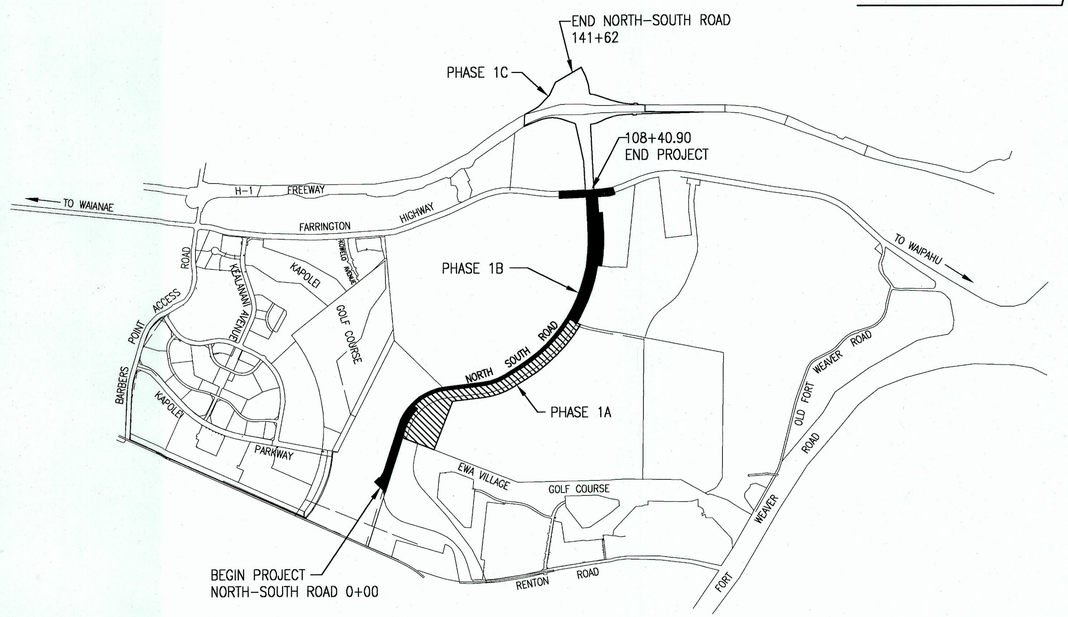

NET LENGTH OF PROJECT - 2.05 MILES
GROSS LENGTH OF PROJECT - 2.05 MILES

N

LOCATION PLAN

NOT TO SCALE

DESIGN DESIGNATION

DESIGN ADT (2022) 43,500
DHV 4,400
D (DESIGN) 54/46
T (DESIGN) 2.7%
T 24 ..... 9.3%
V ..... 45 MPH

CHANGES MADE DURING CONSTRUCTION HAVE BEEN INCORPORATED ON THESE PLANS EXCEPT CHANGES IN THE ORIGINAL THEORETICAL QUANTITIES. FOR ACTUAL QUANTITIES, REFER TO PROJECT LEDGER AND/OR COMPUTATION BOOK.

RESIDENT ENGINEER — DATE 3/7/14

DEPARTMENT OF TRANSPORTATION
STATE OF HAWAII

APPROVED:

for DIR. OF TRANSPORTATION — DATE 3-14-07

R.M. TOWILL CORP. — DESIGNED BY
C. WATANABE — MANAGED BY
692-7551 — PHONE
FEB. 2007 — DATE

ORIGINAL PLAN	SURVEY PLOTTED BY	DATE
	DRAWN BY	
	TRACED BY	
NOTE BOOK	TYPED BY	
	DESIGNED BY	
	QUANTITIES BY	
No.	CHECKED BY	