FED. ROAD DIST. NO.	STATE	FED. AID PROJ. NO.	FISCAL YEAR	SHEET NO.	TOTAL SHEETS
HAWAII	HAWAII	F 59(2)	1953	1	16

7-8-53

INDEX TO DRAWINGS	
SHEET NO.	DESCRIPTION
1	Title Sheet
2 - 3	Plan and Profile - Canal
4	Plan and Profile - Borrow Pit
5 - 8	Structural Details
9 - 14	Cross Sections - Canal
15 - 16	Cross Sections - Borrow Pit

TERRITORY OF HAWAII
TERRITORIAL HIGHWAY DEPARTMENT
HONOLULU, OAHU, T. H.

PLANS OF

MAUKA ARTERIAL
KEEAUMOKU STREET TO ALEXANDER STREET
REALIGNMENT OF MAKIKI STREET

FEDERAL AID PROJECT Nº F 59 (2)

DISTRICT OF HONOLULU
ISLAND OF OAHU

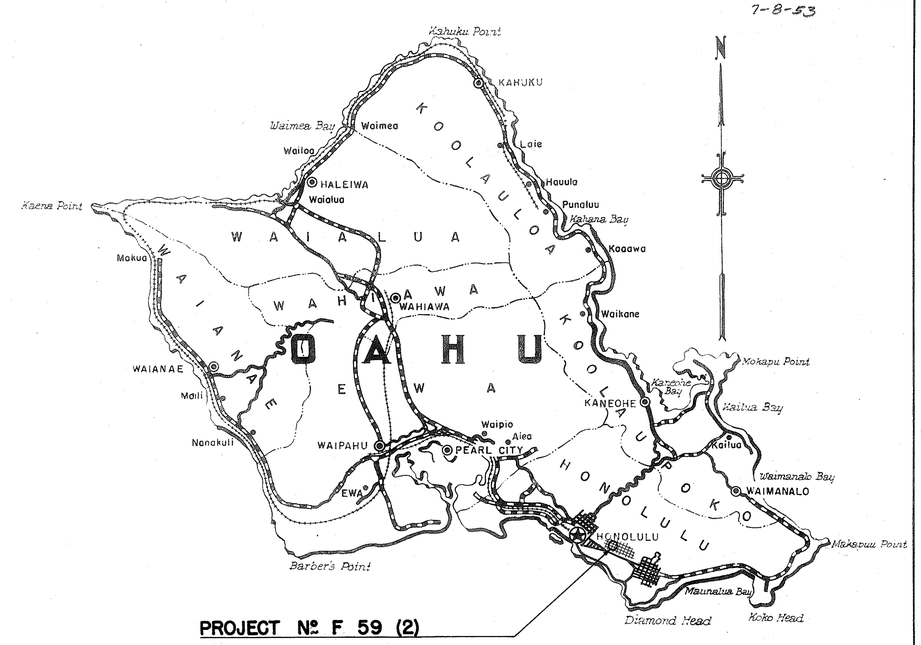

SCALES

PLAN	HOR	1 INCH = 20 FEET
PROFILE	HOR	1 INCH = 20 FEET
	VERT	1 INCH = 5 FEET
CROSS SECTION	HOR	1 INCH = 10 FEET
	VERT	1 INCH = 5 FEET

Federal Aid Projects Previously Constructed Or Under Construction

NOTE:
ALL CHANGES MADE DURING CONSTRUCTION
HAVE BEEN NOTED IN RED IN THESE TRACINGS
AND CHECKED BY: K. Uratani
PROJECT ENGINEER
DATE: 4-6-54

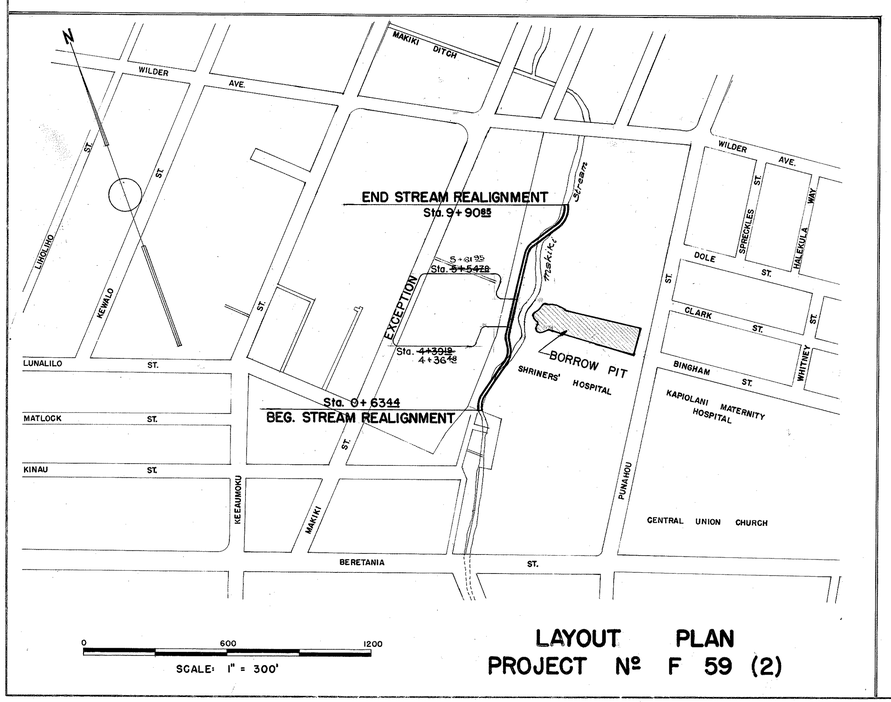

LAYOUT PLAN
PROJECT Nº F 59 (2)

ORIGINAL PLAN	
	SURVEY PLOTTED BY
	DESIGNED BY
	DRAWN BY
	TRACED BY
NOTE BOOK	QUANTITIES BY
	QUANTITIES CHECKED BY
No.	CHECKED BY
	DATE

APPROVED DATE 6/8/53
Ben E. Nutter
TERRITORIAL HIGHWAY ENGINEER

DEPARTMENT OF COMMERCE
BUREAU OF PUBLIC ROADS
APPROVED:
[redacted]
DISTRICT ENGINEER DATE

5655.1