INDEX TO DRAWINGS	
SHEET NO.	DESCRIPTION
1	Title Sheet
2	Plan and Profile — Box Culvert
3	Plan and Profile — Proposed Arterial
4	Structural Details

FED. ROAD DIST. NO.	STATE	FED. AID PROJ. NO.	FISCAL YEAR	SHEET NO.	TOTAL SHEETS
HAWAII	HAW.	U 59(6)	1953	1	4

7-8-53

TERRITORY OF HAWAII
TERRITORIAL HIGHWAY DEPARTMENT
HONOLULU, OAHU, T. H.

PLANS OF

MAUKA ARTERIAL
KEEAUMOKU STREET TO ALEXANDER STREET
REALIGNMENT OF MAKIKI STREAM
FEDERAL AID URBAN PROJECT Nº U 59 (6) UNIT 1

DISTRICT OF HONOLULU
ISLAND OF OAHU

SCALES

PLAN	HOR	1 INCH = 20 FEET
PROFILE	HOR	1 INCH = 20 FEET
	VERT	1 INCH = 5 FEET
CROSS SECTION	HOR	1 INCH = 10 FEET
	VERT	1 INCH = 5 FEET

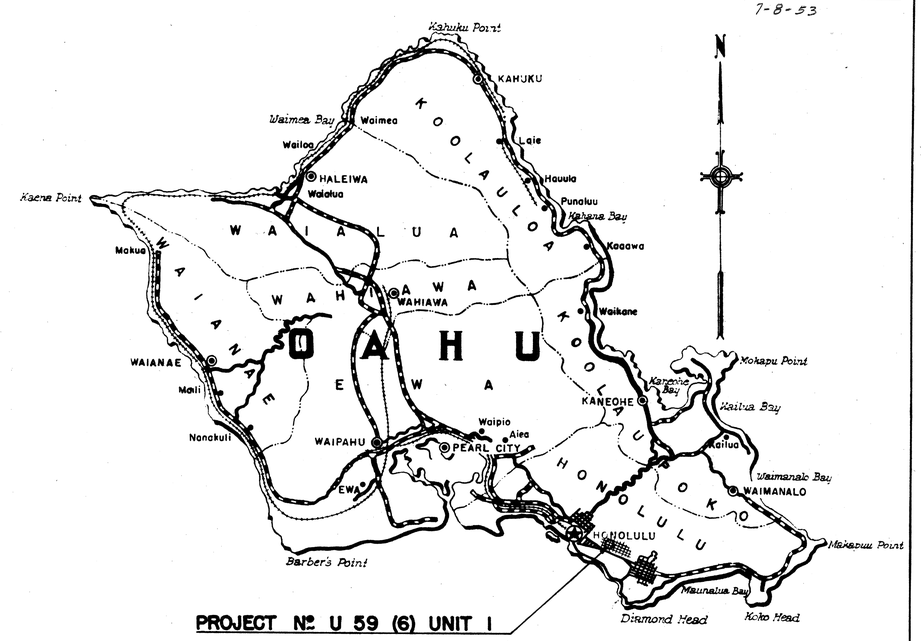

Federal Aid Projects Previously Constructed Or Under Construction

NOTE:
ALL CHANGES MADE DURING CONSTRUCTION
HAVE BEEN NOTED IN RED IN THESE TRACINGS
AND CHECKED BY:
T. Cerutani
PROJECT ENGINEER
DATE: 4-6-54

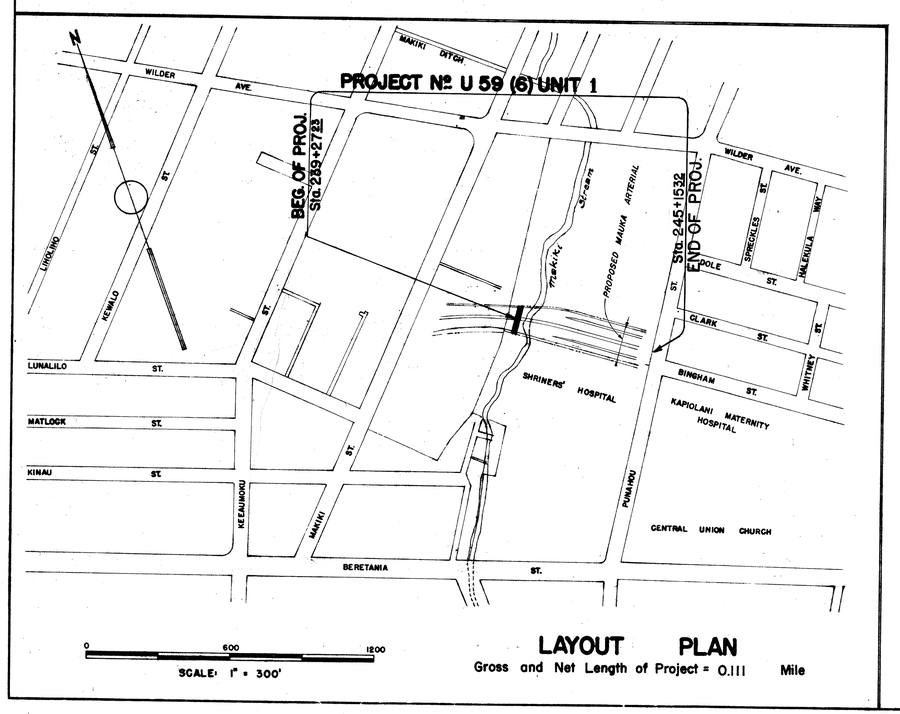

LAYOUT PLAN
Gross and Net Length of Project = 0.111 Mile

ORIGINAL PLAN	SURVEY PLOTTED BY: DESIGNED BY: DRAWN BY: TRACED BY: QUANTITIES BY: QUANTITIES CHECKED BY: CHECKED BY:	DATE
	NOTE BOOK No.	

APPROVED DATE 6/8/53
Ben E. Nutter
TERRITORIAL HIGHWAY ENGINEER

DEPARTMENT OF COMMERCE
BUREAU OF PUBLIC ROADS
APPROVED:
[redacted]
DISTRICT ENGINEER DATE

5637.1