FED. ROAD DIST. NO.	STATE	FED. AID PROJ. NO.	FISCAL YEAR	SHEET NO.	TOTAL SHEETS
HAWAII	HAW	U 59(3) Unit 2	1954	4	25

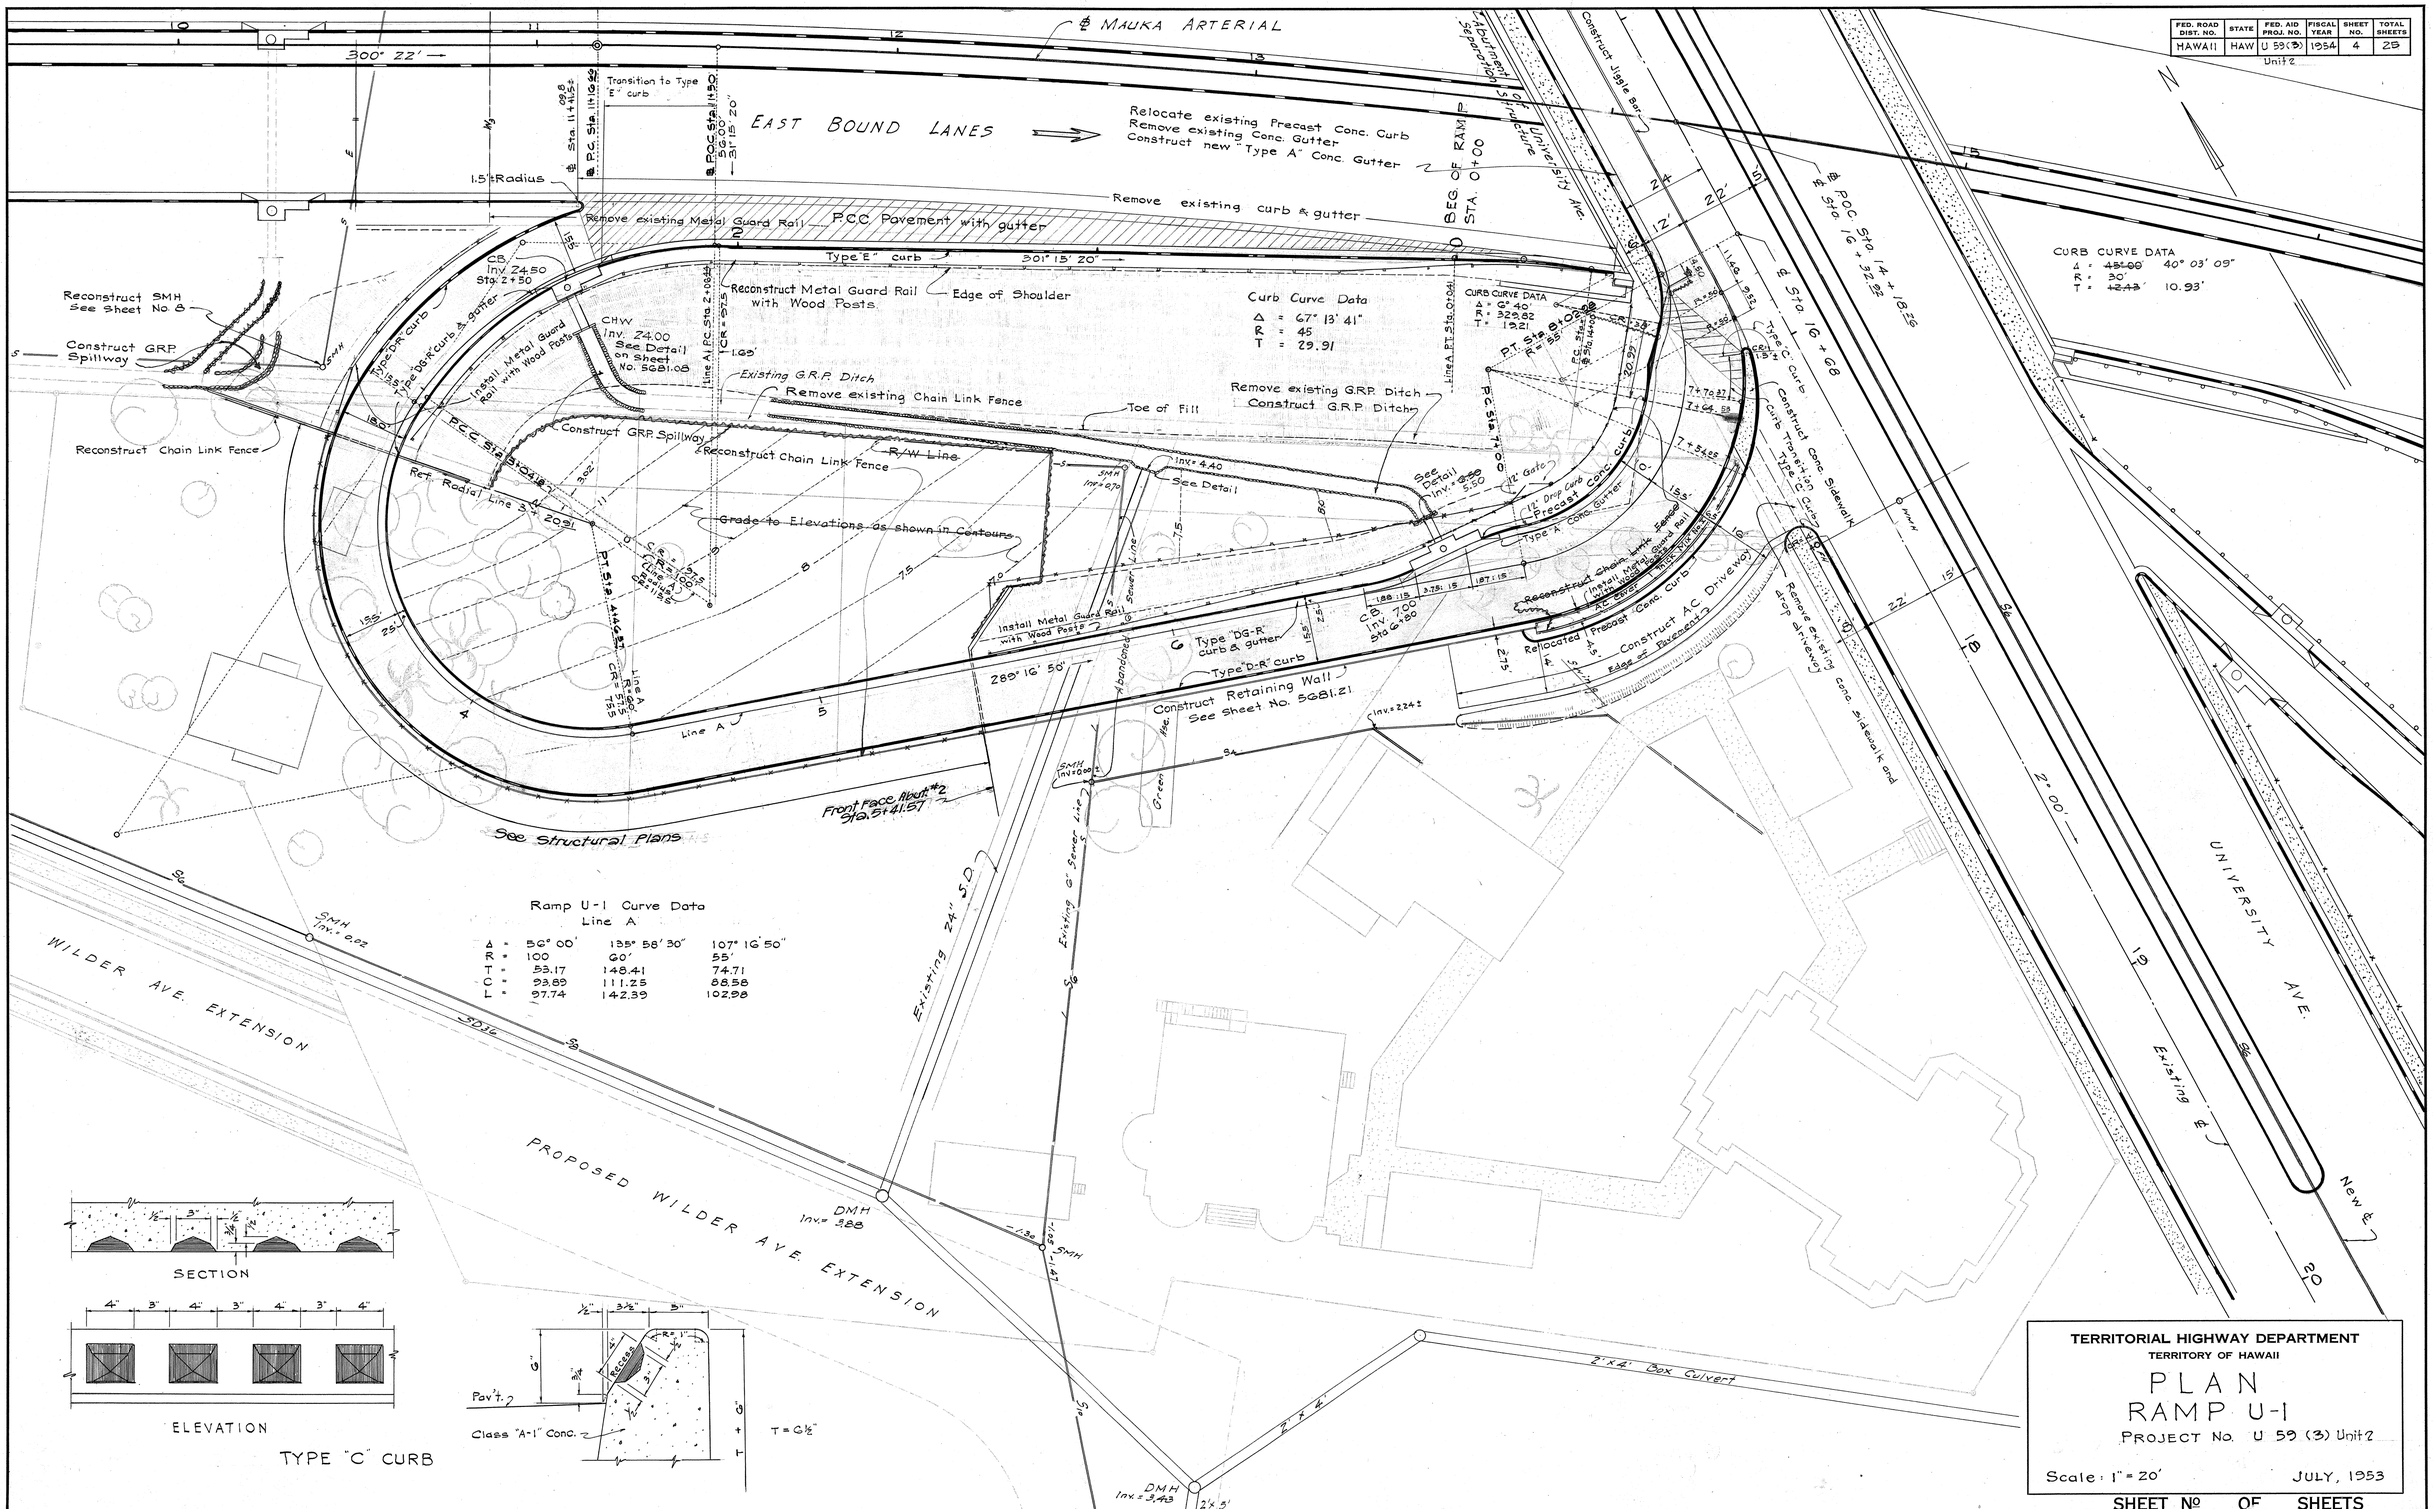

TERRITORIAL HIGHWAY DEPARTMENT
TERRITORY OF HAWAII

PLAN
RAMP U-1

PROJECT No. U 59 (3) Unit 2

Scale: 1" = 20' JULY, 1953

SHEET No. OF SHEETS

5681.04

ORIGINAL PLAN		
	SURVEY PLOTTED BY	DATE
	DESIGNED BY	" "
	DRAWN BY	" "
NOTE BOOK	TRACED BY	" "
	QUANTITIES BY	" "
No.	CHECKED BY	" "

TRACING CLOTH 224 Co., N. Y.