


BEG. PROJ. NO U59(6) UNIT 2
KEEAUMOKU ST. to ALEXANDER ST.
Sta. 230+00

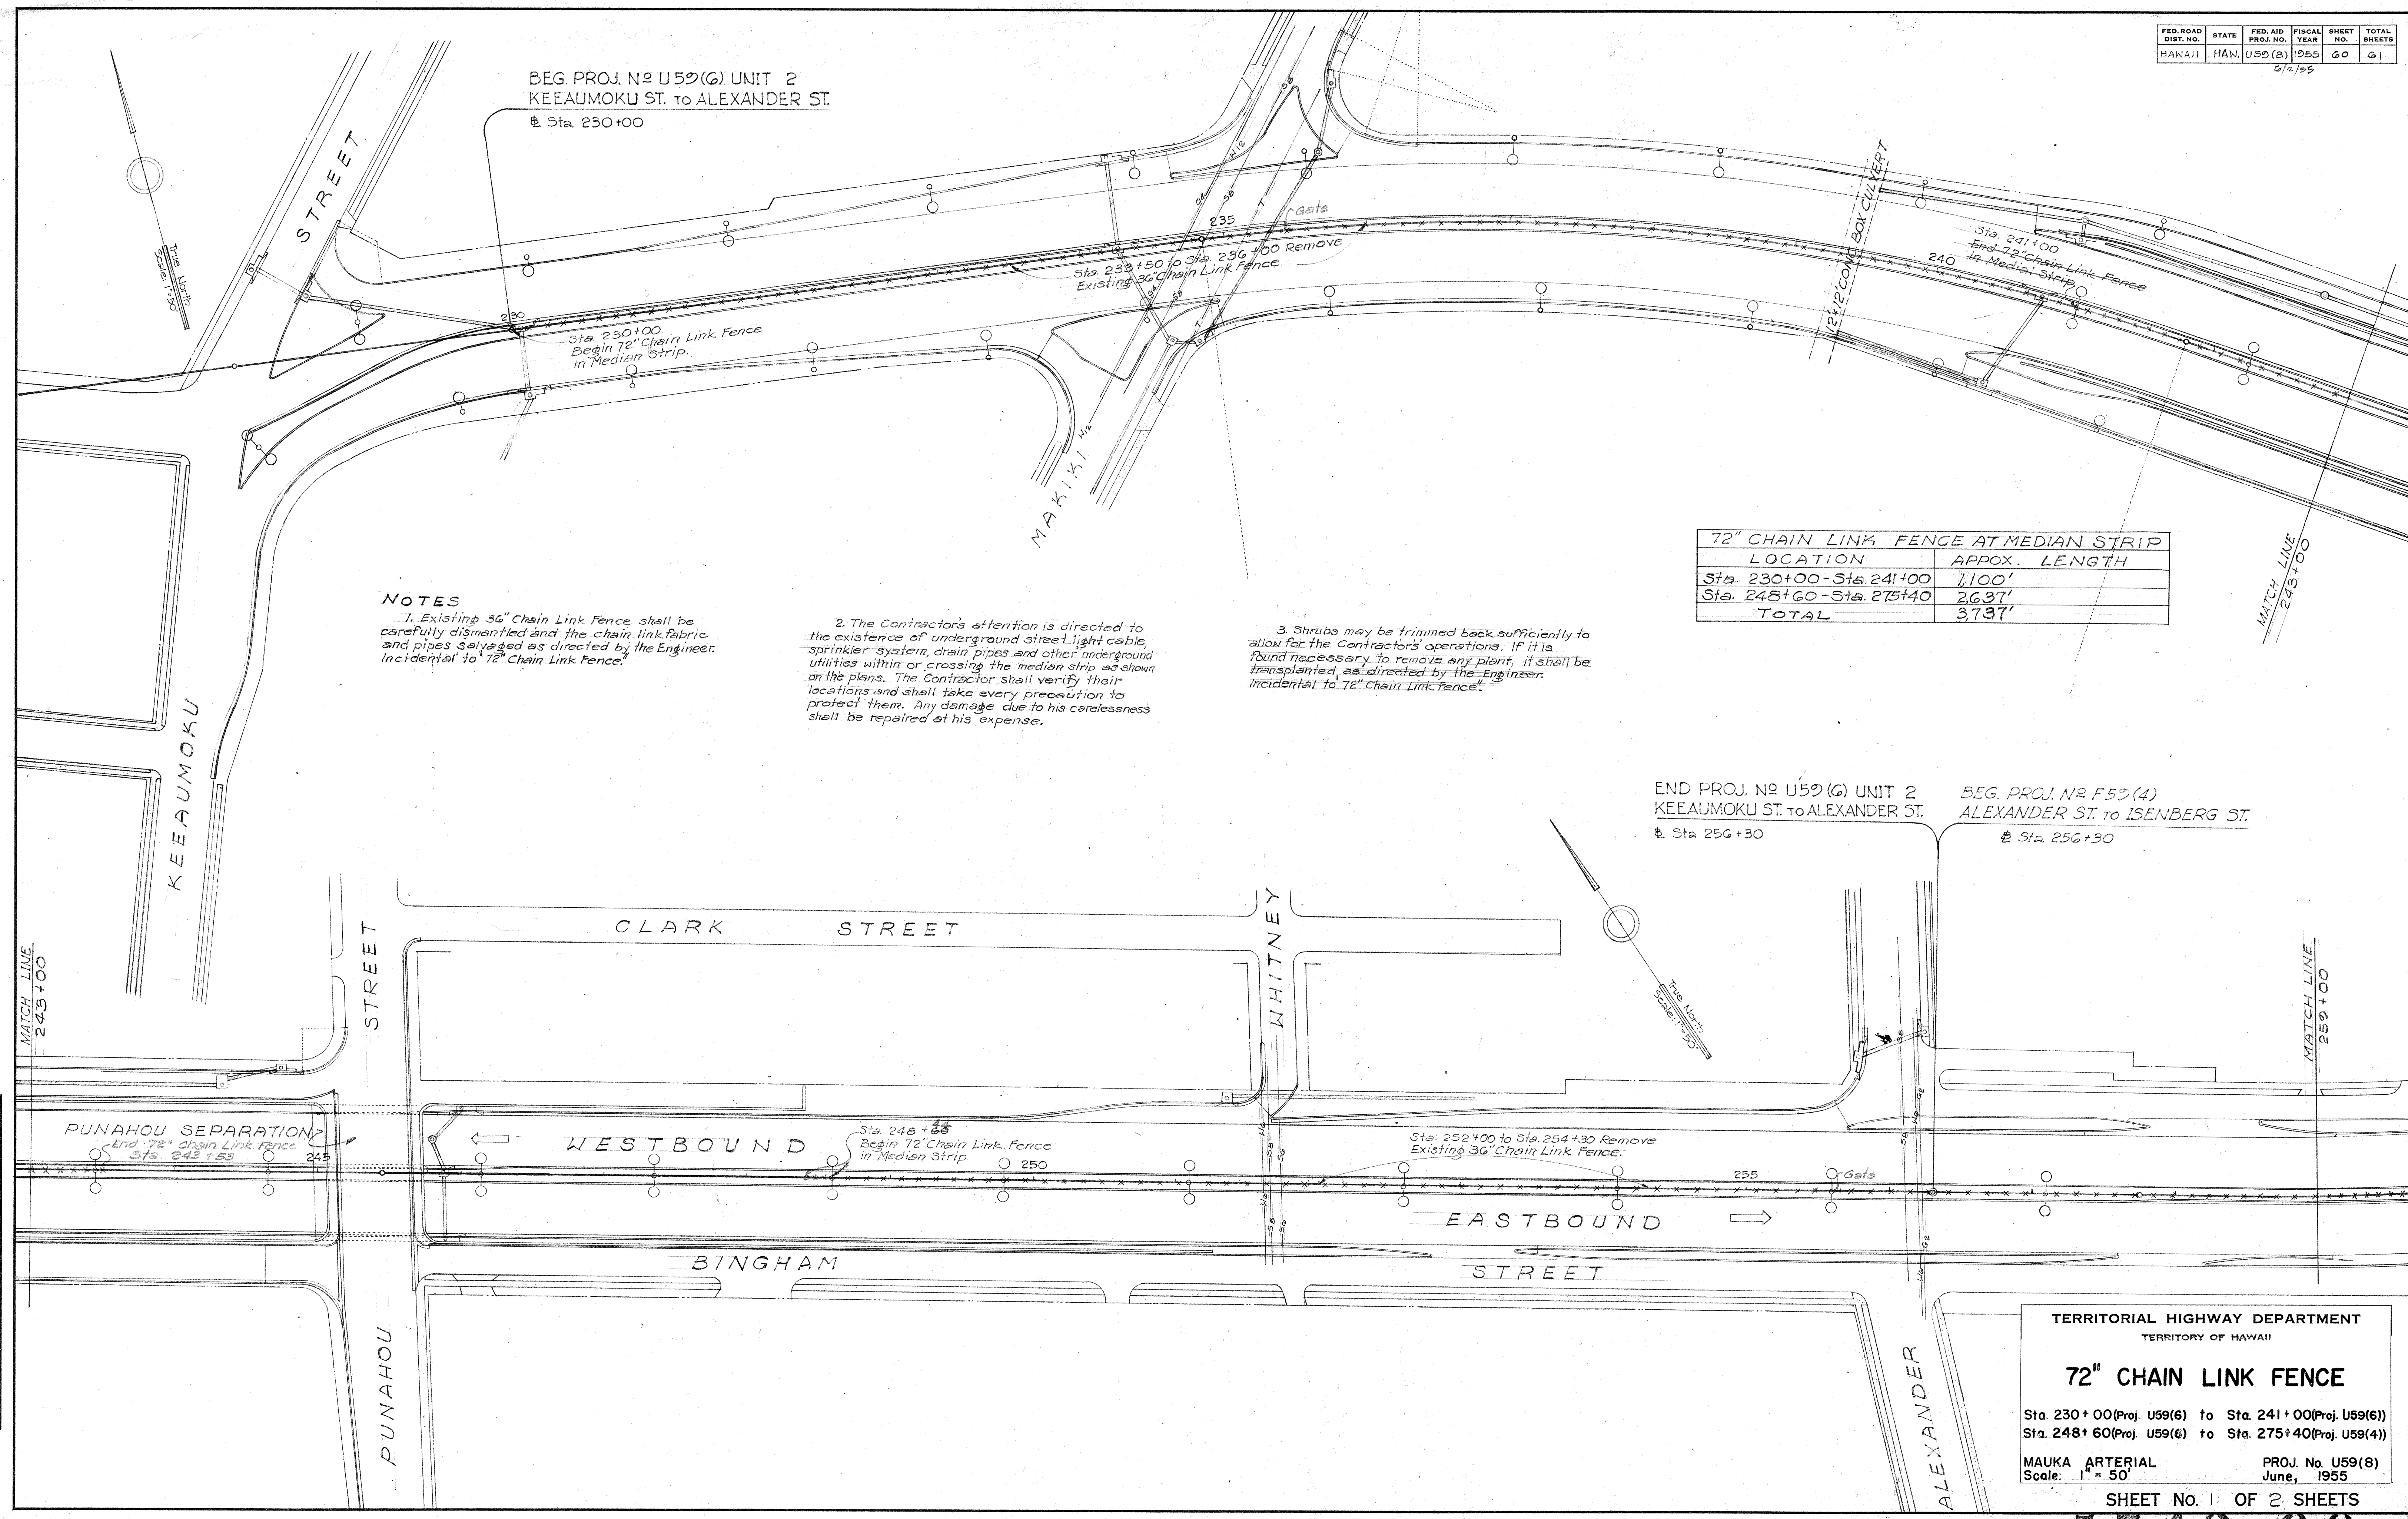

NOTES

1. Existing 36" Chain Link Fence shall be carefully dismantled and the chain link fabric and pipes salvaged as directed by the Engineer. Incidental to 72" Chain Link Fence.

2. The Contractor's attention is directed to the existence of underground street light cable, sprinkler system, drain pipes and other underground utilities within or crossing the median strip as shown on the plans. The Contractor shall verify their locations and shall take every precaution to protect them. Any damage due to his carelessness shall be repaired at his expense.

3. Shrubs may be trimmed back sufficiently to allow for the Contractor's operations. If it is found necessary to remove any plant, it shall be transplanted as directed by the Engineer. Incidental to 72" Chain Link Fence.

72" CHAIN LINK FENCE AT MEDIAN STRIP	
LOCATION	APPROX. LENGTH
Sta. 230+00 - Sta. 241+00	1,100'
Sta. 248+60 - Sta. 275+40	2,637'
TOTAL	3,737'

END PROJ. NO U59(6) UNIT 2
KEEAUMOKU ST. to ALEXANDER ST.
Sta. 256+30

BEG. PROJ. NO F59(4)
ALEXANDER ST. to ISENBERG ST.
Sta. 256+30

DATE
SURVEY PLOTTED BY
PLAN
DRAWN BY
TRACED BY
NOTE BOOK
QUANTITIES CHECKED BY
No.

TERRITORIAL HIGHWAY DEPARTMENT
TERRITORY OF HAWAII

72" CHAIN LINK FENCE

Sta. 230+00(Proj. U59(6)) to Sta. 241+00(Proj. U59(6))
Sta. 248+60(Proj. U59(6)) to Sta. 275+40(Proj. U59(4))

MAUKA ARTERIAL
Scale: 1" = 50'

PROJ. No. U59(8)
June, 1955


SHEET No. 1 OF 2 SHEETS

5743.60

FED. ROAD DIST. NO.	STATE	FED. AID PROJ. NO.	FISCAL YEAR	SHEET NO.	TOTAL SHEETS
HAWAII	HAW	U59(8)	1955	61	61

END OF PROJ. FU59(2)
ALEXANDER ST TO ISENBERG ST

ORIGINAL PLAN	DATE
DESIGNED BY	
DRAWN BY	
TRACED BY	
QUANTITIES CHECKED BY	
NOTE BOOK	
CHECKED BY	

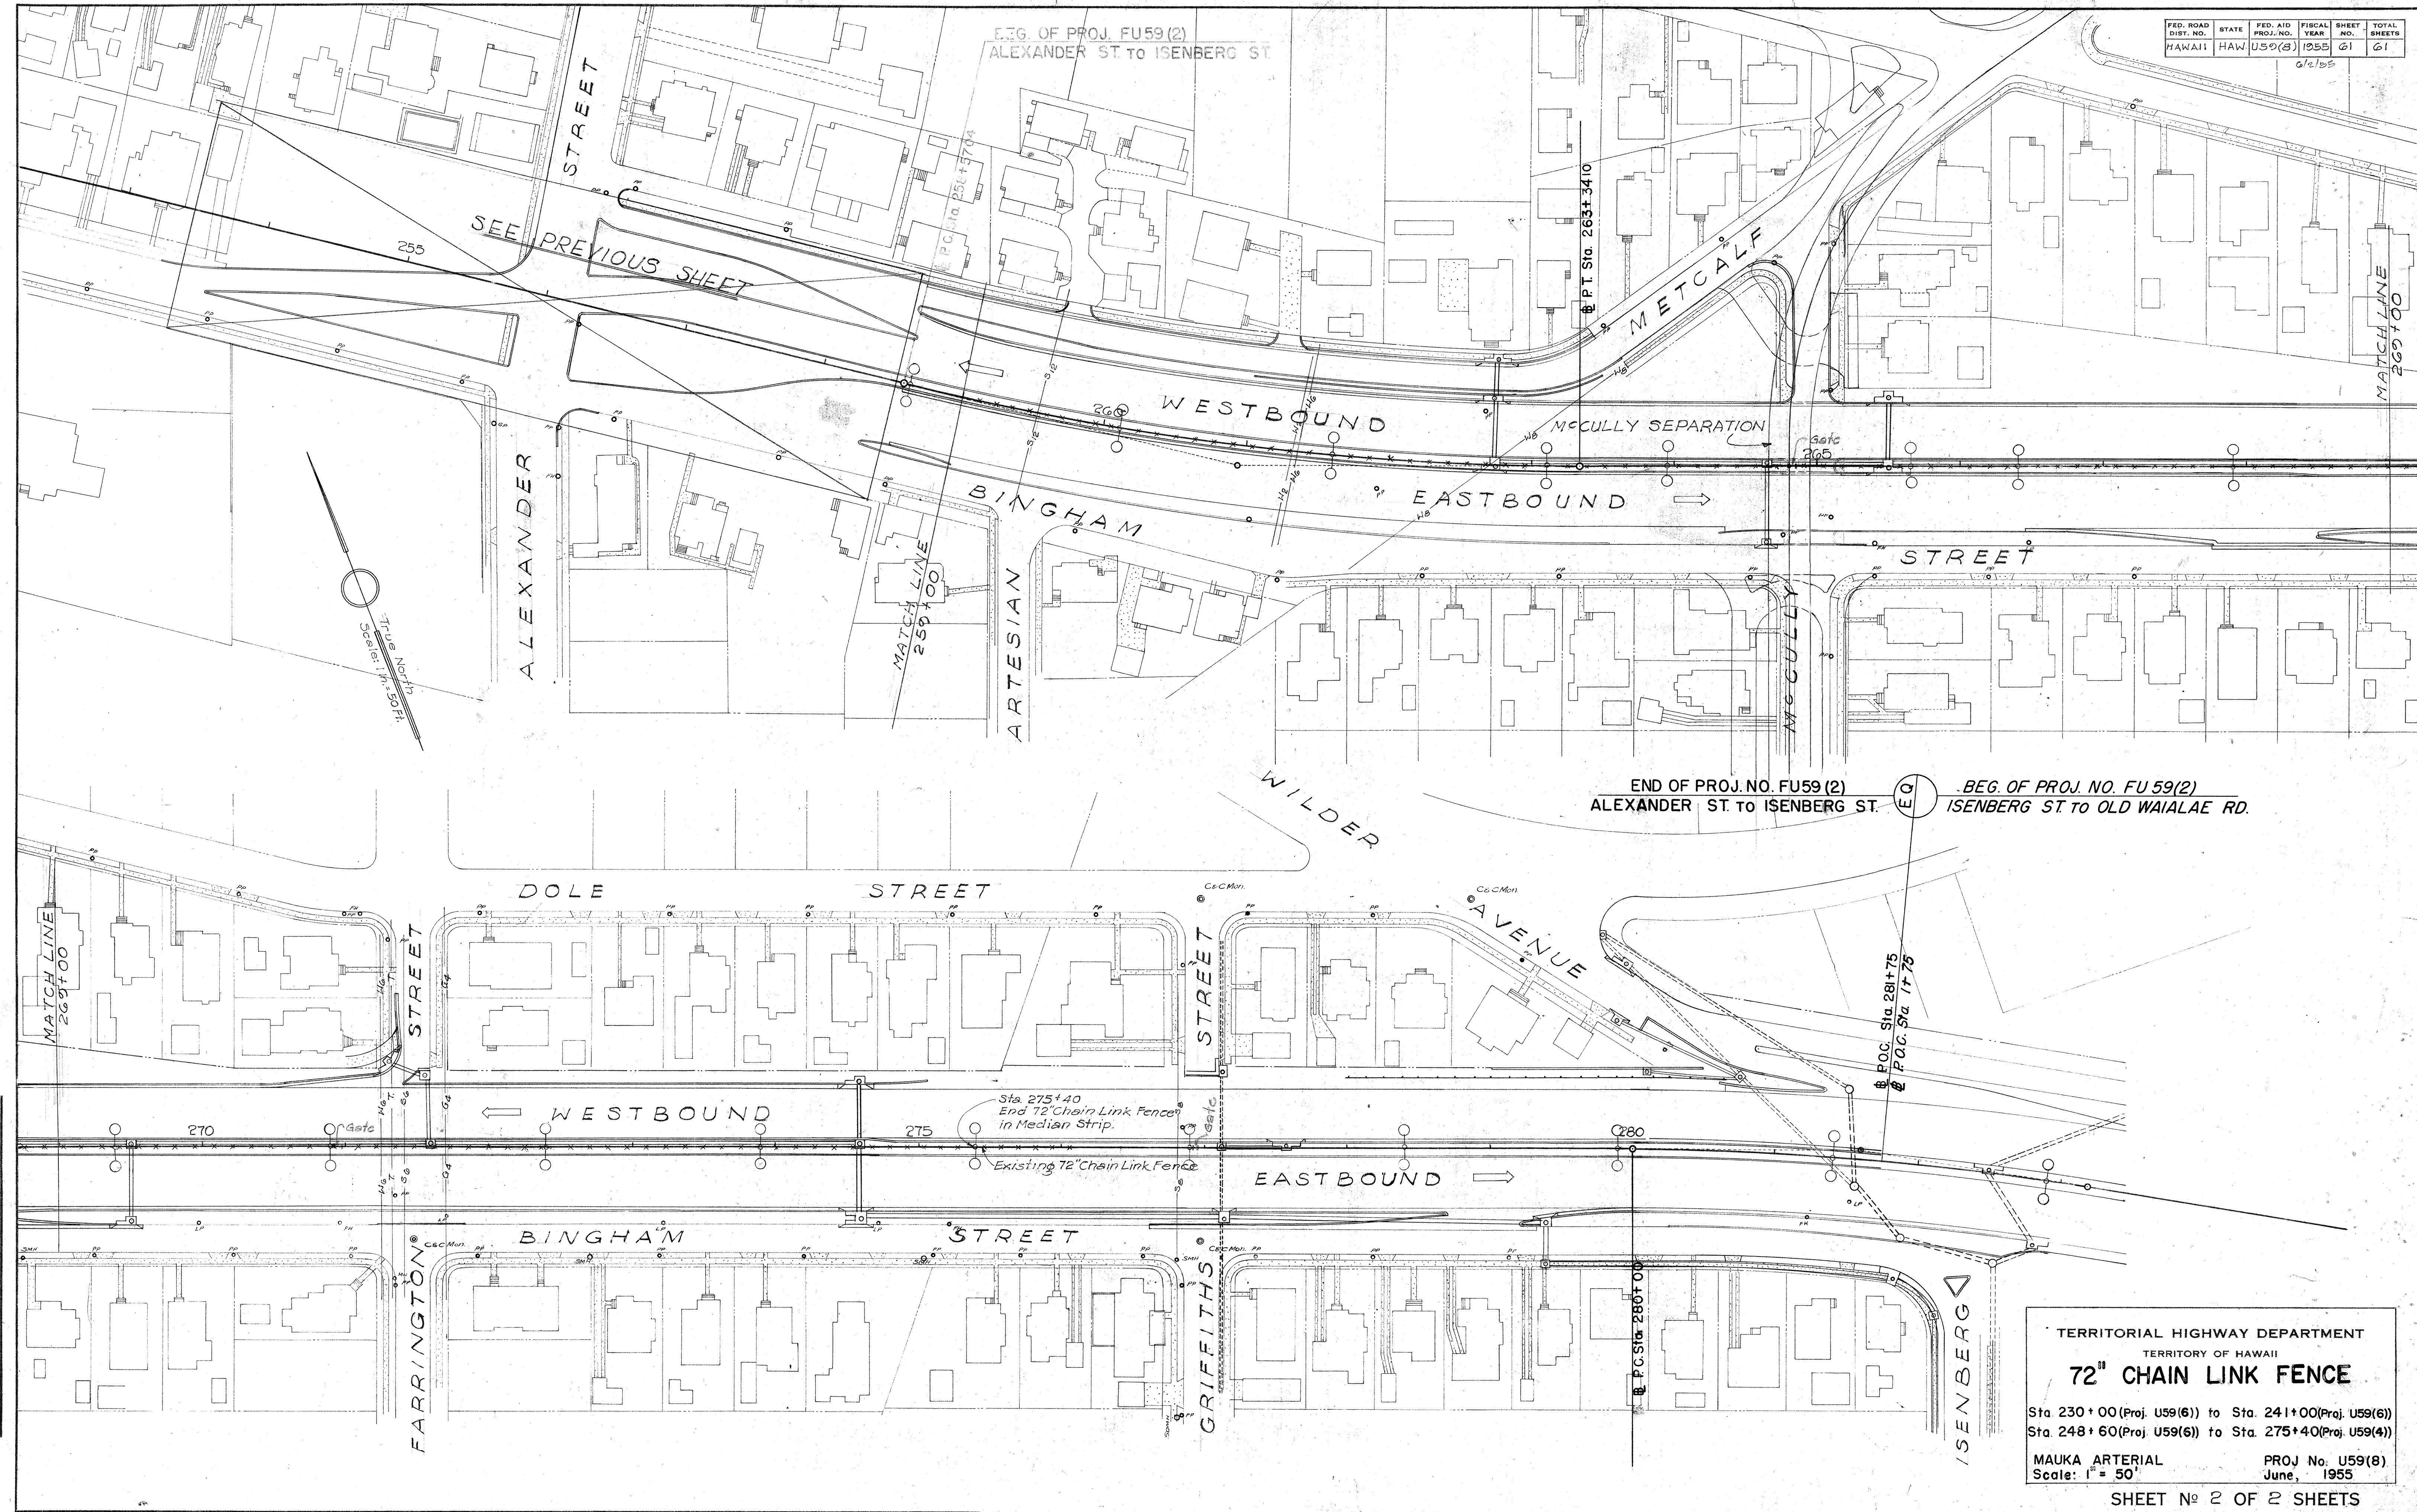

END OF PROJ. NO. FU59(2)
ALEXANDER ST TO ISENBERG ST

BEG. OF PROJ. NO. FU59(2)
ISENBERG ST TO OLD WAIALAE RD.

TERRITORIAL HIGHWAY DEPARTMENT
TERRITORY OF HAWAII
72" CHAIN LINK FENCE

Sta 230+00(Proj. U59(6)) to Sta. 241+00(Proj. U59(6))
Sta. 248+60(Proj. U59(6)) to Sta. 275+40(Proj. U59(4))

MAUKA ARTERIAL
Scale: 1" = 50'

PROJ No. U59(8)
June, 1955

SHEET No 2 OF 2 SHEETS

5743.61

