FED. ROAD DIST. NO.	STATE	FED. AID PROJ. NO.	FISCAL YEAR	SHEET NO.	TOTAL SHEETS
Hawaii	Haw.	U-072-1(7) Unit 3	1958	1	80

TERRITORY OF HAWAII
TERRITORIAL HIGHWAY DEPARTMENT
HONOLULU, OAHU, T. H.

AS BUILT
PLANS OF

LUNALILO FREEWAY

PINKHAM STREET TO HOUGHTAILING STREET

FEDERAL AID PROJECT NO. U-072-1(7) UNIT 3

DISTRICT OF HONOLULU

ISLAND OF OAHU

INDEX TO DRAWINGS

SHEET NO.	DESCRIPTION	COMB. SHEET NO.
1	Title Sheet	1
2 - 4	Typical Sections	3 - 5
5 - 9	Plan & Profile	8-11, 13
10	Construction Phases	16
11 - 12	Boring Logs	17 - 18
13 - 19	Detail Plan of Roadway	19-24,26
20 - 22	Grading Plans (Kalihi Interchange)	29 - 31
23 - 25	Miscellaneous Details	32-33,36
26 - 28	Storm Drain Details And Drainage Channel Details	37 - 39
29 - 31	Gulick Ave. Overpass	40 - 42
32 - 34	Typical Structural Details	54 - 56
35 - 39	Retaining Walls	60 - 64
40	Library Underpinning	65
41 - 45	Telephone, Electric And Existing Utilities	66 - 70
46 - 48	Telephone M.H. Details	76 - 78
49 - 50	Electric & Tel. Std. Detail	79 - 80
51 - 56	Sewer System	82 - 84 87 - 89
57 - 63	Water System	90 - 93 96 - 98
64 - 69	Sub-Station & Hwy. Lighting	99 - 104
70 - 71	Traffic Sign	105 - 106
72 - 80	Cross Section	107 - 115

SCALE

PLAN		1 INCH	= 50 FEET
PROFILE	HOR.	1 INCH	= 50 FEET
	VER.	1 INCH	= 5 FEET
CROSS SECTION	HOR.	1 INCH	= 10 FEET
	VER.	1 INCH	= 5 FEET

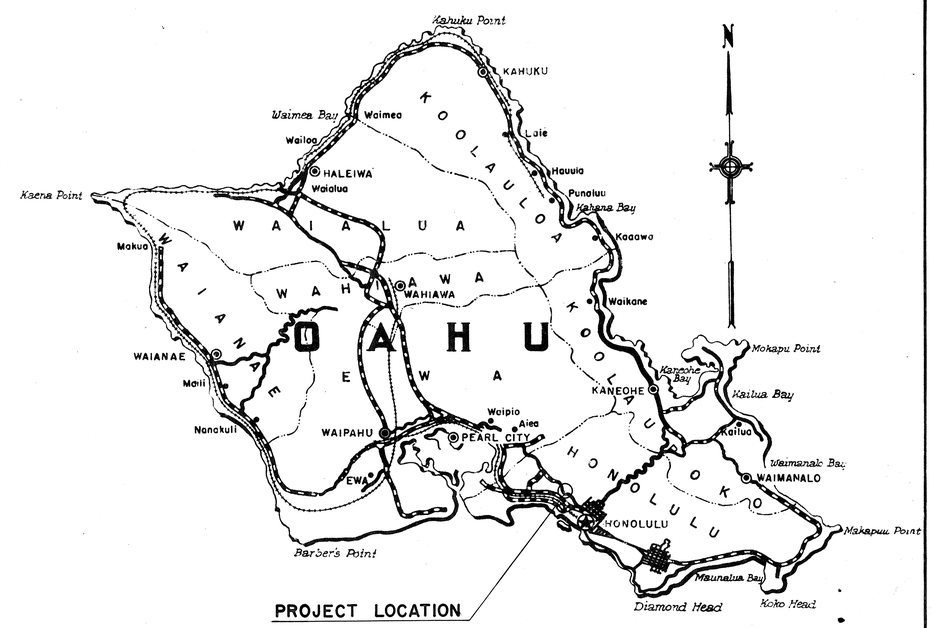

Federal Aid Projects Previously Constructed Or Under Construction

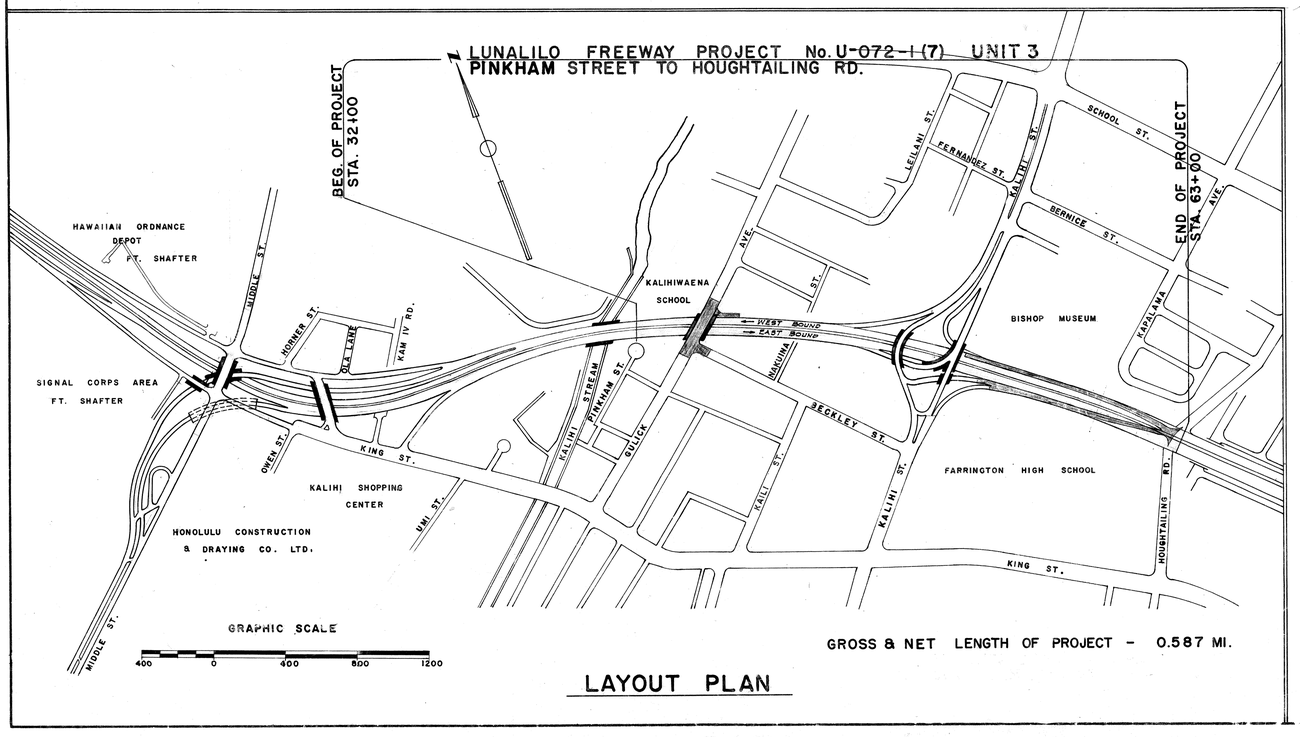

GROSS & NET LENGTH OF PROJECT - 0.587 MI.

LAYOUT PLAN

NOTE:
ALL CHANGES MADE DURING CONSTRUCTION HAVE BEEN NOTED IN THESE TRACINGS IN RED AND CHECKED BY

RESIDENT ENGINEER

DATE

BELT, COLLINS & ASSOCIATES, LTD.

Civil and Structural Engineers

·ASSOCIATES·

MOFFATT, NICHOL & TAYLOR - Structural Engineers

JAMES B. MANN - Surveyor

PAUL R. WEISSICH - Landscape Architect

WYNN NAKAMURA - Electrical Engineer

APPROVED: DATE 7/7/58

Wm Whedon
TERRITORIAL HIGHWAY ENGINEER

DEPARTMENT OF COMMERCE
BUREAU OF PUBLIC ROADS
APPROVED:
[redacted]
DIVISION ENGINEER DATE

ORIGINAL PLAN
SURVEY PLOTTED BY
TRACED BY
DRAWN BY
NOTE BOOK
QUANTITIES BY
QUANTITIES CHECKED BY
CHECKED BY
DATE
No.

5983.1