


STATE OF HAWAII
DEPARTMENT OF TRANSPORTATION
HIGHWAYS DIVISION

DETAIL PLAN
OF
DRAINAGE SYSTEM

INTERSTATE HIGHWAY
PROJ. No. I-H-1(3):24 UNIT

ORIGINAL PLAN	DATE
DESIGNED BY	
NOTED BY	
CHECKED BY	
NO.	

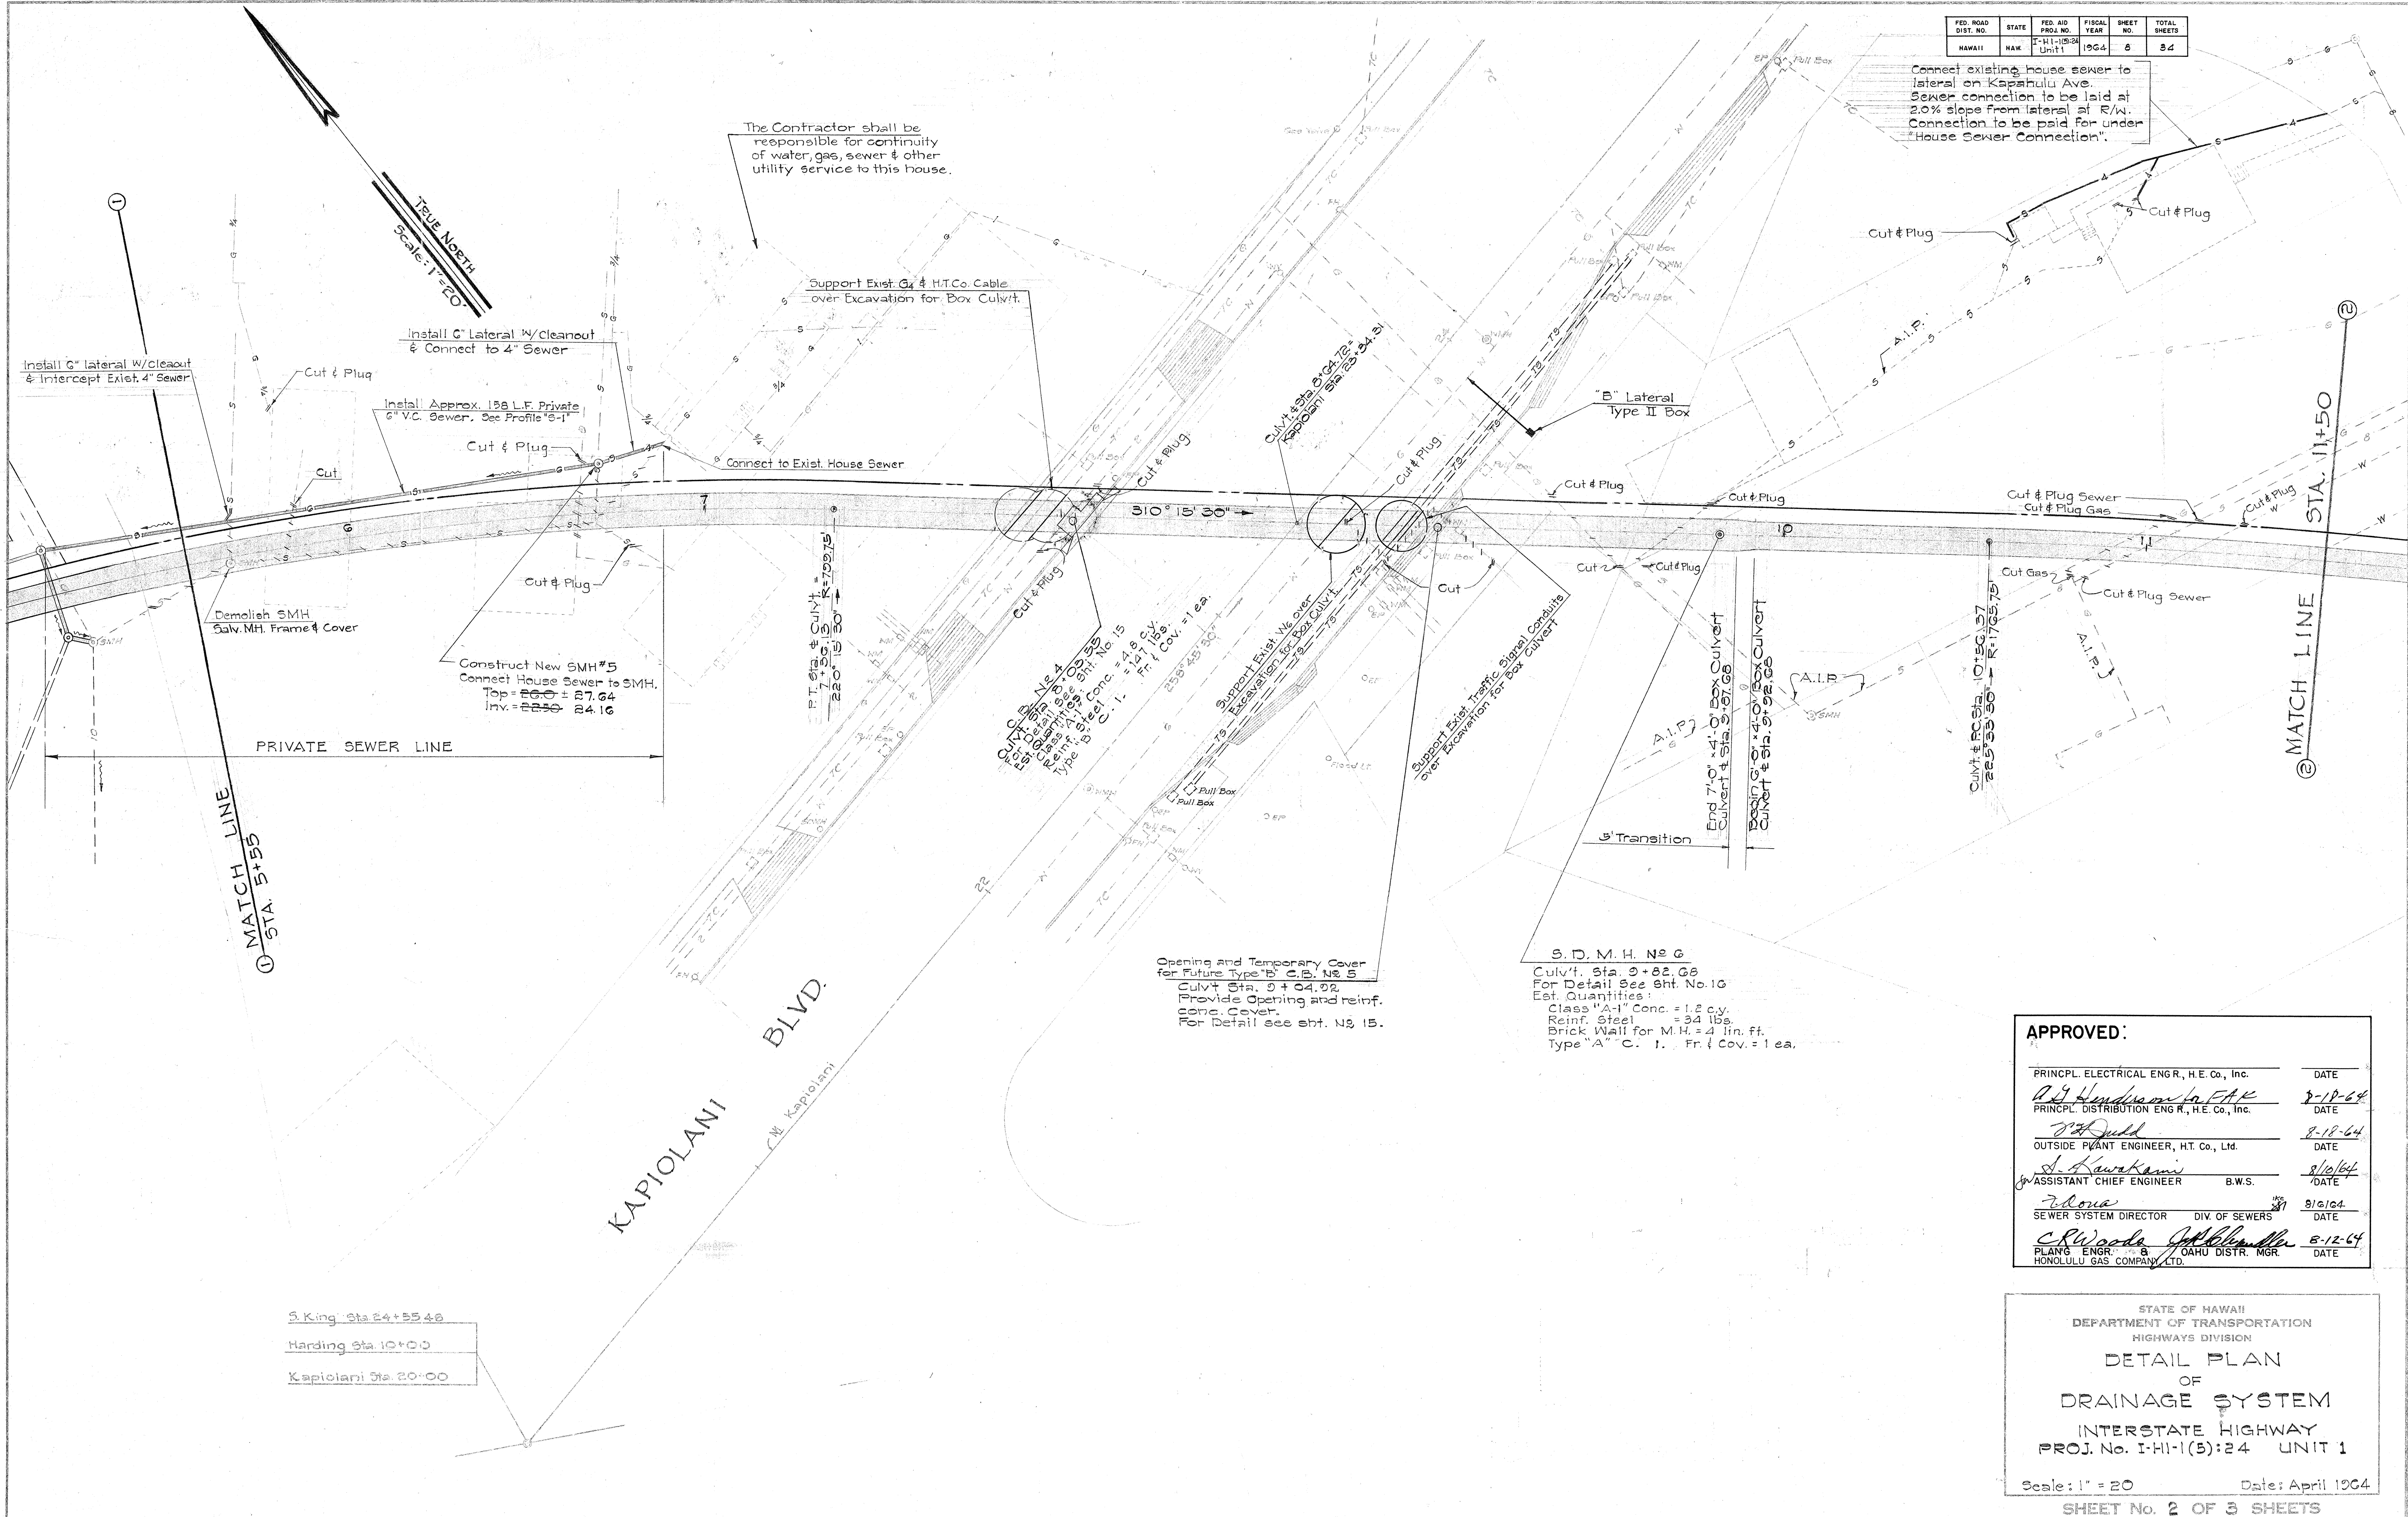


FED. ROAD DIST. NO.	STATE	FED. AID PROJ. NO.	FISCAL YEAR	SHEET NO.	TOTAL SHEETS
HAWAII	HAW.	I-11-1(5)-24 Unit 1	1964	8	24

APPROVED:	
PRINCPL. ELECTRICAL ENGR., H.E. Co., Inc.	DATE
<i>R. J. Henderson</i> for <i>F.A.K.</i>	8-18-64
PRINCPL. DISTRIBUTION ENGR., H.E. Co., Inc.	DATE
<i>R. J. Daulton</i>	8-18-64
OUTSIDE PLANT ENGINEER, H.T. Co., Ltd.	DATE
<i>S. K. Kawanishi</i>	8/16/64
ASSISTANT CHIEF ENGINEER B.W.S.	DATE
<i>E. L. O'Neil</i>	8/16/64
SEWER SYSTEM DIRECTOR DIV. OF SEWERS	DATE
<i>C. R. Woods</i> <i>J. H. O'Neil</i>	8-12-64
PLANS ENGR. OAHU DIST. MGR.	DATE
HONOLULU GAS COMPANY, LTD.	

STATE OF HAWAII
DEPARTMENT OF TRANSPORTATION
HIGHWAYS DIVISION

DETAIL PLAN
OF
DRAINAGE SYSTEM
INTERSTATE HIGHWAY
PROJ. No. I-11-1(5)-24 UNIT 1

Scale: 1" = 20' Date: April 1964
SHEET No. 2 OF 3 SHEETS

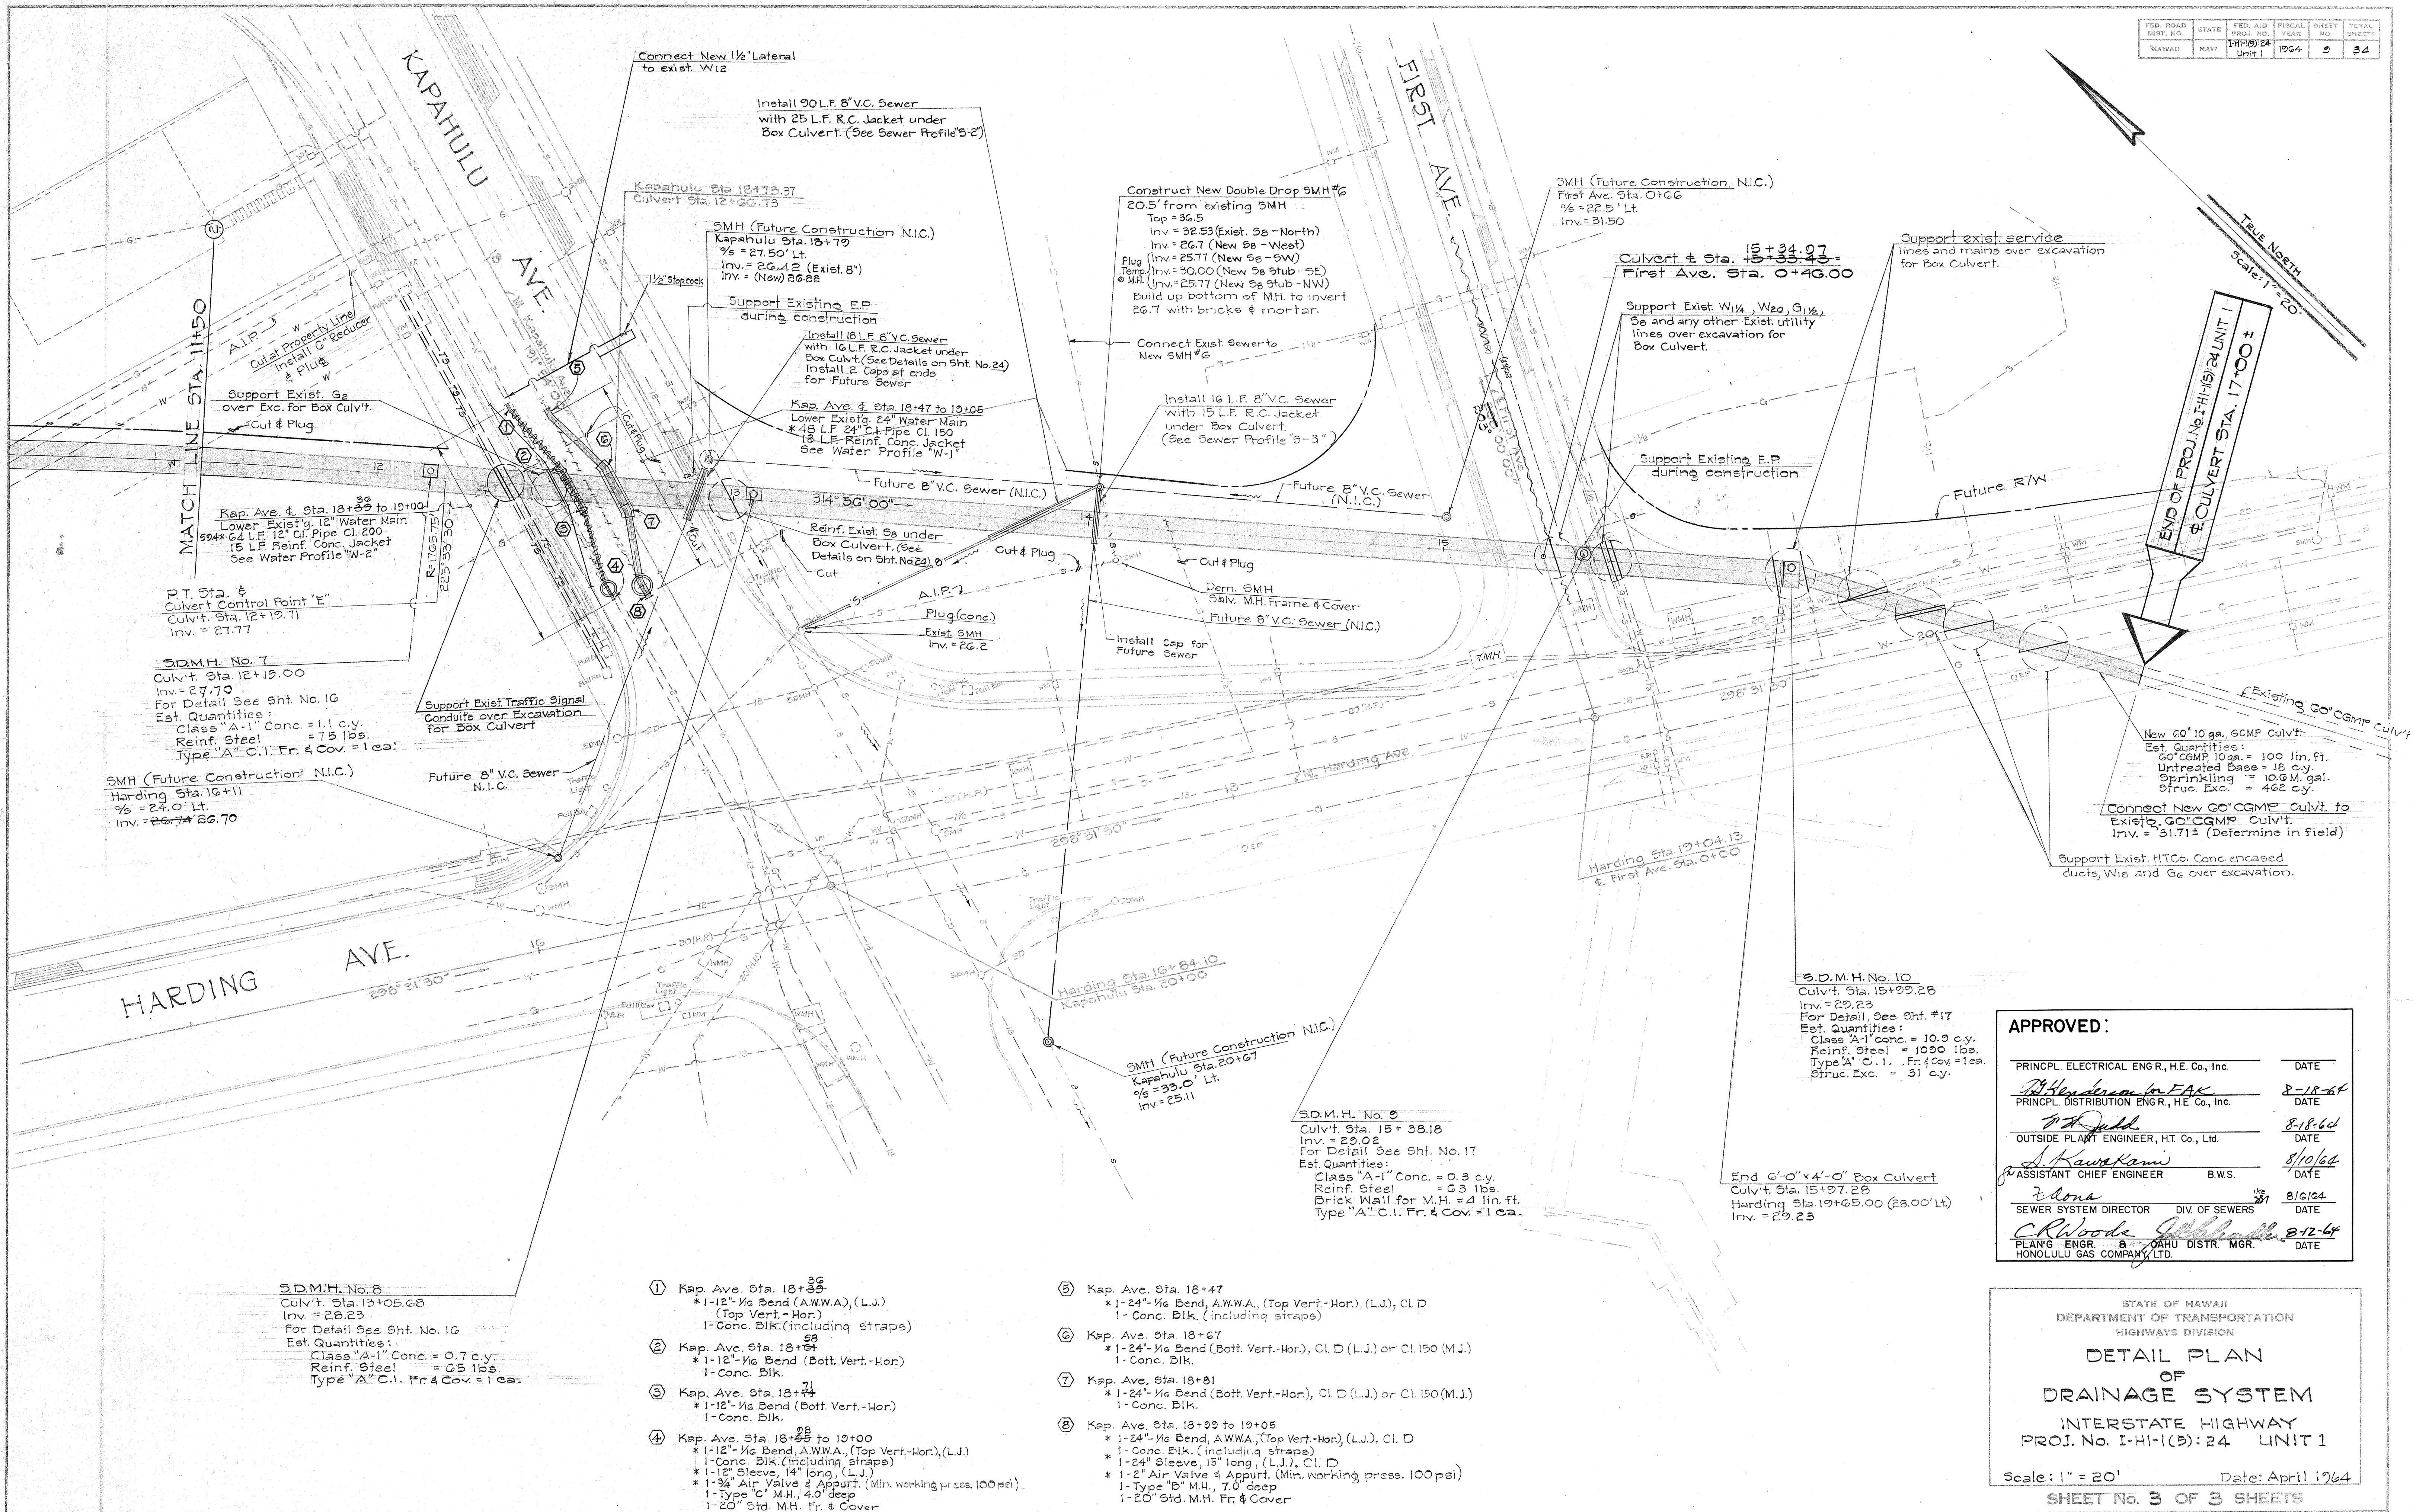

APPROVED:	
PRINCP. ELECTRICAL ENGR., H.E. Co., Inc.	DATE
<i>[Signature]</i>	8-18-64
PRINCP. DISTRIBUTION ENGR., H.E. Co., Inc.	DATE
<i>[Signature]</i>	8-18-64
OUTSIDE PLANT ENGINEER, H.T. Co., Ltd.	DATE
<i>[Signature]</i>	8/10/64
ASSISTANT CHIEF ENGINEER	DATE
<i>[Signature]</i>	8/10/64
SEWER SYSTEM DIRECTOR	DATE
<i>[Signature]</i>	8-12-64
PLANNING ENGR. & OAHU DIST. MGR.	DATE
HONOLULU GAS COMPANY, LTD.	

STATE OF HAWAII
DEPARTMENT OF TRANSPORTATION
HIGHWAYS DIVISION

**DETAIL PLAN
OF
DRAINAGE SYSTEM**

INTERSTATE HIGHWAY
PROJ. No. I-HI-1(3):24 UNIT 1

Scale: 1" = 20' Date: April 1964
SHEET No. 3 OF 3 SHEETS