FED. ROAD DIST. NO.	STATE	FED. AID PROJ. NO.	FISCAL YEAR	SHEET NO.	TOTAL SHEETS
HAWAII	HAW	I-HI-1(6) UNIT I	1965	1	129

INDEX TO DRAWINGS

SHEET NO.	DESCRIPTION
1	TITLE SHEET
2-5	TYPICAL SECTIONS
6-7	PLAN AND PROFILE
8	MISC. ROADWAY PROFILES
9-14	DETAIL PLAN OF ROADWAY
15-18	GROUTED RUBBLE SLOPE PROTECTION NOS. 1, 2, 3, & 4
19-20	MISC. ROADWAY DETAILS
21-22	PROFILES-DRIVEWAYS
23-26	STANDARD DETAILS-HIGHWAY
27-40	DRAINAGE SYSTEM
41-46	RELOC. AND REHABILITATION OF BLDGS AND IMPROVEMENTS
47-53	UTILITIES-WATER
54-71	UTILITIES-ELEC., TEL., GAS
72-77	HIGHWAY LIGHTING SYSTEM
78-79	TRAFFIC SIGNS
80-83	STANDARD DETAILS-TRAFFIC SIGNS AND ROUTE MARKERS
84-88	LANDSCAPE PLAN
89-96	SPRINKLER SYSTEM
97-111	CROSS SECTIONS
112-115	16th AVE. SEPARATION STRUCTURE NO. 16
116-125	HARDING AVE. SEPARATION STRUCTURE NO. 17
126	TYPICAL DETAILS STRUCTURES NO. 16 AND 17
127-129	STANDARD DETAILS-BRIDGE

STATE OF HAWAII

DEPARTMENT OF TRANSPORTATION

HIGHWAYS DIVISION

HONOLULU, HAWAII

"AS BUILT"

PLANS FOR

CONSTRUCTION OF A PORTION OF INTERSTATE HIGHWAY (LUNALILO FREEWAY)

KOKO HEAD AVENUE TO 17TH AVENUE

FEDERAL AID INTERSTATE PROJECT NO. I-HI-1(6) UNIT I

GRADING AND STRUCTURES

DISTRICT OF HONOLULU

ISLAND OF OAHU

SCALES:

PLAN & PROFILE	HOR.	1" = 50'
	VER.	1" = 10'
DETAIL ROADWAY PLAN		1" = 20'
CROSS SECTION	HOR.	1" = 10'
	VER.	1" = 10'

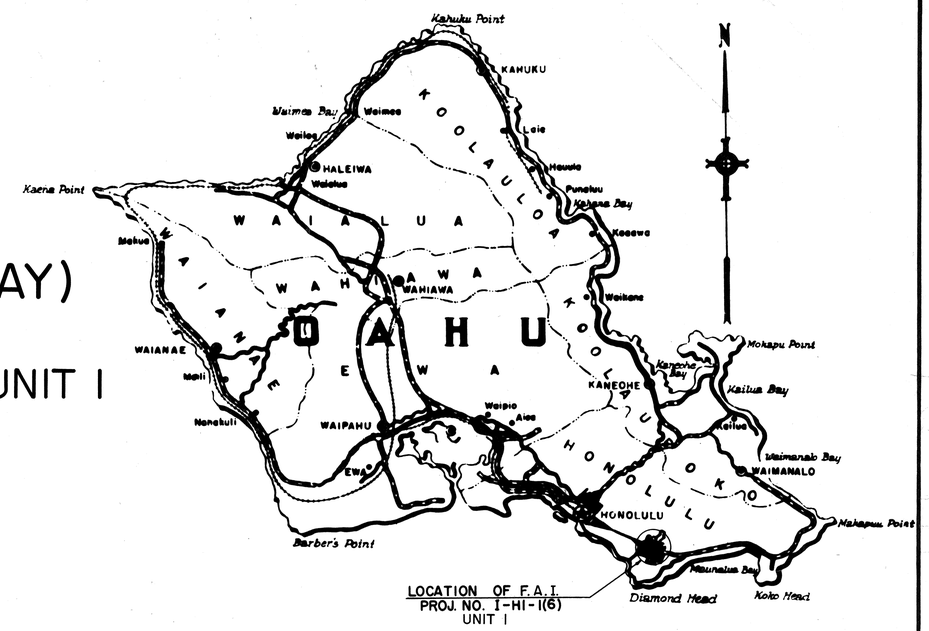

LOCATION OF F.A.I. PROJ. NO. I-HI-1(6) UNIT I

Federal Aid Projects Previously Constructed Or Under Construction

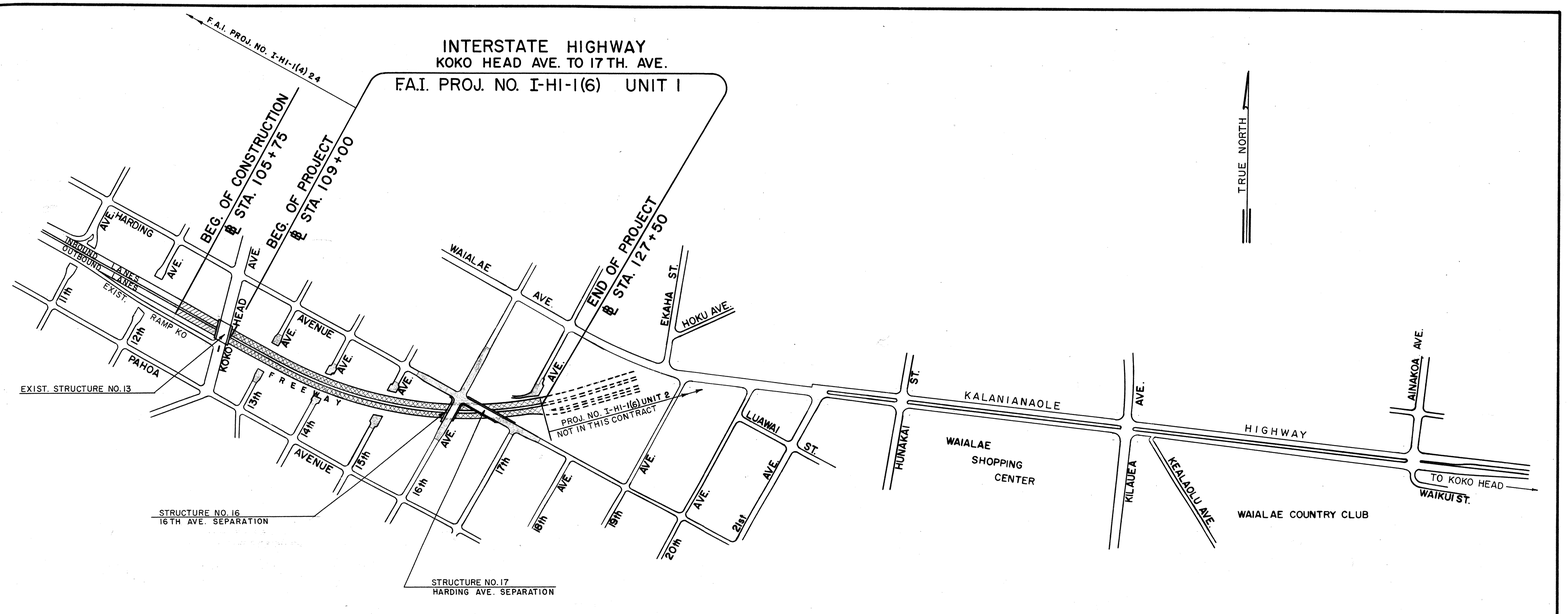

LAYOUT PLAN
Scale: 1" = 400'

GROSS AND NET LENGTH OF PROJECT ..... 0.350 Mi.

LEGEND

- ROADWAY AREAS TO BE PAVED AND COMPLETED.
- ROADWAY AREAS TO BE GRADED ONLY.
- EXISTING GRADED ROADWAY AREAS TO REMAIN.

DESIGN CLASSIFICATION

DESIGN ADT (1975) 49,200
DHV ..... 10 %
D 70/30
T ..... 3 %
V ..... 50 M.P.H.

NOTE:

ALL CHANGES MADE DURING CONSTRUCTION HAVE BEEN NOTED ON THESE TRACINGS IN RED AND CHECKED BY:

George Y. Kuris
PROJECT ENGINEER

7-3-68
DATE

APPROVED DATE 5-26-65

Kaiko T. Kauka
ACTING DIRECTOR OF TRANSPORTATION

DEPARTMENT OF COMMERCE
BUREAU OF PUBLIC ROADS
APPROVED:
John B. Wilkerson
DIVISION ENGINEER
JUN 24 1965
DATE

ORIGINAL PLAN
SURVEY PLOTTED BY
DESIGNED BY
DRAWN BY
TRACED BY
QUANTITIES CHECKED BY
CHECKED BY R. Oishi
DATE June '65
NOTE BOOK
No.