


FED. ROAD DIST. NO.	STATE	FED. AID PROJ. NO.	FISCAL YEAR	SHEET NO.	TOTAL SHEETS
HAWAII	HAW.	134-1(6)	1965		

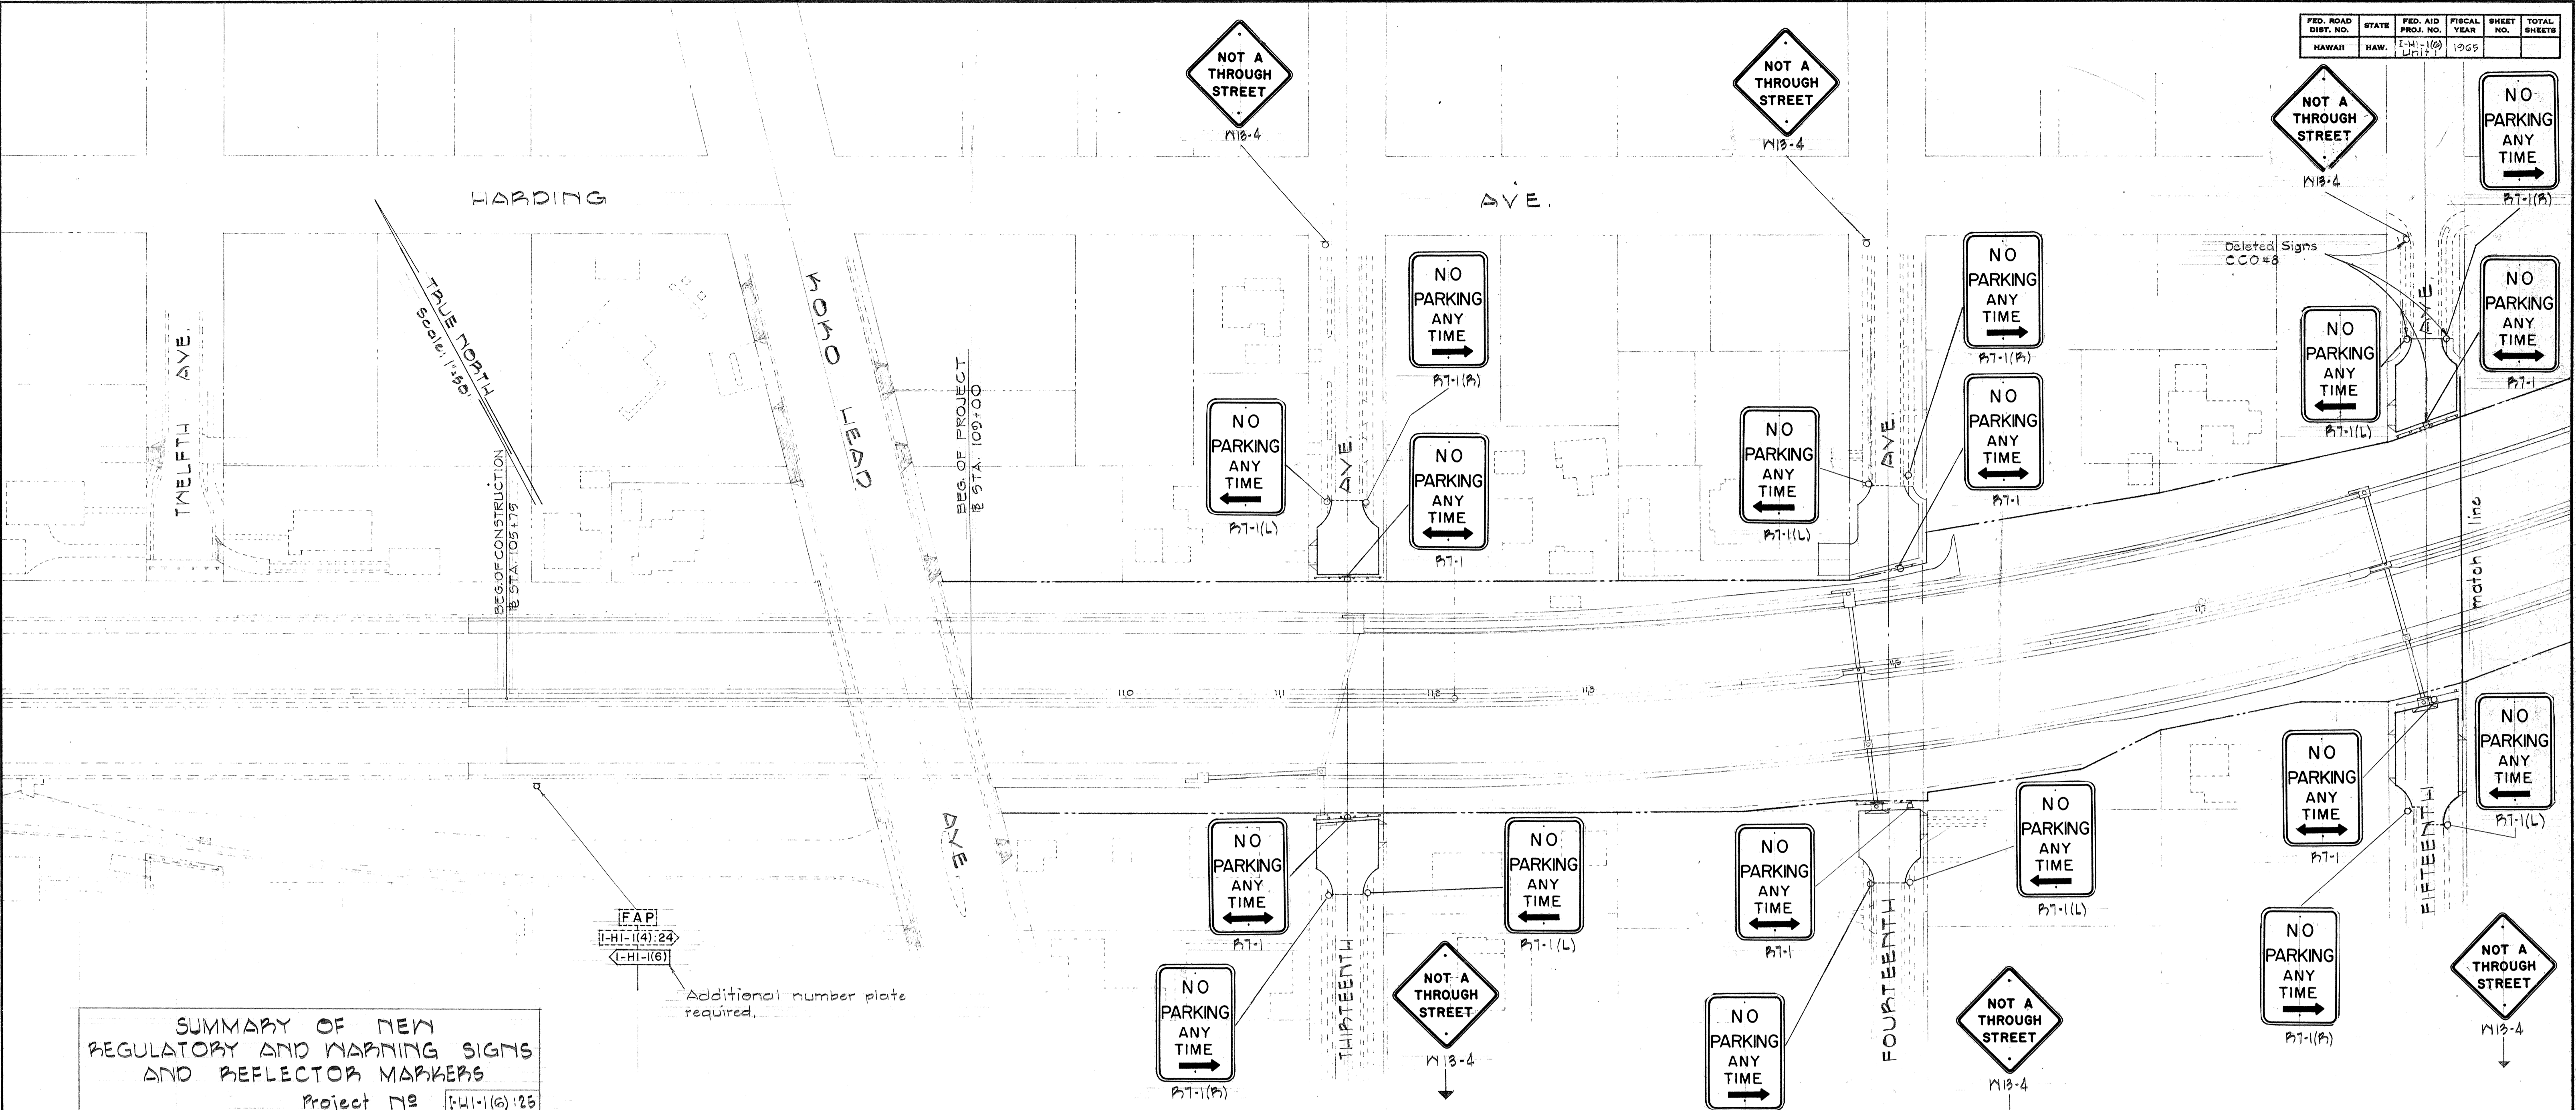

[FAP]
[H-1(4) 24]
[H-1(6)]
Additional number plate required.

SUMMARY OF NEW REGULATORY AND WARNING SIGNS AND REFLECTOR MARKERS

Project No. I-HI-1(6) 25

TYPE	DESCRIPTION	QUANTITY
P1-1	STOP	3
P2-1(55)-I	SPEED LIMIT 55 M.P.H.	—
P7-1	NO PARKING ANYTIME ←→	12
P7-1(P)	NO PARKING ANYTIME →	7
P7-1(L)	NO PARKING ANYTIME ←	7
Y13-3(25)-I	EXIT 25 M.P.H.	—
Y13-4	NOT A THROUGH STREET	7
P1M-2	REFLECTOR MARKER	—
P1M-3	REFLECTOR MARKER	—
MG-1-W-1(3)	CARDINAL DIRECTION MARKER	—
IM-1(3)	INTERSTATE SHIELD	—
TOTAL		43

TRAFFIC SIGN LEGEND

- New sign.
- Existing sign to remain unless otherwise noted.
- Sign mounted on galvanized iron pipe.
- Sign mounted on two galvanized iron pipe.
- Sign mounted on highway lighting standard, traffic signal standard or utility pole.
- Reflectorized markers on galvanized channel.
- Overhead Expressway sign (one sign)

GENERAL NOTES

1. Exact location of signs to be determined in the field by the Engineer.
2. Existing signs not incorporated into the new traffic sign layout shall be removed, unless otherwise noted (All costs incidental to the item of "Installation of signs.")
3. Signs noted NIC are not part of this contract and shall not be installed.
4. For locations of Construction Identification Signs, see sheet Nos. 6 and 7.


STATE OF HAWAII
DEPARTMENT OF TRANSPORTATION
HIGHWAYS DIVISION

**TRAFFIC SIGNS
LAYOUT PLAN**

INTERSTATE HIGHWAY (LUNALILO FWY)
Koko Head Avenue to 17th Avenue.
F. A. I. Project No. I-HI-1(6) UNIT 1

SURVEY PLOTTED BY _____ DATE _____
 DRAWN BY _____
 DESIGNED BY _____
 QUANTITIES BY _____
 CHECKED BY _____
 No. _____

FED. ROAD DIST. NO.	STATE	FED. AID PROJ. NO.	FISCAL YEAR	SHEET NO.	TOTAL SHEETS
HAWAII	HAW.	1-11-1(6)	1965		

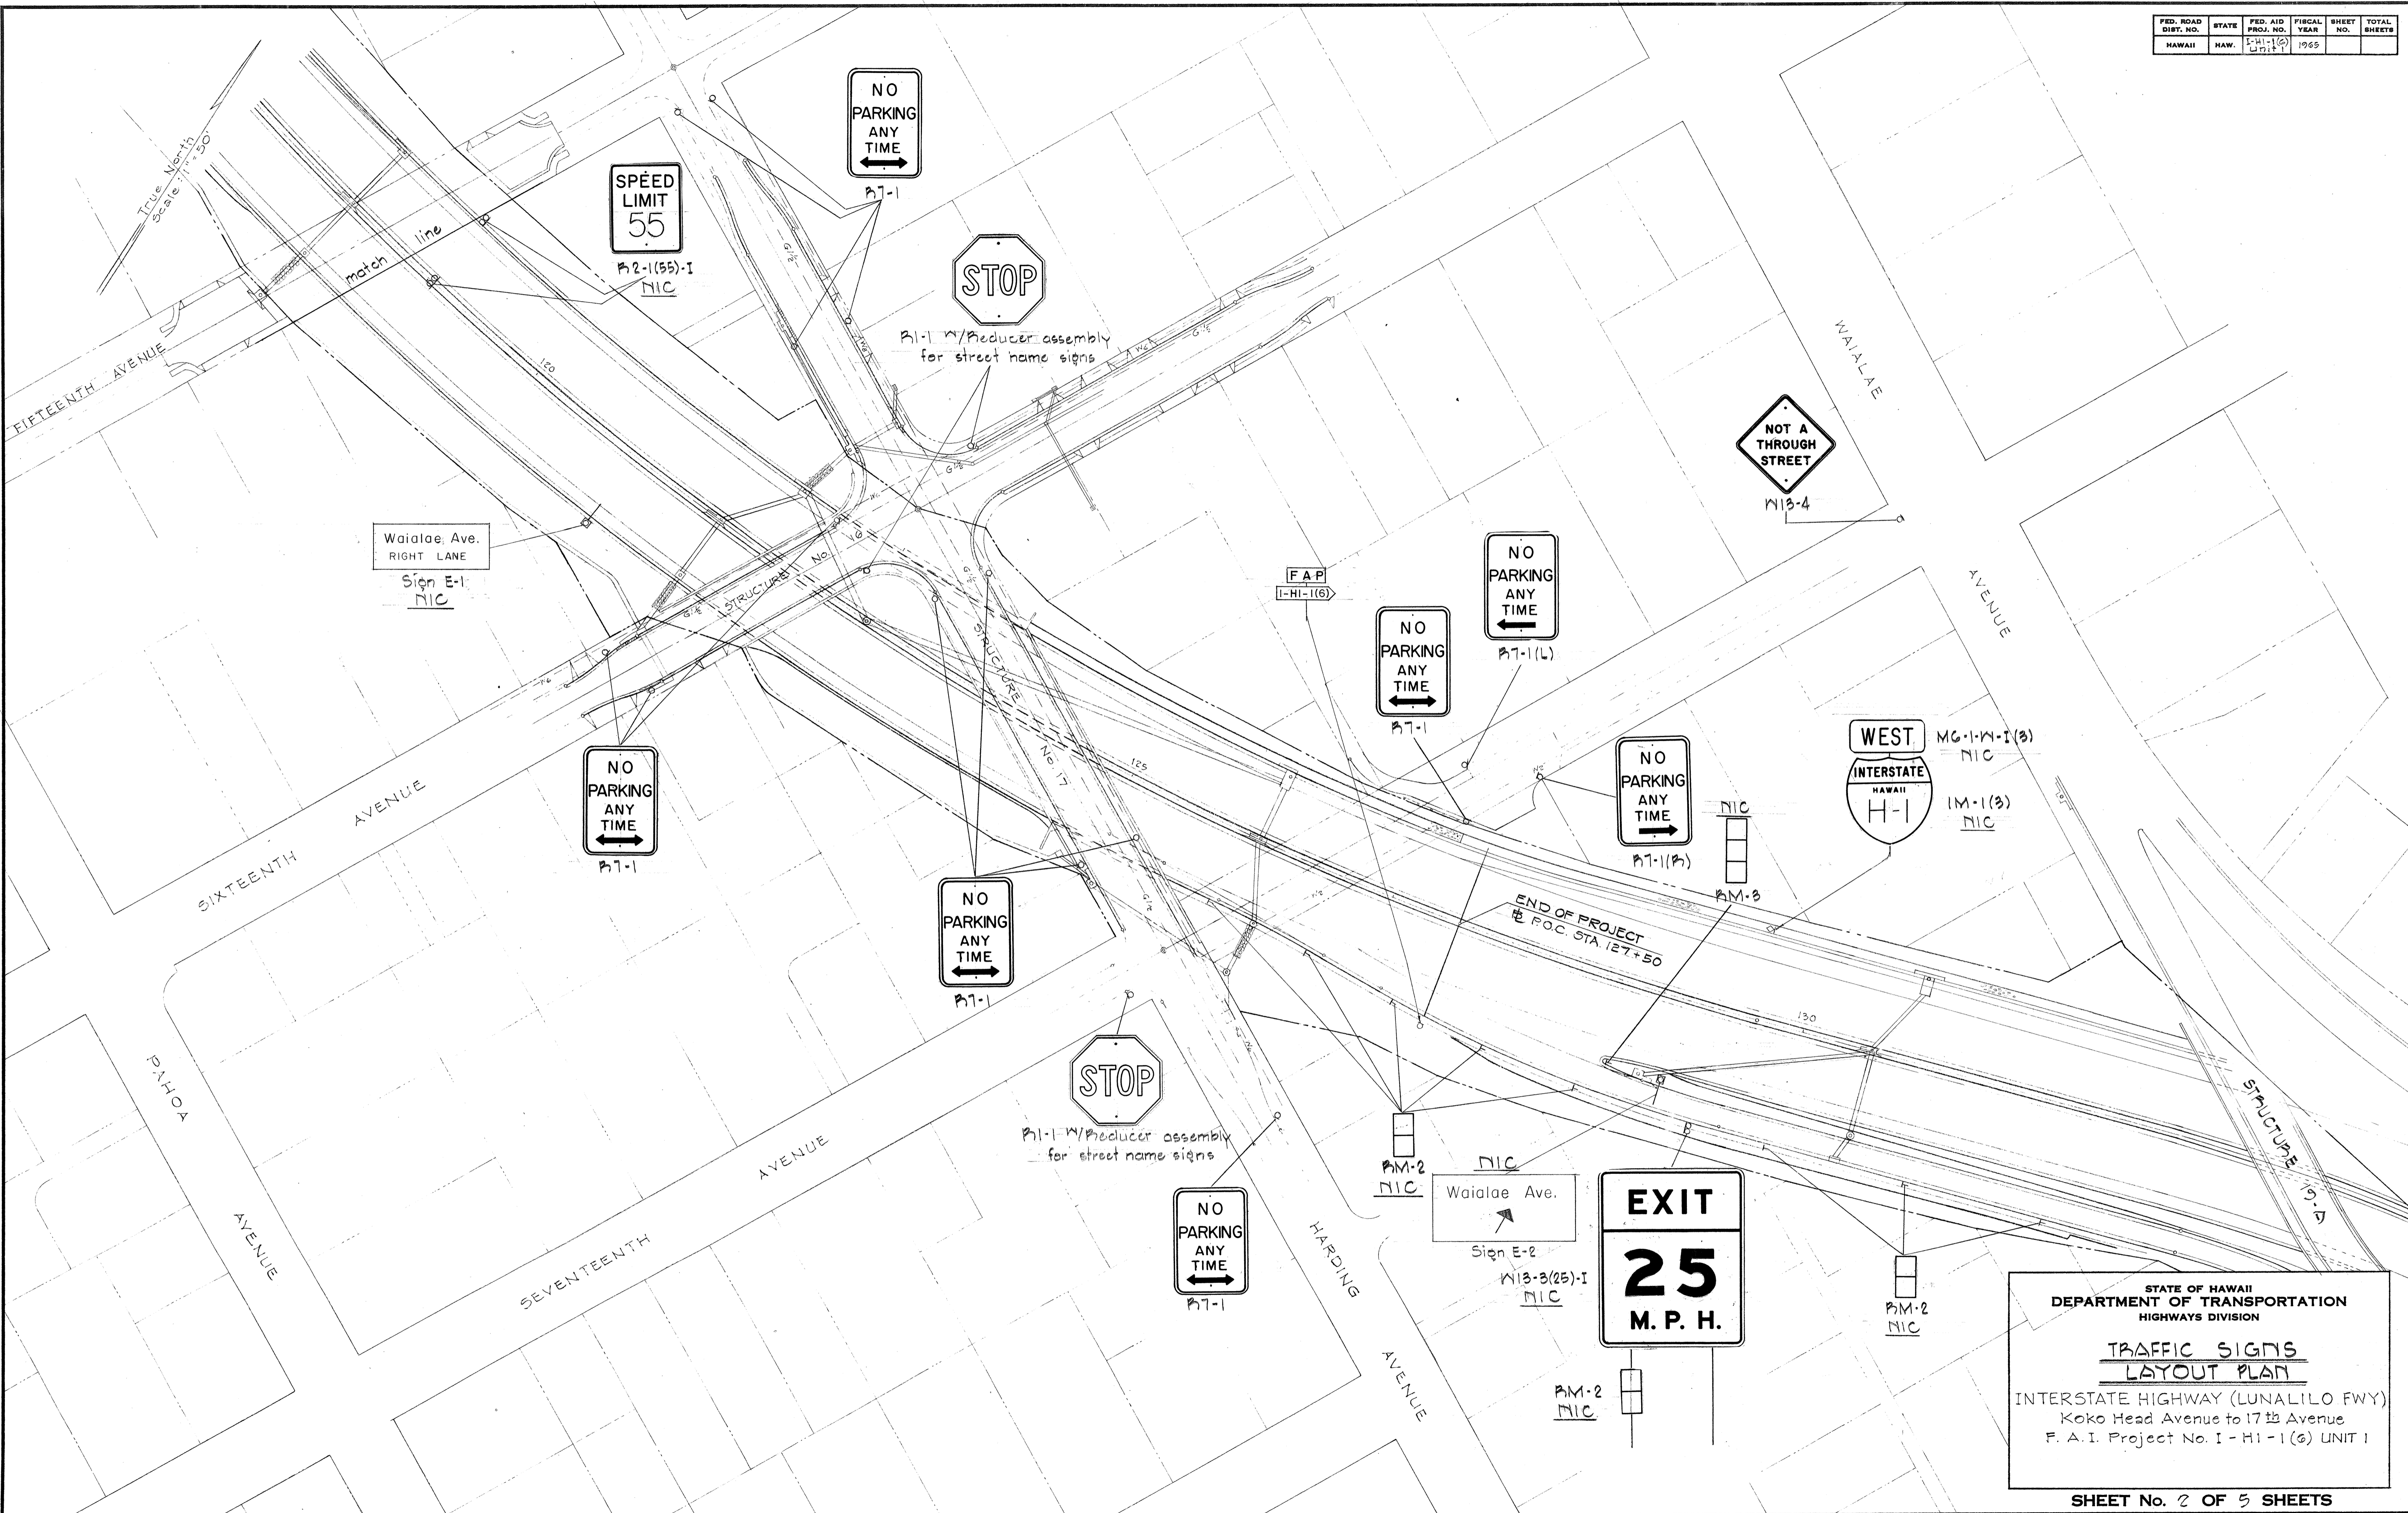

SURVEY PLOTTED BY	DATE
DRAWN BY	
DESIGNED BY	
QUANTITIES BY	
CHECKED BY	
NOTE BOOK	
No.	

STATE OF HAWAII
DEPARTMENT OF TRANSPORTATION
HIGHWAYS DIVISION

**TRAFFIC SIGNS
LAYOUT PLAN**

INTERSTATE HIGHWAY (LUNALILO FWY)
Koko Head Avenue to 17th Avenue
F. A. I. Project No. I - H1 - 1 (6) UNIT 1

PRINTED ON NO. 1000H CLEARPRINT