FED. ROAD DIST. No.	STATE	FED. AID PROJ. No.	FISCAL YEAR	SHEET No.	TOTAL SHEETS
HAWAII	HAW.	I-HI-1(27)	1966	32	33

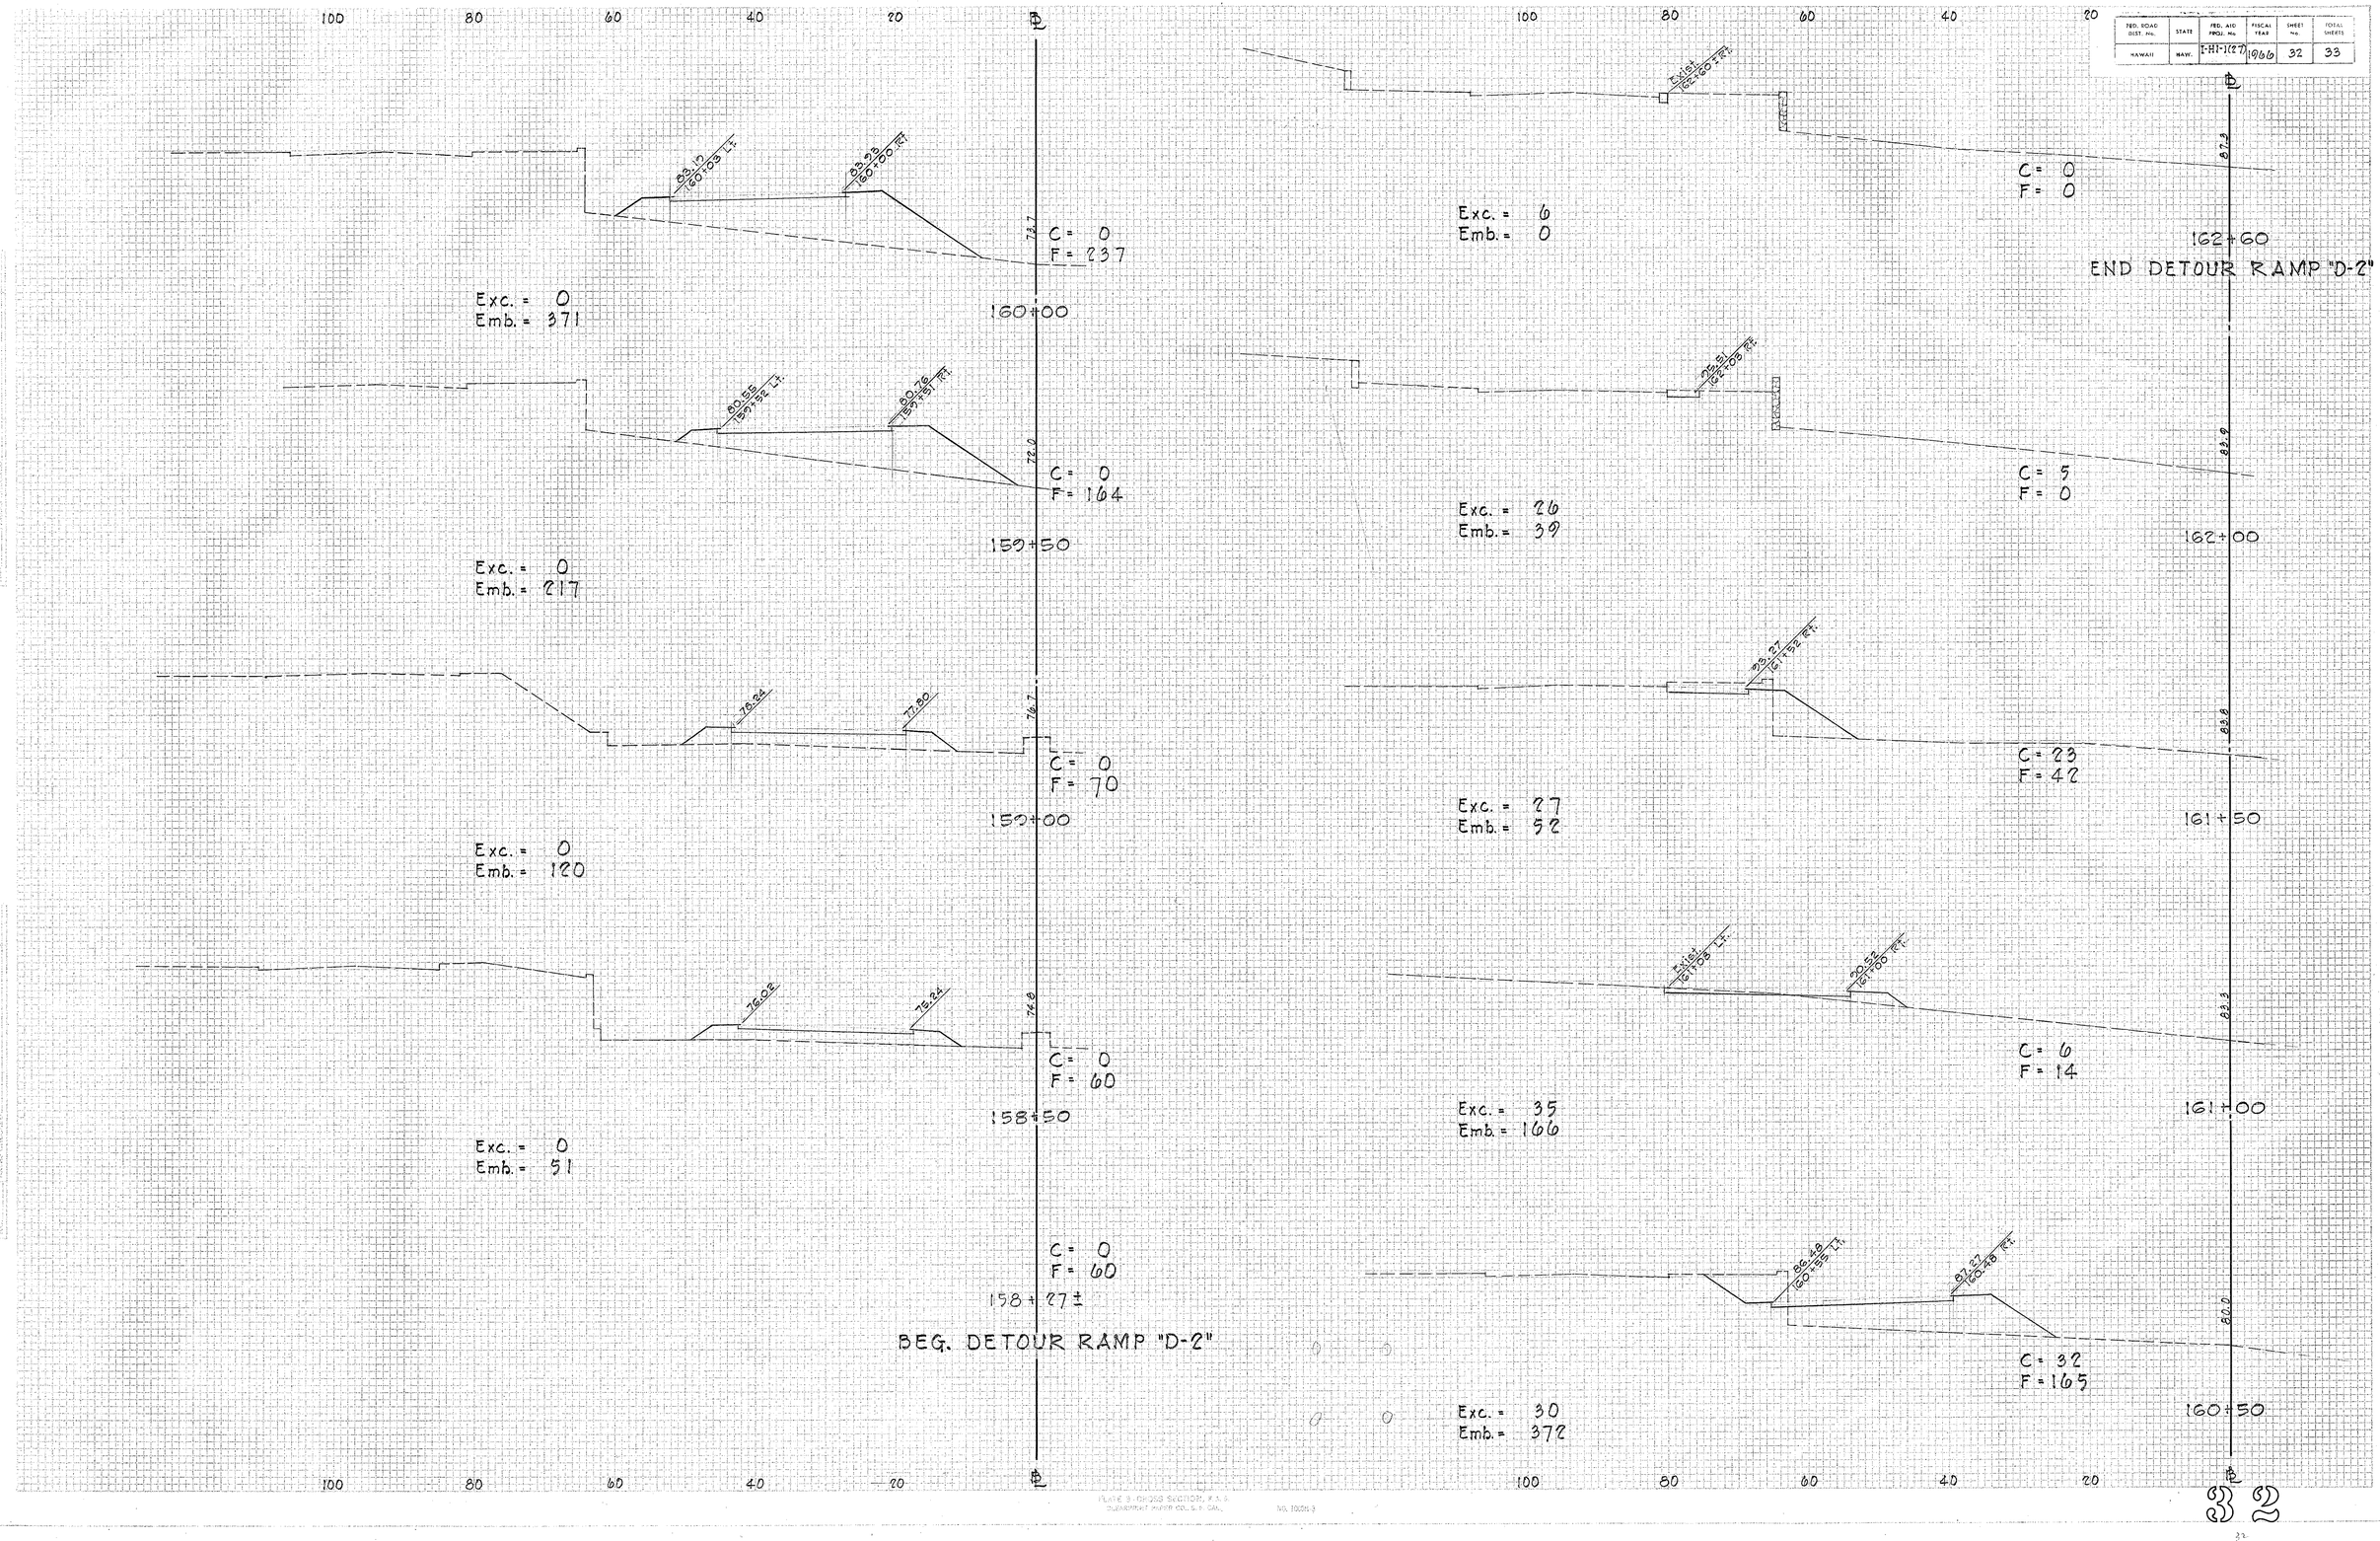

PLATE 9-CROSS SECTION, F.A.S.
DEPARTMENT PUBLIC WORKS, STATE OF CAL.

NO. 10004-9

FED. ROAD DIST. No.	STATE	FED. AID PROJ. No.	FISCAL YEAR	SHEET No.	TOTAL SHEETS
HAWAII	HAW.	I-HI-1(27)	1986	33	33

Exc.= 43

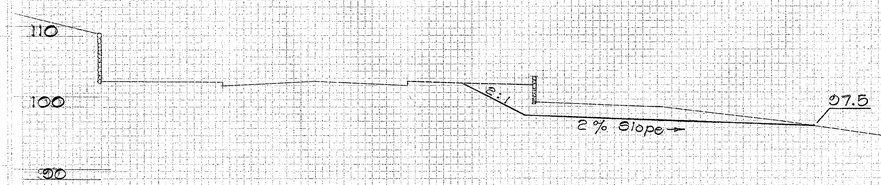

Exc.= 235

165 + 75 C=0

165 + 50 C= 92

Exc.= 210

165 + 00 C = 162

Exc.= 36

164 + 60 C=122

164 + 45 C= 6

BORROW SITE No. 1

Exc.= 398

163 + 50 C=0

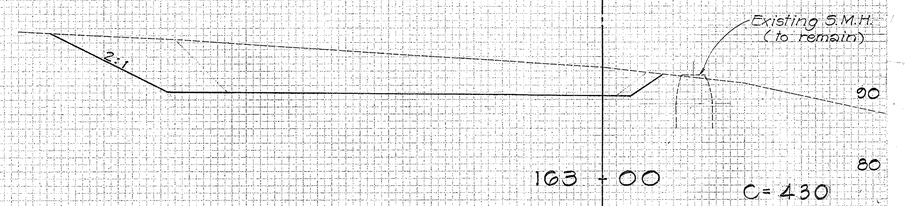

163 + 00 C= 430

Exc.= 279

NOTE:

2:1 Cut Slopes shown on this sheet are finish Cut Slopes for future Project No. I-HI-1(31), Unit 1, and are to be finished in conformity to the requirements for Class "A" Excavation, Article 13.2 (E) of the Standard Specifications.

162 + 65 C= 0

BORROW SITE No. 2