FED ROAD DIST. NO	STATE	FED. AID PROJ. NO.	FISCAL YEAR	SHEET NO.	TOTAL SHEETS
HAWAII	HAW.	I-HI-I(32):5 Unit 1	1966	1	73

INDEX TO DRAWINGS

COMPOSITE SHEET NO.	DESCRIPTION	SET SHT. NO.
36	TITLE SHEET	1
37 - 39	TYPICAL SECTIONS	2 - 4
40 - 43	PLAN AND PROFILE	5 - 8
44 - 47	PROFILES AND SUPER ELEVATION DIAGRAMS	9 - 12
48 - 49	DETAIL PLAN OF ROADWAY	13 - 14
7 - 13, 50	MISC. ROADWAY DETAILS	15
42 - 43, 51 - 69	DRAINAGE PLANS AND DETAILS	7 - 8, 16 - 34
	GRADE SEPARATION STRUCTURES	
70 - 79	STRUCTURE NO. 360	35 - 44
80 - 90	MILITARY ACCESS ROAD	45 - 55
27 - 35	STRUCTURE STANDARD DETAILS	
91 - 92	UTILITIES (ELECTRIC)	56 - 57
93 - 105	BASELINE CROSS SECTIONS	58 - 70
106 - 108	CANE HAUL ROAD CROSS SECTIONS	71 - 73
109 - 110	RETAINING WALL DETAILS	74 - 75
85	DELETED	50

STATE OF HAWAII

DEPARTMENT OF TRANSPORTATION
HIGHWAYS DIVISION

HONOLULU, HAWAII

AS BUILT
PLANS FOR
CONSTRUCTION OF A PORTION OF

INTERSTATE ROUTE H-1
KUNIA INTERCHANGE TO WAIKELE STREAM

FEDERAL AID INTERSTATE PROJECT No. I-HI-1(32):5, UNIT 1
AND
FEDERAL AID INTERSTATE PROJECT No. I-HI-1(22):5

DISTRICT OF EWA
ISLAND OF OAHU

SCALES:

PLAN & PROFILE ..... HOR. 1" = 100' 1" = 50'
VER. 1" = 10' 1" = 10'

CROSS SECTION ..... HOR. 1" = 10' 1" = 20'
VER. 1" = 10' 1" = 20'

NOTE:
ALL CHANGES MADE DURING CONSTRUCTION HAVE BEEN NOTED ON THESE TRACINGS IN RED AND CHECKED BY:

Leong Kau — 8-21-68
PROJECT ENGINEER — DATE

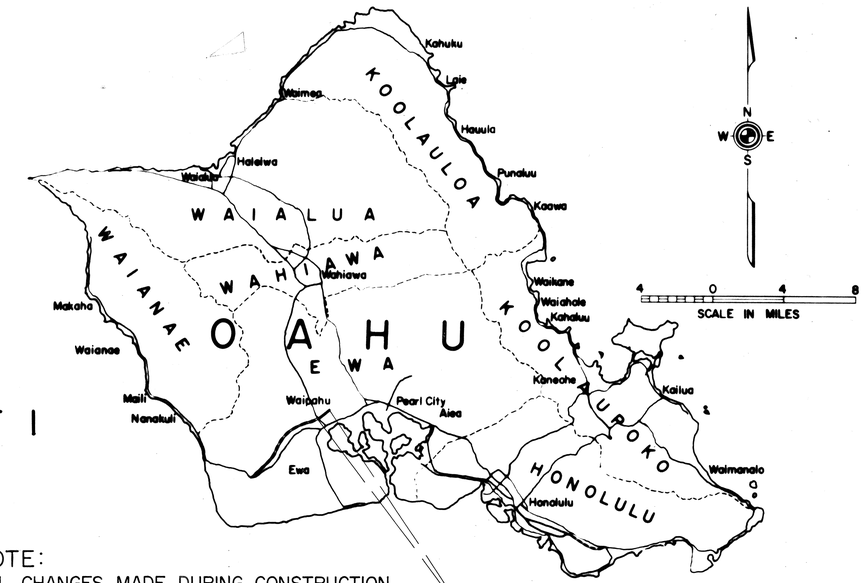

LOCATION OF PROJECT
F.A.I. PROJ. No. I-HI-1(32):5, UNIT 1

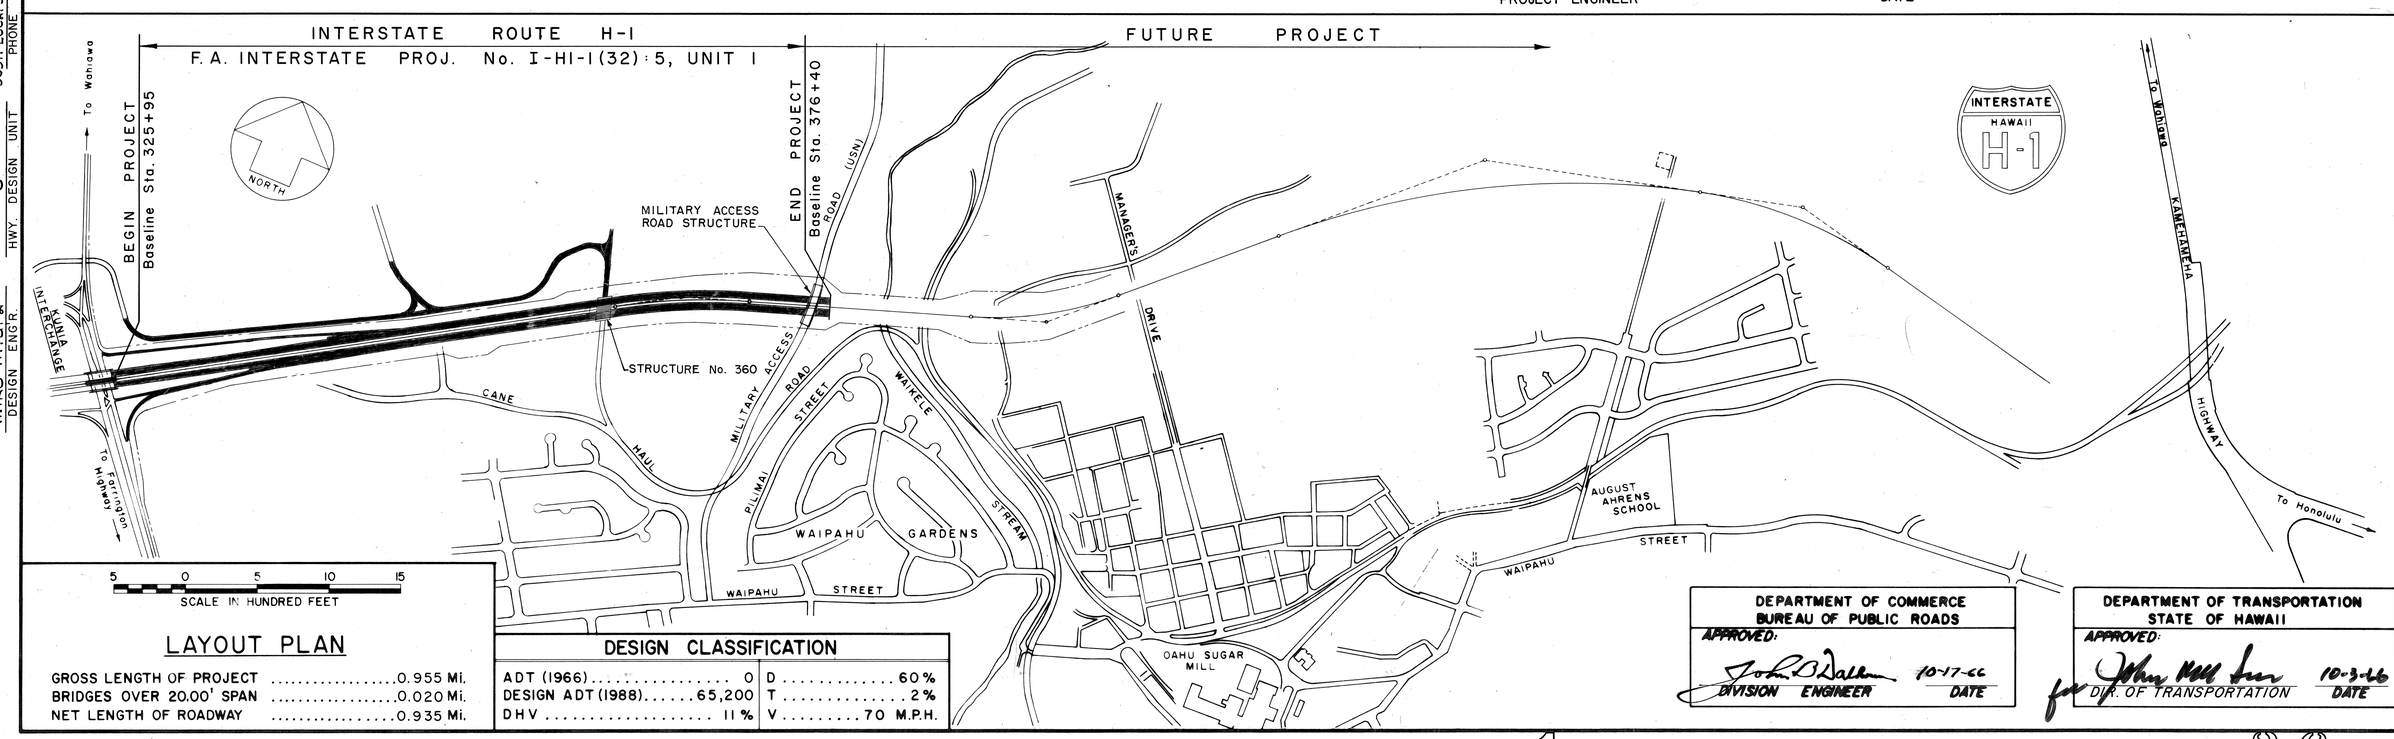

5 0 5 10 15
SCALE IN HUNDRED FEET

LAYOUT PLAN

GROSS LENGTH OF PROJECT	0.955 Mi.
BRIDGES OVER 20.00' SPAN	0.020 Mi.
NET LENGTH OF ROADWAY	0.935 Mi.

DESIGN CLASSIFICATION

ADT (1966)	0	D	60%
DESIGN ADT (1988)	65,200	T	2%
DHV	11%	V	70 M.P.H.

DEPARTMENT OF COMMERCE
BUREAU OF PUBLIC ROADS
APPROVED:
John D. Dalton — 10-17-66
DIVISION ENGINEER — DATE

DEPARTMENT OF TRANSPORTATION
STATE OF HAWAII
APPROVED:
for John Hill Lee — 10-3-66
DIR. OF TRANSPORTATION — DATE

Mike Miura
DESIGN ENGR.
C
HWY. DESIGN UNIT
50511 Local 301
PHONE
April 1966
DATE

36