


TOTAL PLANT LIST			
BOTANICAL NAME	COMMON NAME	QUANTITY	SPECIFICATIONS
Citharexylum spinosum	Cigar Box Wood Tree	10 ea.	4'-0" Tall, 5 gal. con. plant as indicated, stake
Cocos nucifera	Coconut	3 ea.	88 10' plant as indicated
Cyrtanthus donnell smithii	Gold Tree	3 ea.	4'-0" Tall, 5 gal. con. plant as indicated, stake
Tabebuia pentaphylla	Pink Tecoma	12 ea.	4'-0" Tall, 5 gal. con. plant as indicated, stake
Hibiscus cameroni	Pink Hibiscus	328 ea.	2' Tall, 1 gal. con. plant 4' ac.
Ligustrum texanum	Texas Privet	271 ea.	12'-18" Tall, 1 qt. con. plant 6'-8' ac.
Nerium oleander	Pink Oleander	330 ea.	2' Tall, 1 gal. con. plant 4' ac.
Wedelia trilobata	Wedelia	11,291 ea.	10" runners, 1 qt. con. plant 30' ac.
Cynodon dactylon	Bermuda Grass	53,730 #	STD. SPECS.
Dissotis plumosa	Dissotis	3,651 ea.	10" runners, 1 qt. con. plant 30' ac.
Cordia sebestena	Orange Kou	20 ea.	5 g.c., 10'-0" tall
Cassia fistula x javanica	Rainbow Shower Tree	12 ea.	Field stock, 10'-0" tall
Thevetia peruviana	Be-Still	51 ea.	5 g.c. @ random
Cassia glauca	Kalamona	88 ea.	5 g.c. @ random
Allamanda cathartica	Allamanda	2,542 ea.	1 GAL. CAN. PLANT @ 2'-0" EA. WAY

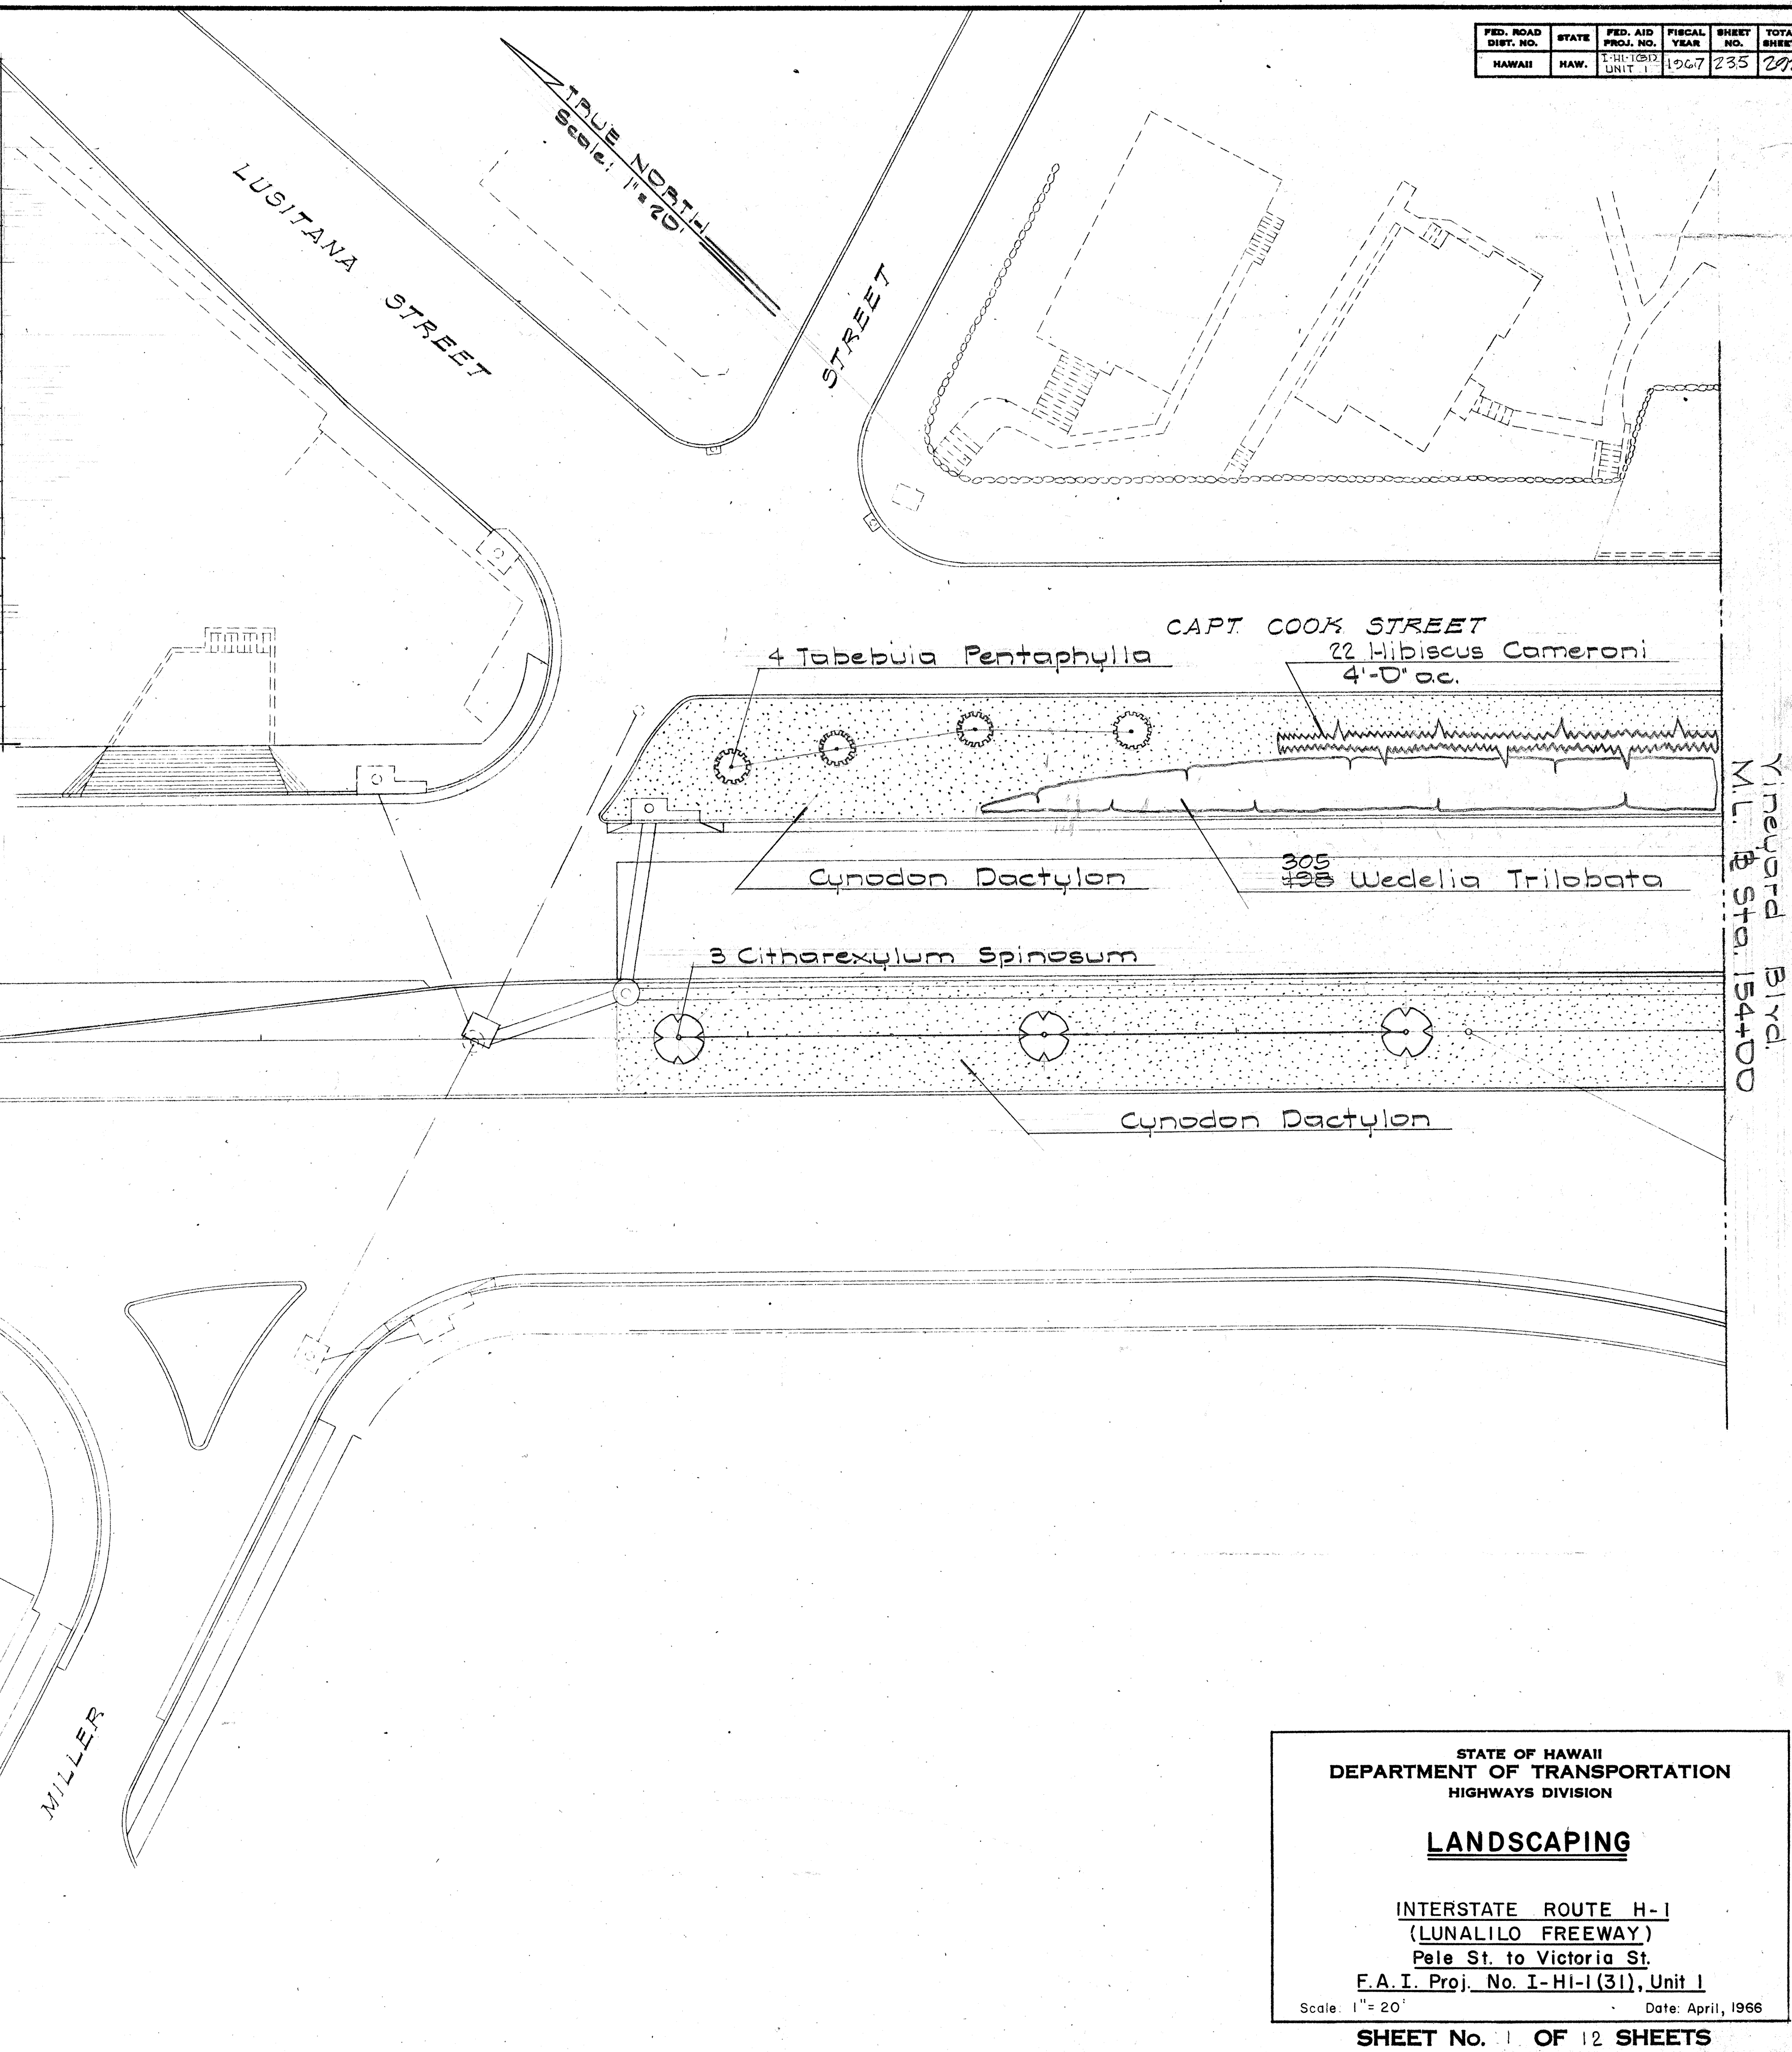

NOTE:
Top soil shall be placed at a depth of 6" for all grassed areas.

Westbound Lanes
Eastbound Lanes

PLANT LIST THIS SHEET		
BOTANICAL NAME	COMMON NAME	QUANTITY
Citharexylum spinosum	Cigar Box Wood Tree	3 ea.
Tabebuia pentaphylla	Pink Tecoma	4 ea.
Hibiscus cameroni	Pink Hibiscus	22 ea.
Wedelia trilobata	Wedelia	305 ea.
Cynodon dactylon	Bermuda Grass	6,860 ea.


SURVEY PLATTED BY
DRAWN BY
CHECKED BY
NOTE BOOK
No.

STATE OF HAWAII
DEPARTMENT OF TRANSPORTATION
HIGHWAYS DIVISION

LANDSCAPING

INTERSTATE ROUTE H-1
(LUNALILO FREEWAY)
Pele St. to Victoria St.
F.A.I. Proj. No. I-HI-1(31), Unit 1
Scale: 1" = 20' Date: April, 1966

SHEET No. 1 OF 12 SHEETS

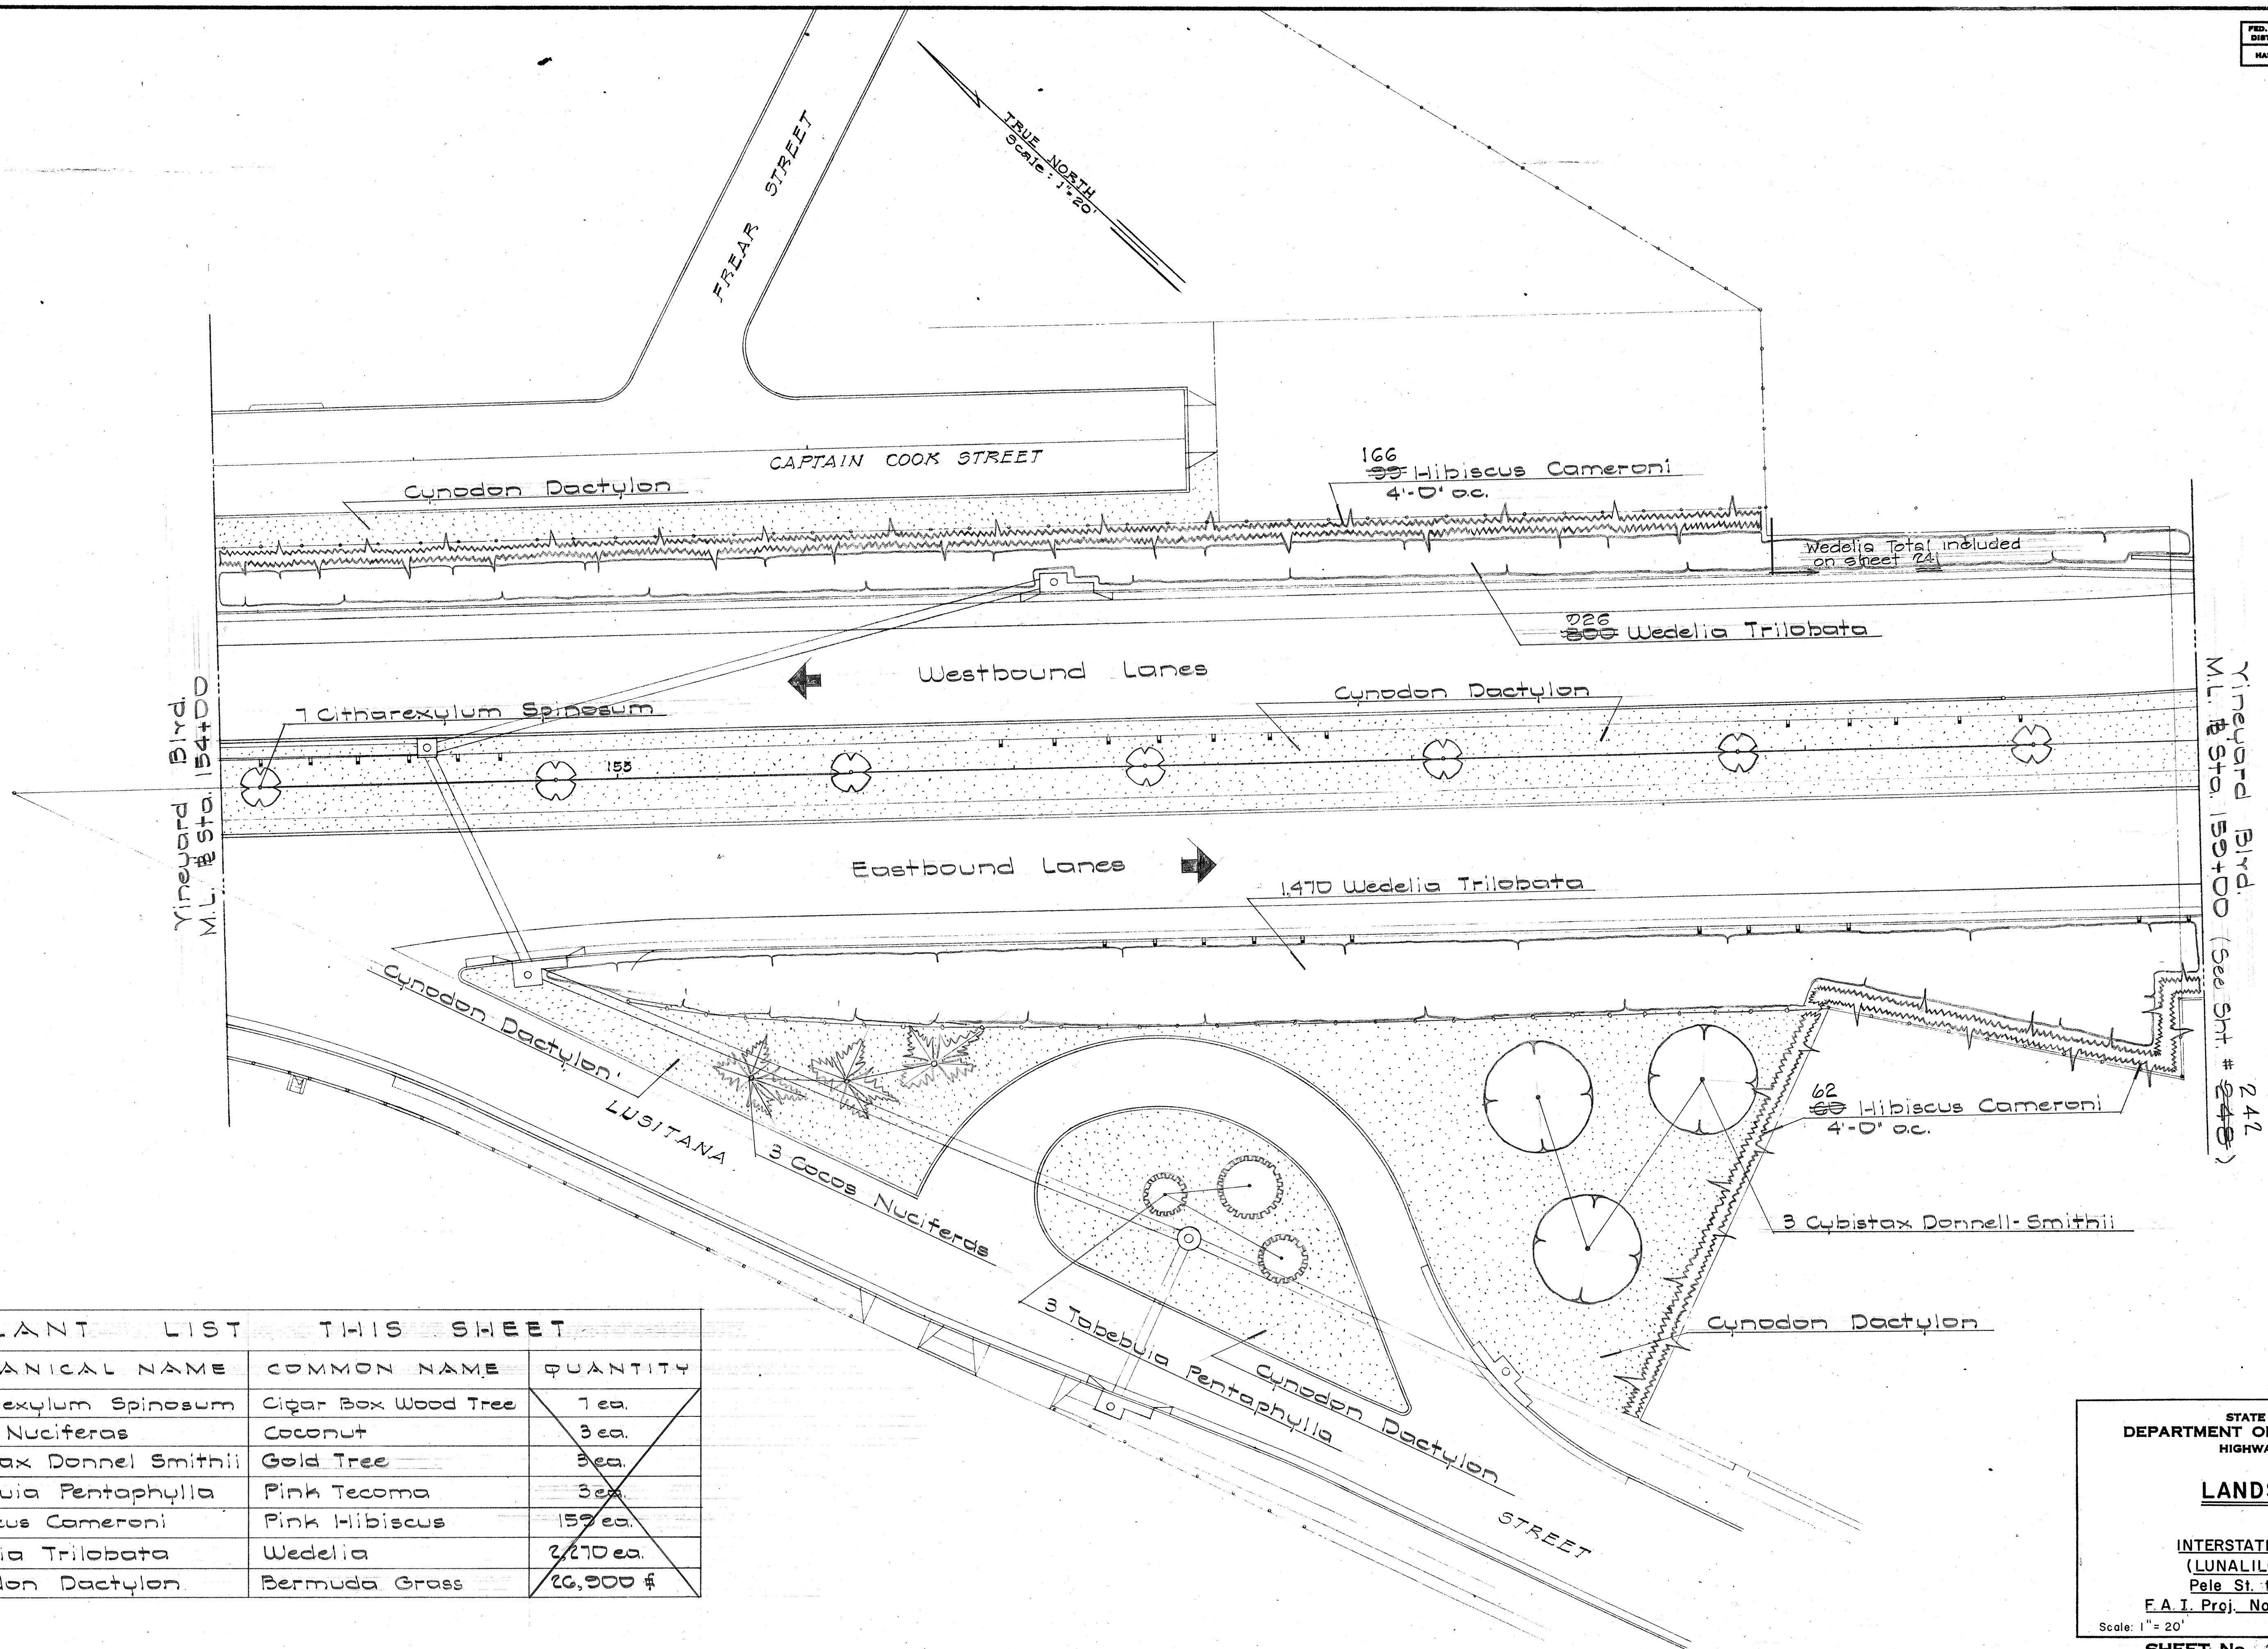

PLANT LIST THIS SHEET		
BOTANICAL NAME	COMMON NAME	QUANTITY
Cocos Nucifera	Coconut	3 ea.
Cybistax Donnell-Smithii	Gold Tree	3 ea.
Tabebuia Pentaphylla	Pink Tecoma	3 ea.
Hibiscus Camerani	Pink Hibiscus	159 ea.
Wedelia Trilobata	Wedelia	2,270 ea.
Cynodon Dactylon	Bermuda Grass	26,900 #

STATE OF HAWAII
DEPARTMENT OF TRANSPORTATION
HIGHWAYS DIVISION

LANDSCAPING

INTERSTATE ROUTE H-1
(LUNALILO FREEWAY)
Pele St. to Victoria St.
F.A.I. Proj. No. I-HI-1(31), Unit 1

Scale: 1" = 20' Date: April, 1966

SHEET No. 2 OF 12 SHEETS


236

DATE: _____
SURVEY PLOTTED BY: _____
DRAWN BY: _____
CHECKED BY: _____
NOTES: _____
PLANT BOOK: _____
No. _____

FED. ROAD DIST. NO.	STATE	FED. AID PROJ. NO.	FISCAL YEAR	SHEET NO.	TOTAL SHEETS
11	HA	11(31)	1967	237	292

ORIGINAL PLAN	SURVEY PLOTTED BY	DATE
DESIGNED BY		
DRAWN BY		
CHECKED BY		
NOTED BY		
QUANTITIES BY		
CHECKED BY		
No.		

MATCH LINE

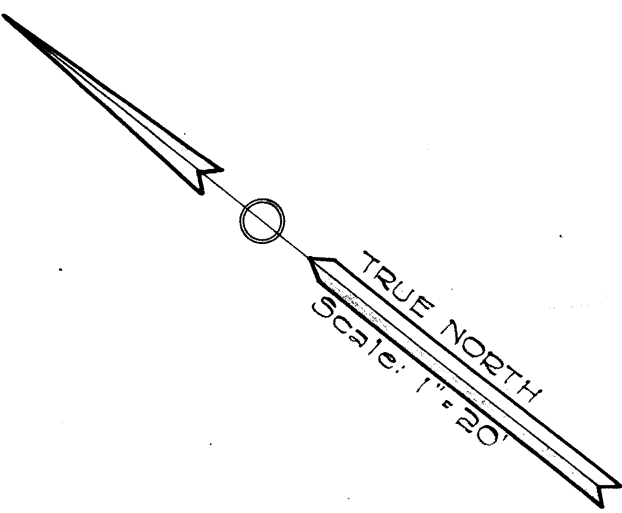


PALI HIGHWAY


BEGIN OF PROJ. I-HI-1(31) UNIT I
Baseline Sta. 144+72

PLANT LIST THIS SHEET		
BOTANICAL NAME	COMMON NAME	QUANTITY
Ligustrum Texanum	Texas Privet	50 ea.

STATE OF HAWAII
DEPARTMENT OF TRANSPORTATION
HIGHWAYS DIVISION
LANDSCAPING
INTERSTATE ROUTE H-1
(LUNALILO FREEWAY)
Pele St. to Victoria St.
F.A. I. Proj. No. I-HI-1(31), Unit I
SCALE: 1" = 20' April 1966
SHEET NO. 3 OF 12 SHEETS

MATCH LINE
Sta. 145+00

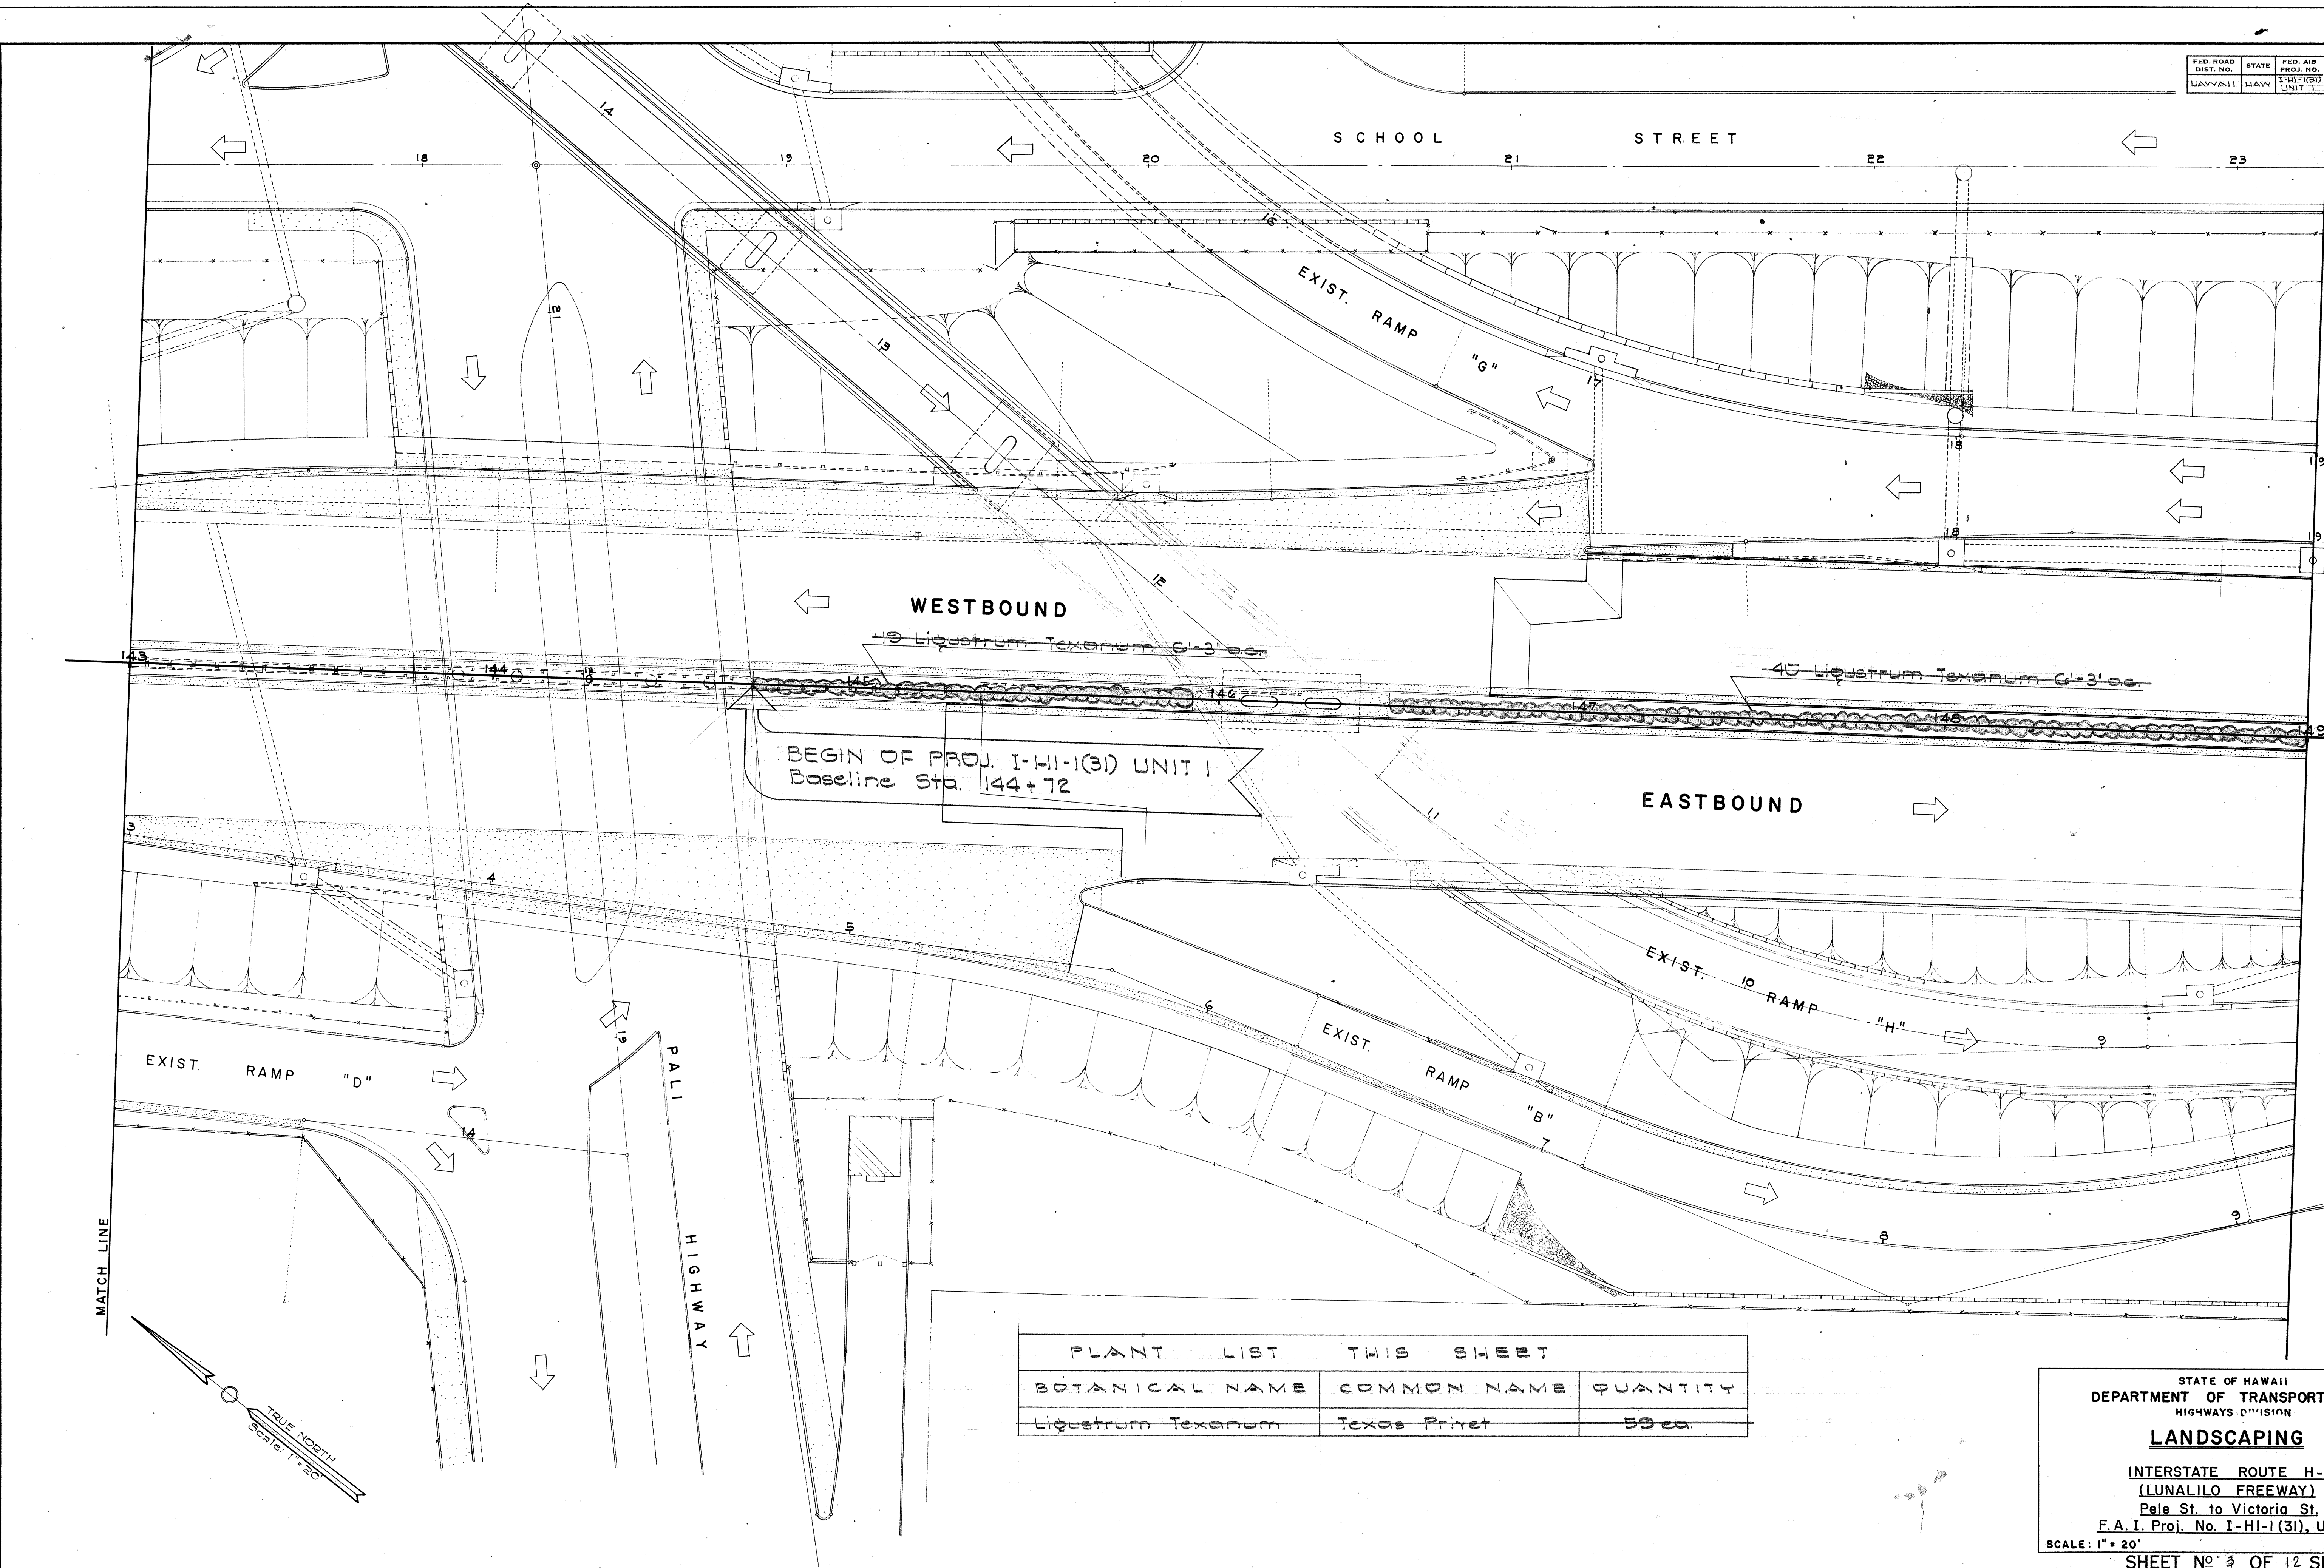

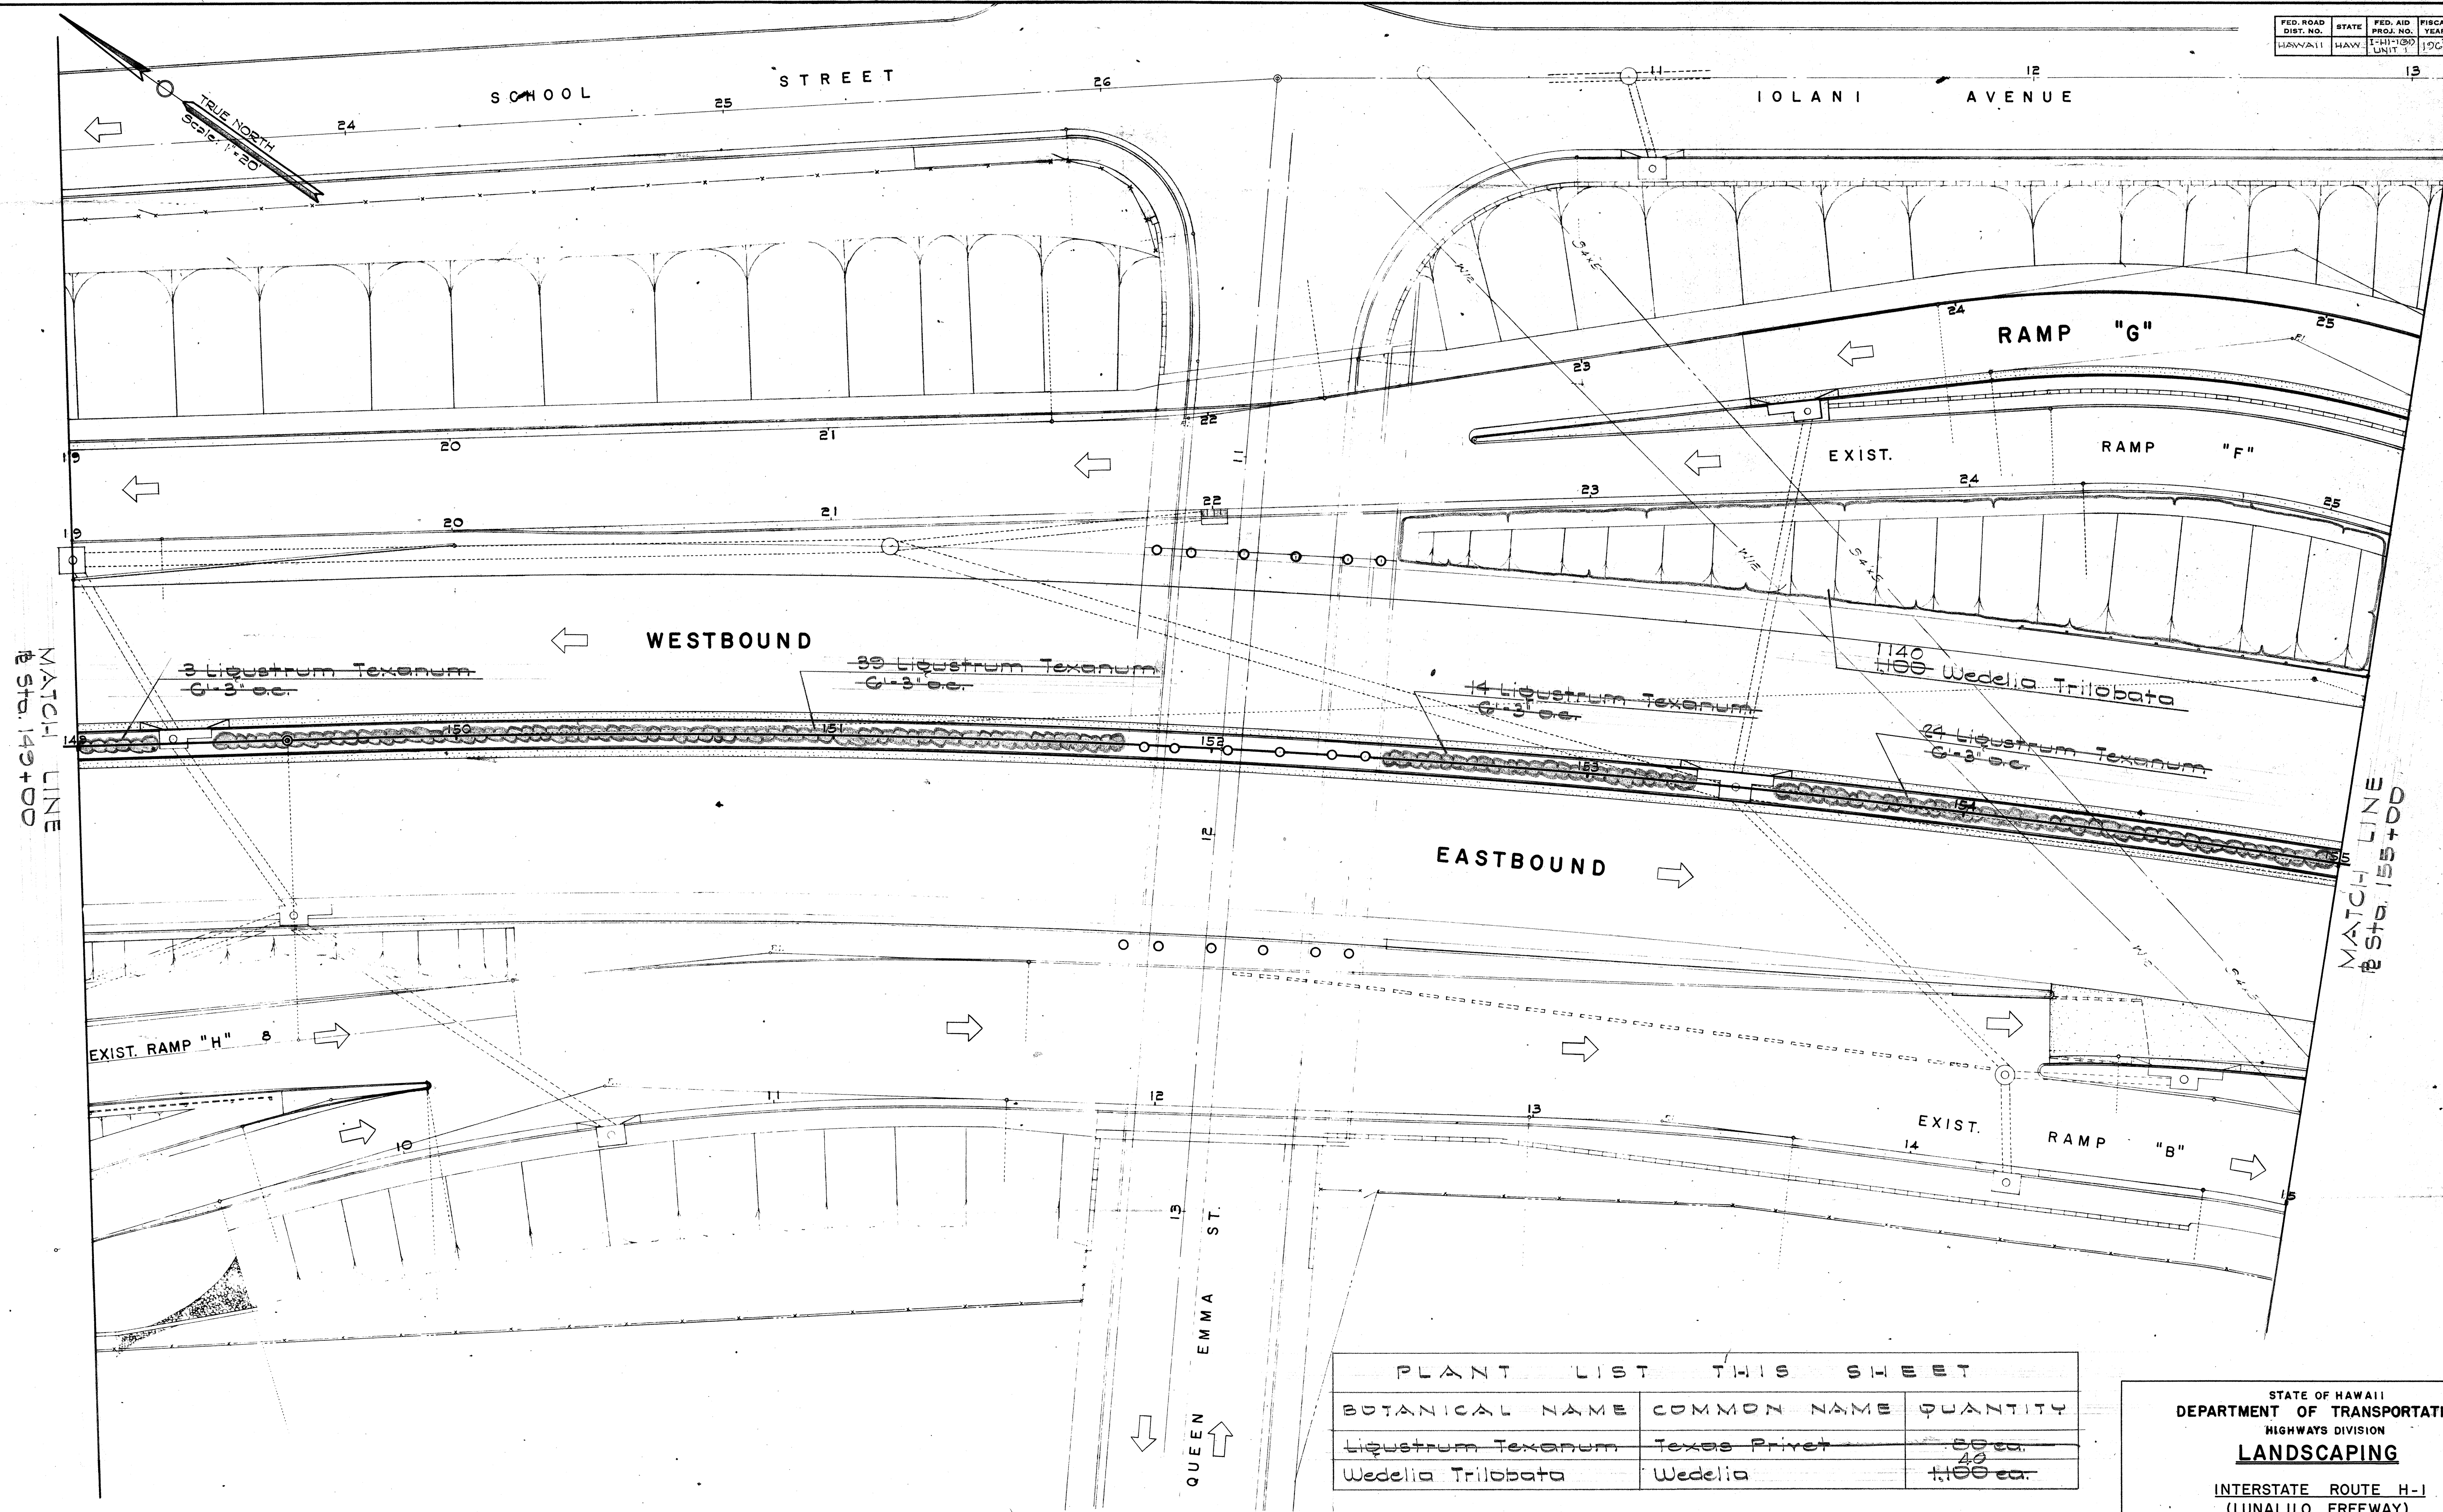


PLANT LIST THIS SHEET		
BOTANICAL NAME	COMMON NAME	QUANTITY
Wedelia Trilobata	Wedelia	1,100 ea.

STATE OF HAWAII
DEPARTMENT OF TRANSPORTATION
HIGHWAYS DIVISION
LANDSCAPING
INTERSTATE ROUTE H-1
(LUNALILO FREEWAY)
Pele St. to Victoria St.
F.A.I. Proj. No. I-H-1 (31), Unit I
SCALE: 1" = 20' April 1966
SHEET NO. 4 OF 12 SHEETS

ORIGINAL SURVEY PLOTTED BY: DATE: _____
PLAN DRAWN BY: _____
NOTE BOOK TRACED BY: _____
QUANTITIES BY: _____
CHECKED BY: _____

TRUE NORTH
Scale: 1" = 20'

PLANT LIST THIS SHEET		
BOTANICAL NAME	COMMON NAME	QUANTITY
Nerium Oleander	Pink Oleander	60 ea.
Ligustrum Texanum	Texas Privet	62 ea.
Wedelia Trilobata	Wedelia	525 ea.
Cynodon Dactylon	Bermuda Grass	800 sq. ft.
Dissotis Plumosa	Dissotis	204 ea.

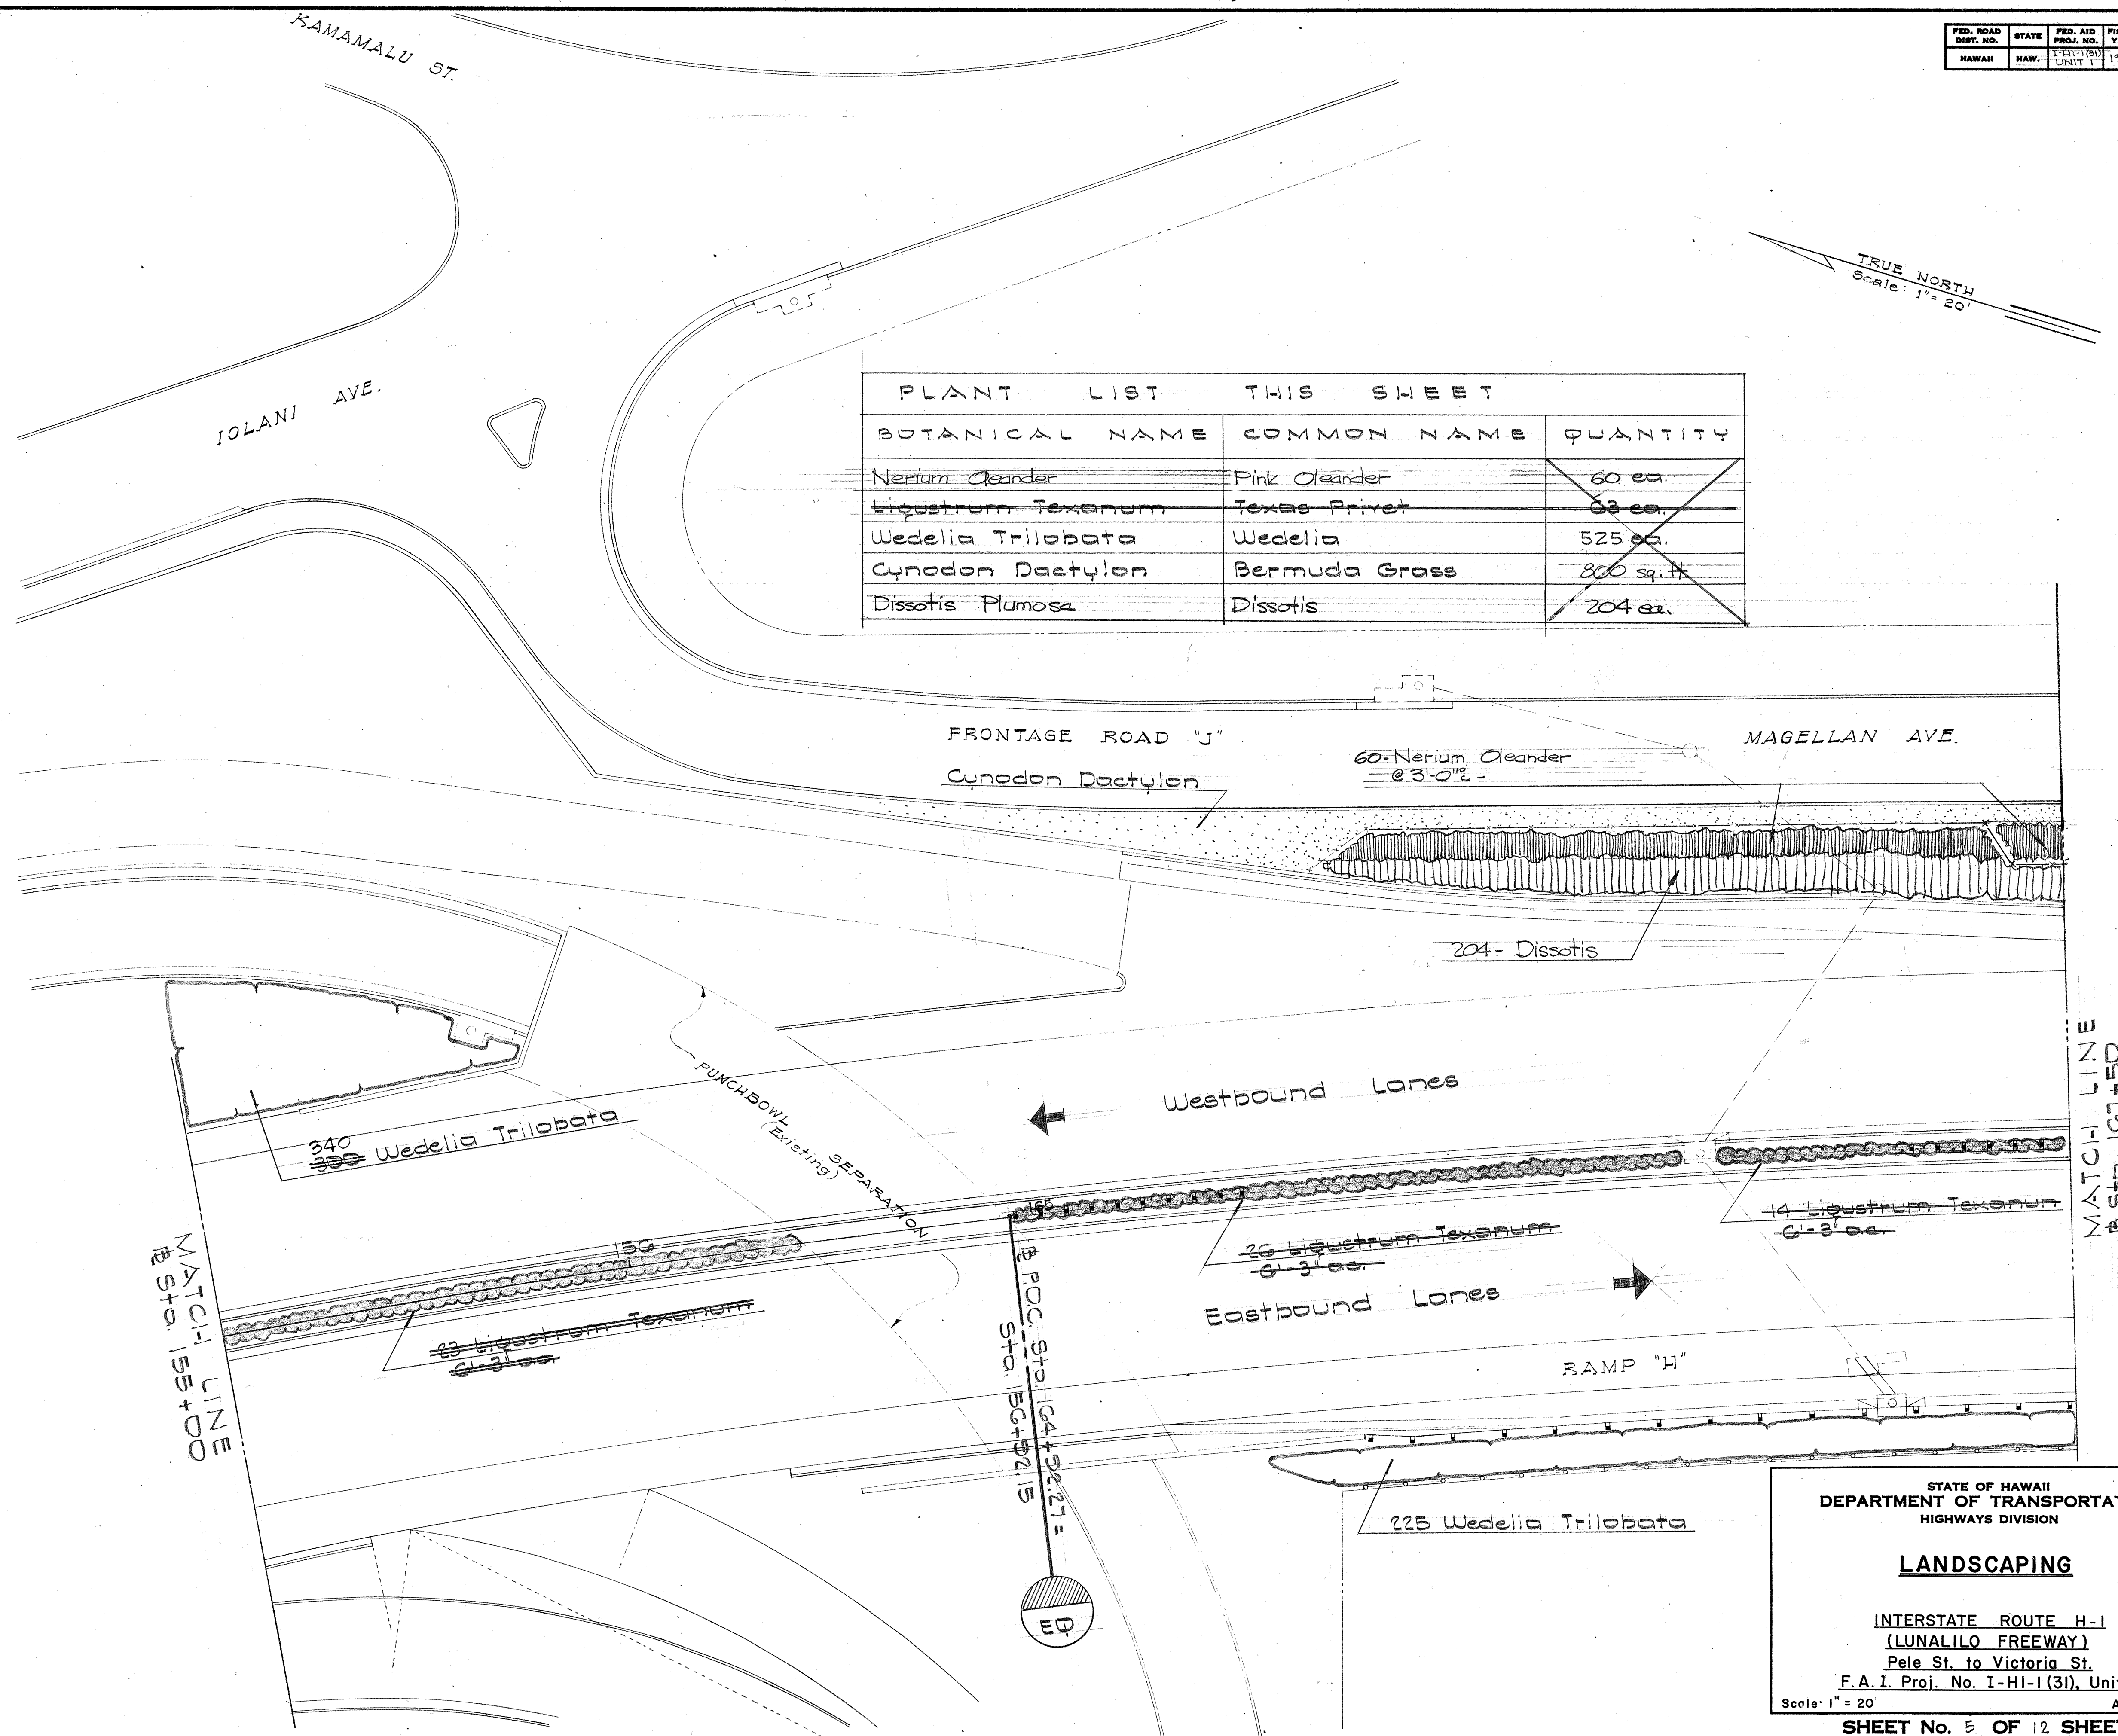

DATE: _____
 SURVEY PLOTTED BY: _____
 DESIGNED BY: _____
 CHECKED BY: _____
 ORIGINAL PLAN: _____
 NOTE BOOK: _____
 NO. _____


STATE OF HAWAII
 DEPARTMENT OF TRANSPORTATION
 HIGHWAYS DIVISION

LANDSCAPING

INTERSTATE ROUTE H-1
 (LUNALILO FREEWAY)
 Pele St. to Victoria St.
 F.A.I. Proj. No. I-HI-1(31), Unit 1

Scale: 1" = 20' April 1966

SHEET NO. 5 OF 12 SHEETS

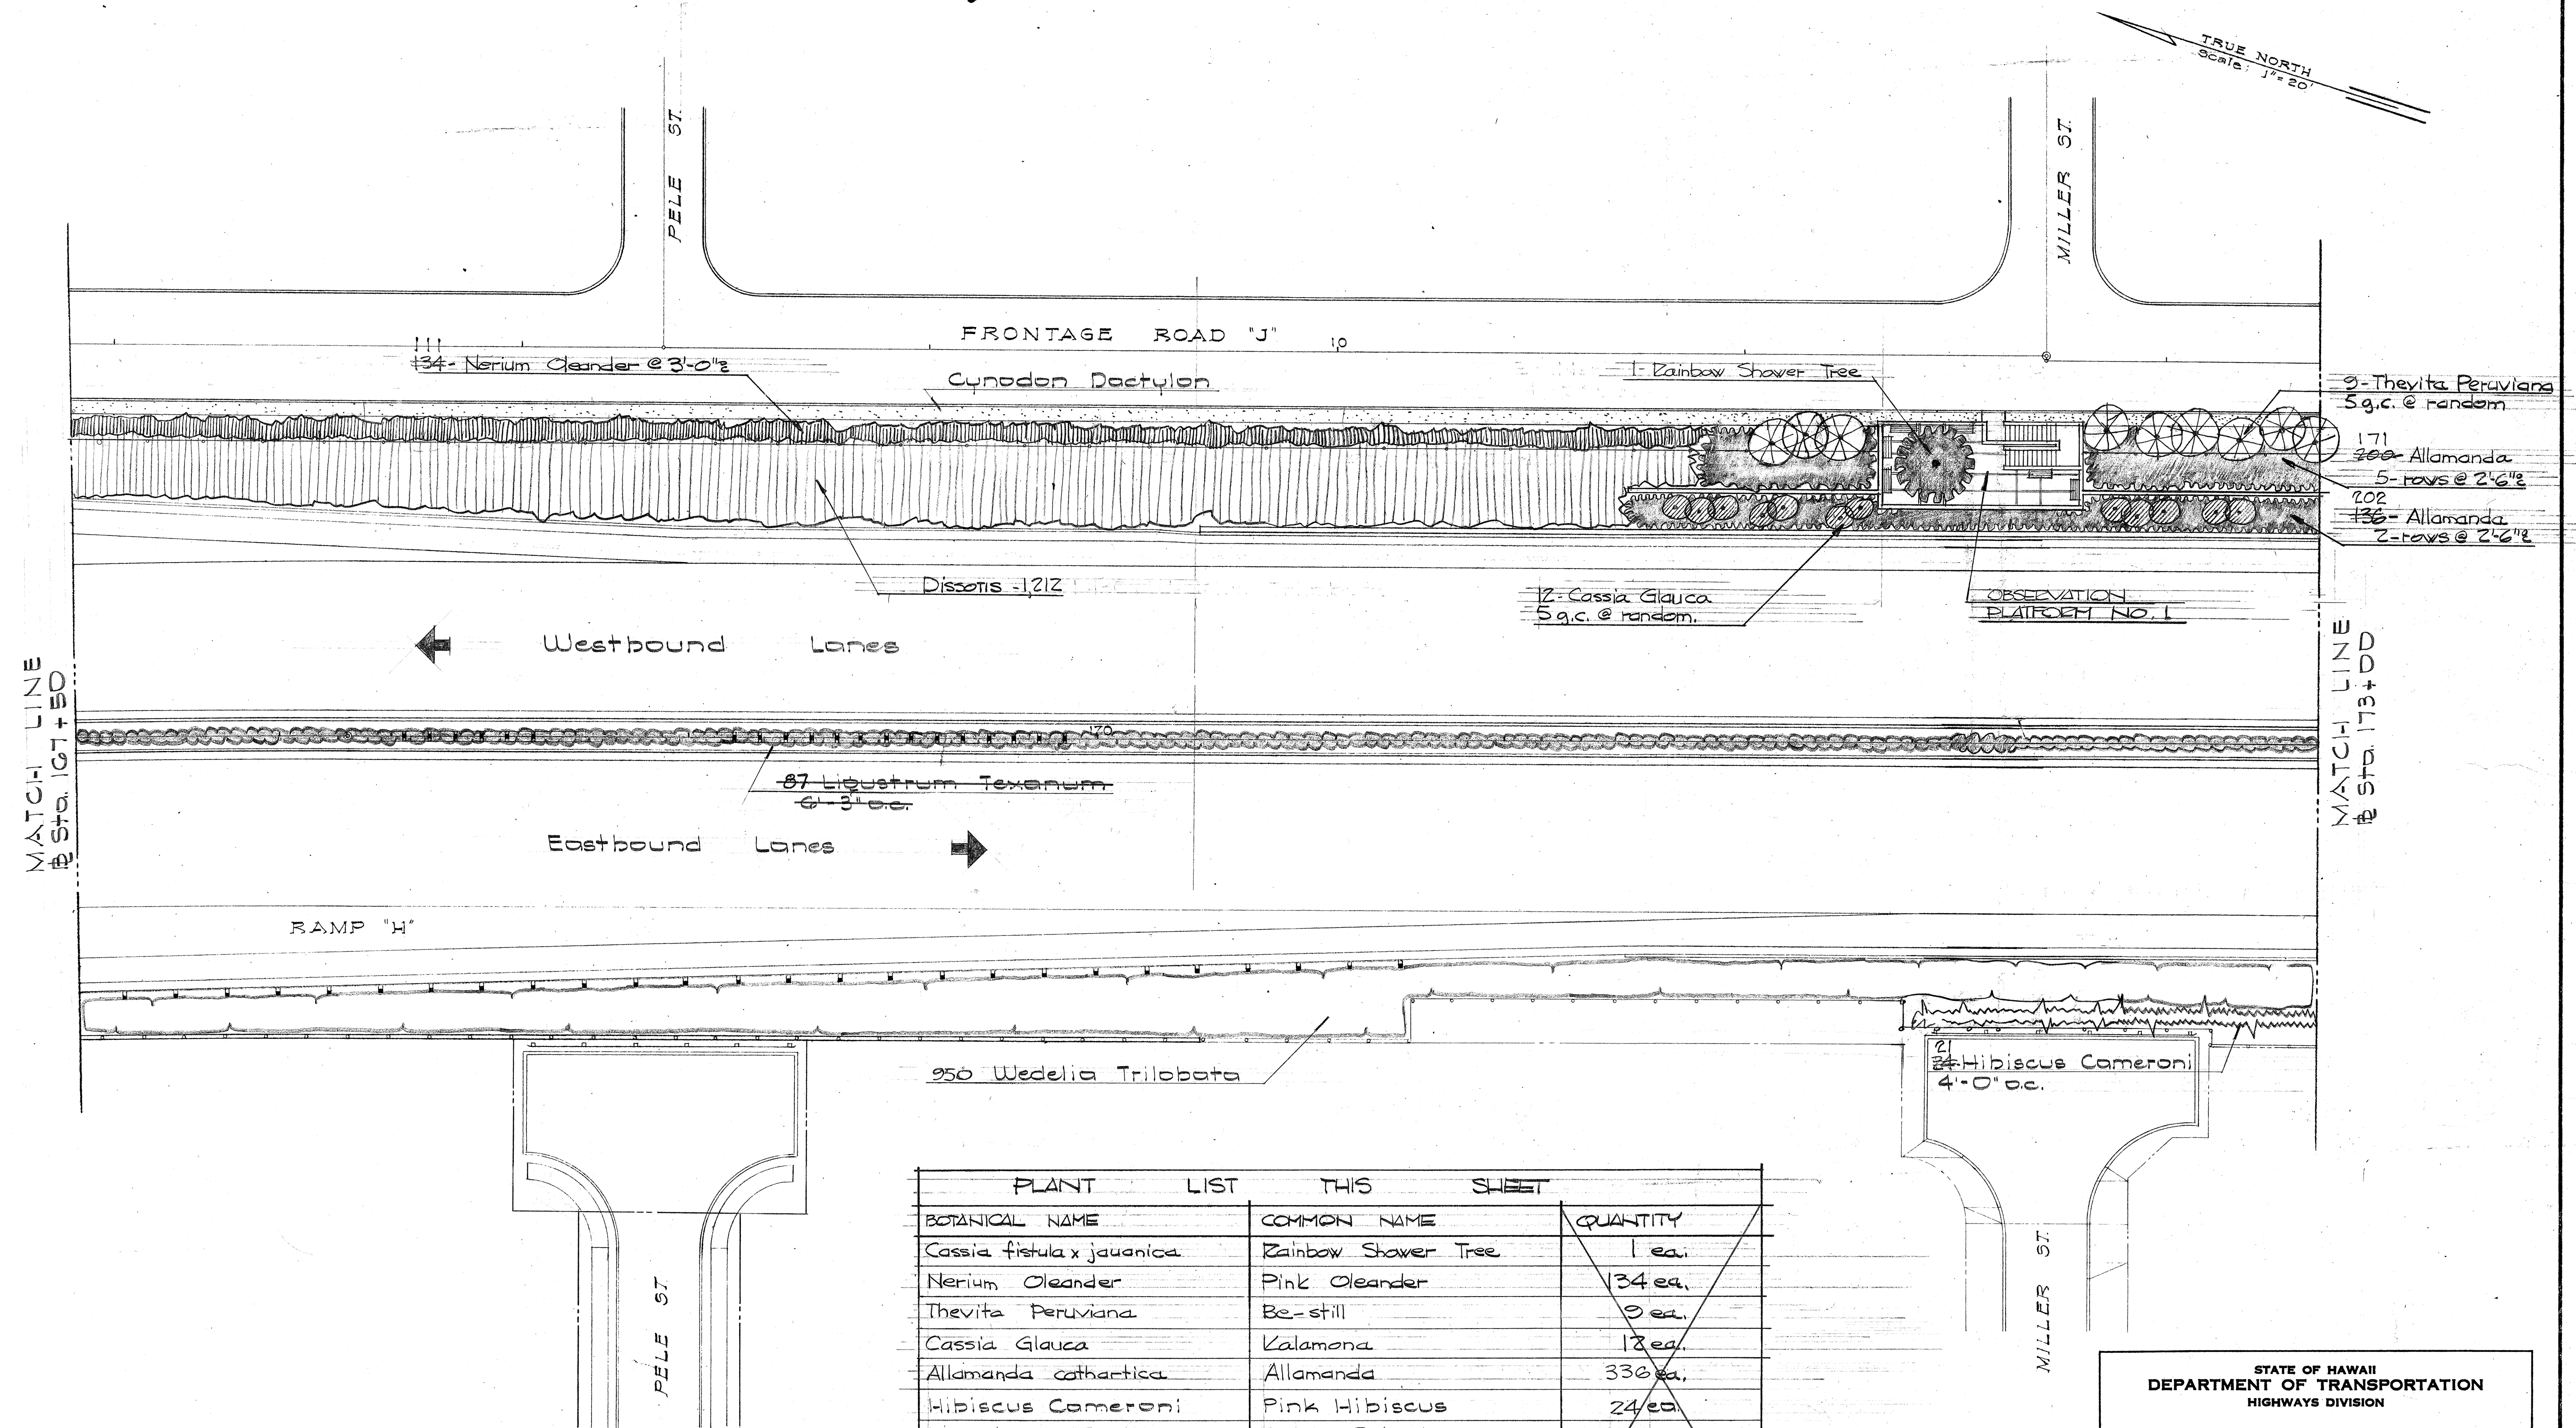

PLANT LIST THIS SHEET		
BOTANICAL NAME	COMMON NAME	QUANTITY
Cassia fistula x javanica	Rainbow Shower Tree	1 ea.
Nerium Oleander	Pink Oleander	134 ea.
Thevita Peruviana	Be-still	9 ea.
Cassia Glauca	Kalamona	12 ea.
Allamanda cathartica	Allamanda	336 ea.
Hibiscus Cameroni	Pink Hibiscus	24 ea.
Ligustrum Texanum	Texas Privet	87 ea.
Dissotis Plumosa	Dissotis	1,212 ea.
Wedelia Trilobata	Wedelia	950 ea.
Cynodon Dactylon	Bermuda Grass	1,710 sq. ft.

STATE OF HAWAII
DEPARTMENT OF TRANSPORTATION
HIGHWAYS DIVISION

LANDSCAPING

INTERSTATE ROUTE H-1
(LUNALILO FREEWAY)
Pele St. to Victoria St.

F.A.I. Proj. No. I-HI-1(31), Unit I



Scale: 1" = 20'

April 1966

SHEET No. 6 OF 12 SHEETS

2410

DATE	_____
SURVEY PLOTTED BY	_____
DESIGNED BY	_____
NOTED BY	_____
CHECKED BY	_____
ORIGINAL PLAN	_____
NOTE BOOK	_____
No.	_____

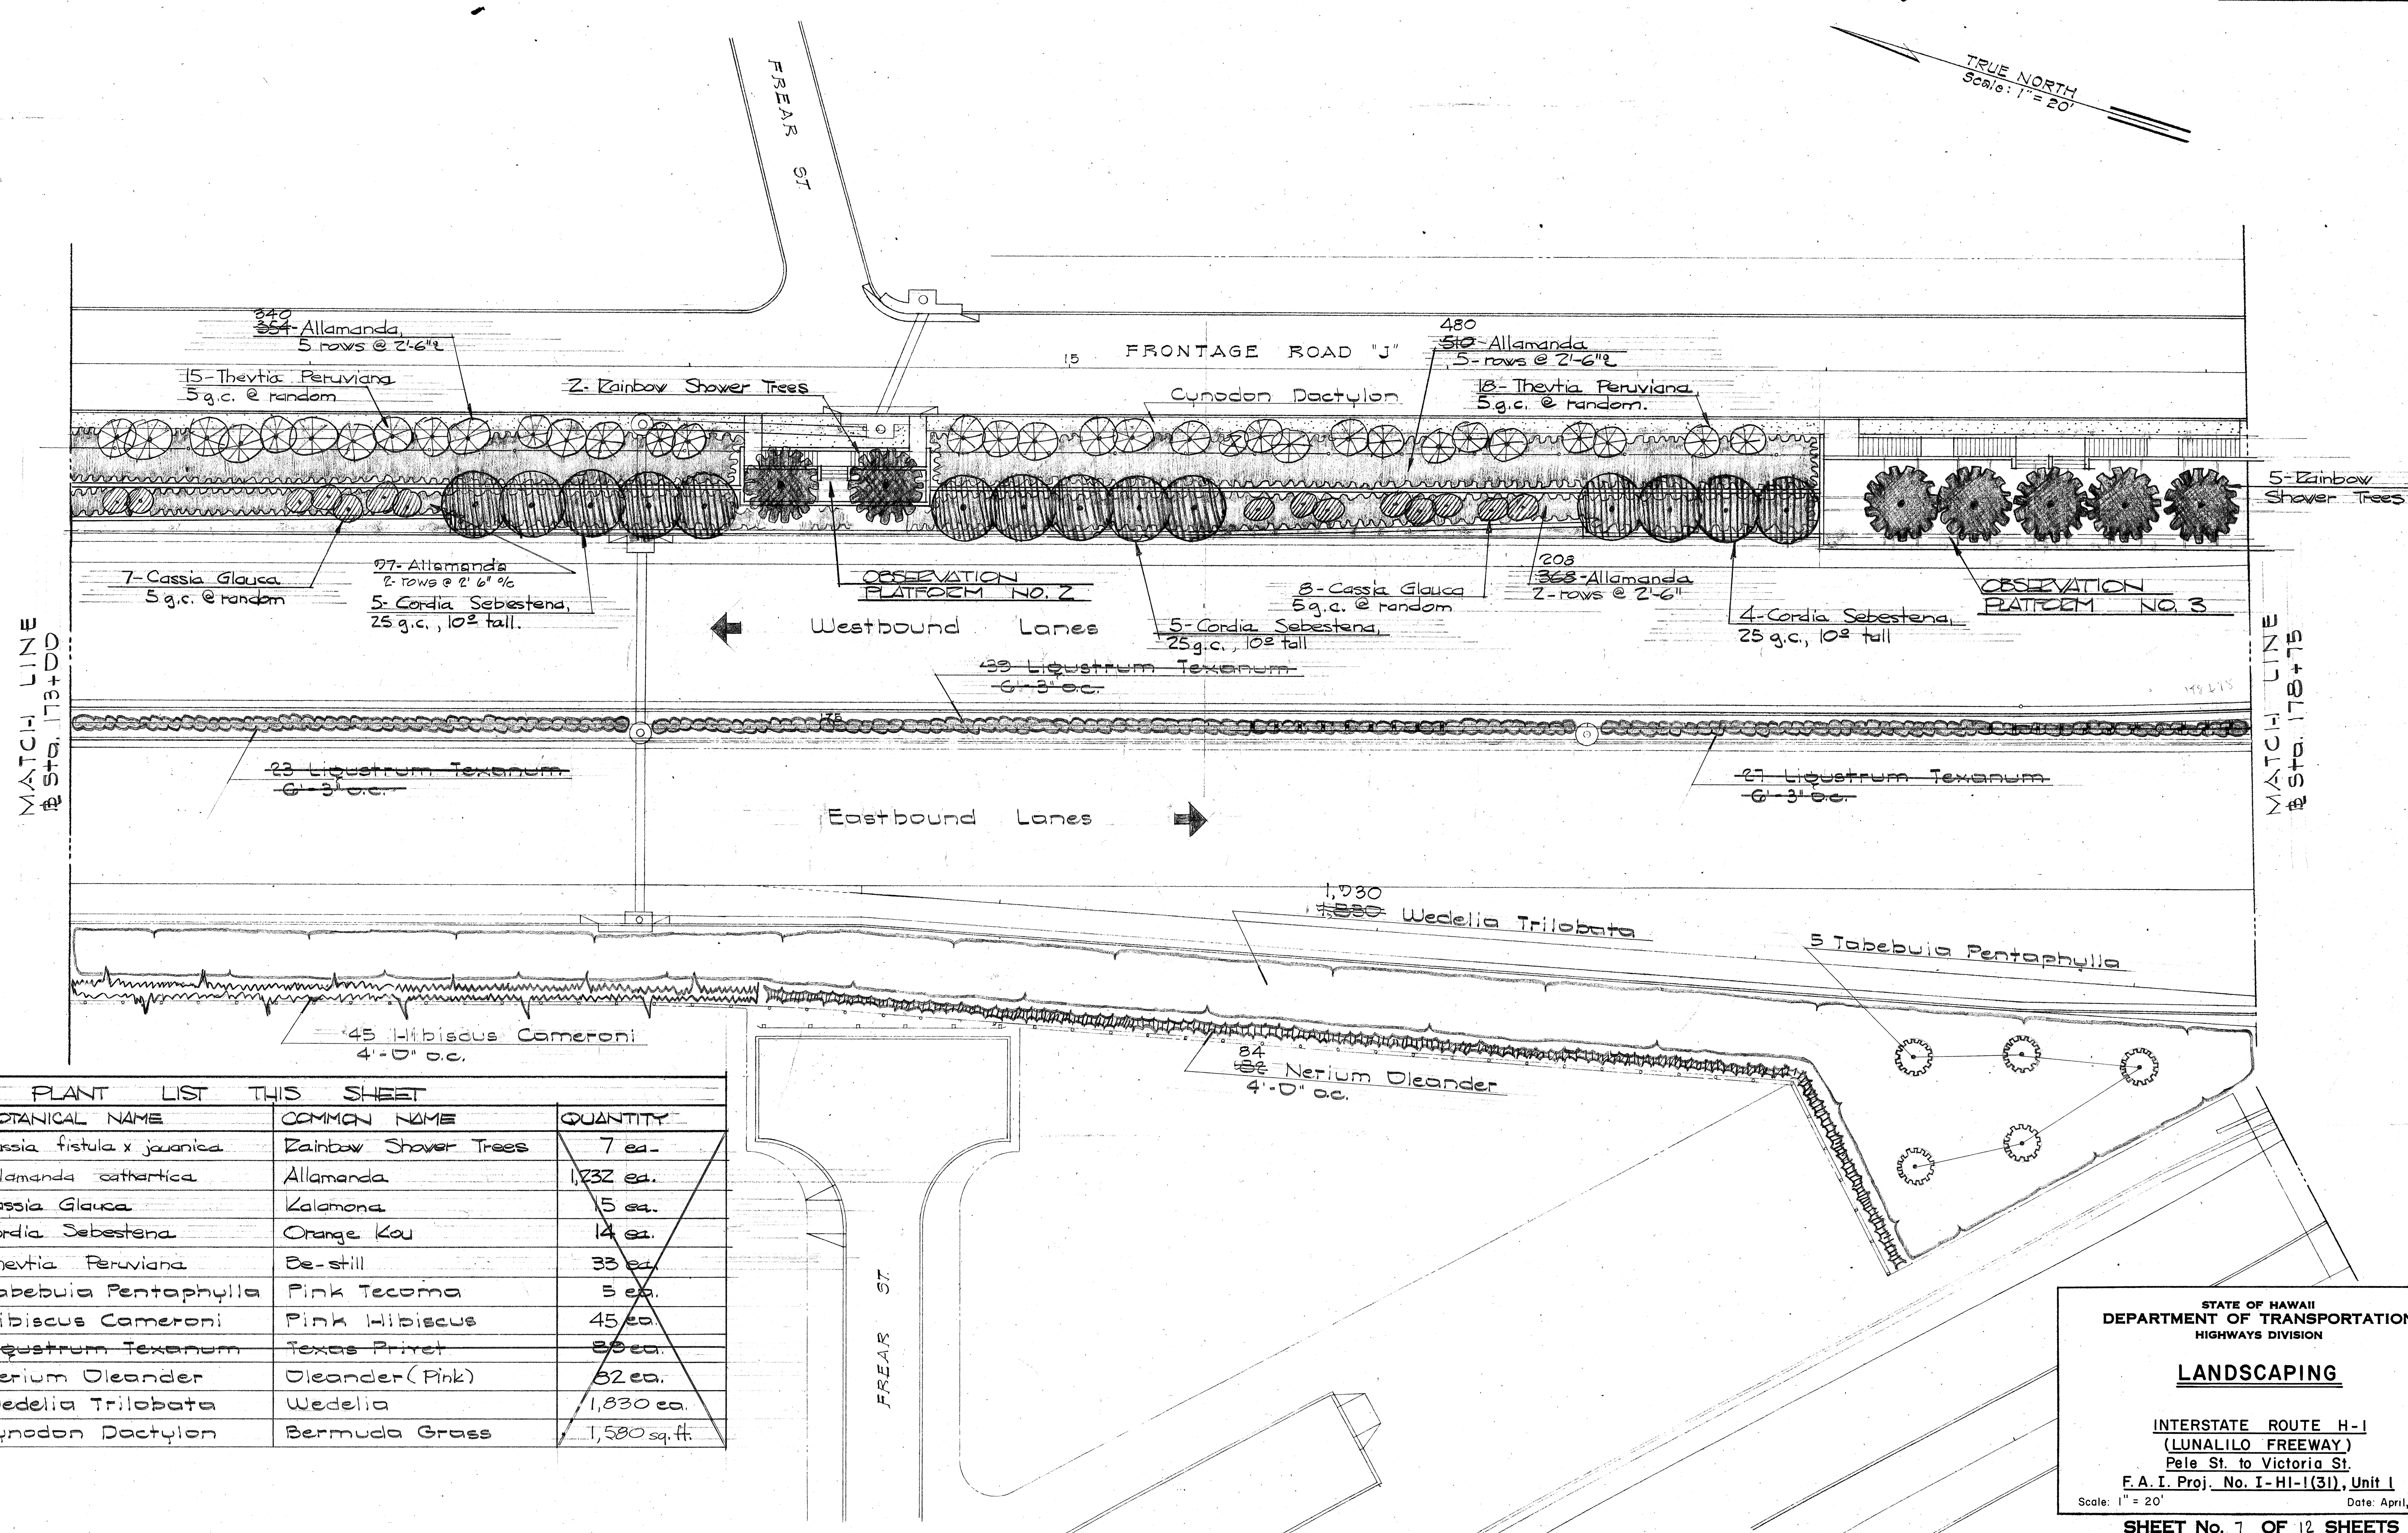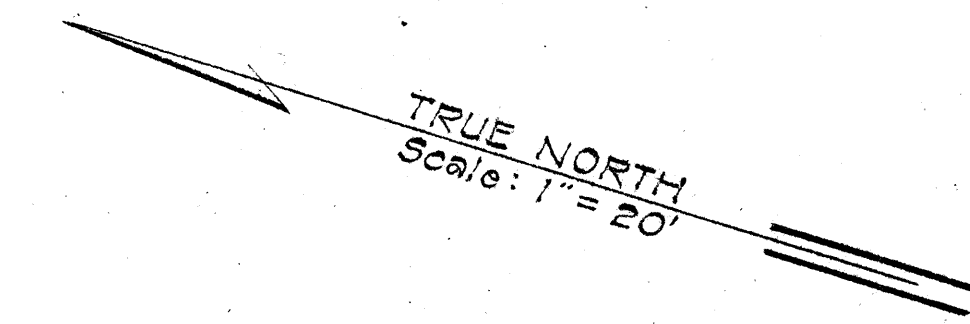

PLANT LIST THIS SHEET		
BOTANICAL NAME	COMMON NAME	QUANTITY
Cassia fistula x javanica	Rainbow Shower Trees	7 ea.
Allamanda cathartica	Allamanda	1,232 ea.
Cassia Glauca	Kalamona	15 ea.
Cordia Sebestena	Orange Kou	14 ea.
Theytia Peruviana	Be-still	33 ea.
Tabebuia Pentaphylla	Pink Tecoma	5 ea.
Hibiscus Cameroni	Pink Hibiscus	45 ea.
Nerium Oleander	Oleander (Pink)	84 ea.
Wedelia Trilobata	Wedelia	1,830 ea.
Cynodon Dactylon	Bermuda Grass	1,580 sq. ft.

STATE OF HAWAII
DEPARTMENT OF TRANSPORTATION
HIGHWAYS DIVISION

LANDSCAPING

INTERSTATE ROUTE H-1
(LUNALILO FREEWAY)
Pele St. to Victoria St.
F.A.I. Proj. No. I-HI-1(31), Unit 1

Scale: 1" = 20' Date: April, 1966


SHEET No. 7 OF 12 SHEETS

DATE: _____
SURVEYED BY: _____
DRAWN BY: _____
DESIGNED BY: _____
CHECKED BY: _____
No. _____

PLANT LIST THIS SHEET (CONT)-Proj. No 1-H1-1(31)		
BOTANICAL NAME	COMMON NAME	QUANTITY
Thevita Peruviana	Be- still	9 ea.
Cassia Glauca	Kalamond	22 ea.
Allamanda cathartica	Allamanda	364 ea.
Cordia Sebestena	Orange KOU	2 ea.

FED. ROAD DIST. NO.	STATE	FED. AID PROJ. NO.	FISCAL YEAR	SHEET NO.	TOTAL SHEETS
HAWAII	HAW.	I-11-1(31) UNIT 1	1967	242	260

TRUE NORTH
Scale: 1" = 20'

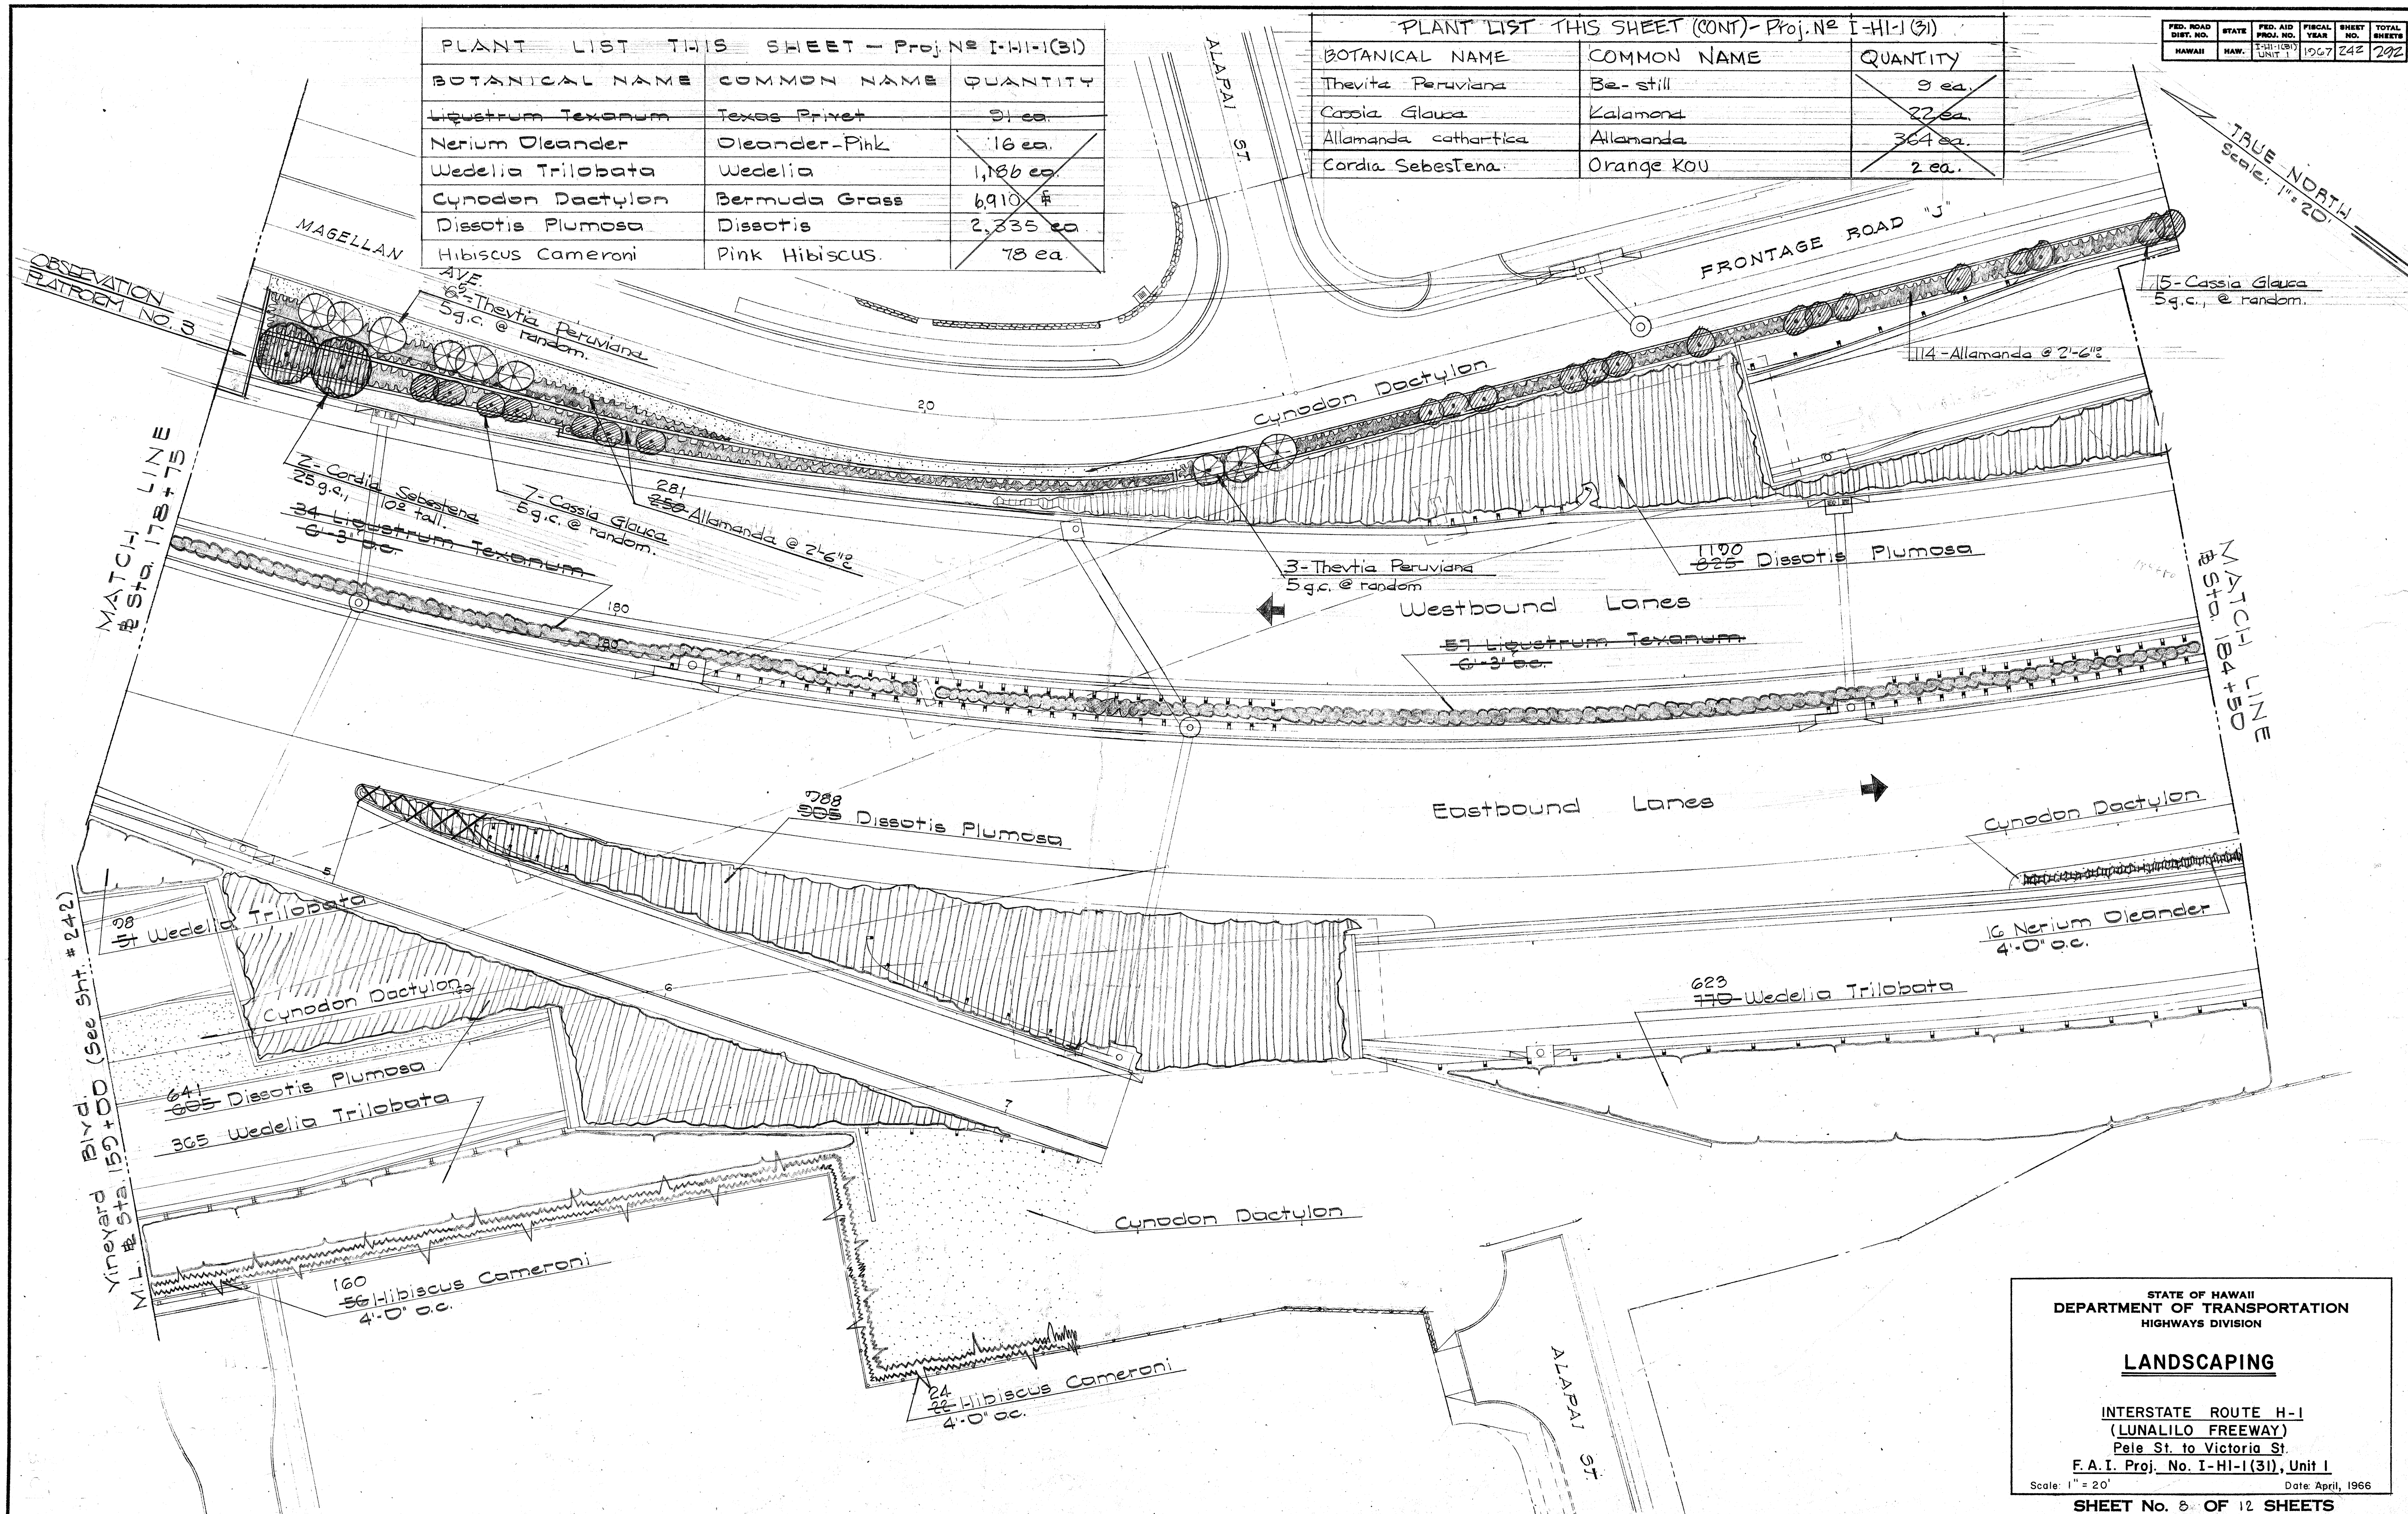

STATE OF HAWAII
DEPARTMENT OF TRANSPORTATION
HIGHWAYS DIVISION

LANDSCAPING

INTERSTATE ROUTE H-1
(LUNALILO FREEWAY)
Pele St. to Victoria St.
F. A. I. Proj. No. I-H1-1(31), Unit I


Scale: 1" = 20'

Date: April 196

SHEET No. 8 OF 12 SHEETS

243

PRINTED ON NO. 1002H CLEARPRINT

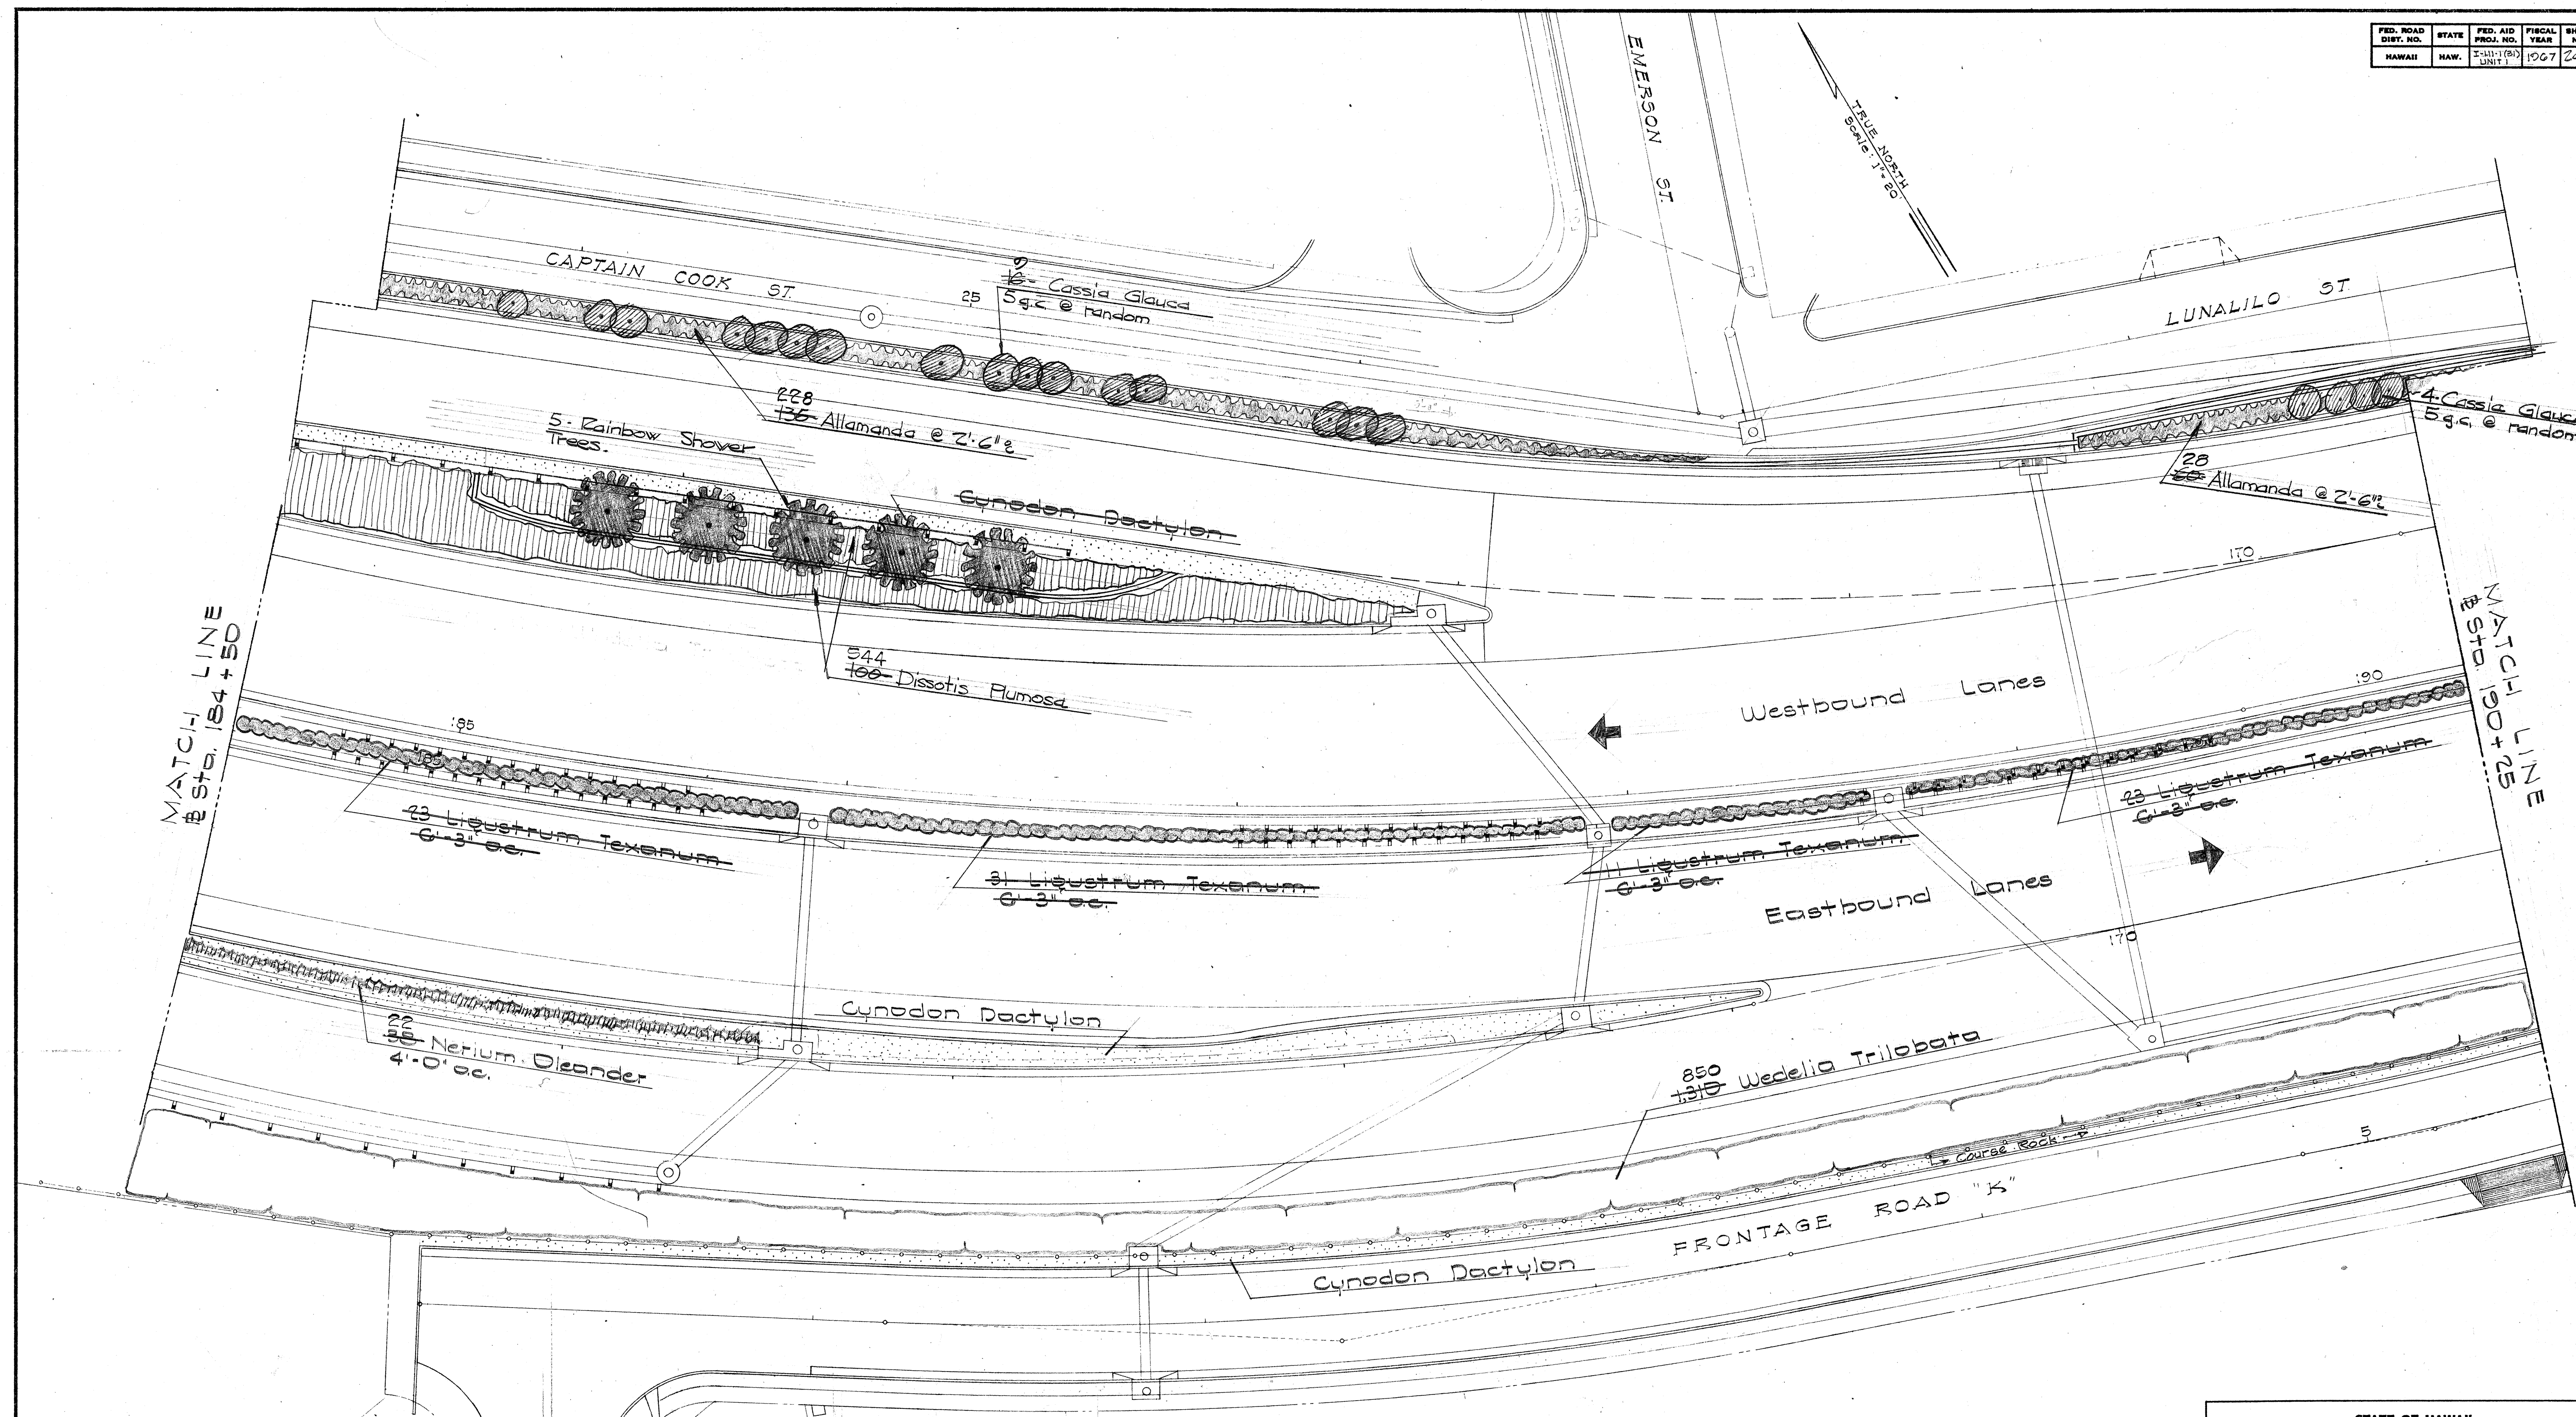

SURVEY PLOTTED BY	DATE
DRAWN BY	
DESIGNED BY	
NOTED BY	
CHECKED BY	

PLANT LIST THIS SHEET					
BOTANICAL NAME	COMMON NAME	QUANTITY	BOTANICAL NAME	COMMON NAME	QUANTITY
Cassia fistula x javanica	Rainbow Shower Tree	5 ea.	Ligustrum Texanum	Texas Privet	88 ea.
Cassia Glauca	Kalamona	20 ea.	Wedelia Trilobata	Wedelia	1,310 ea.
Dissotis Plumosa	Dissotis	100 ea.	Cynodon Dactylon	Bermuda Grass	6,050 #
Allamanda cathartica	Allamanda	196 ea.	Nerium Oleander	Oleander - PINK	38 ea.

STATE OF HAWAII
DEPARTMENT OF TRANSPORTATION
HIGHWAYS DIVISION

LANDSCAPING

INTERSTATE ROUTE H-1
(LUNALILO FREEWAY)
Pele St. to Victoria St.
F.A.I. Proj. No. I-HI-1 (31), Unit 1


Scale: 1" = 20' Date: April, 1966

SHEET No. 2 OF 12 SHEETS

PLANT LIST THIS SHEET		
BOTANICAL NAME	COMMON NAME	QUANTITY
Cordia Sebestena	Orange Kou	1 ea.
Ligustrum Texanum	Texas Privet	70 ea.
Wedelia Trilobata	Wedelia	625 ea.
Cynodon Dactylon	Bermuda Grass	1,500 #
Allamanda cathartica	Allamanda	280 ea.
Cassia Glauca	Kalamona	14 ea.

MATCH LINE
Sta. 190+25

MATCH LINE
Sta. 190+00

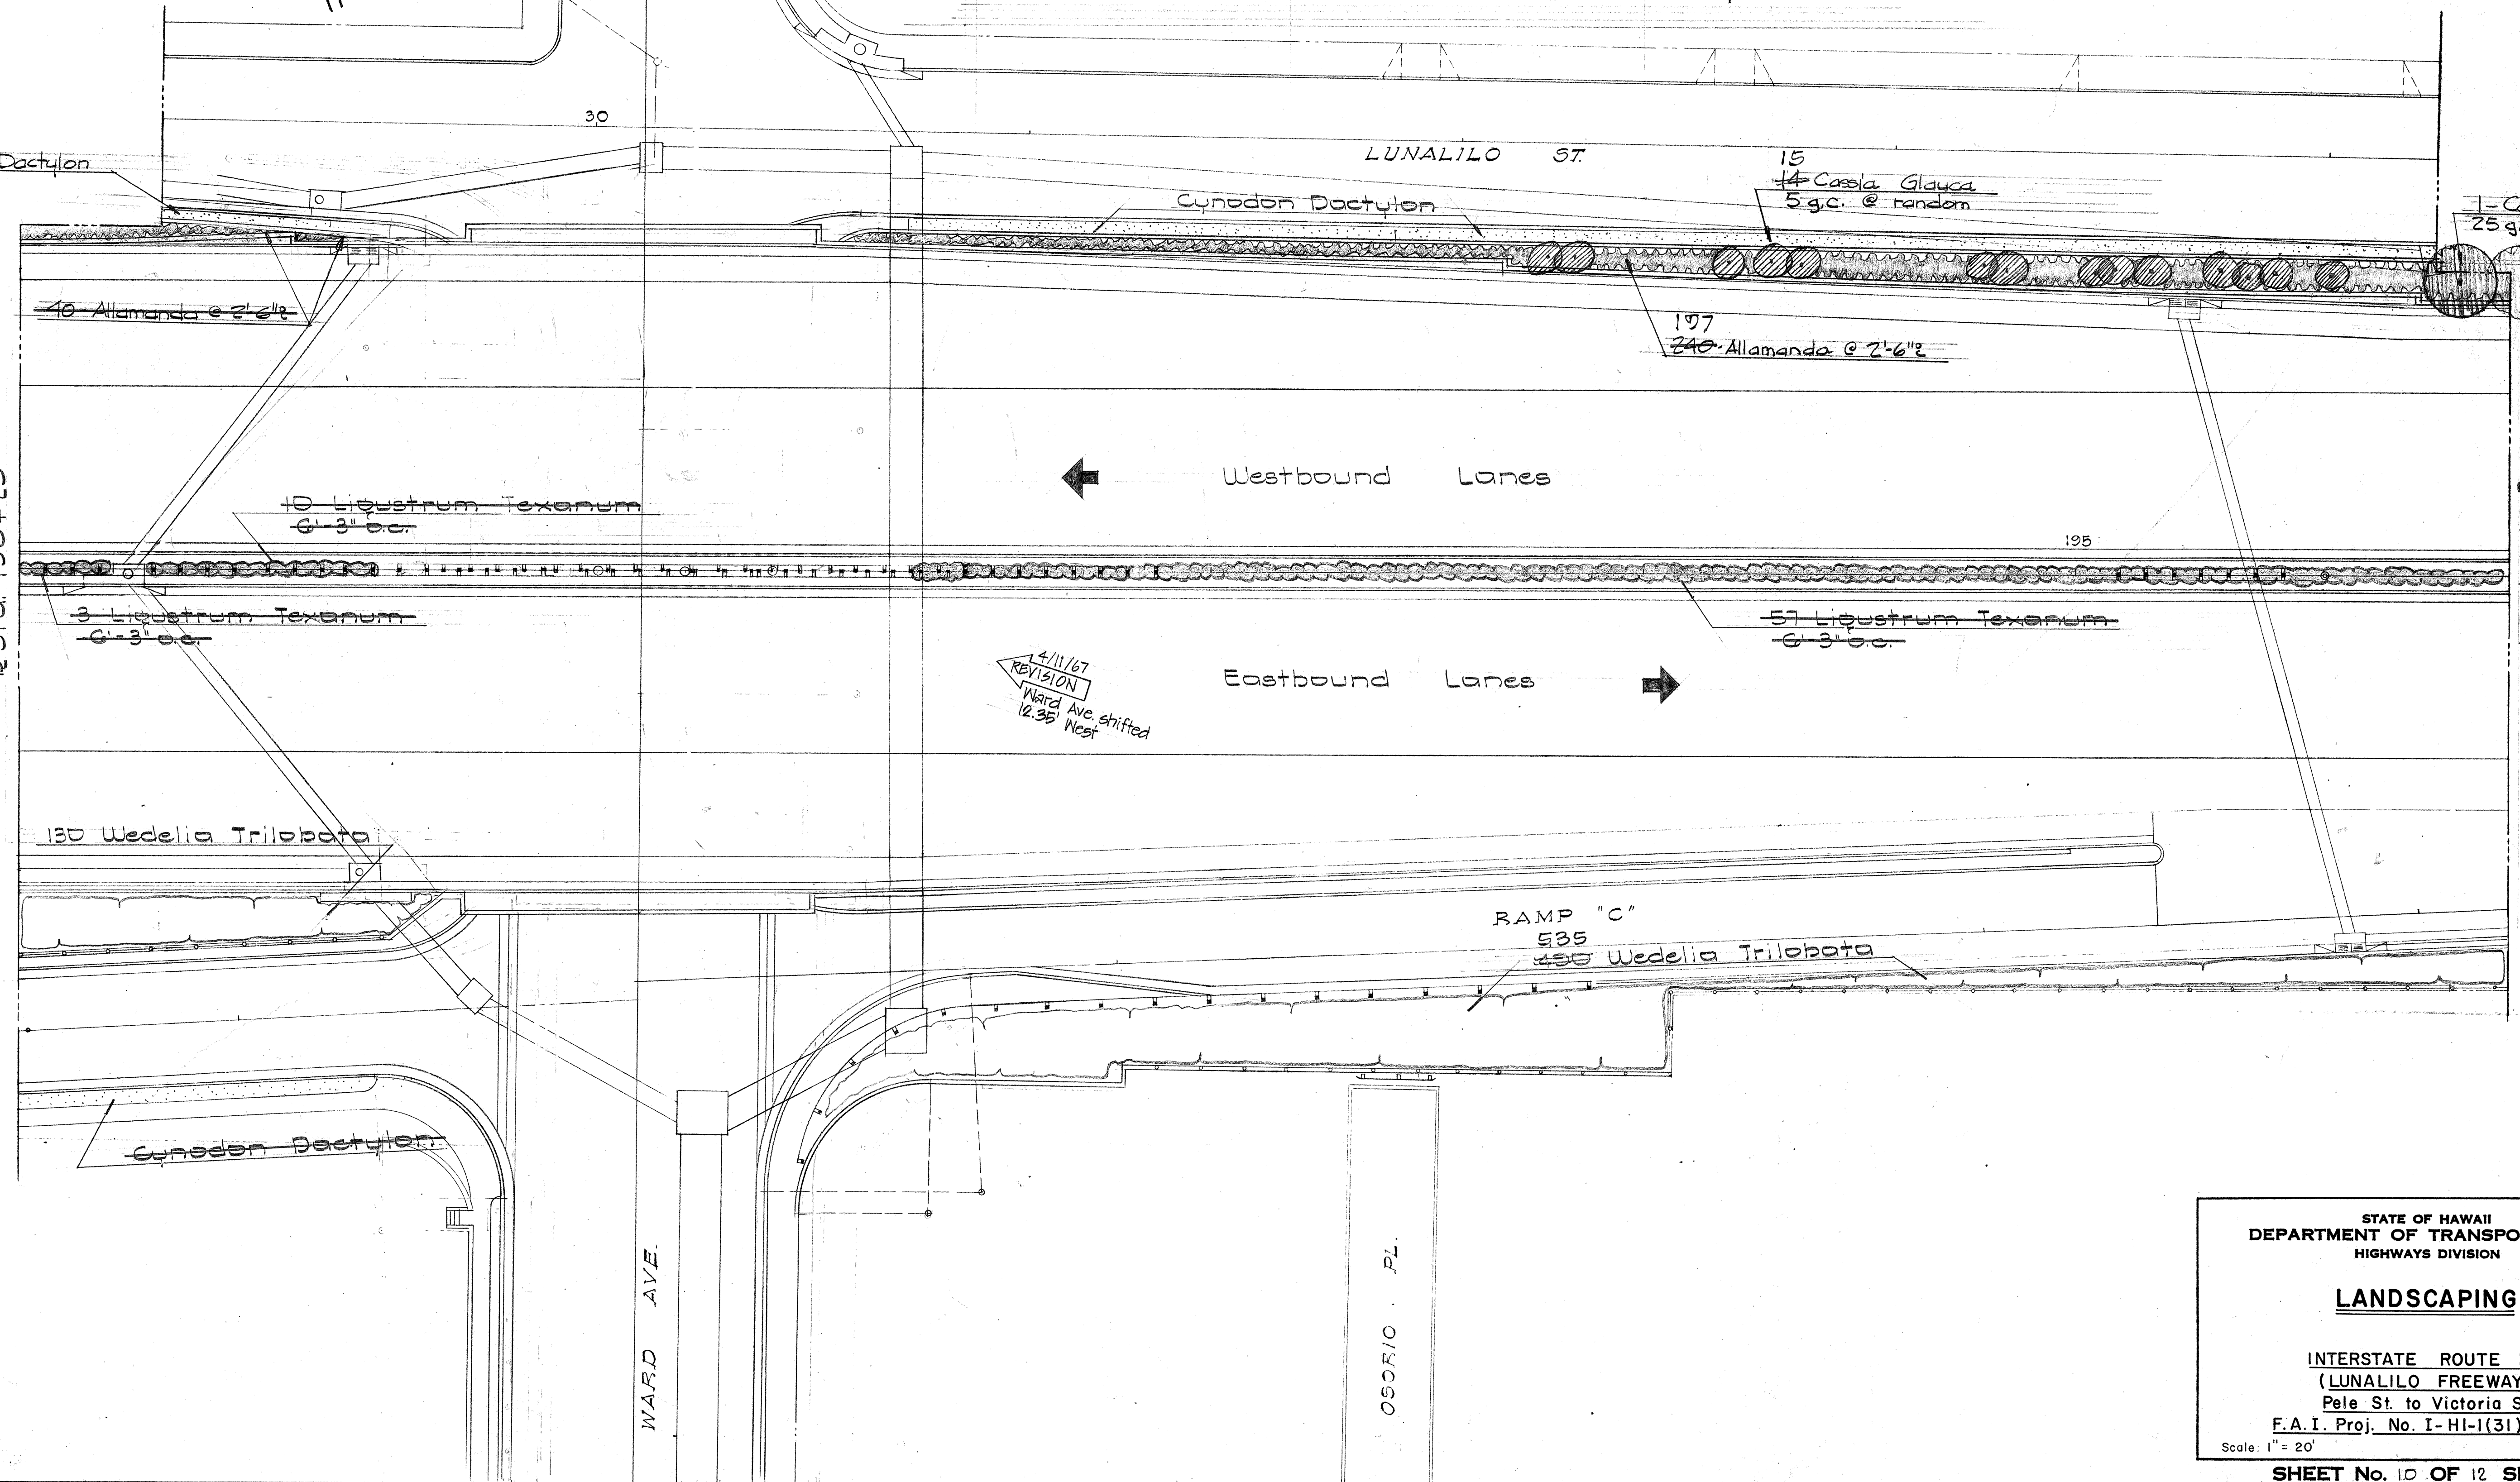

DESIGNED BY	DATE
DRAWN BY	
CHECKED BY	
NOTED BY	
NO.	

STATE OF HAWAII
DEPARTMENT OF TRANSPORTATION
HIGHWAYS DIVISION

LANDSCAPING


INTERSTATE ROUTE H-1
(LUNALILO FREEWAY)
Pele St. to Victoria St.
F.A.I. Proj. No. I-1(31), Unit 1
Scale: 1" = 20' Date: April 11, 1967

SHEET No. 10 OF 12 SHEETS

THIS SHEET SUPERCEDES SHEET 244

244A

TRUE NORTH
Scale 1" = 20'

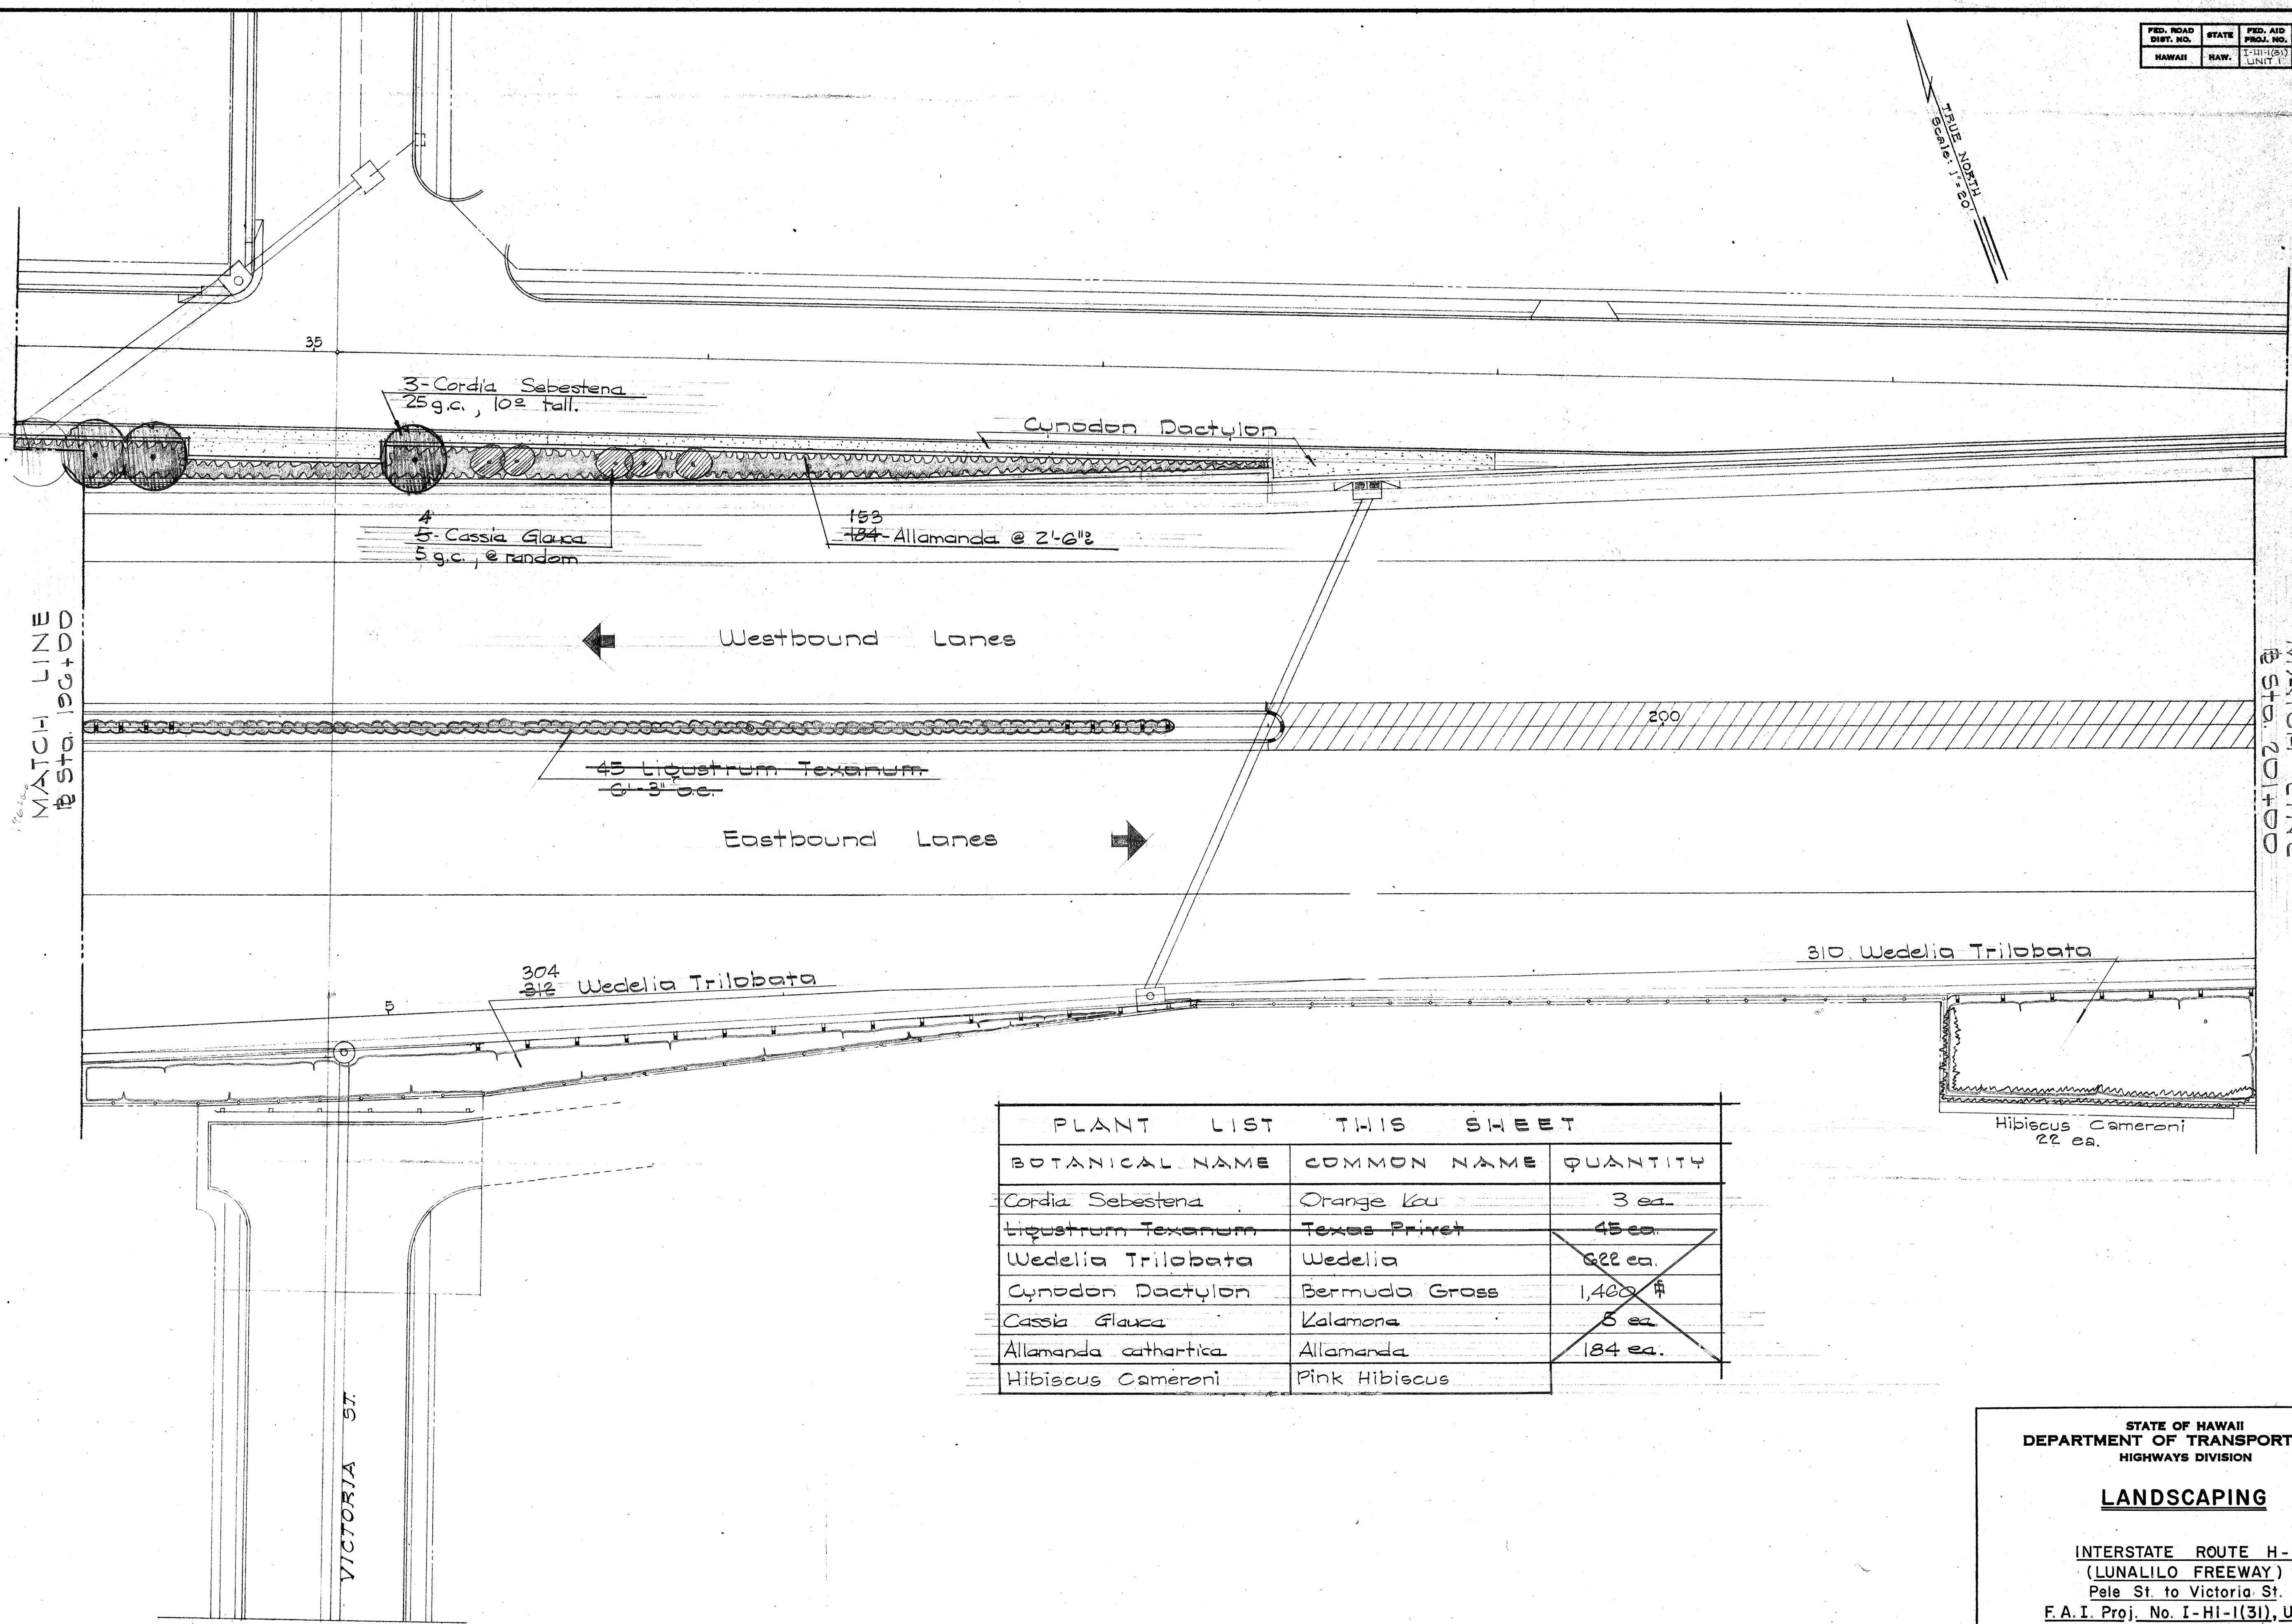

PLANT LIST THIS SHEET		
BOTANICAL NAME	COMMON NAME	QUANTITY
Cordia Sebestena	Orange Kau	3 ea.
Ligustrum Texanum	Texas Privet	45 ea.
Cassia Glauca	Kalamona	5 ea.
Allamanda cathartica	Allamanda	184 ea.
Hibiscus Camerani	Pink Hibiscus	

STATE OF HAWAII
DEPARTMENT OF TRANSPORTATION
HIGHWAYS DIVISION

LANDSCAPING

INTERSTATE ROUTE H-1
(LUNALILO FREEWAY)
Pele St. to Victoria St.
F.A.I. Proj. No. I-HI-1(31), Unit I

Scale: 1" = 20' Date: April, 1966

SHEET No. 11 OF 12 SHEETS

ORIGINAL PLAN
DESIGNED BY
NOTED BOOK
CHECKED BY
DATE

FED. ROAD DIST. NO.	STATE	FED. AID PROJ. NO.	FISCAL YEAR	SHEET NO.	TOTAL SHEETS
HAWAII	HAW.	1967	246	292	

MATCH LINE
Sta. 201+50

Westbound Lanes

Eastbound Lanes

ERNEST ST.

LUNALILO ST.

45

LELE NORTH
Scale: 1" = 20'

680 Wedelia Trilobata

Hibiscus Cameroni
44 ea.

PLANT LIST THIS SHEET

BOTANICAL NAME	COMMON NAME	QUANTITY
Wedelia Trilobata	Wedelia	680 ea.
Hibiscus Cameroni	Pink Hibiscus	

STATE OF HAWAII
DEPARTMENT OF TRANSPORTATION
HIGHWAYS DIVISION

LANDSCAPING

INTERSTATE ROUTE H-1
(LUNALILO FREEWAY)
Pele St. to Victoria St.
F.A.I. Proj. No. I-HI-1(31), Unit 1

Scale: 1" = 20'

Date: April, 1966

SHEET No. 12 OF 12 SHEETS

246

ORIGINAL PLAN	DATE
SURVEY PLOTTED BY	
DRAWN BY	
DESIGNED BY	
NOTE BOOK	
QUANTITIES BY	
CHECKED BY	