FED ROAD DIST. NO	STATE	FED. AID PROJ. NO.	FISCAL YEAR	SHEET NO.	TOTAL SHEETS
HAWAII	HAW.	I-HI-1(32):5 UNIT 3 I-HI-1(22):5 UNIT 2	1967	1	99

INDEX TO DRAWINGS

SHEET NO.	DESCRIPTION
1	TITLE SHEET
2-4	TYPICAL SECTIONS
5-9	PLAN AND PPOFILE
10	RAMP "D" DETAILS
11	MANAGER'S DRIVE DETAILS
11 A	DISPOSAL SITE PLAN
12	F.A.I. PROJ. NO. I-HI-1(22): 5, Unit 2 CONSTRUCTION OF CESSPOOL ON LOT TMK: 9-4-02:3
13-15	SUPERELEVATION DIAGRAMS
16-25	MISC. AND STANDARD DETAILS
26-29	WATER SYSTEM
30-57	IRRIGATION AND DRAINAGE DETAILS
58-73	MANAGER'S DRIVE GRADE SEPARATION
74-77	UTILITIES: ELECTRIC AND TELEPHONE
78-99	CROSS SECTIONS

NOTE:
ALL CHANGES MADE DURING CONSTRUCTION HAVE BEEN NOTED IN RED ON THESE TRACINGS AND CHECKED BY:

Thomas N. Miyasato
PROJECT ENGINEER

8/9/72
DATE

STATE OF HAWAII
DEPARTMENT OF TRANSPORTATION
HIGHWAYS DIVISION
HONOLULU, HAWAII

"AS BUILT" PLANS FOR

CONSTRUCTION OF A PORTION OF

INTERSTATE ROUTE H-1

WAIKELE STREAM TO WEST OF WAIAWA INTERCHANGE

FEDERAL AID INTERSTATE PROJ. NO. I-HI-1(32):5, UNIT 3

AND

FEDERAL AID INTERSTATE PROJ. NO. I-HI-1(22):5, UNIT 2

DISTRICT OF EWA

ISLAND OF OAHU

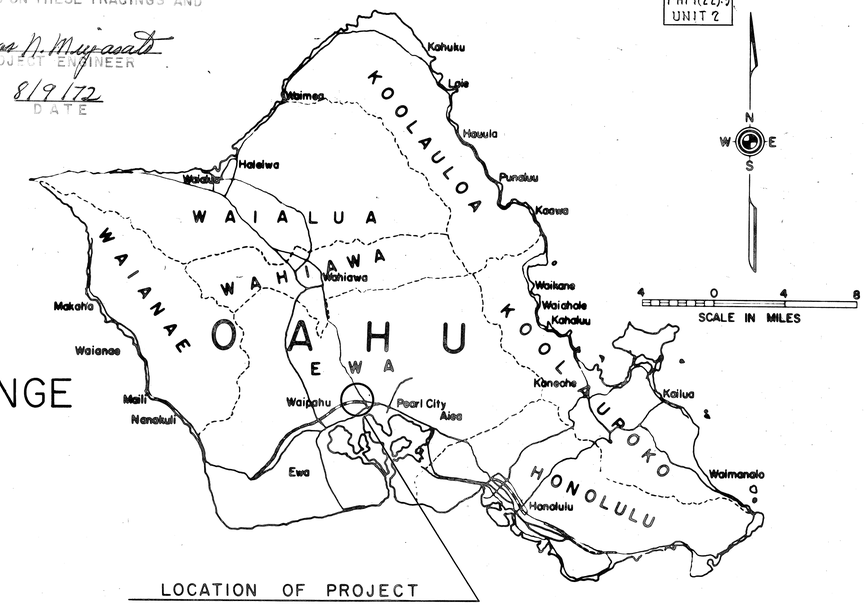

LOCATION OF PROJECT

Federal Aid Interstate Projects Previously Constructed or Under Construction

F. A. I. PROJECT NO. I-HI-1(32):5 UNIT 2

F. A. I PROJECT NO. I-HI-1(32):5 UNIT 1

INTERSTATE PROJECT NOS. I-HI-1(32):5, UNIT 3 & I-HI-1(22):5, UNIT 2

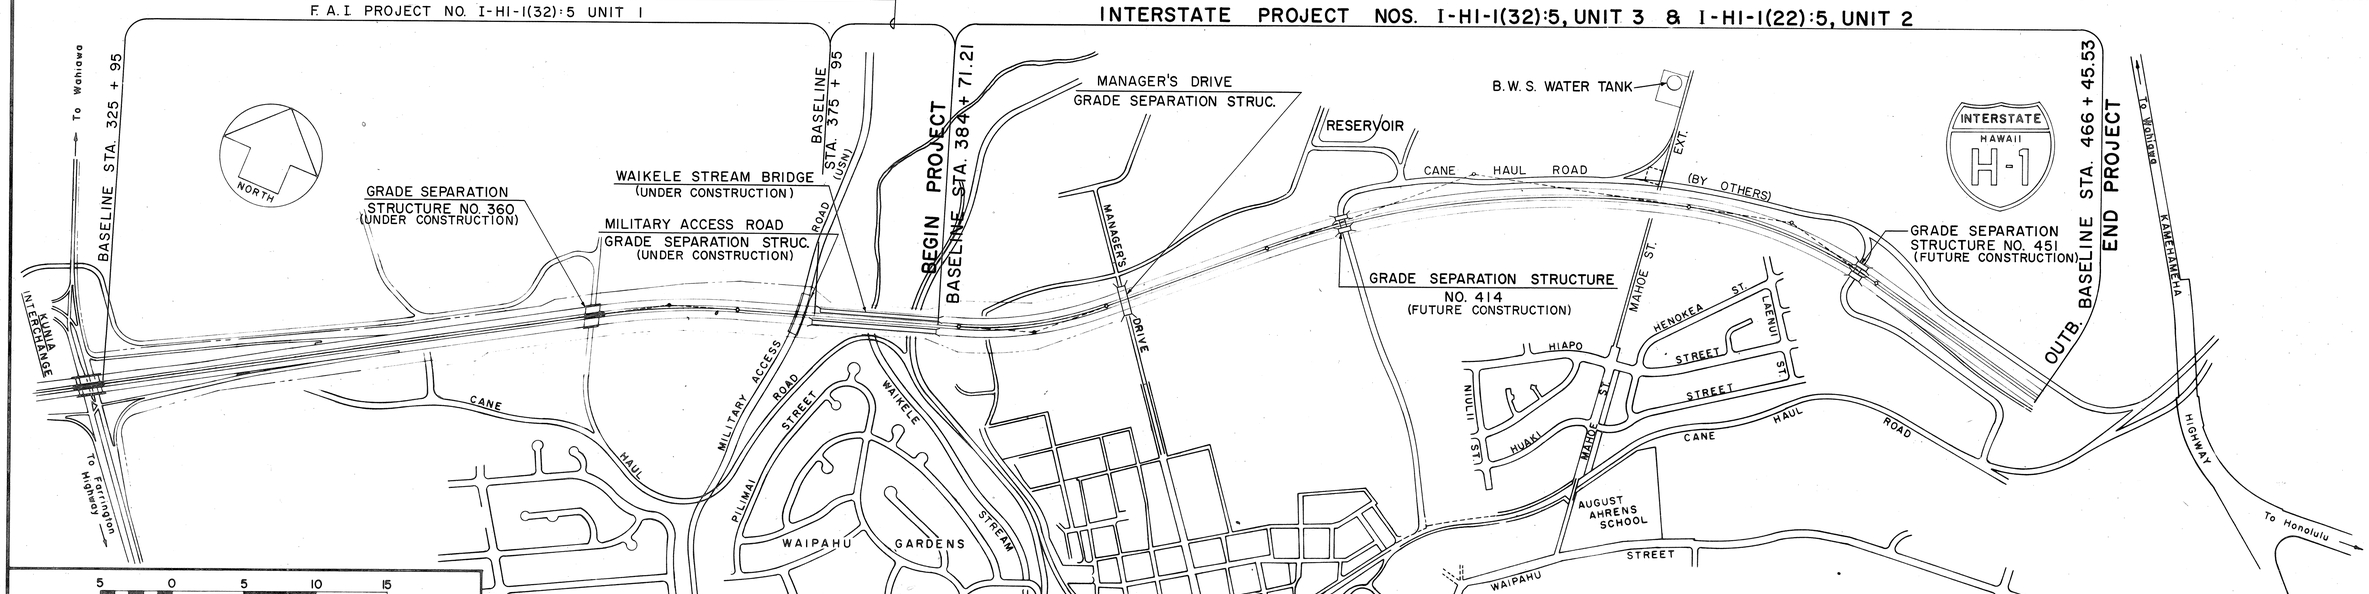

5 0 5 10 15
SCALE IN HUNDRED FEET

LAYOUT PLAN

GROSS LENGTH OF PROJECT	1.548 Mi.
BRIDGES OVER 20.00' SPAN	0.000 Mi.
NET LENGTH OF ROADWAY	1.548 Mi.

DESIGN CLASSIFICATION

CONTROL OF ACCESS — FULL	D 65%
CURRENT ADT (1967) 0	T 3%
DESIGN ADT (1987) 52,400	V ..... 70 M.P.H.
DHV (-11%) 5700	

DEPARTMENT OF TRANSPORTATION
BUREAU OF PUBLIC ROADS
APPROVED:
FOR DIVISION ENGINEER — DATE 10-19-67

DEPARTMENT OF TRANSPORTATION
STATE OF HAWAII
APPROVED:
for DIR. OF TRANSPORTATION — DATE 6-27-67

D. Lee July 1967