FED. ROAD DIST. NO.	STATE	FED. AID PROJ. NO.	FISCAL YEAR.	SHEET NO.	TOTAL SHEETS
HAWAII	HAW.	F-HI-1(36)8	1967	38	124

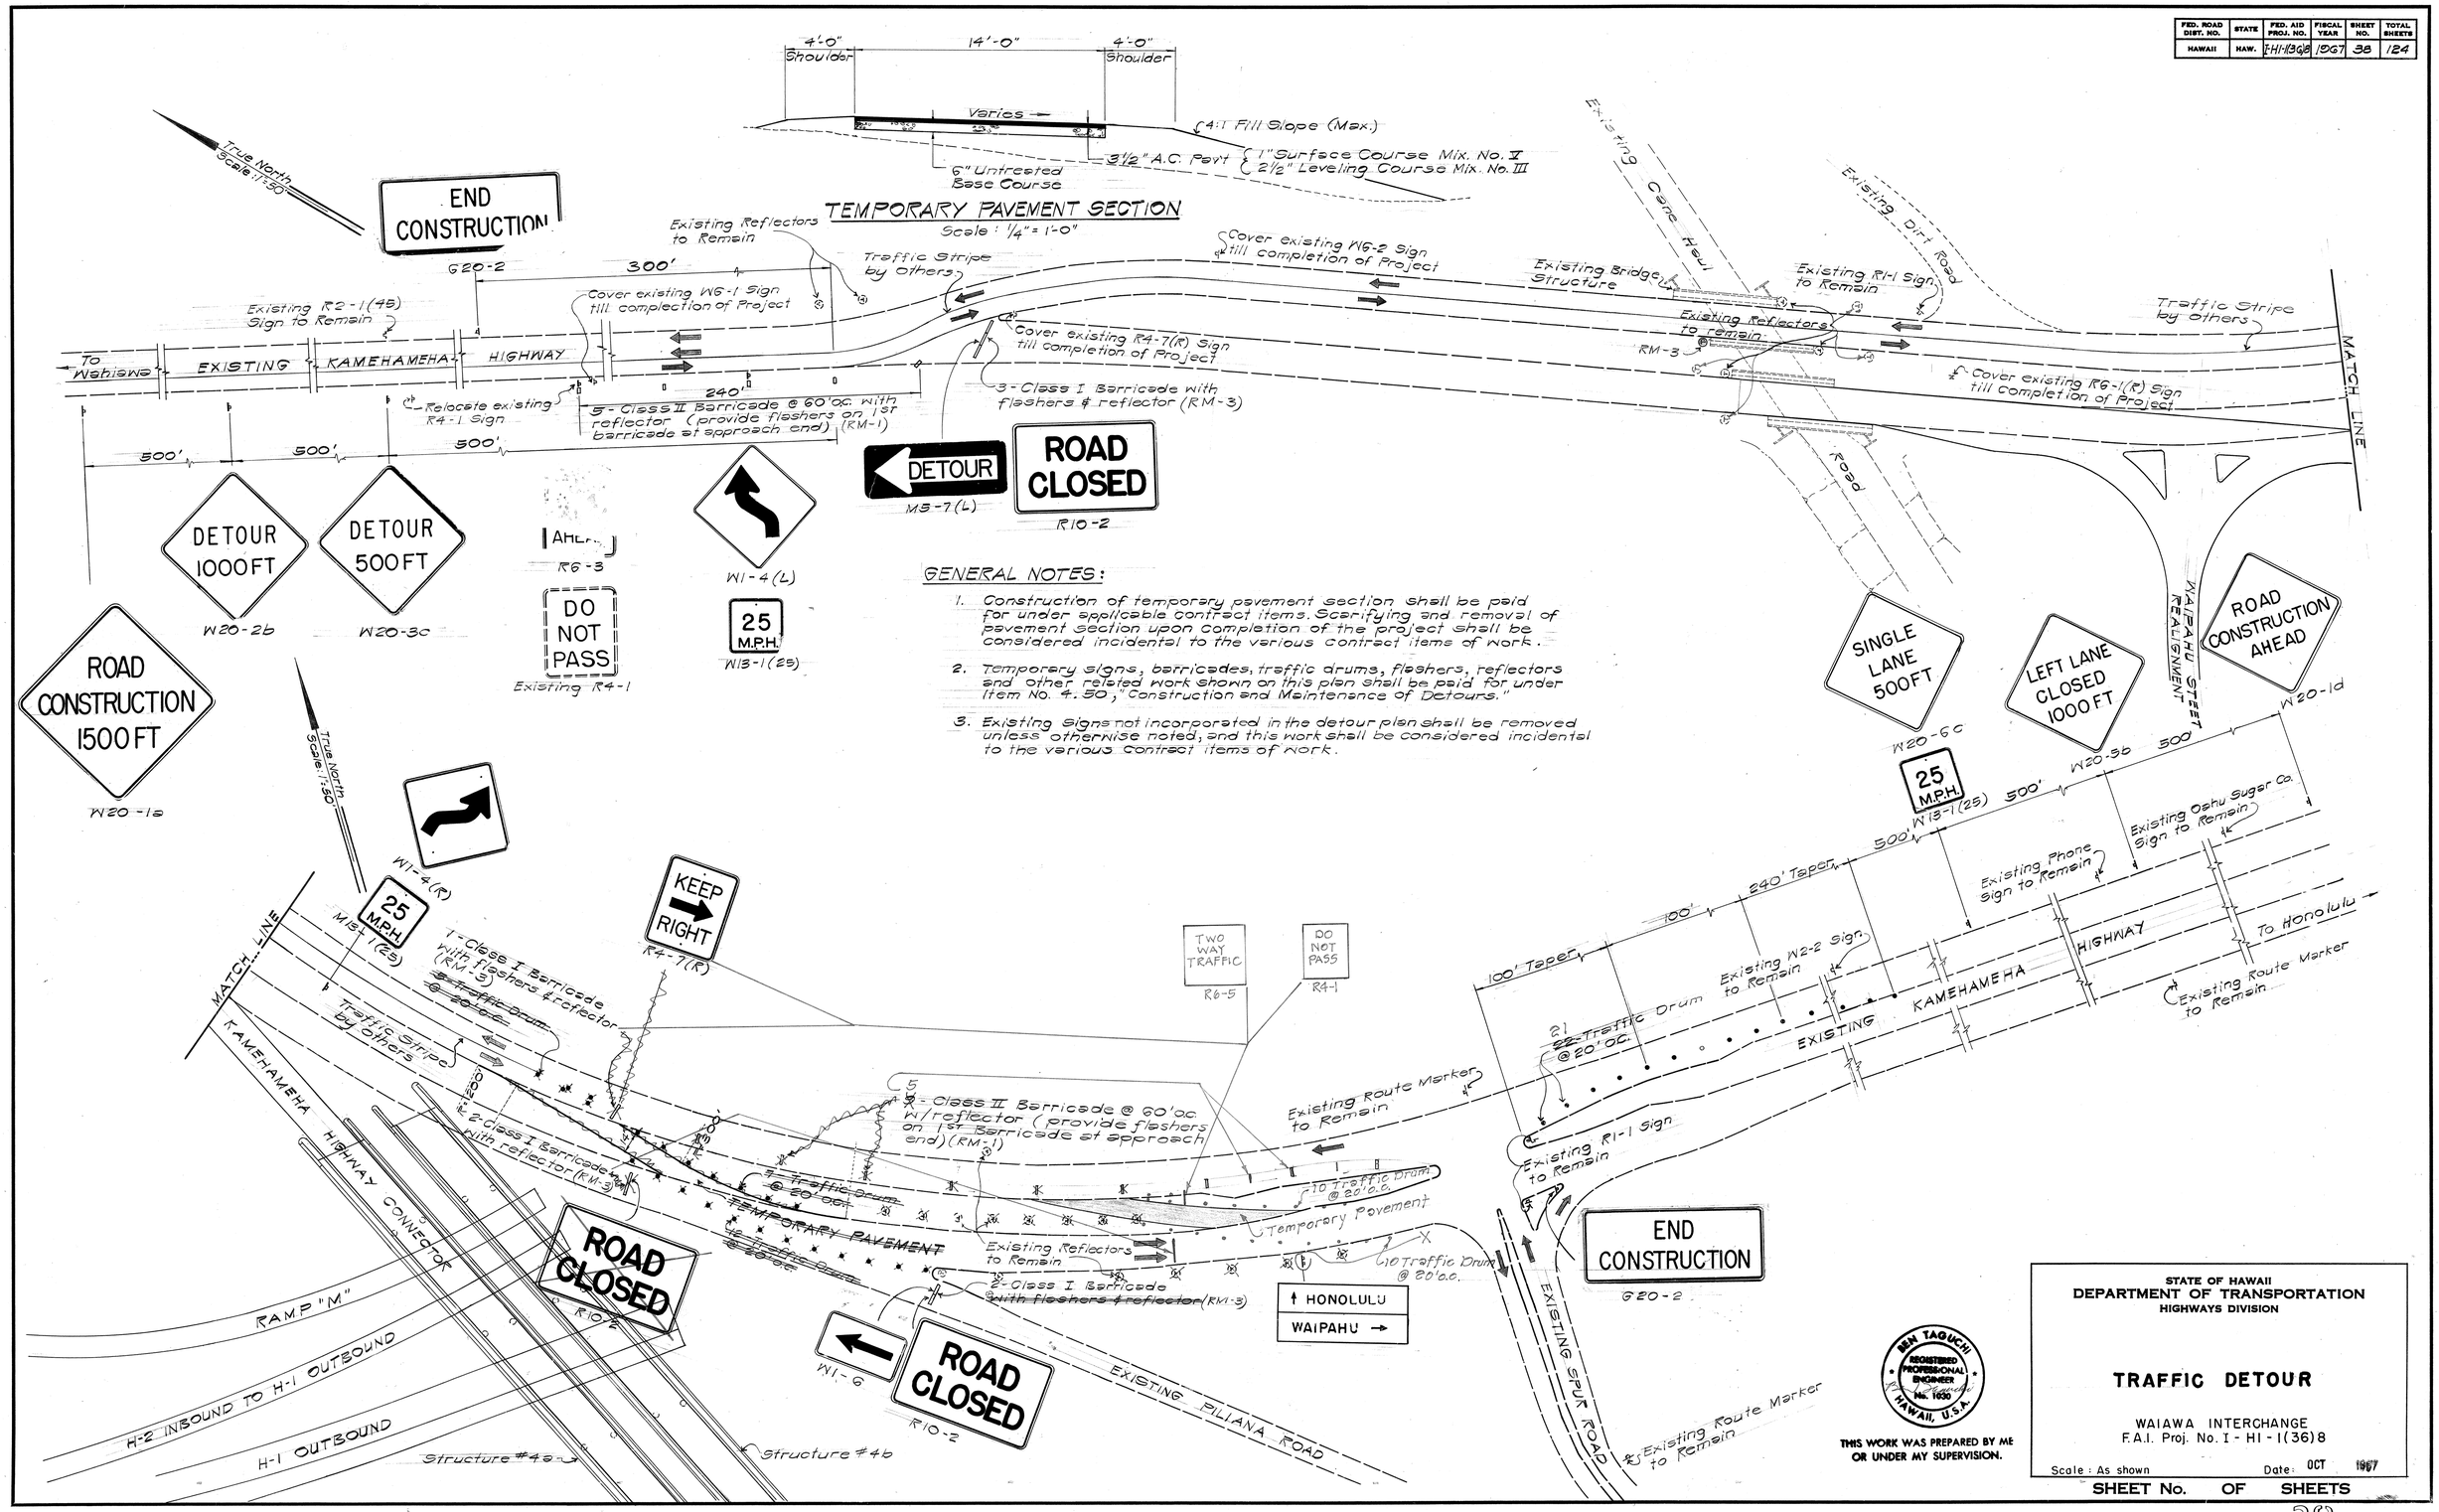

ORIGINAL PLAN		DATE
	SURVEY PLOTTED BY	
	DRAWN BY	
	TRACED BY	
NOTE BOOK	DESIGNED BY	
	QUANTITIES BY	
No.	CHECKED BY	

STATE OF HAWAII
DEPARTMENT OF TRANSPORTATION
HIGHWAYS DIVISION

TRAFFIC DETOUR

WAIAWA INTERCHANGE
F.A.I. Proj. No. I - HI - 1(36)8

Scale: As shown Date: OCT 1967

SHEET No. OF SHEETS

MIN TAGUCHI
REGISTERED PROFESSIONAL ENGINEER
No. 1630
HAWAII, U.S.A.

THIS WORK WAS PREPARED BY ME OR UNDER MY SUPERVISION.

38