FED. ROAD DIST. NO.	STATE	FED. AID PROJ. NO.	FISCAL YEAR	SHEET NO.	TOTAL SHEETS
HAWAII	HAW.	I-HI-1(44)8	1967	1	28

INDEX TO DRAWINGS

SHT. NO	DESCRIPTION
1	Title Sheet
2	Layout Plan
3	Boring Plan
4	Typical Roadway Sections
	Plan and Profile
5	H-1 Inbound & H-1 Outbound
6	H-2 Inb. to H-1 Outb. & H-1 Inb. to H-2 Outb.
7	Temporary Connector 1, 2 & 3
8-9	Superelevation Diagrams
10	Intersection Details
11	Drainage Plan
12	Fuel Lines Relocation Plan
13-14	Trunk Sewer Plan and Details
15-20	Traffic Signs and Pavement Markers
21-23	Guard Rails Details
24-27	Electrical Plan and Details
28	Cross Sections

STATE OF HAWAII

DEPARTMENT OF TRANSPORTATION

HIGHWAYS DIVISION

HONOLULU, HAWAII

"AS-BUILT"

PLANS FOR

CONSTRUCTION OF A PORTION OF

INTERSTATE ROUTE H-1

WAIAWA INTERCHANGE

FEDERAL AID INTERSTATE PROJECT No. I-HI-1(44):8

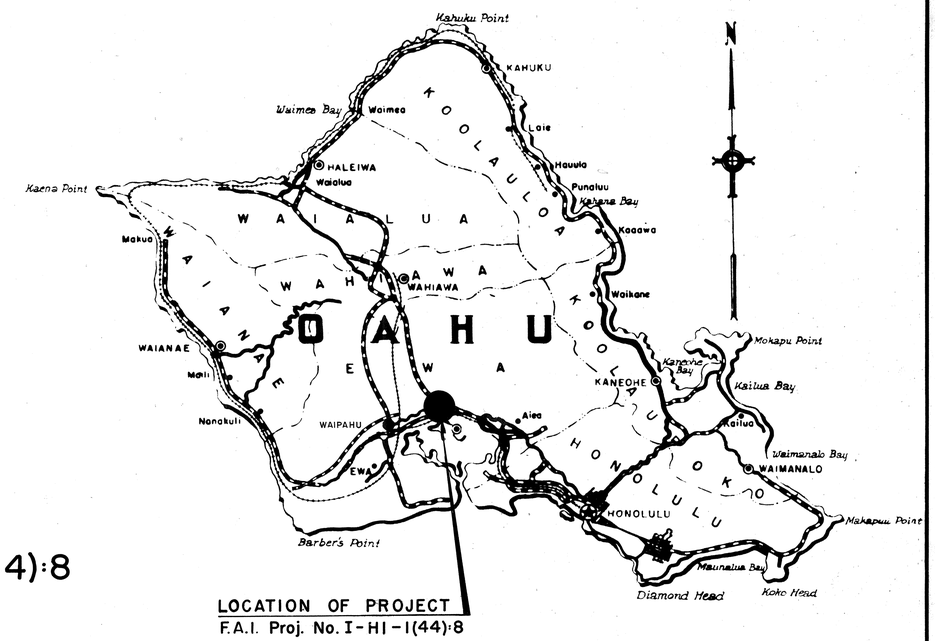

LOCATION OF PROJECT
F.A.I. Proj. No. I-HI-1(44):8

Federal Aid Projects Previously Constructed Or Under Construction

DISTRICT OF EWA
ISLAND OF OAHU

NOTE:

ALL CHANGES MADE DURING CONSTRUCTION HAVE BEEN NOTED IN RED ON THESE TRACINGS AND CHECKED BY:

Kenneth Shelton
PROJECT ENGINEER

1/18/72
DATE

SCALES:

PLAN & PROFILE	HOR.	1" = 50'
	VER.	1" = 10'
DETAIL ROADWAY PLAN		1" = 20'
CROSS SECTION	HOR.	1" = 10'
	VER.	1" = 10'

DESIGN CLASSIFICATION

DESIGN ADT (1988)	56,900
DHV	10 %
D	60/40
T	3.5 %
V	70 m.p.h.

APPROVED: Date: 2/28/68

John D. Wise Duff
FOR DIRECTOR OF TRANSPORTATION

DEPARTMENT OF TRANSPORTATION
BUREAU OF PUBLIC ROADS

APPROVED:

John B. Dallman 4-19-68
DIVISION ENGINEER DATE

ORIG. NAT. PLAN
NOTE BOOK No.
SURVEY PLOTTED BY
DRAWN BY
TRACED BY
QUANTITIES BY
QUANTITIES CHECKED BY
DATE

I