FED. ROAD DIST. NO.	STATE	FED. AID PROJ. NO.	FISCAL YEAR	SHEET NO.	TOTAL SHEETS
HAWAII	HAW.	I-HI-1(48):9	1968	28	133

GENERAL NOTES:

1. The Contractor shall station flagmen and install and maintain suitable warning signs during his hauling operations along and across roadways used for the passage of public traffic. The signing layout shall be approved by the Engineer prior to its incorporation.
2. The Contractor shall confine his fill operations to the limits shown on this sheet.
3. Spillage along the haul route resulting from the hauling operations shall be cleaned off immediately by the Contractor.
4. The Contractor shall make such repairs to roadways along the haul route as may be required as a result of his hauling operations.
5. Irrigation improvements shown on Sht. 27A shall be completed and the system operable prior to disposal of surplus material.

℄ CURVE DATA

CURVE	Δ	Δ/2	R	T	Lc	Ch
①	55° 00' 00"	27°30' 00"	1500.00	780.85	1439.90	1385.25
②	12° 20' 20"	06°10' 10"	3600.00	389.14	775.28	773.78
③	41° 28' 00"	20°44' 00"	1524.00	576.89	1102.96	1079.05
④	06° 16' 40"	03°08' 20"	3273.74	179.93	358.70	358.52
⑤	14° 04' 20"	07°02' 10"	3600.00	444.33	884.18	881.96
⑥	16° 06' 00"	08°03' 00"	1400.00	198.00	393.40	392.10
⑦	17° 26' 00"	08°43' 00"	800.00	122.66	243.41	242.48
⑧	51° 26' 00"	25°43' 00"	444.53	214.10	399.05	385.78

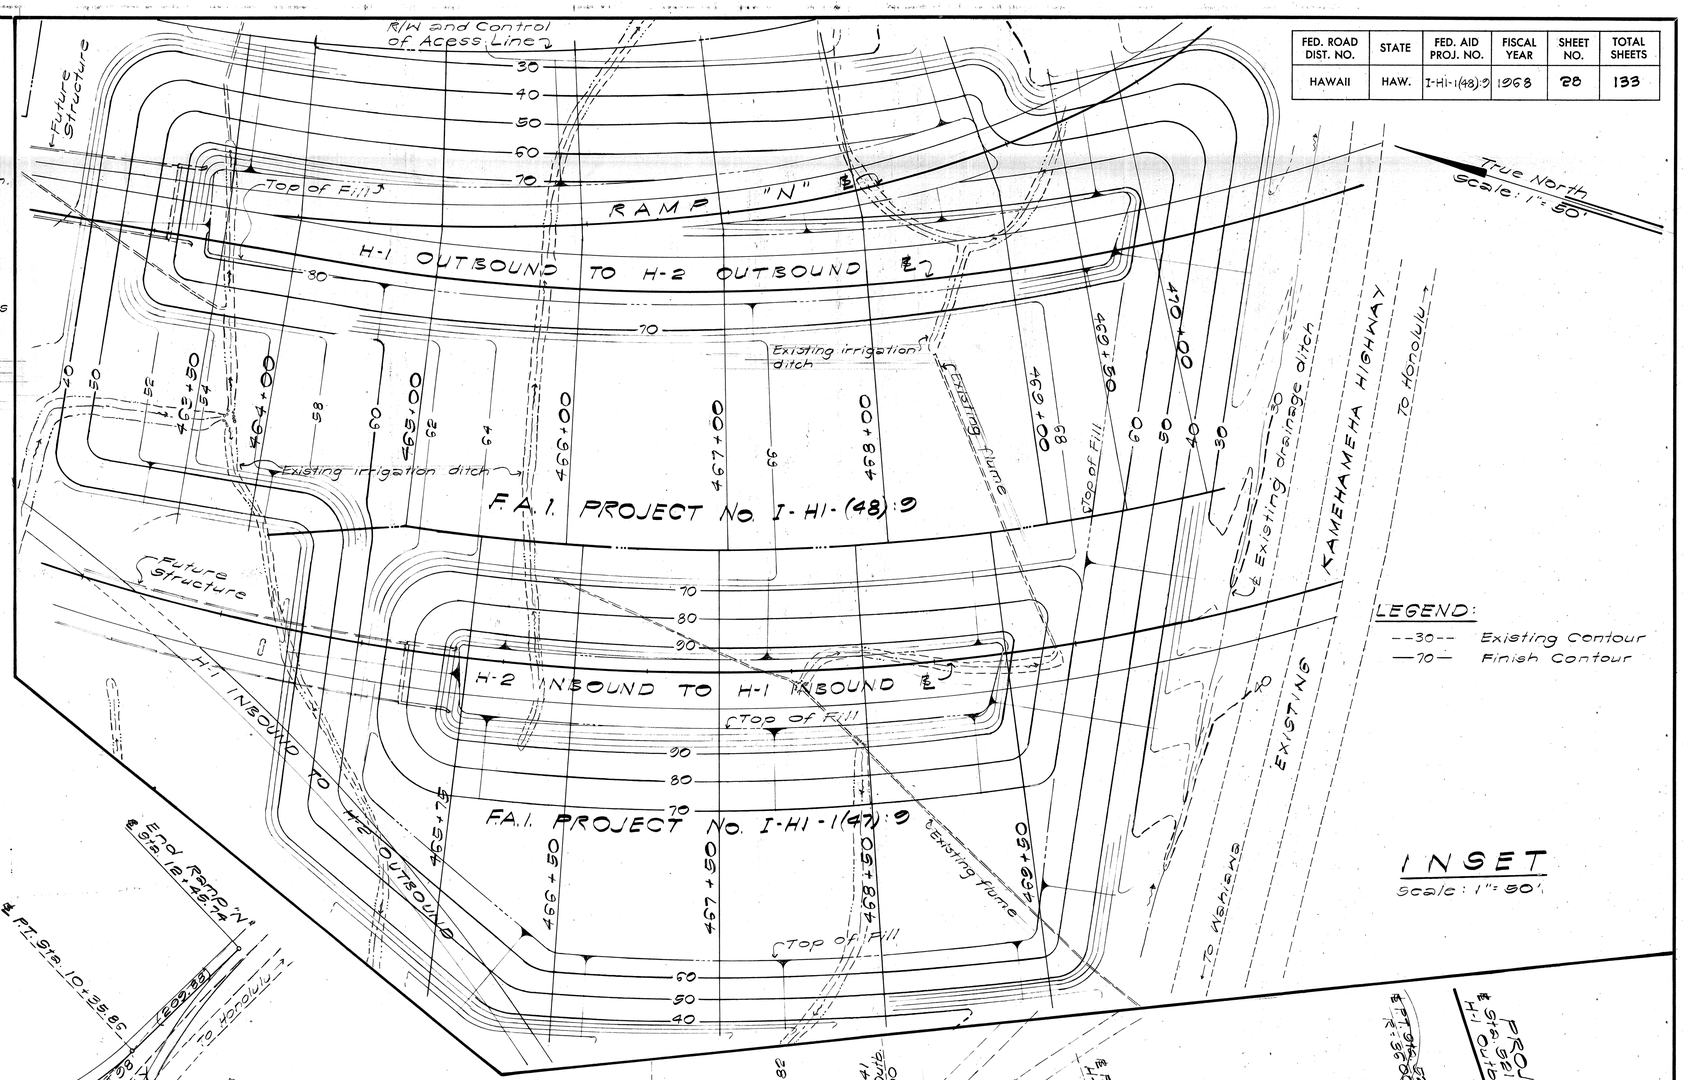

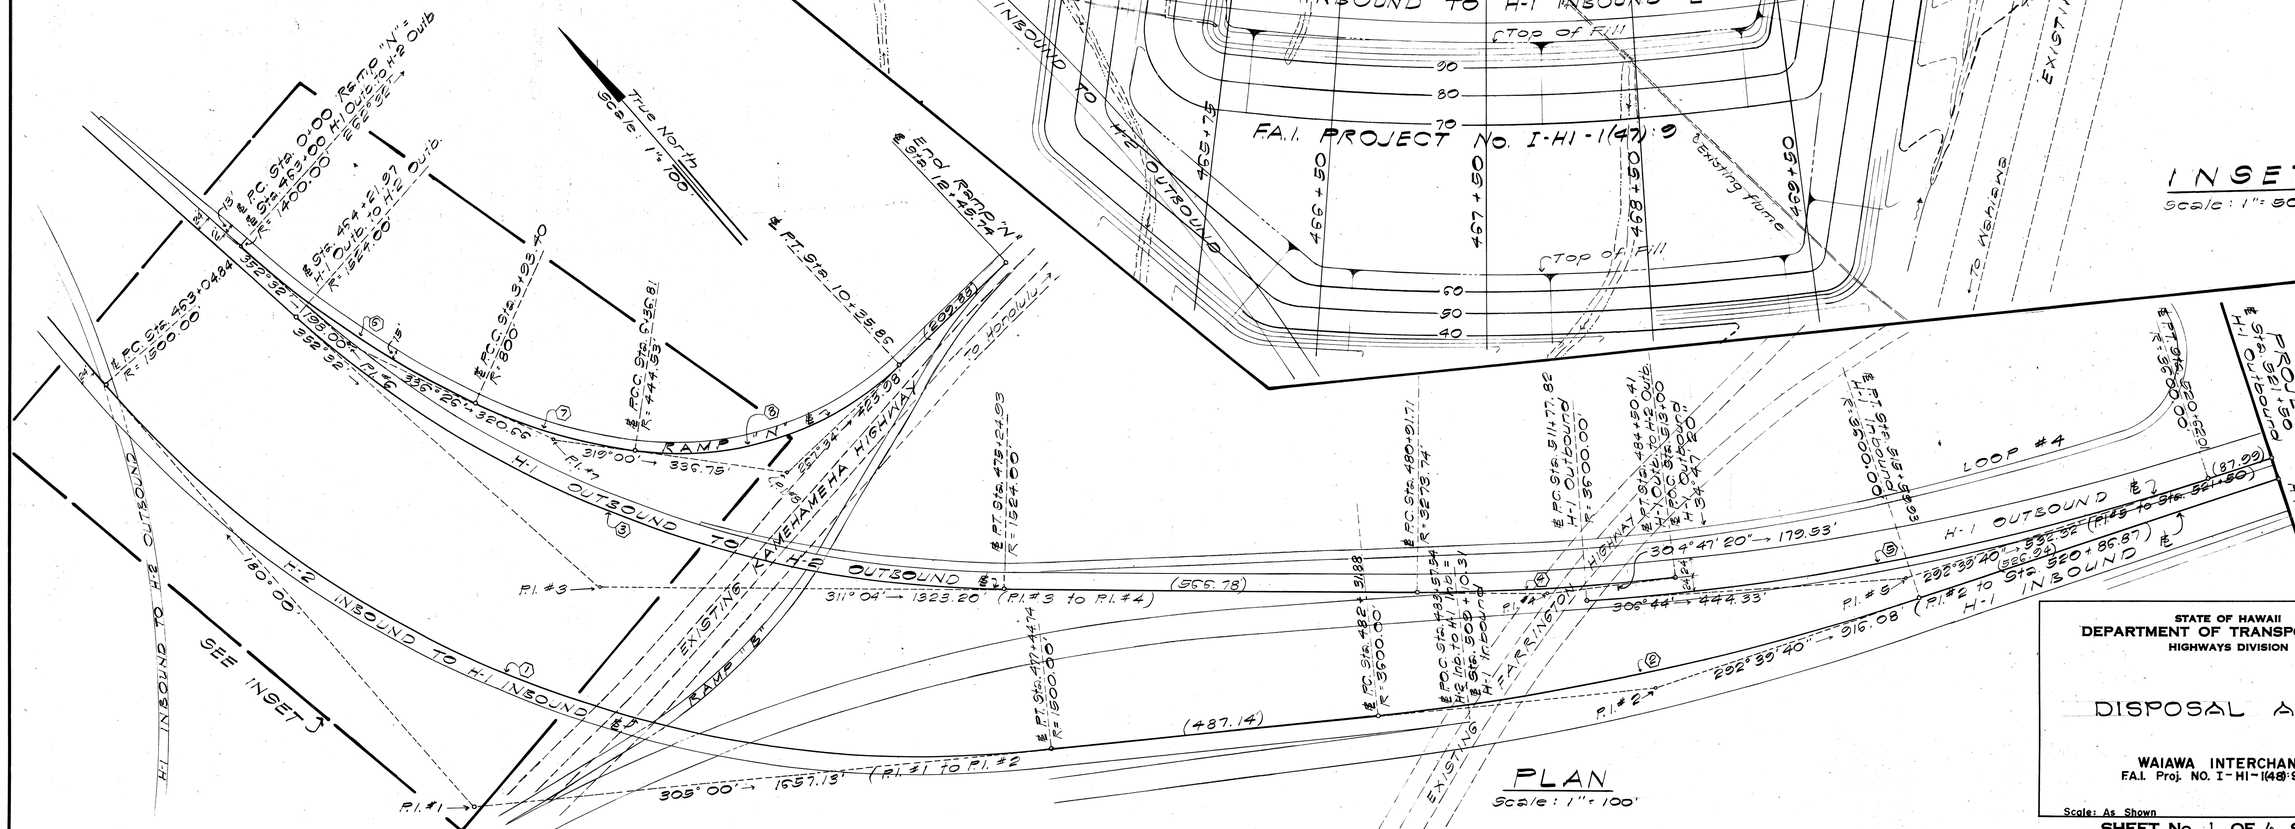

LEGEND:

--30-- Existing Contour
—70— Finish Contour

ORIGINAL PLAN	SURVEY PLOTTED BY:	DATE:
	DRAWN BY:	
	TRACED BY:	
NOTE BOOK	DESIGNED BY:	
	QUANTITIES BY:	
No.	CHECKED BY:	

STATE OF HAWAII
DEPARTMENT OF TRANSPORTATION
HIGHWAYS DIVISION

DISPOSAL AREA

WAIAWA INTERCHANGE
F.A.I. Proj. NO. I-HI-1(48):9

Scale: As Shown Date: Aug. 1968

SHEET No. 1 OF 6 SHEETS

FED. ROAD DIST. NO.	STATE	FED. AID PROJ. NO.	FISCAL YEAR	SHEET NO.	TOTAL SHEETS
HAWAII	HAW.	FHI-1(8)9	1968	29	133

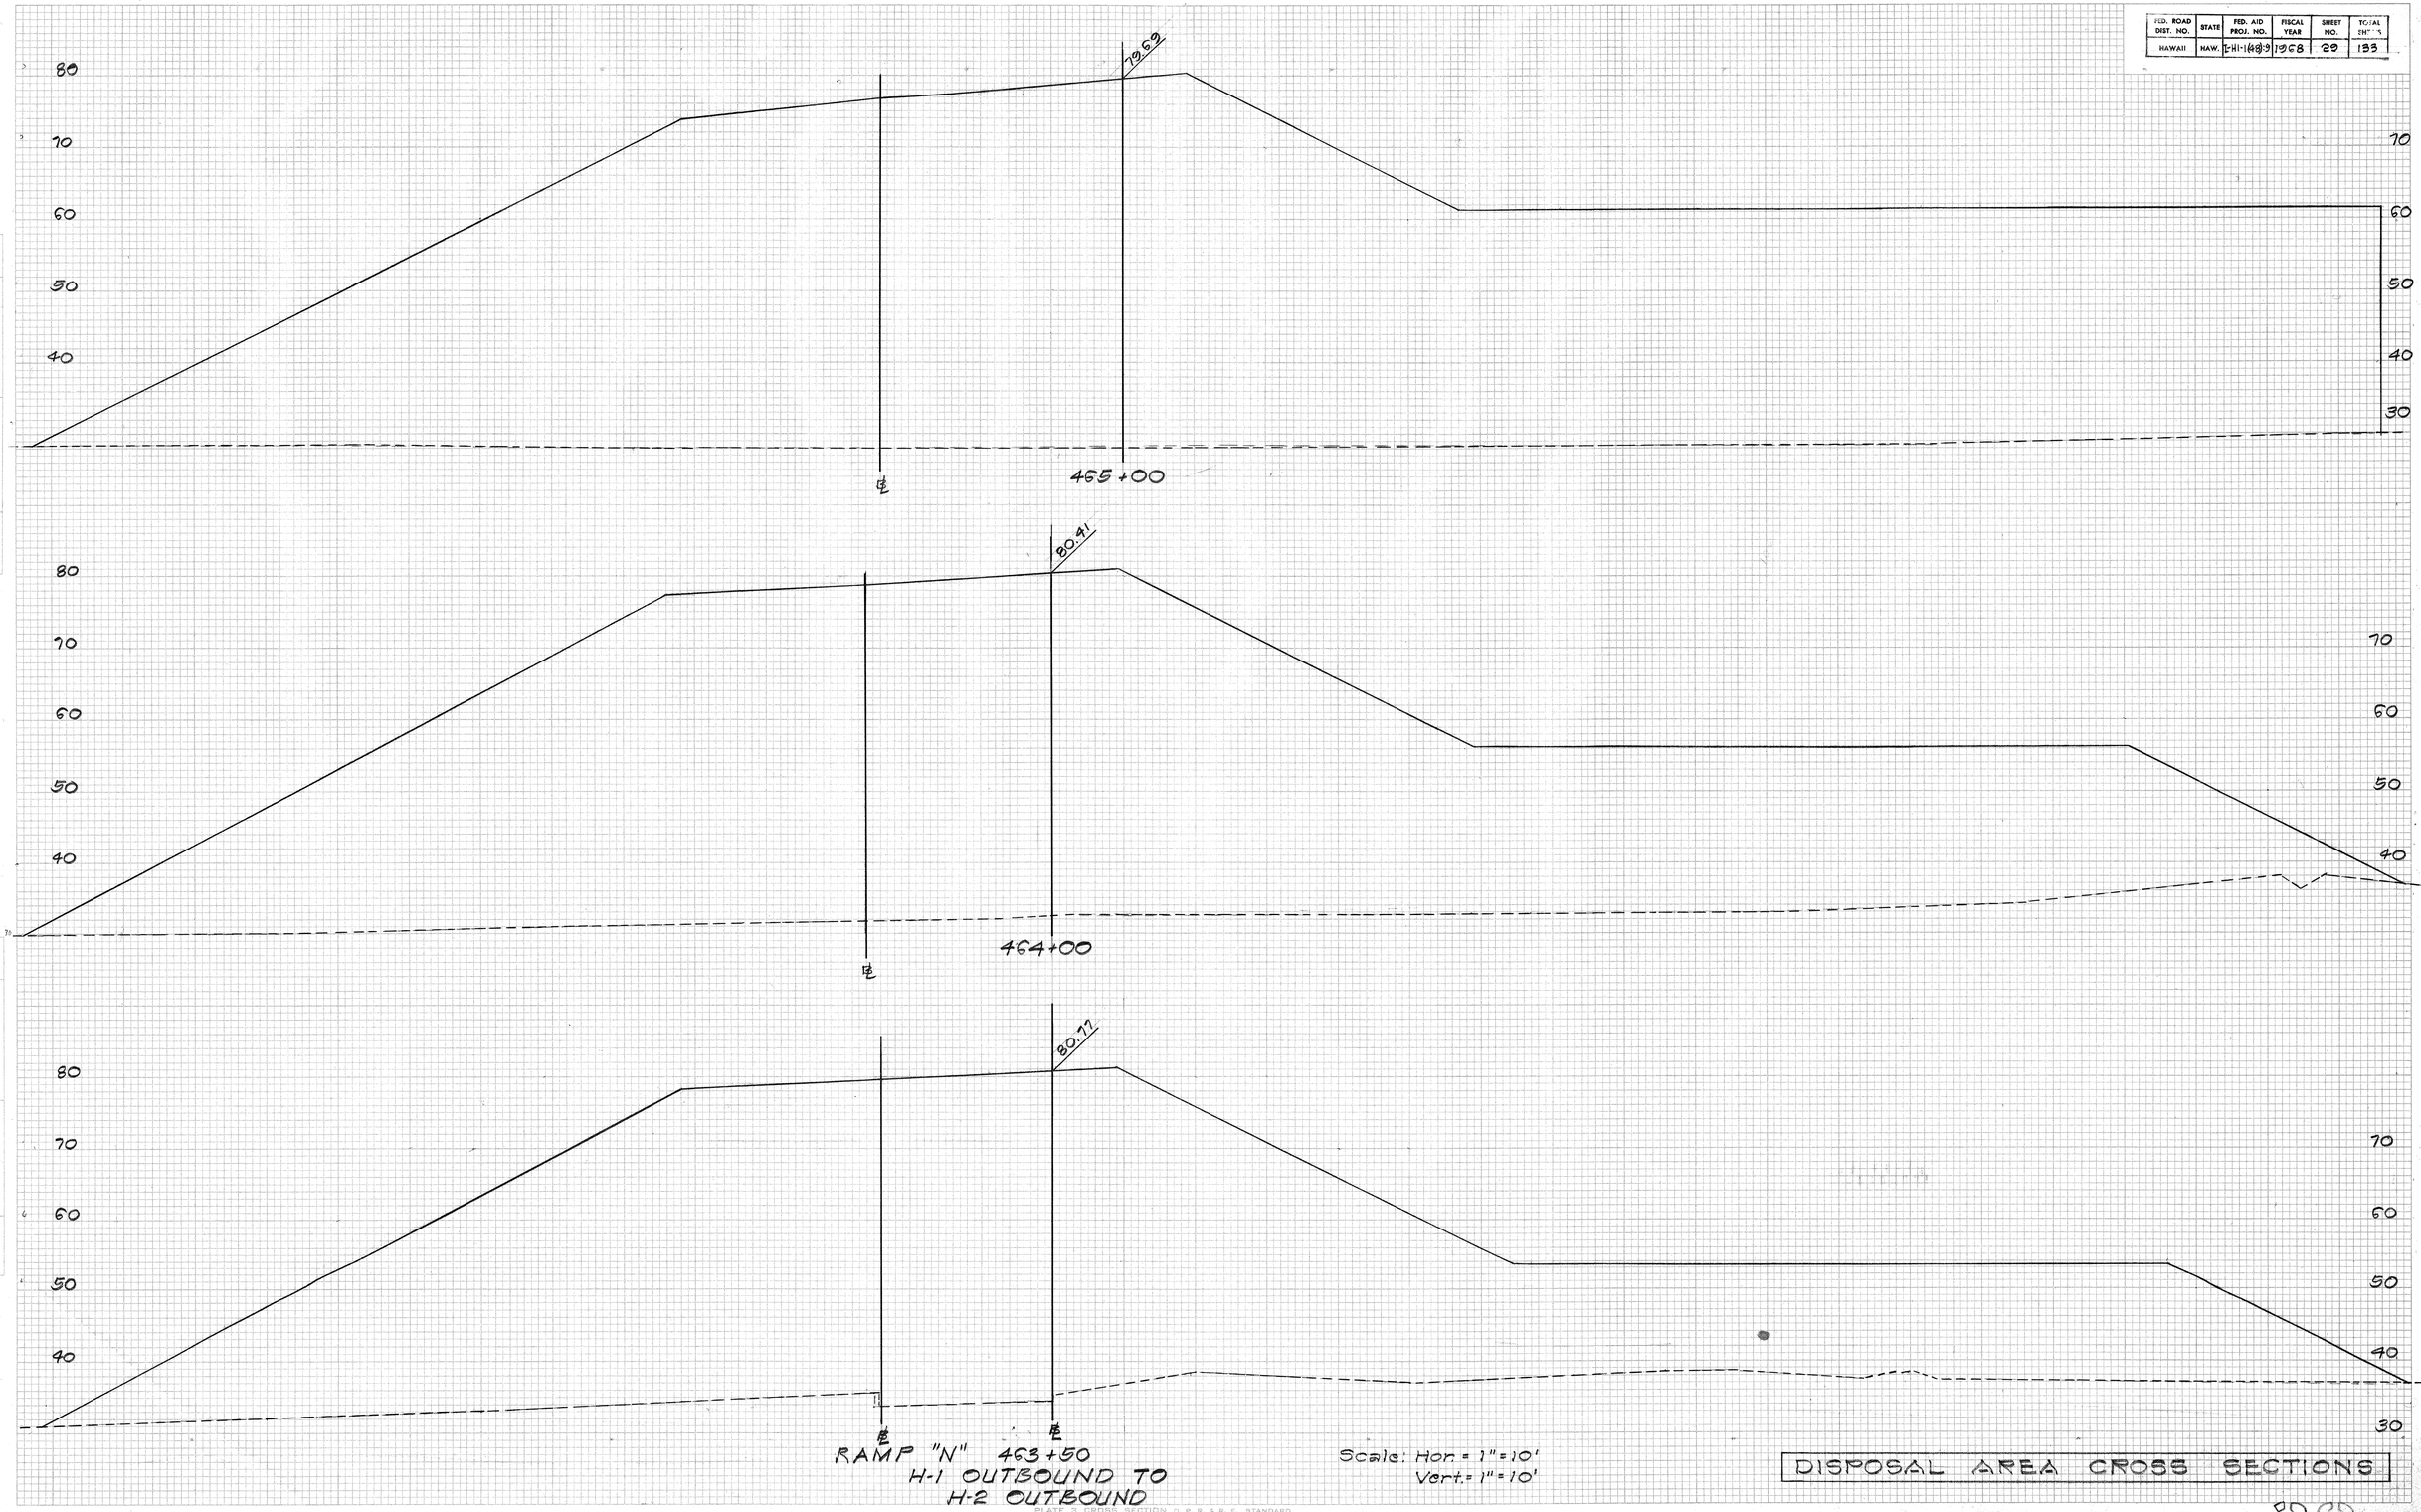

RAMP "N" 463+50
H-1 OUTBOUND TO
H-2 OUTBOUND

Scale: Hor. = 1" = 10'
Vert. = 1" = 10'

DISPOSAL AREA CROSS SECTIONS

PLATE 3 CROSS SECTION U. P. R. & R. E. STANDARD
100% AGEPROOF VELLUM - MADE AND PRINTED IN U.S.A.
EUGENE DIETZGEN CO.

SHEET No. 2 OF 6 SHEETS

29
H-1 Outb to H-2 Outb
3

FINAL SURVEY — SURVEYED, PLOTTED, NOTE BOOK, NO., TEMPLATE, AREAS, AREAS CHECKED, BY, DATE

ORIGINAL SURVEY — SURVEYED, PLOTTED, NOTE BOOK, NO., TEMPLATE, AREAS, AREAS CHECKED, BY, DATE

FED. ROAD DIST. NO.	STATE	FED. AID PROJ. NO.	FISCAL YEAR	SHEET NO.	TOTAL SHEETS
HAWAII	HAW.	I-HI-1(48)9	1968	30	133

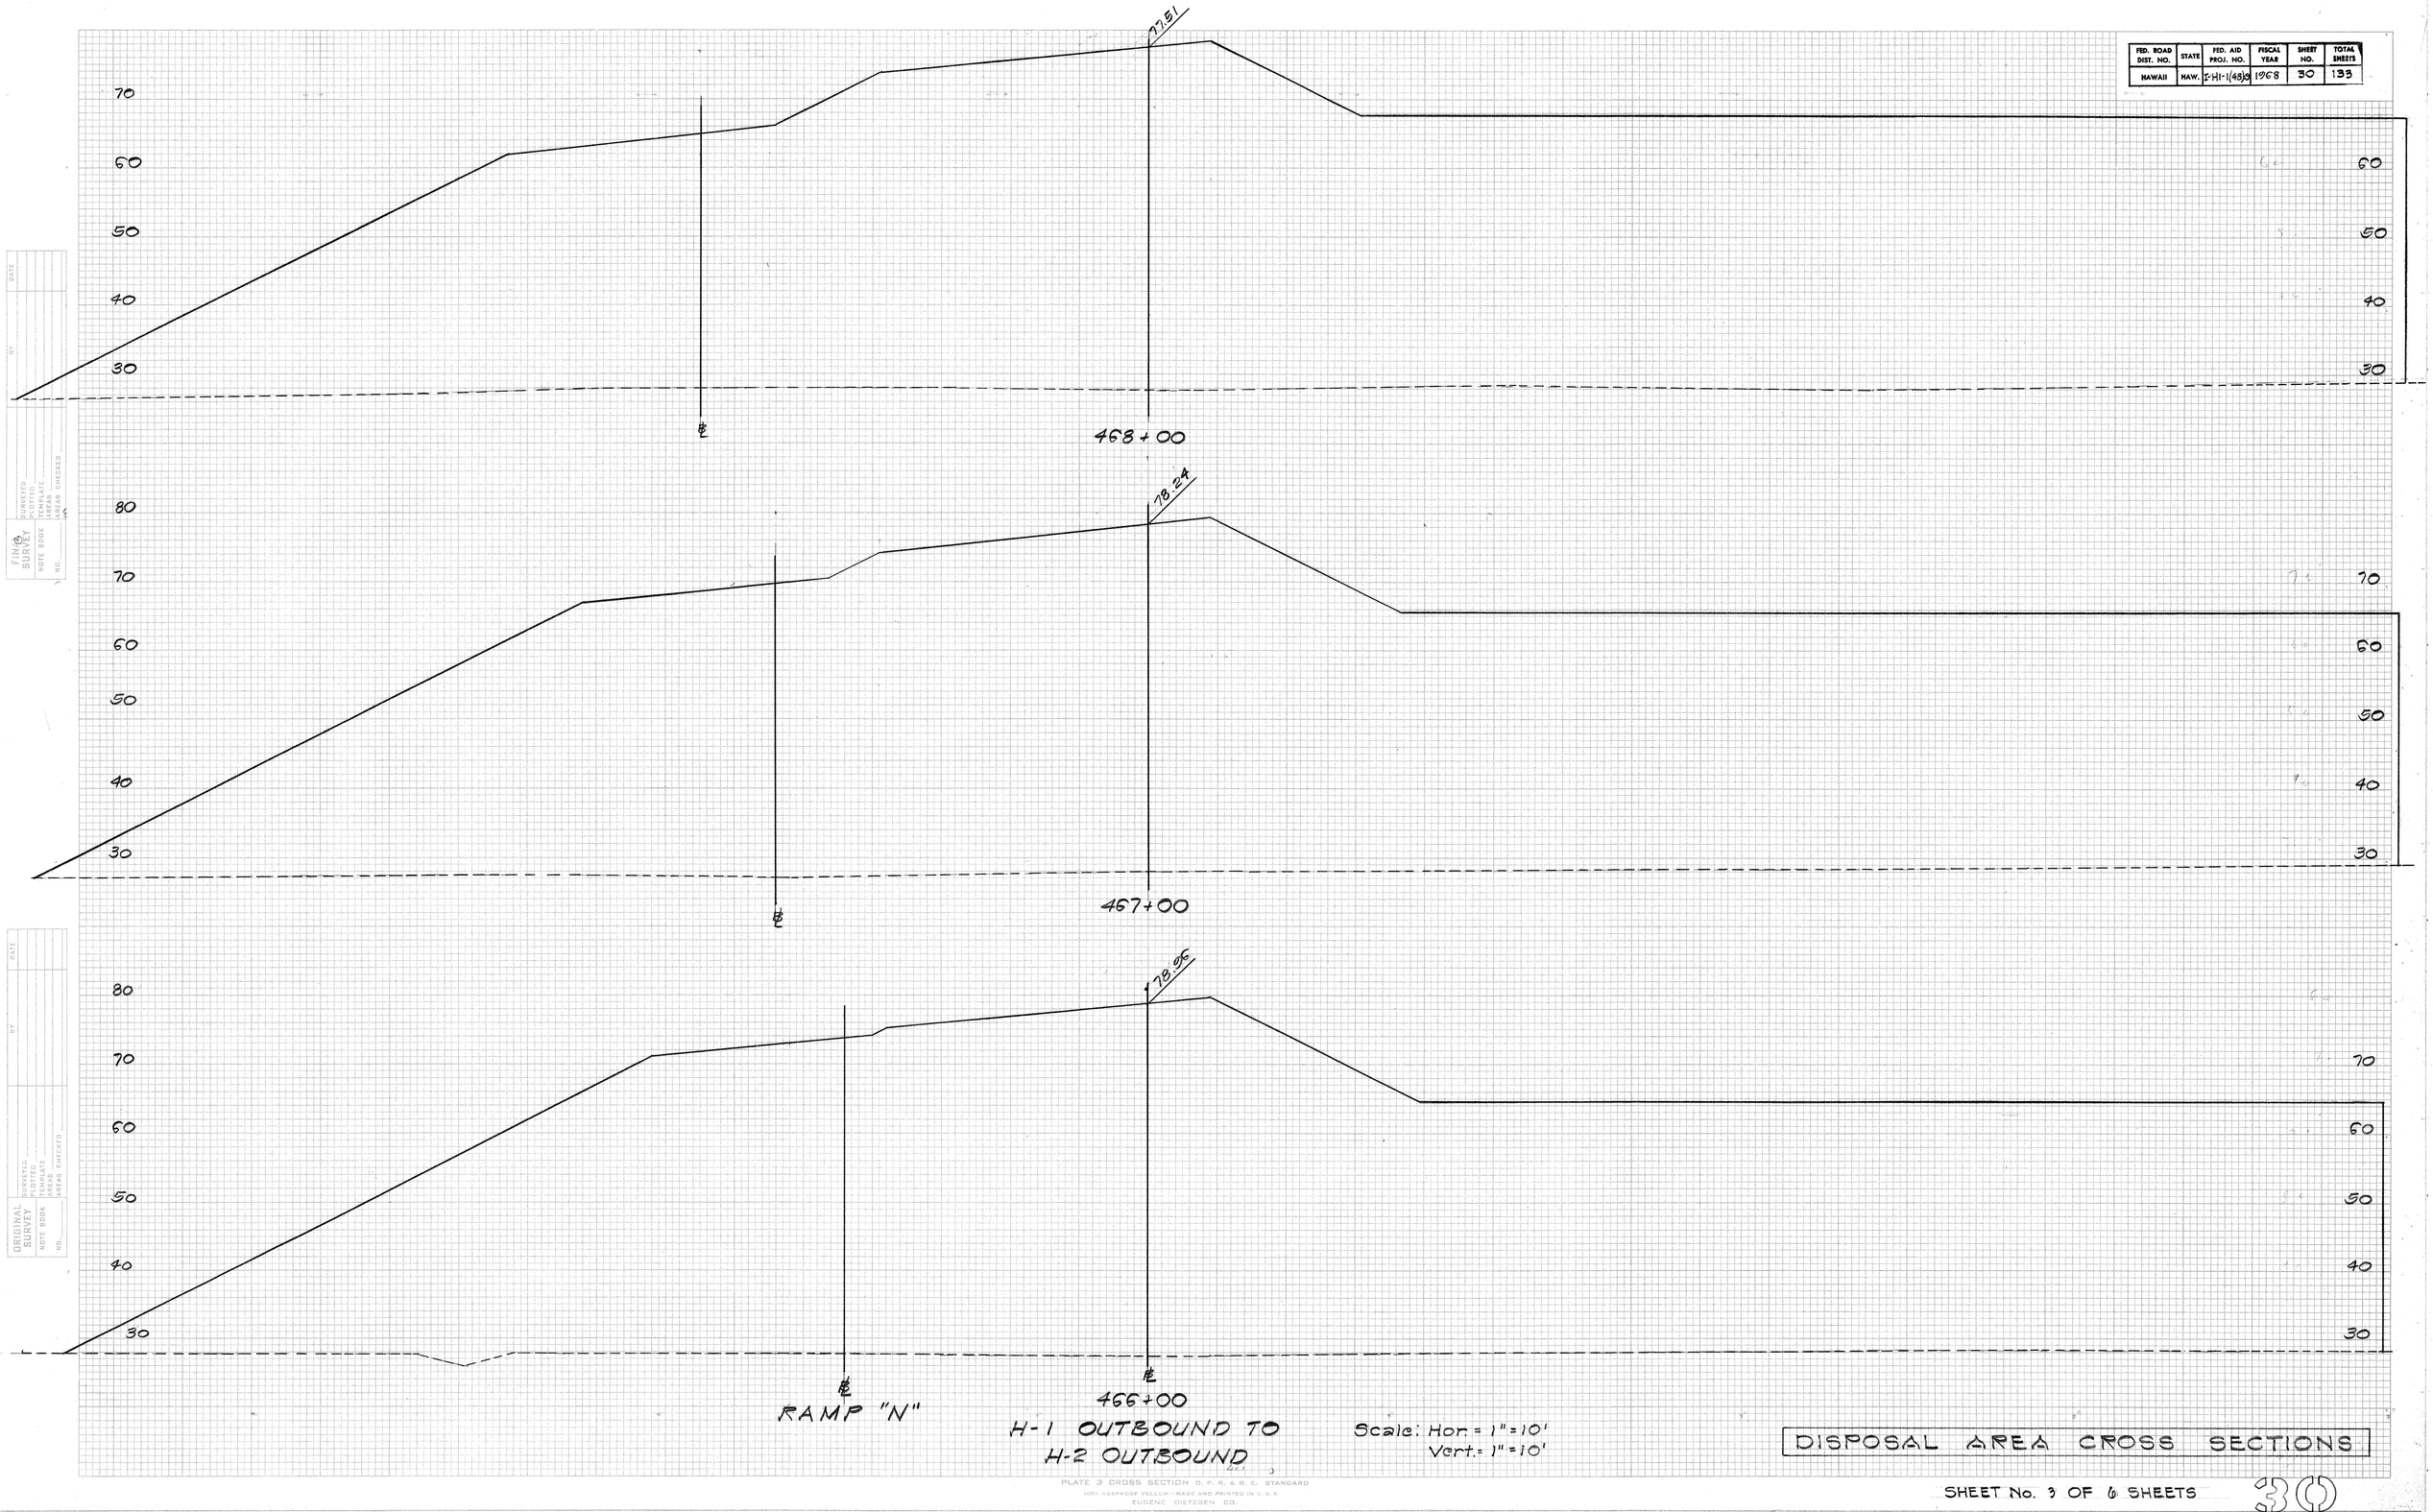

Scale: Hor.= 1"=10'
Vert.= 1"=10'

DISPOSAL AREA CROSS SECTIONS

PLATE 3 CROSS SECTION C. P. R. & R. E. STANDARD
100% ASEPHOSE VELLUM - MADE AND PRINTED IN U. S. A.
EUGENE DIETZGEN CO.

SHEET No. 3 OF 6 SHEETS

30

FED. ROAD DIST. NO.	STATE	FED. AID PROJ. NO.	FISCAL YEAR	SHEET NO.	TOTAL SHEETS
HAWAII	HAW.	I-HI-1A8)-9	1968	31	133

70
60
50
40
30

470+00

8
70
60
50
40
30

76.43

469+50

70
60
50
40
30

76.79

℄ RAMP "N"

℄ 469+00
H-1 OUTBOUND TO
H-2 OUTBOUND

Scale: Hor. = 1" = 10'
Vert = 1" = 10'

DISPOSAL AREA CROSS SECTIONS

SHEET No 4 OF 6 SHEETS

31

ORIGINAL SURVEY — PLOTTED, SHOWN, NOTE BOOK, NO. —, BY, DATE

FINAL SURVEY — SURVEYED, PLOTTED, TEMPLATE, AREAS, CROSS CHECKED, BY, DATE

PLATE 3 CROSS SECTION, F.A.S.
CLEARPRINT PAPER CO., S. F. CAL.
NO. 1020H 3

FED. ROAD DIST. NO.	STATE	FED. AID PROJ. NO.	FISCAL YEAR	SHEET NO.	TOTAL SHEETS
HAWAII	HAW.	I-HI-1(48)9	1968	32	133

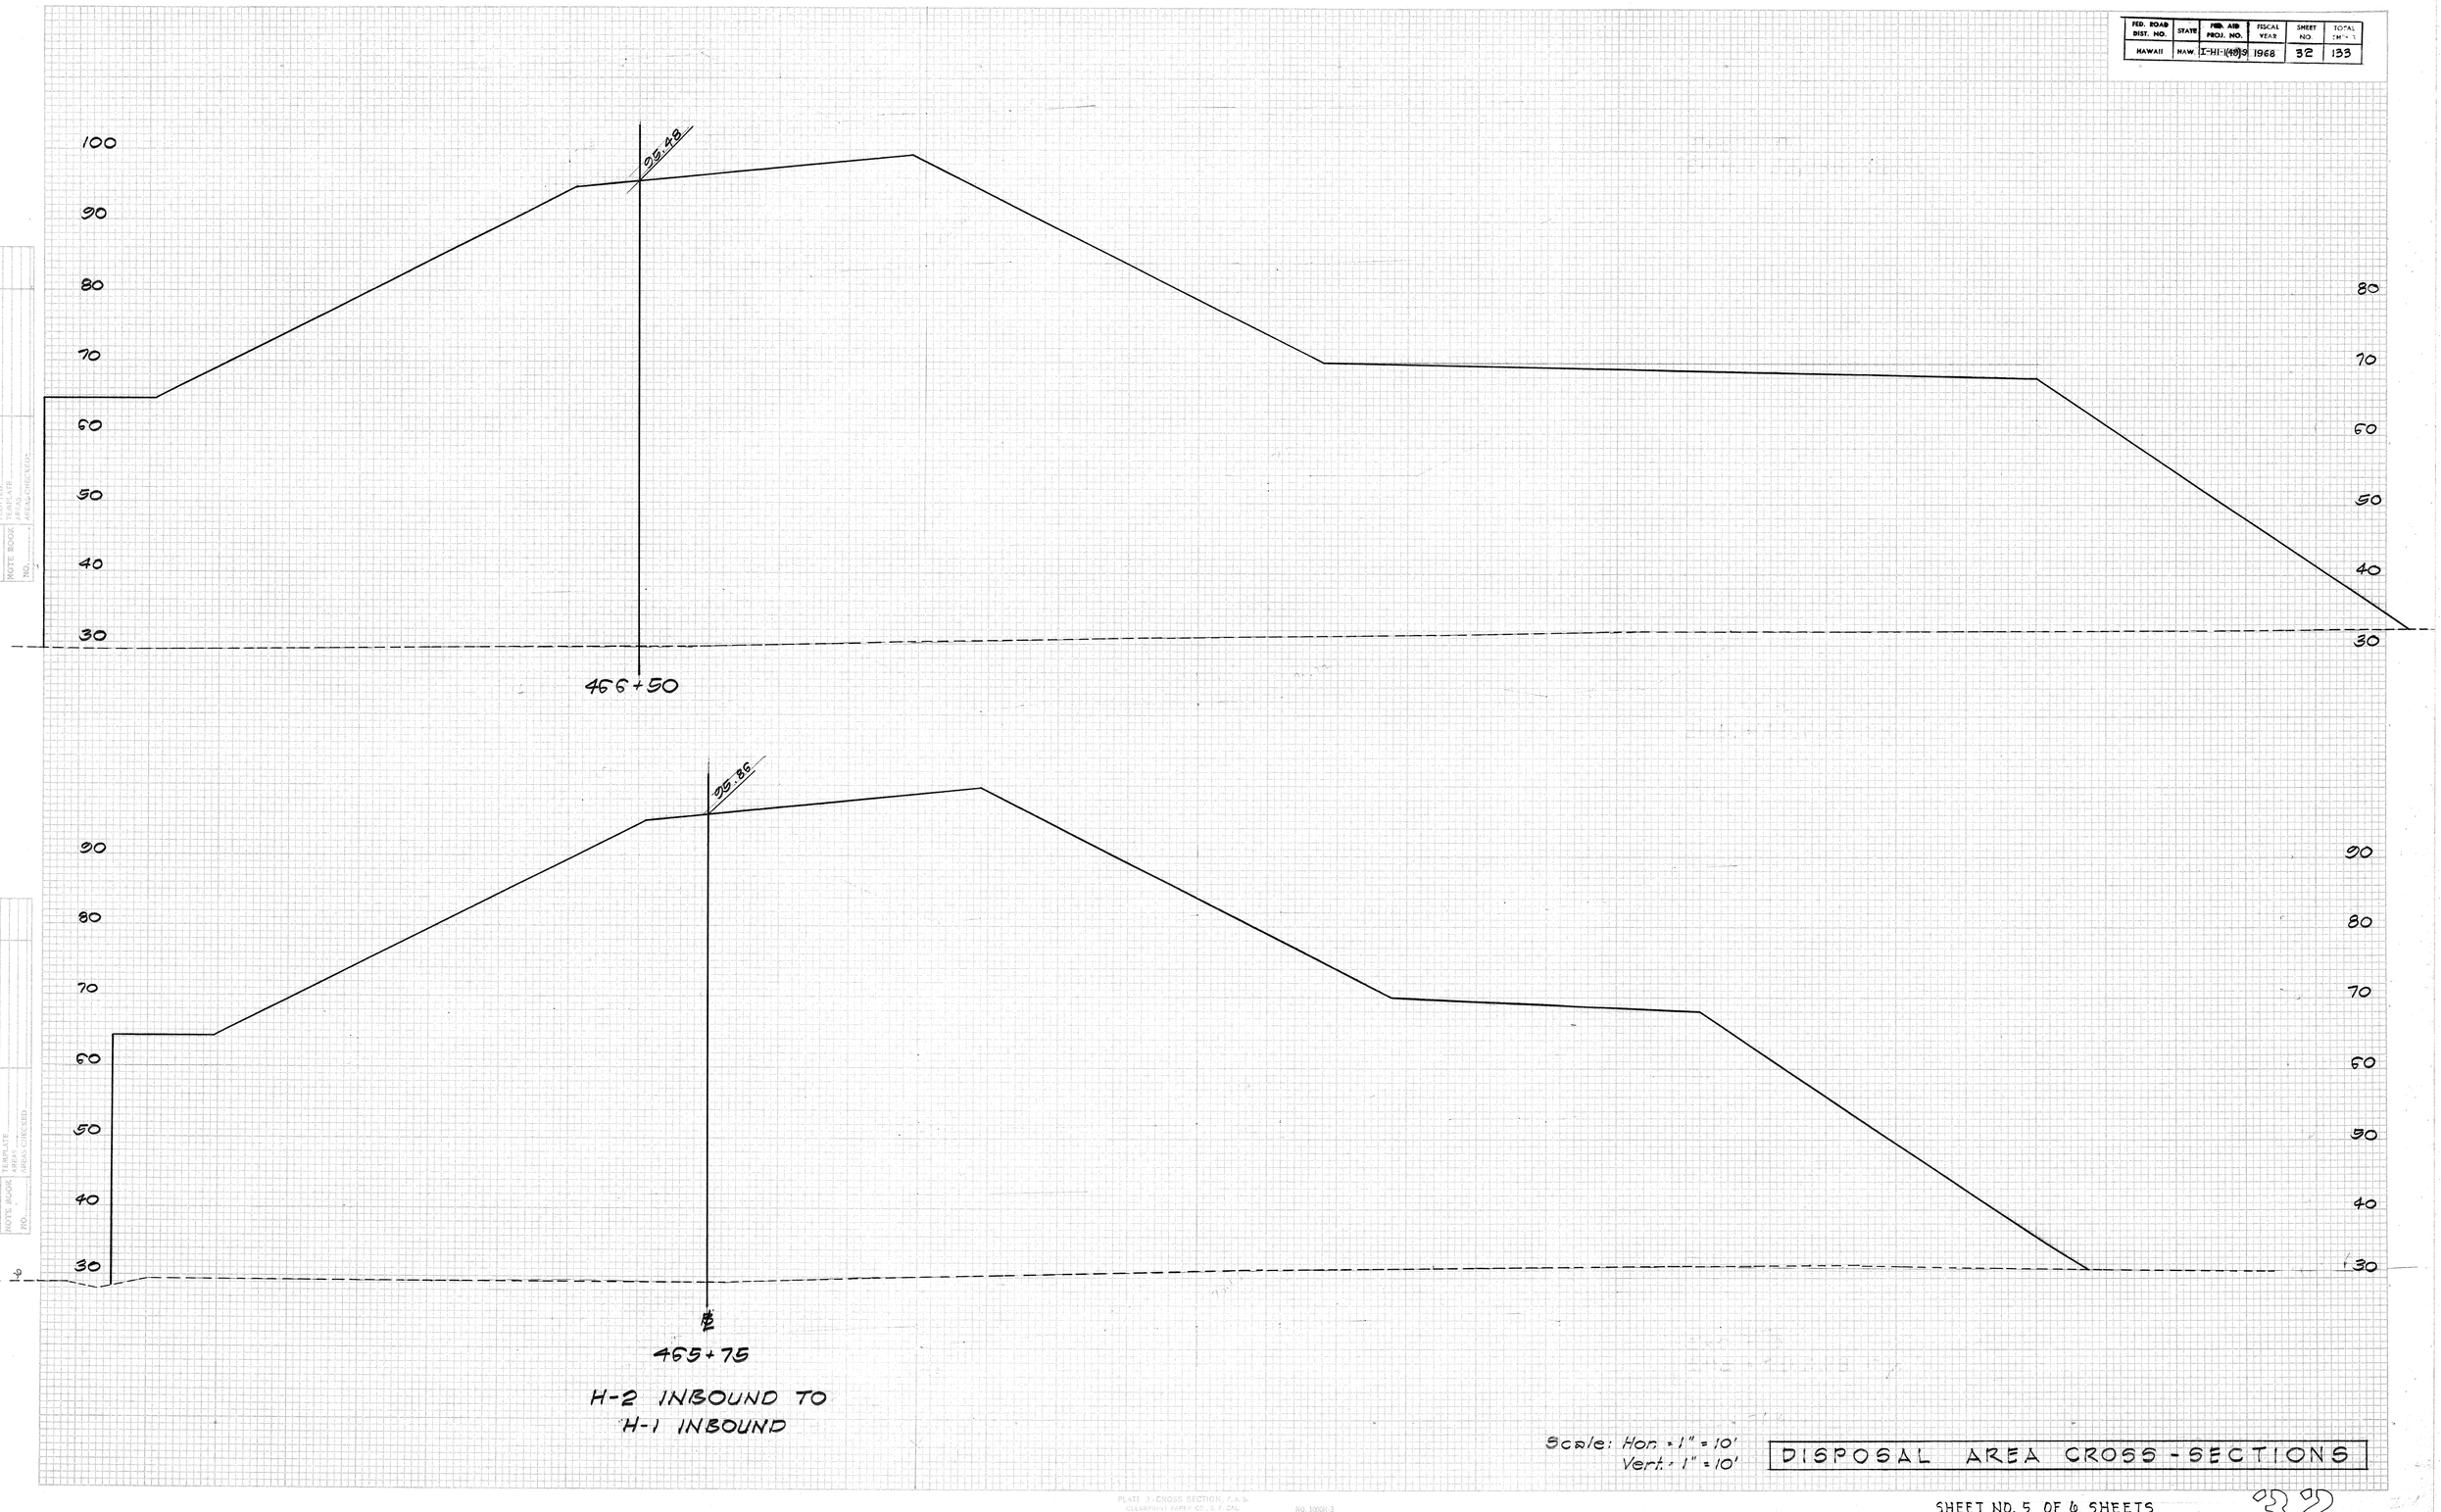

ORIGINAL SURVEY — SURVEYED / PLOTTED / TEMPLATE / AREAS / CROSS-CHECKED — NOTE BOOK — NO. — BY — DATE

FINAL SURVEY — SURVEYED / PLOTTED / TEMPLATE / AREAS / CROSS-CHECKED — NOTE BOOK — NO. — BY — DATE

Scale: Hor. = 1" = 10'
Vert. = 1" = 10'

DISPOSAL AREA CROSS-SECTIONS

SHEET NO. 5 OF 6 SHEETS

32

PLATE 3-CROSS SECTION, F.A.S. CLEARPRINT PAPER CO., S. F. CAL. NO. 10004-3

FED. ROAD DIST. NO.	STATE	FED. AID PROJ. NO.	FISCAL YEAR	SHEET NO.	TOTAL SHEETS
HAWAII	HAW.	I-HI-1(48)8	1968	33	133

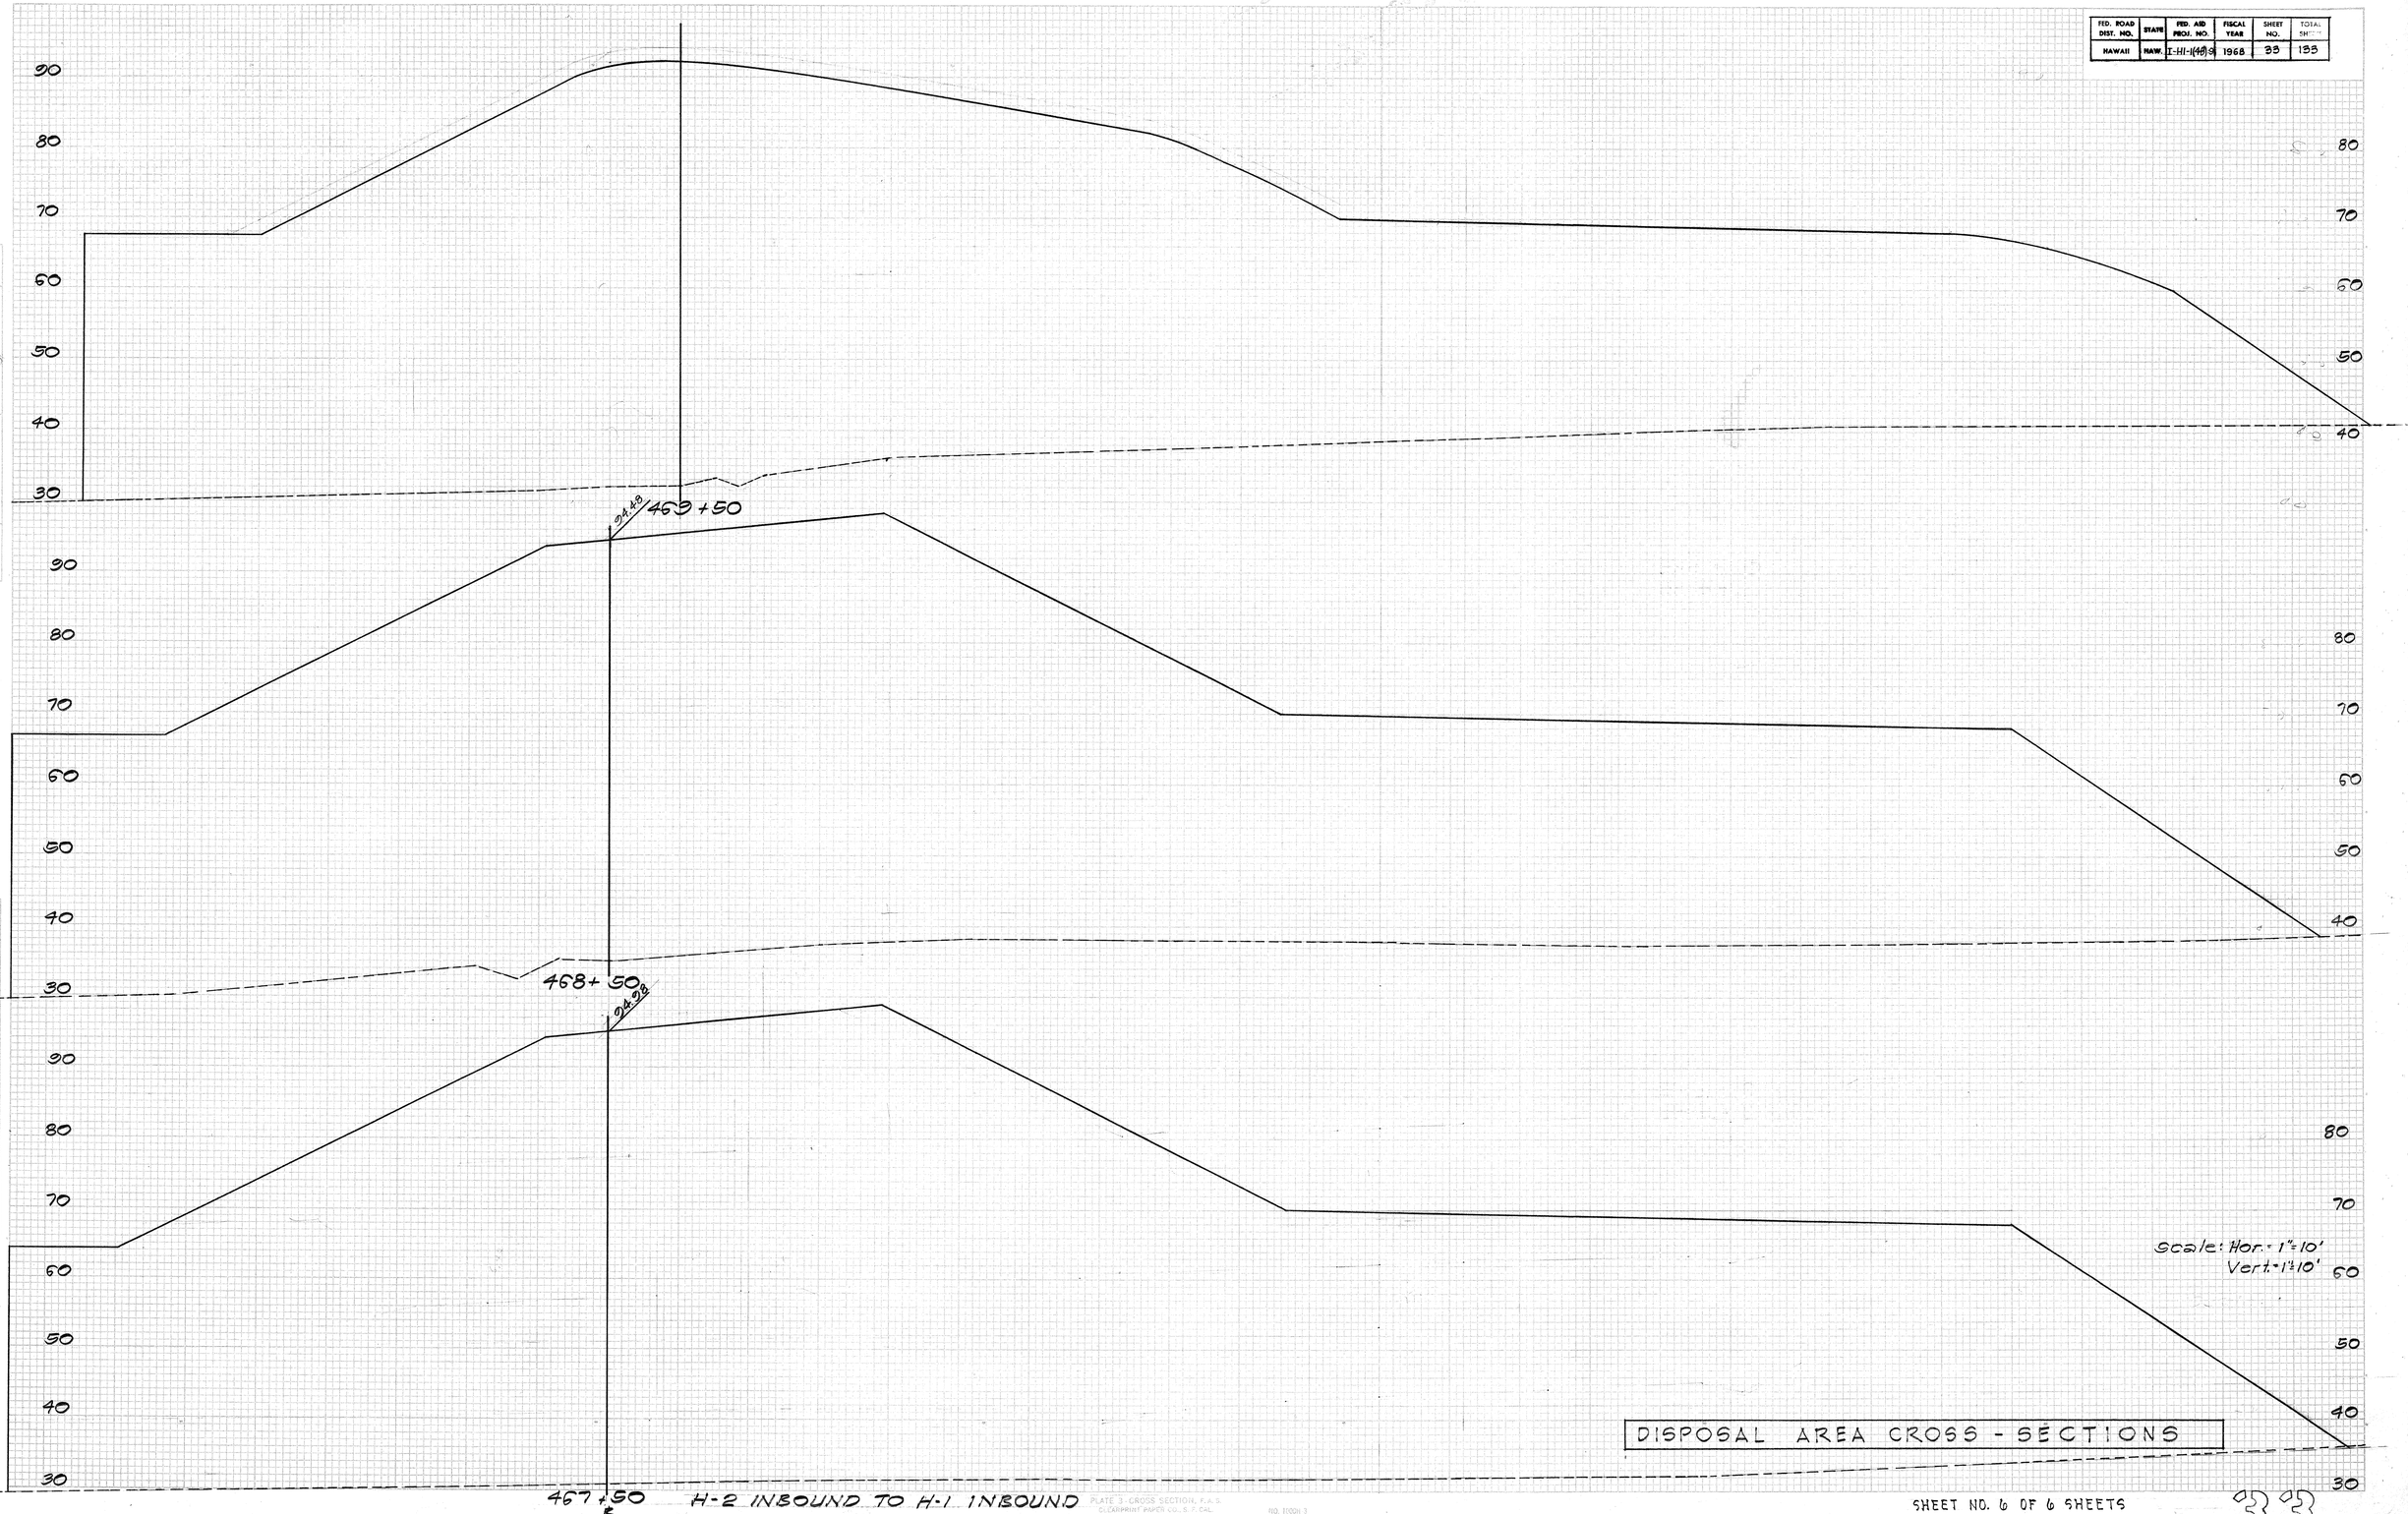

DISPOSAL AREA CROSS - SECTIONS

SHEET NO. 6 OF 6 SHEETS

33

H-2 IN to H-1 In (2)

PLATE 3. CROSS SECTION, F.A.S. CLEARPRINT PAPER CO., S. F. CAL. NO. 1000H 3

FINAL SURVEY — SURVEYED / PLOTTED / TRIMPLATE / NOTE BOOK / NO. / AREAS CHECKED / DATE / BY

ORIGINAL SURVEY — SURVEYED / PLOTTED / TRIMPLATE / NOTE BOOK / NO. / AREAS CHECKED / DATE / BY