FED. ROAD DIST. NO.	STATE	FED. AID PROJ. NO.	FISCAL YEAR	SHEET NO.	TOTAL SHEETS
HAWAII	HAW.	I-HI-1(47):9	1969	C013A	238

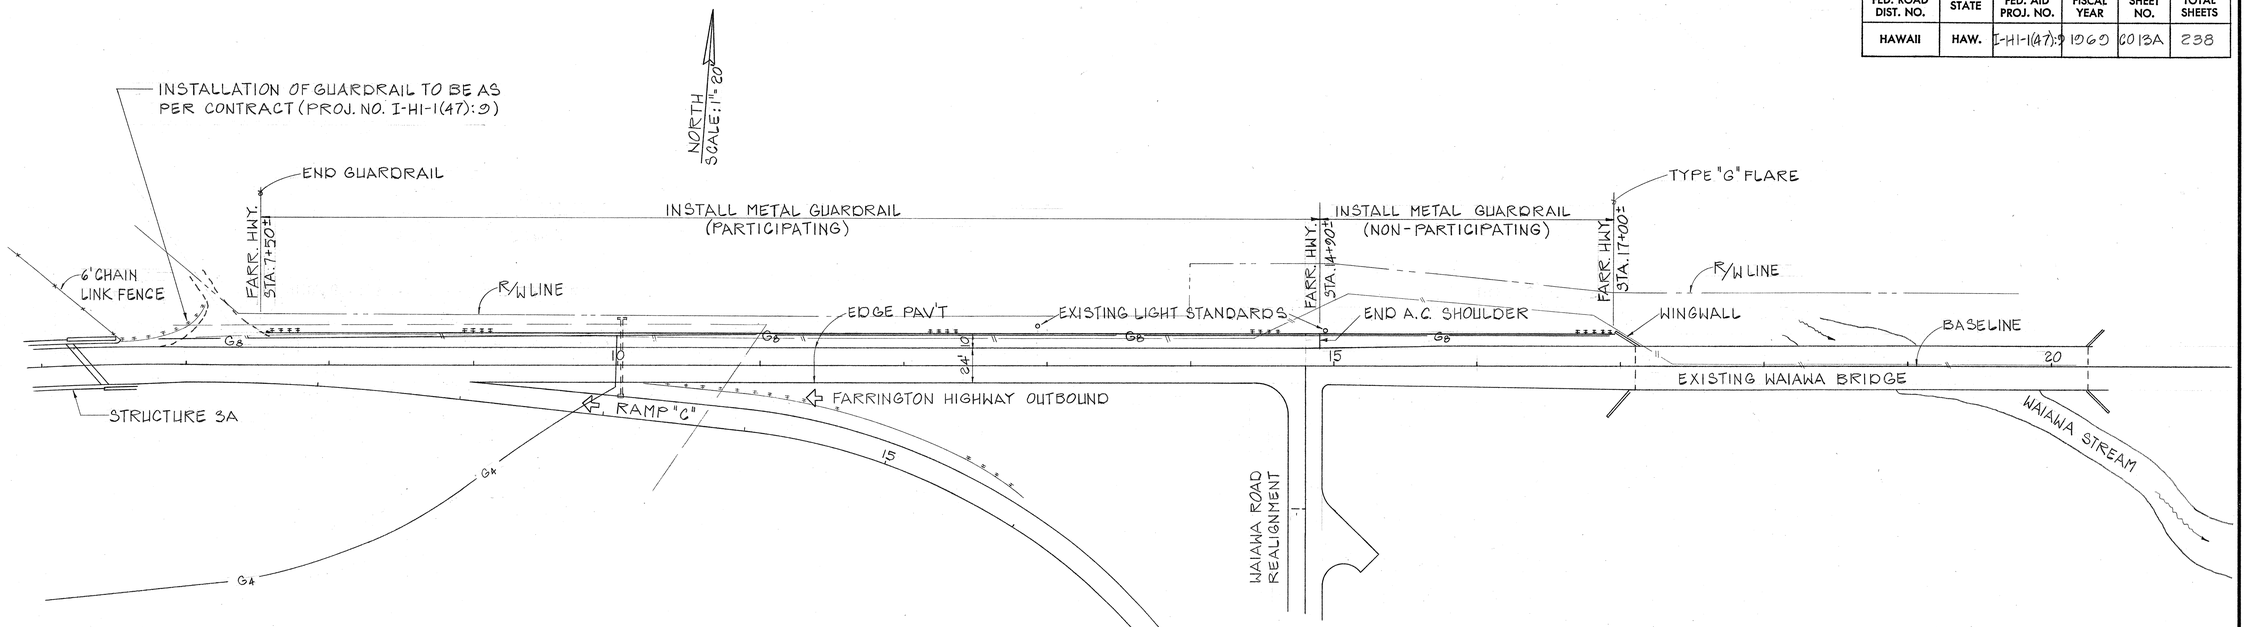

EXISTING UNDERGROUND STRUCTURES

—Gs—	GAS LINE
——	ELECTRIC LINE
—\\—	ARMY SIGNAL CORPS CABLE

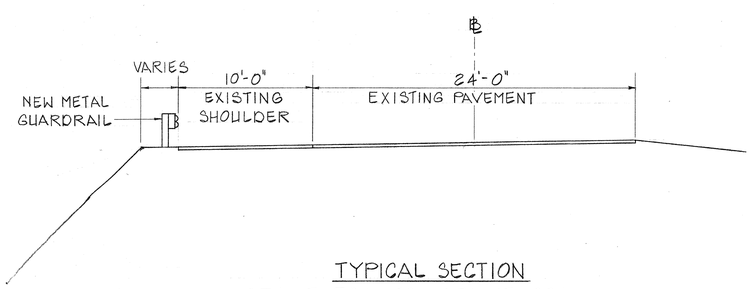

TYPICAL SECTION
STA. 7+50± TO STA. 17+00±
SCALE: 3/16" = 1'-0"

GENERAL NOTES

LOCATION OF EXISTING UNDERGROUND STRUCTURES SUCH AS CULVERTS, PIPELINES, CONDUITS, CABLES, ETC., AS SHOWN ON THE PLANS ARE APPROXIMATE ONLY, OTHER EXISTING UTILITIES MAY NOT BE SHOWN. THE CONTRACTOR SHALL CHECK AND VERIFY THE LOCATION OF SAME.

ORIGINAL PLAN	SURVEY PLOTTED BY	DATE
	DRAWN BY	
	TRACED BY	
NOTE BOOK	DESIGNED BY	
	QUANTITIES BY	
No.	CHECKED BY	

STATE OF HAWAII
DEPARTMENT OF TRANSPORTATION
HIGHWAYS DIVISION

GUARDRAIL INSTALLATION
FARRINGTON HIGHWAY
OUTBOUND LANES

F.A.I. Proj. No. I-HI-1(47):9

SCALE: AS SHOWN DATE: NOV., 1969

SHEET No. OF SHEETS

C013A

K+E CRYSTALENS® LA 2920 TRACING PAPER