INDEX TO DRAWINGS	
SHT. NO.	DESCRIPTION
1	TITLE SHEET
2	PLAN AND PROFILE
3	DETAIL PLAN OF ROADWAY
4-6	DETAIL ADJUSTMENT OF PARKING DECK ON TMK: 9-7-19-13
7-9	NAVY UTILITY ACCESS ROAD
10	UTILITY-NAVY'S RAILROAD R/W
11-25	STANDARD DETAILS
26-71	PEARL CITY VIADUCT
72-77	STANDARD BRIDGE DETAILS
78-83	LIGHTING PLAN
84-89	EXPRESSWAY SIGNS
90-91	TRIPLE CELL BOX CULVERT

FED. ROAD DIST. NO.	STATE	FED. AID PROJ. NO.	FISCAL YEAR	SHEET NO.	TOTAL SHEETS
HAWAII	HAW.	I-HI-1(68):10 I-HI-1(39):10	1968	1	91

STATE OF HAWAII

DEPARTMENT OF TRANSPORTATION
HIGHWAYS DIVISION

HONOLULU, HAWAII

"AS BUILT" PLANS OF

INTERSTATE ROUTE H-1

WAIAWA STREAM TO WEST OF WAIAU INTERCHANGE
(WAIMANO STREAM TO WEST OF WAIAU INTERCHANGE)

FEDERAL AID INTERSTATE PROJECT NO. I-HI-1(68):10

AND

FEDERAL AID INTERSTATE PROJECT NO. I-HI-1(39):10

DISTRICT OF EWA
ISLAND OF OAHU

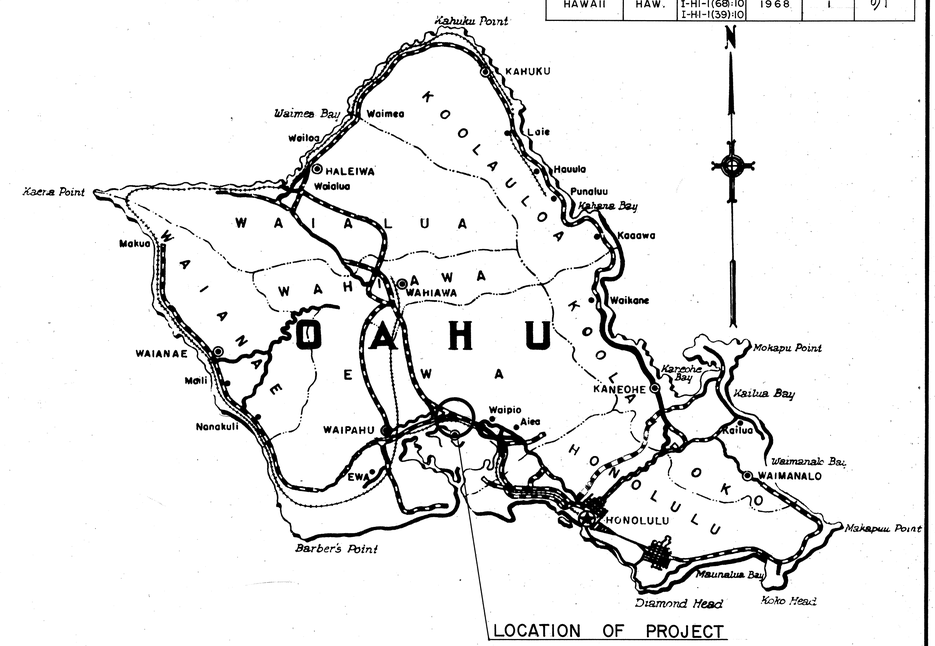

Federal Aid Projects Previously Constructed Or Under Construction

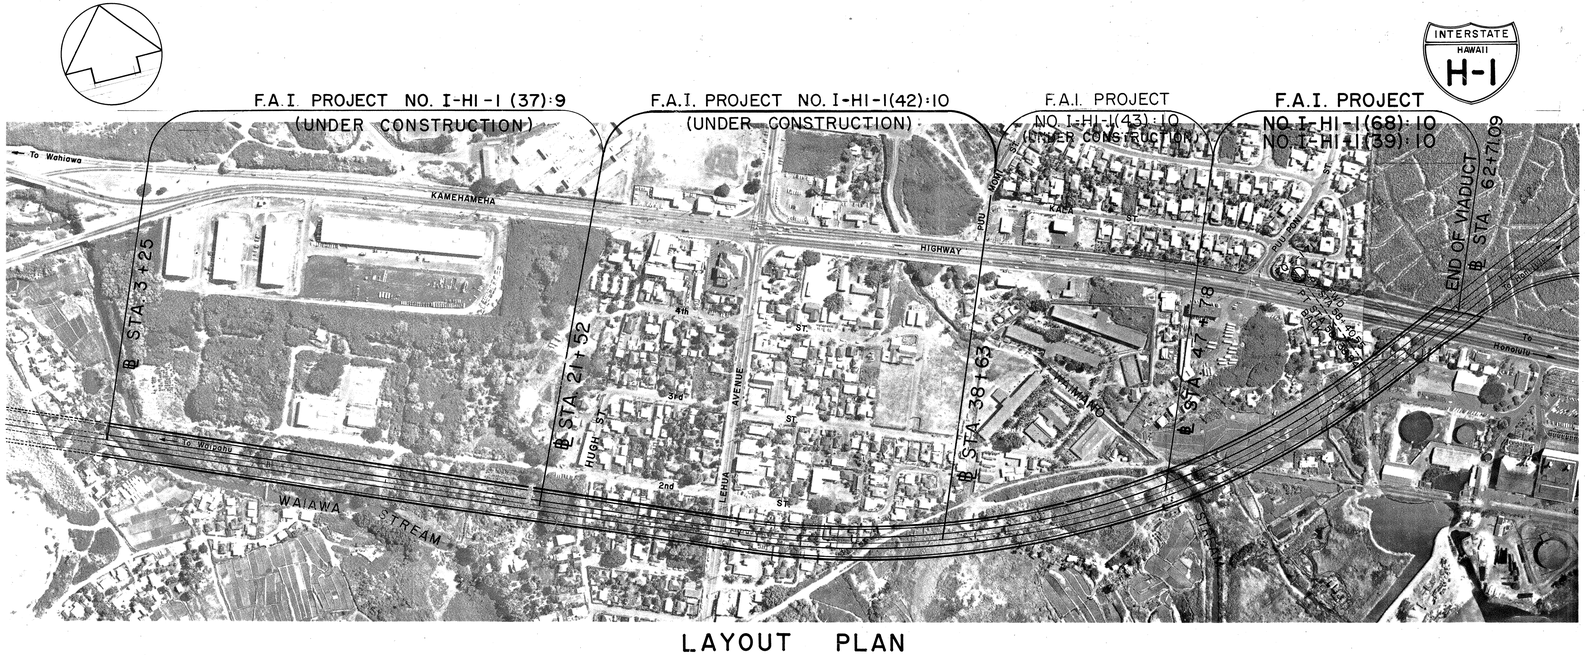

LAYOUT PLAN

300 0 300 600 900
SCALE IN FEET

LENGTH OF PROJECT .....= 0.283 MILE
STRUCTURE .....= 0.283 MILE

DESIGN CLASSIFICATION

ADT (1965) 0
ADT (1988) 80,900
D 65 35
DHV ..... 10.5 %
T ..... 4.0 %
T_{24} ..... 6.0 %
V ..... 60 MPH

NOTE:

ALL THE QUANTITIES SHOWN ARE ORIGINAL THEORETICAL QUANTITIES. FOR ACTUAL QUANTITIES, REFER TO PROJECT LEDGER AND OR COMPUTATION BOOK. ALL CHANGES MADE DURING CONSTRUCTION HAVE BEEN NOTED IN RED ON THESE TRACINGS AND CHECKED BY

PROJECT ENGINEER
8/15/73
DATE

APPROVED: DATE 11/28/63

FOR DIRECTOR OF TRANSPORTATION

DEPARTMENT OF TRANSPORTATION
BUREAU OF PUBLIC ROADS
APPROVED:
FOR DIVISION ENGINEER DATE

ORIGINAL PLAN	SURVEY PLOTTED BY R. Leads DATE MAR. 68
	DESIGNED BY
	DRAWN BY
NOTE BOOK	QUANTITIES BY
	QUANTITIES CHECKED BY
No.	CHECKED BY