FED. ROAD DIST. NO.	STATE	FED. AID PROJ. NO.	FISCAL YEAR	SHEET NO.	TOTAL SHEETS
HAWAII	HAW.	I-HI-1(31):21, UNIT 3	1968	40	47

Revised: 12-6-68
7-30-69

PLANT LIST THIS SHEET

BOTANICAL NAME	COMMON NAME	QUANTITY	SPECIFICATIONS
Cassia Fistula x Javanica	Rainbow Shower	3 ea.	4'-6' tall, 5 Gal. can, Plant as indicated, stake
Cybistax Donnell Smithii	Gold Tree	3 ea.	
Tabebuia Pentaphylla	Pink Tecoma	3 ea.	8' tall, 10 Gal. can
Hibiscus Cameroni	Pink Hibiscus	~~33~~ 115 ea.	2' tall, 1 Gal. can plant 4'-0" o.c.
Nerium Oleander	Oleander - White	110 ea.	
Wedelia Trilobata	Wedelia	~~14,340~~ 14,877 ☆	12"-18" runners
Cynodon Dactylon	Bermuda Grass	~~9,310~~ 10,440 ☆	See "Standard Specifications"

NOTE:
Top soil shall be placed at a depth of 6" for all grassed areas.

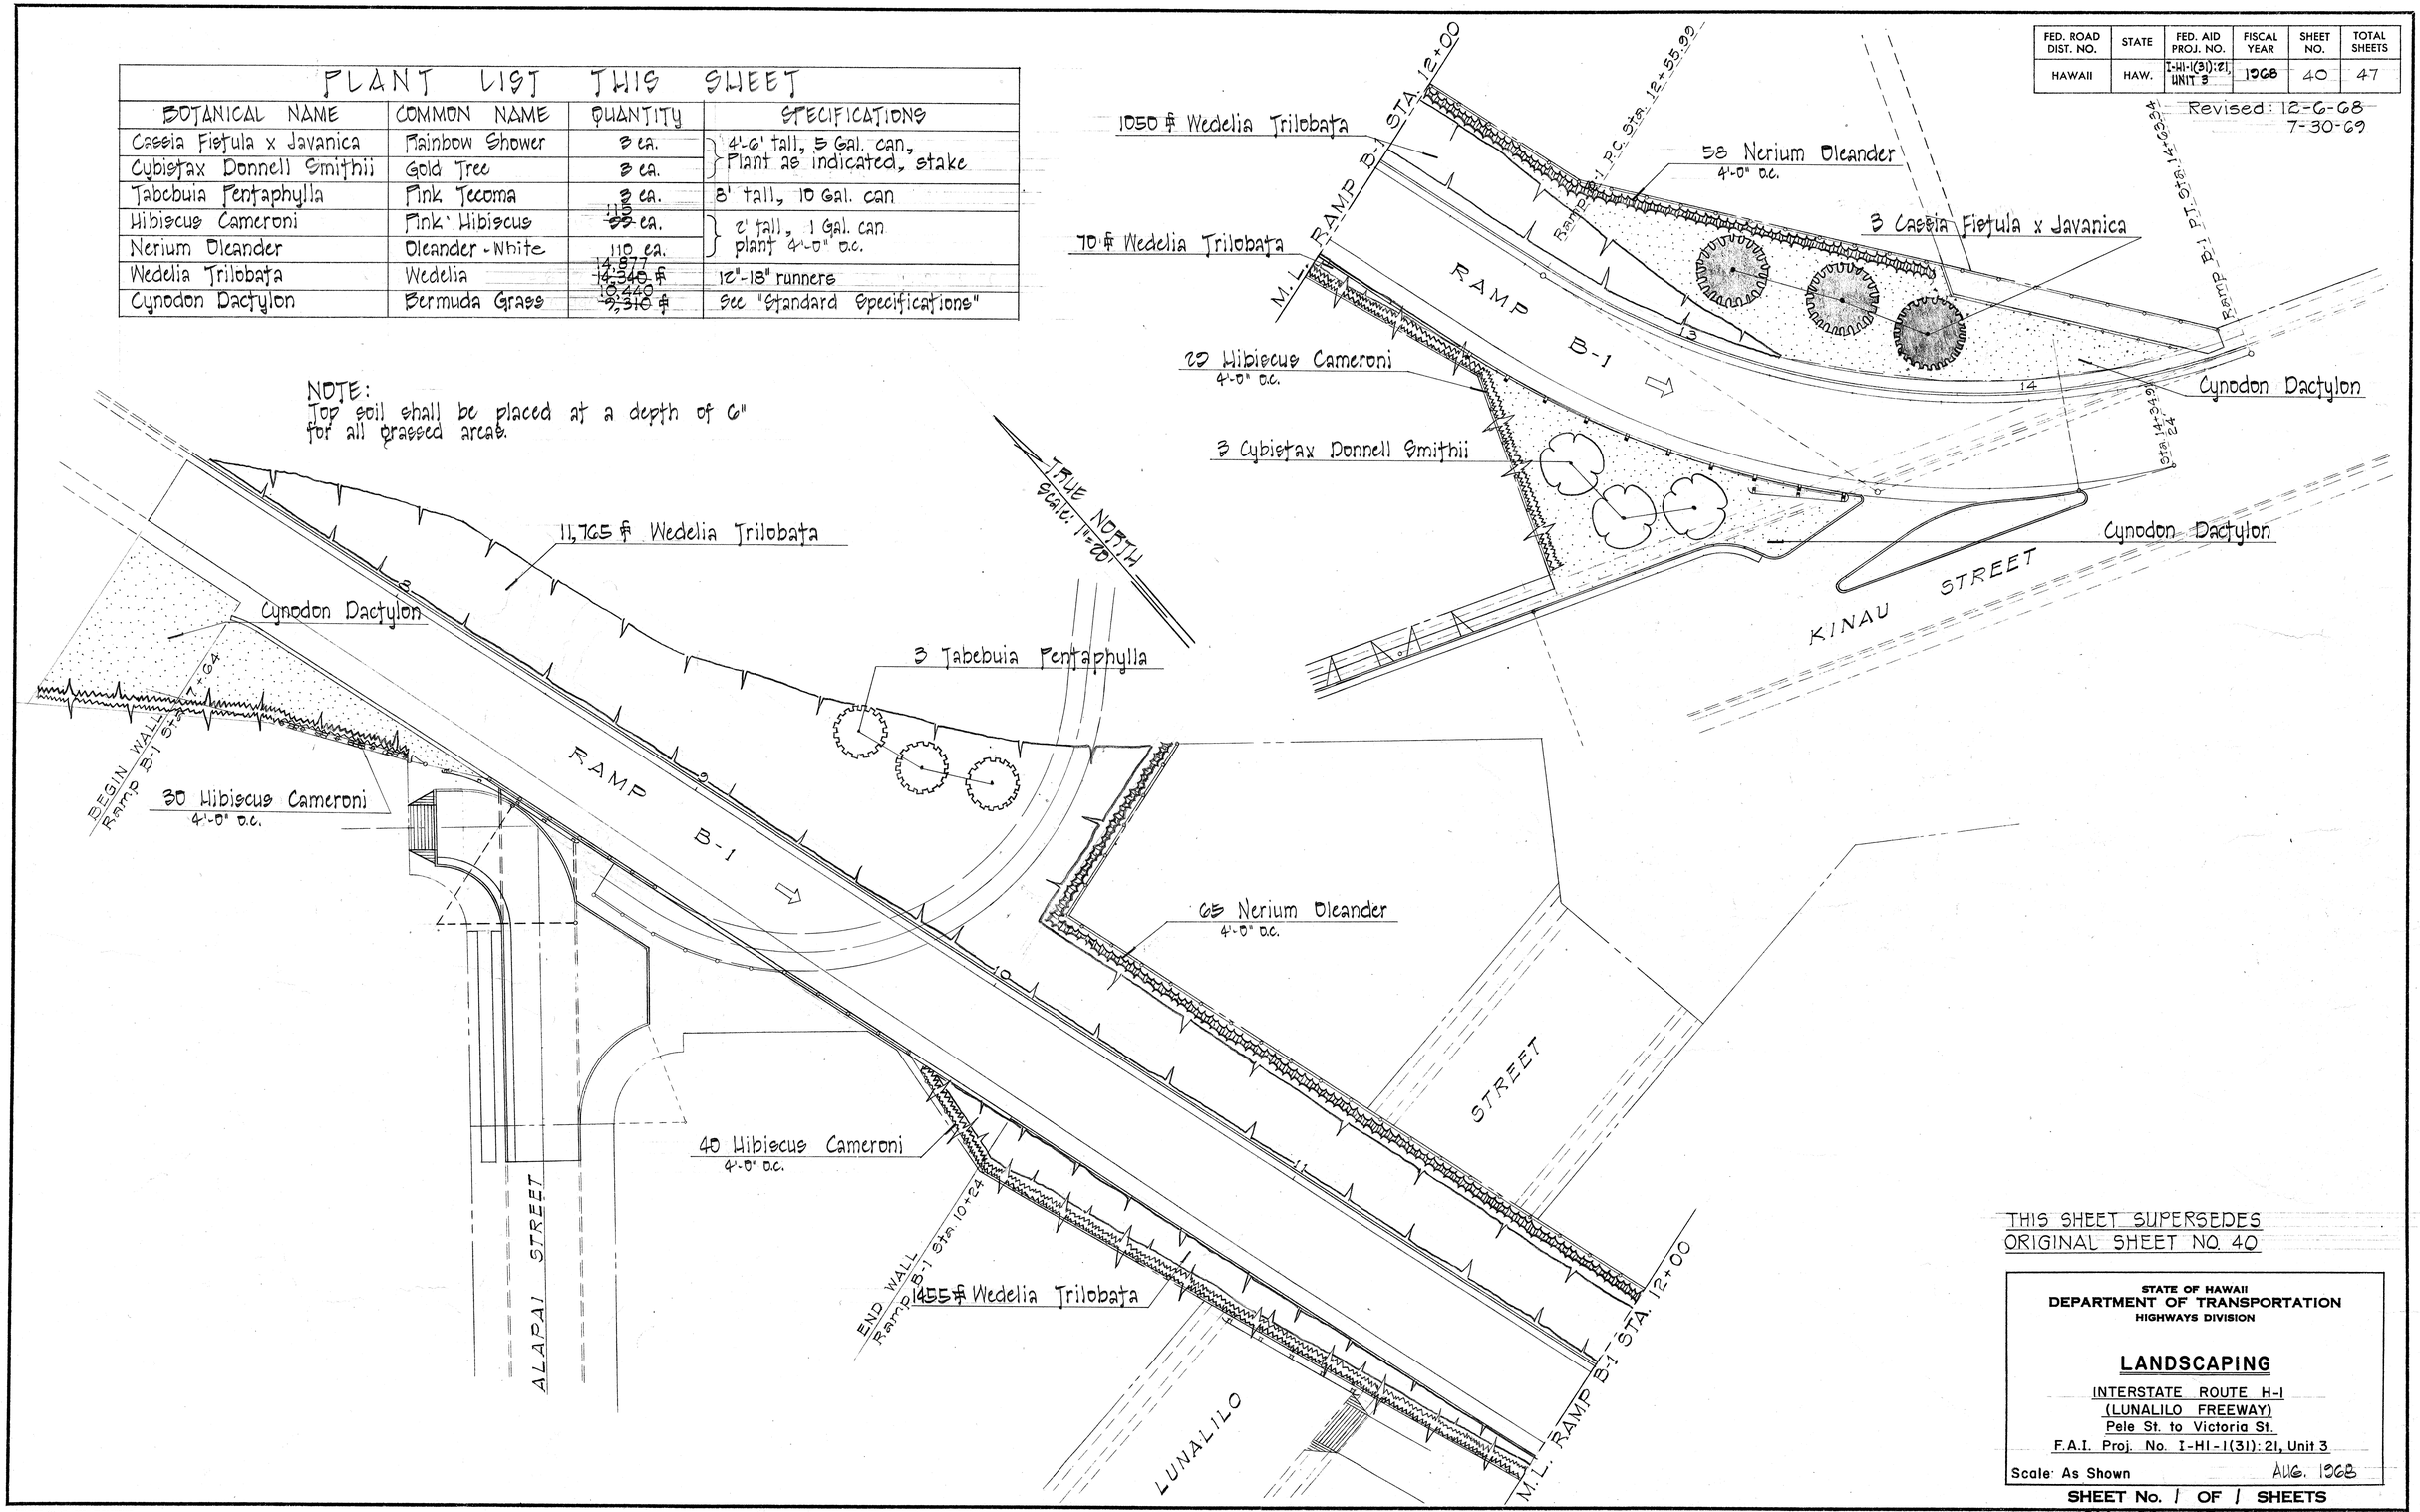

THIS SHEET SUPERSEDES
ORIGINAL SHEET NO. 40

STATE OF HAWAII
DEPARTMENT OF TRANSPORTATION
HIGHWAYS DIVISION

LANDSCAPING

INTERSTATE ROUTE H-1
(LUNALILO FREEWAY)
Pele St. to Victoria St.
F.A.I. Proj. No. I-HI-1(31): 21, Unit 3

Scale: As Shown — AUG. 1968

SHEET No. 1 OF 1 SHEETS

C.O. 40

ORIGINAL PLAN		DATE
	SURVEY PLOTTED BY	
	DRAWN BY	
	TRACED BY	
NOTE BOOK	DESIGNED BY	
	QUANTITIES BY	
No.	CHECKED BY	

PRINTED ON NO. 1000H CLEARPRINT