FED. ROAD DIST. NO.	STATE	FED. AID PROJ. NO.	FISCAL YEAR	SHEET NO.	TOTAL SHEETS
HAWAII	HAW.	I-HI-1(31):21 Unit 3	1969	C0485-1	47

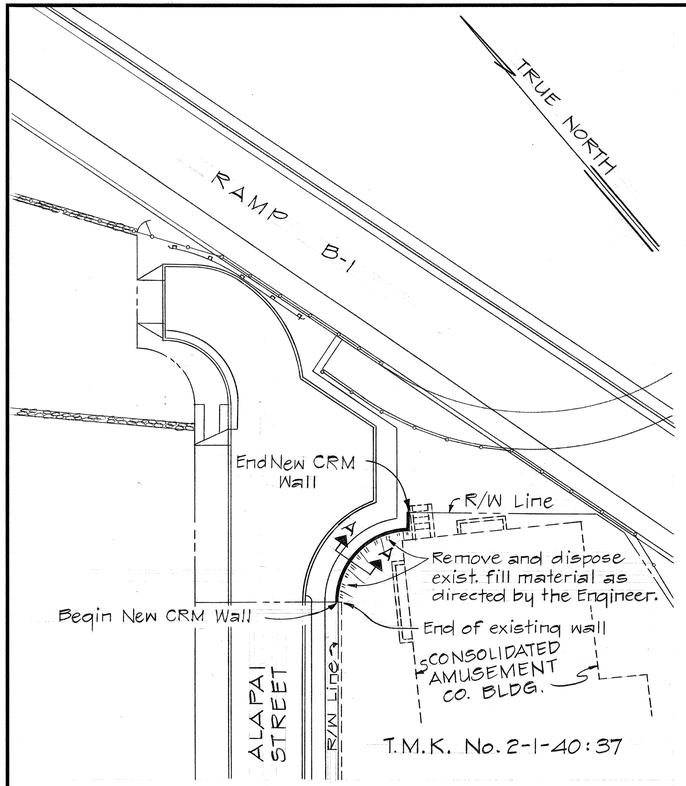

PLAN

Scale: 1" = 20'

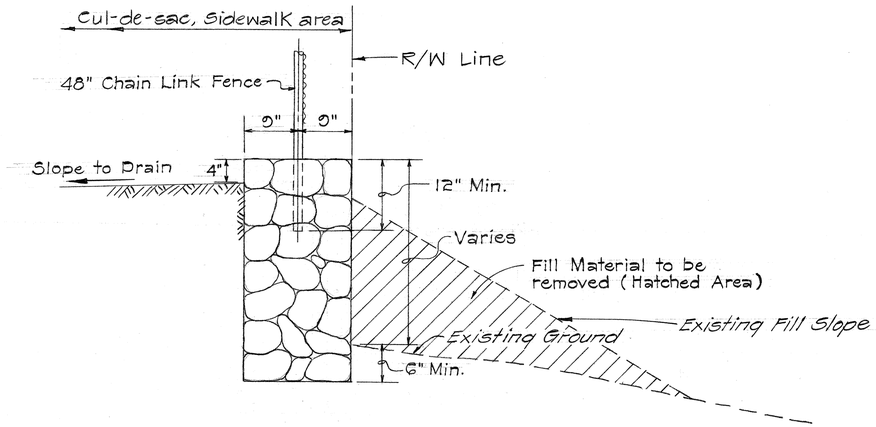

TYPICAL SECTION OF CRM RETAINING WALL

Scale: 1" = 1'-0"

THIS SHEET IS A SUPPLEMENT TO THE CONTRACT PLANS

STATE OF HAWAII
DEPARTMENT OF TRANSPORTATION
HIGHWAYS DIVISION

RETAINING WALL AT ALAPAI CUL-DE-SAC

INTERSTATE ROUTE H-1
PELE ST. TO VICTORIA ST.

F.A.I. Proj. No. I-HI-1(31):21, Unit 3

Scale: As Shown Date: Dec. 26, 1969

SHEET No. 1 OF 1 SHEETS

ORIGINAL PLAN		DATE
	SURVEY PLOTTED BY	
	DRAWN BY	"
NOTE BOOK	TRACED BY	"
	DESIGNED BY	"
	QUANTITIES BY	"
No.	CHECKED BY	"

K+E CRYSTALENS® LA 2920 TRACING PAPER

C0 485 S1