FED ROAD DIST. NO	STATE	FED. AID PROJ. NO.	FISCAL YEAR	SHEET NO.	TOTAL SHEETS
HAWAII	HAW.	I-HI-1(53):23	1969	1	30

INDEX TO DRAWINGS

SHEET NO.	DESCRIPTION
1	TITLE SHEET
2-8	PLAN
9-13	TYPICAL SECTION & CONC. BARRIER DETAILS
14-19	MISCELLANEOUS AND STANDARD DETAILS
20-23	HWY. LIGHTING SYSTEM
24-25	HIGHWATER WARNING ALARM SYSTEM
26-31	DRAINAGE DETAILS
32-39	UTILITY PLANS AND DETAILS

STATE OF HAWAII

DEPARTMENT OF TRANSPORTATION
HIGHWAYS DIVISION

HONOLULU, HAWAII

"AS BUILT"

PLANS FOR

MEDIAN IMPROVEMENT OF INTERSTATE ROUTE H-1

KEEAUMOKU STREET TO OLD WAIALAE ROAD
(Makiki Street to Kalo Lane Separation)

FEDERAL AID INTERSTATE PROJ. No. I-HI-1(53):23

DISTRICT OF HONOLULU
ISLAND OF OAHU

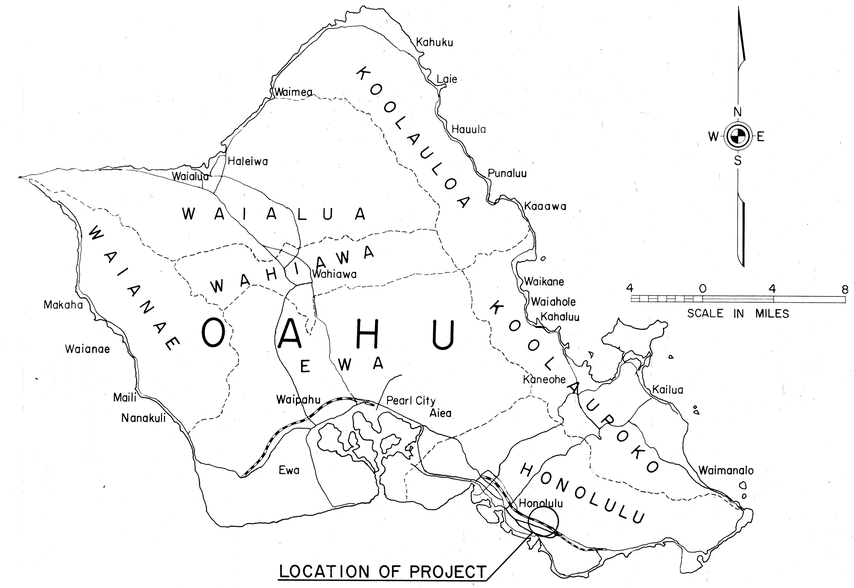

Federal Aid Interstate Projects Previously Constructed or Under Construction.

NOTE: ALL CHANGES MADE DURING CONSTRUCTION HAVE BEEN NOTED IN RED ON THESE TRACINGS AND CHECKED BY.

Ralph T. Horie
RESIDENT ENGINEER

8-19-70
DATE

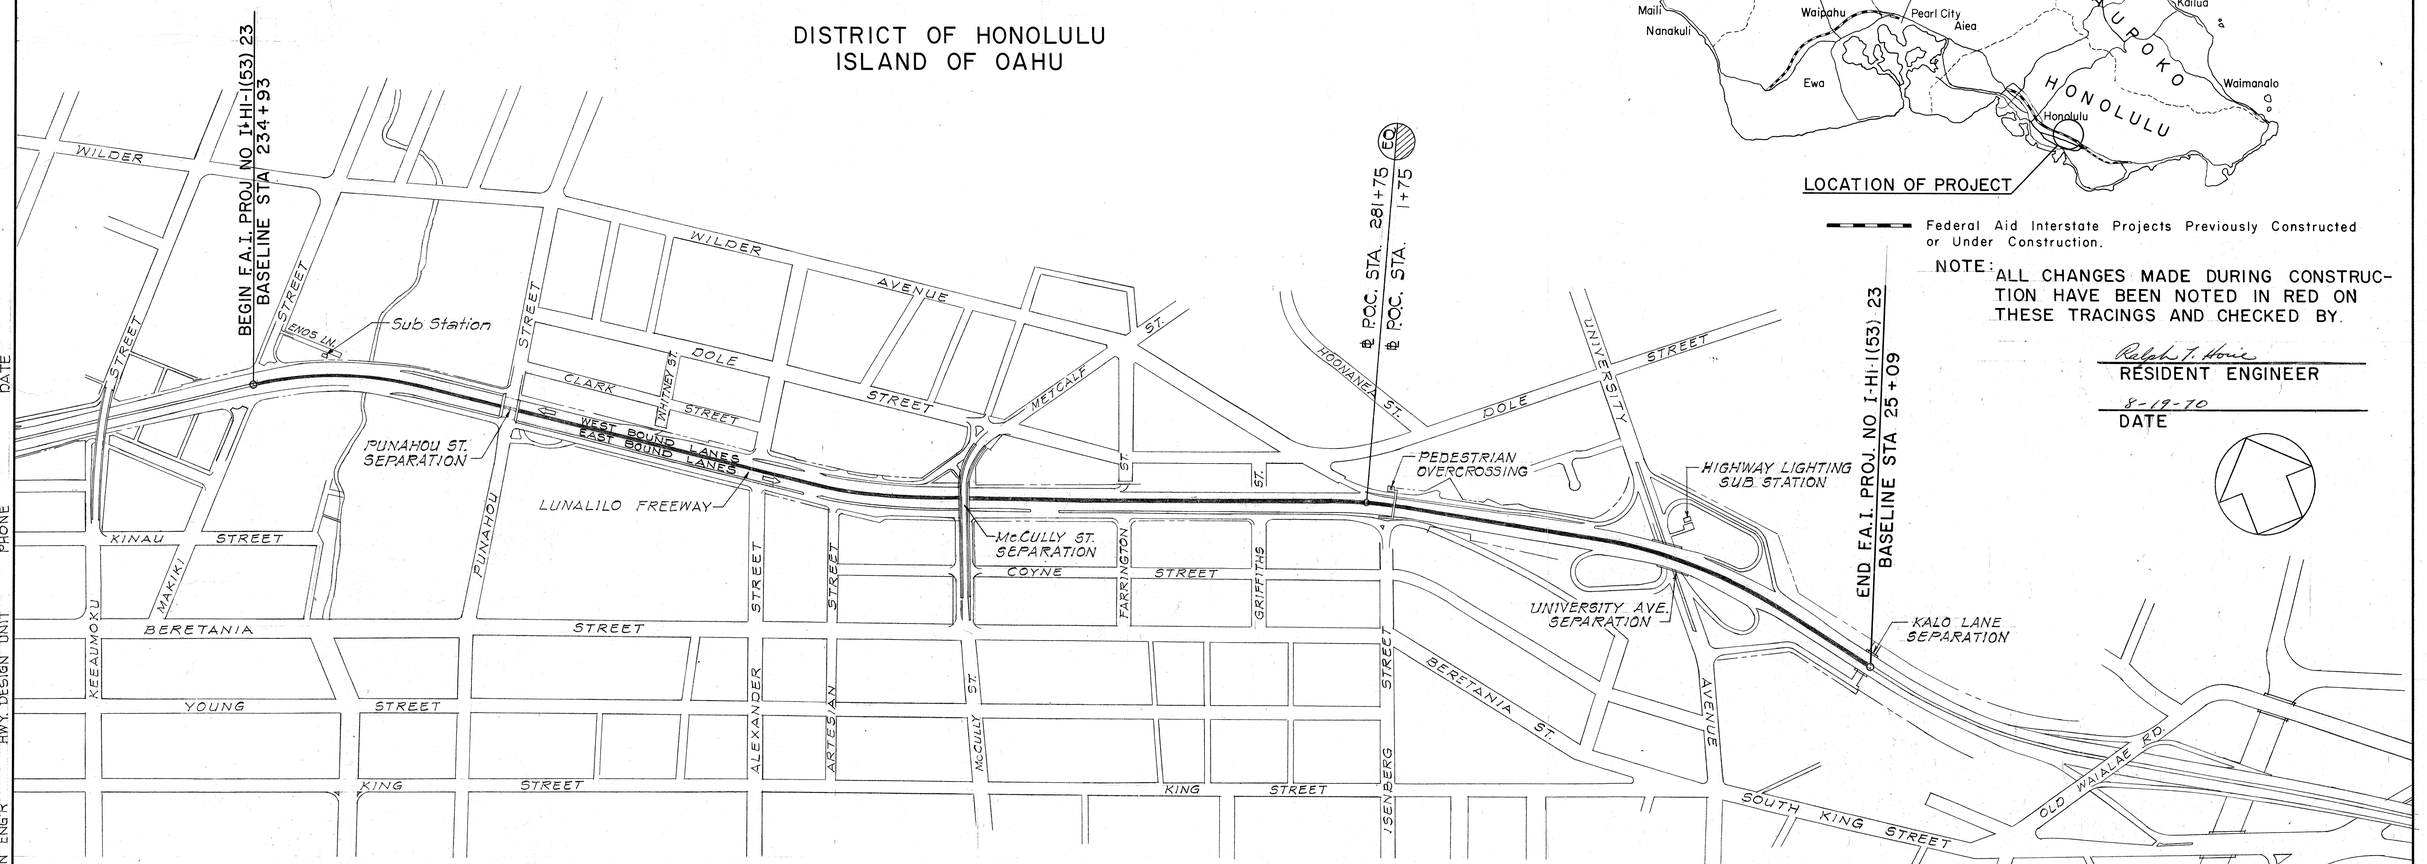

Design Classification	
ADT (1968)	60,000
V	50 M.P.H.

LAYOUT PLAN

3 0 3 6
SCALE IN HUNDRED FEET

Length of Project ..... 1.329 Miles

DEPARTMENT OF TRANSPORTATION
BUREAU OF PUBLIC ROADS
APPROVED:
for DIVISION ENGINEER — 5-21-69 DATE

DEPARTMENT OF TRANSPORTATION
STATE OF HAWAII
APPROVED:
for DIR. OF TRANSPORTATION — 4/22/69 DATE

April 1969 DATE
548-2211 Local 301 PHONE
"B" HWY. DESIGN UNIT
S.F. Yuen DESIGN ENG'R