FED. ROAD DIST. NO.	STATE	FED. AID PROJ. NO.	FISCAL YEAR	SHEET NO.	TOTAL SHEETS
HAWAII	HAW.	F-HI-1(69):10 F-HI-1(40):11	1969	158	185

FINAL SURVEY — SURVEYED, PLOTTED, TEMPLATE, AREAS, NOTE BOOK, NO., AREAS CHECKED, BY, DATE

ORIGINAL SURVEY — SURVEYED, PLOTTED, TEMPLATE, AREAS, NOTE BOOK, NO., AREAS CHECKED, BY, DATE

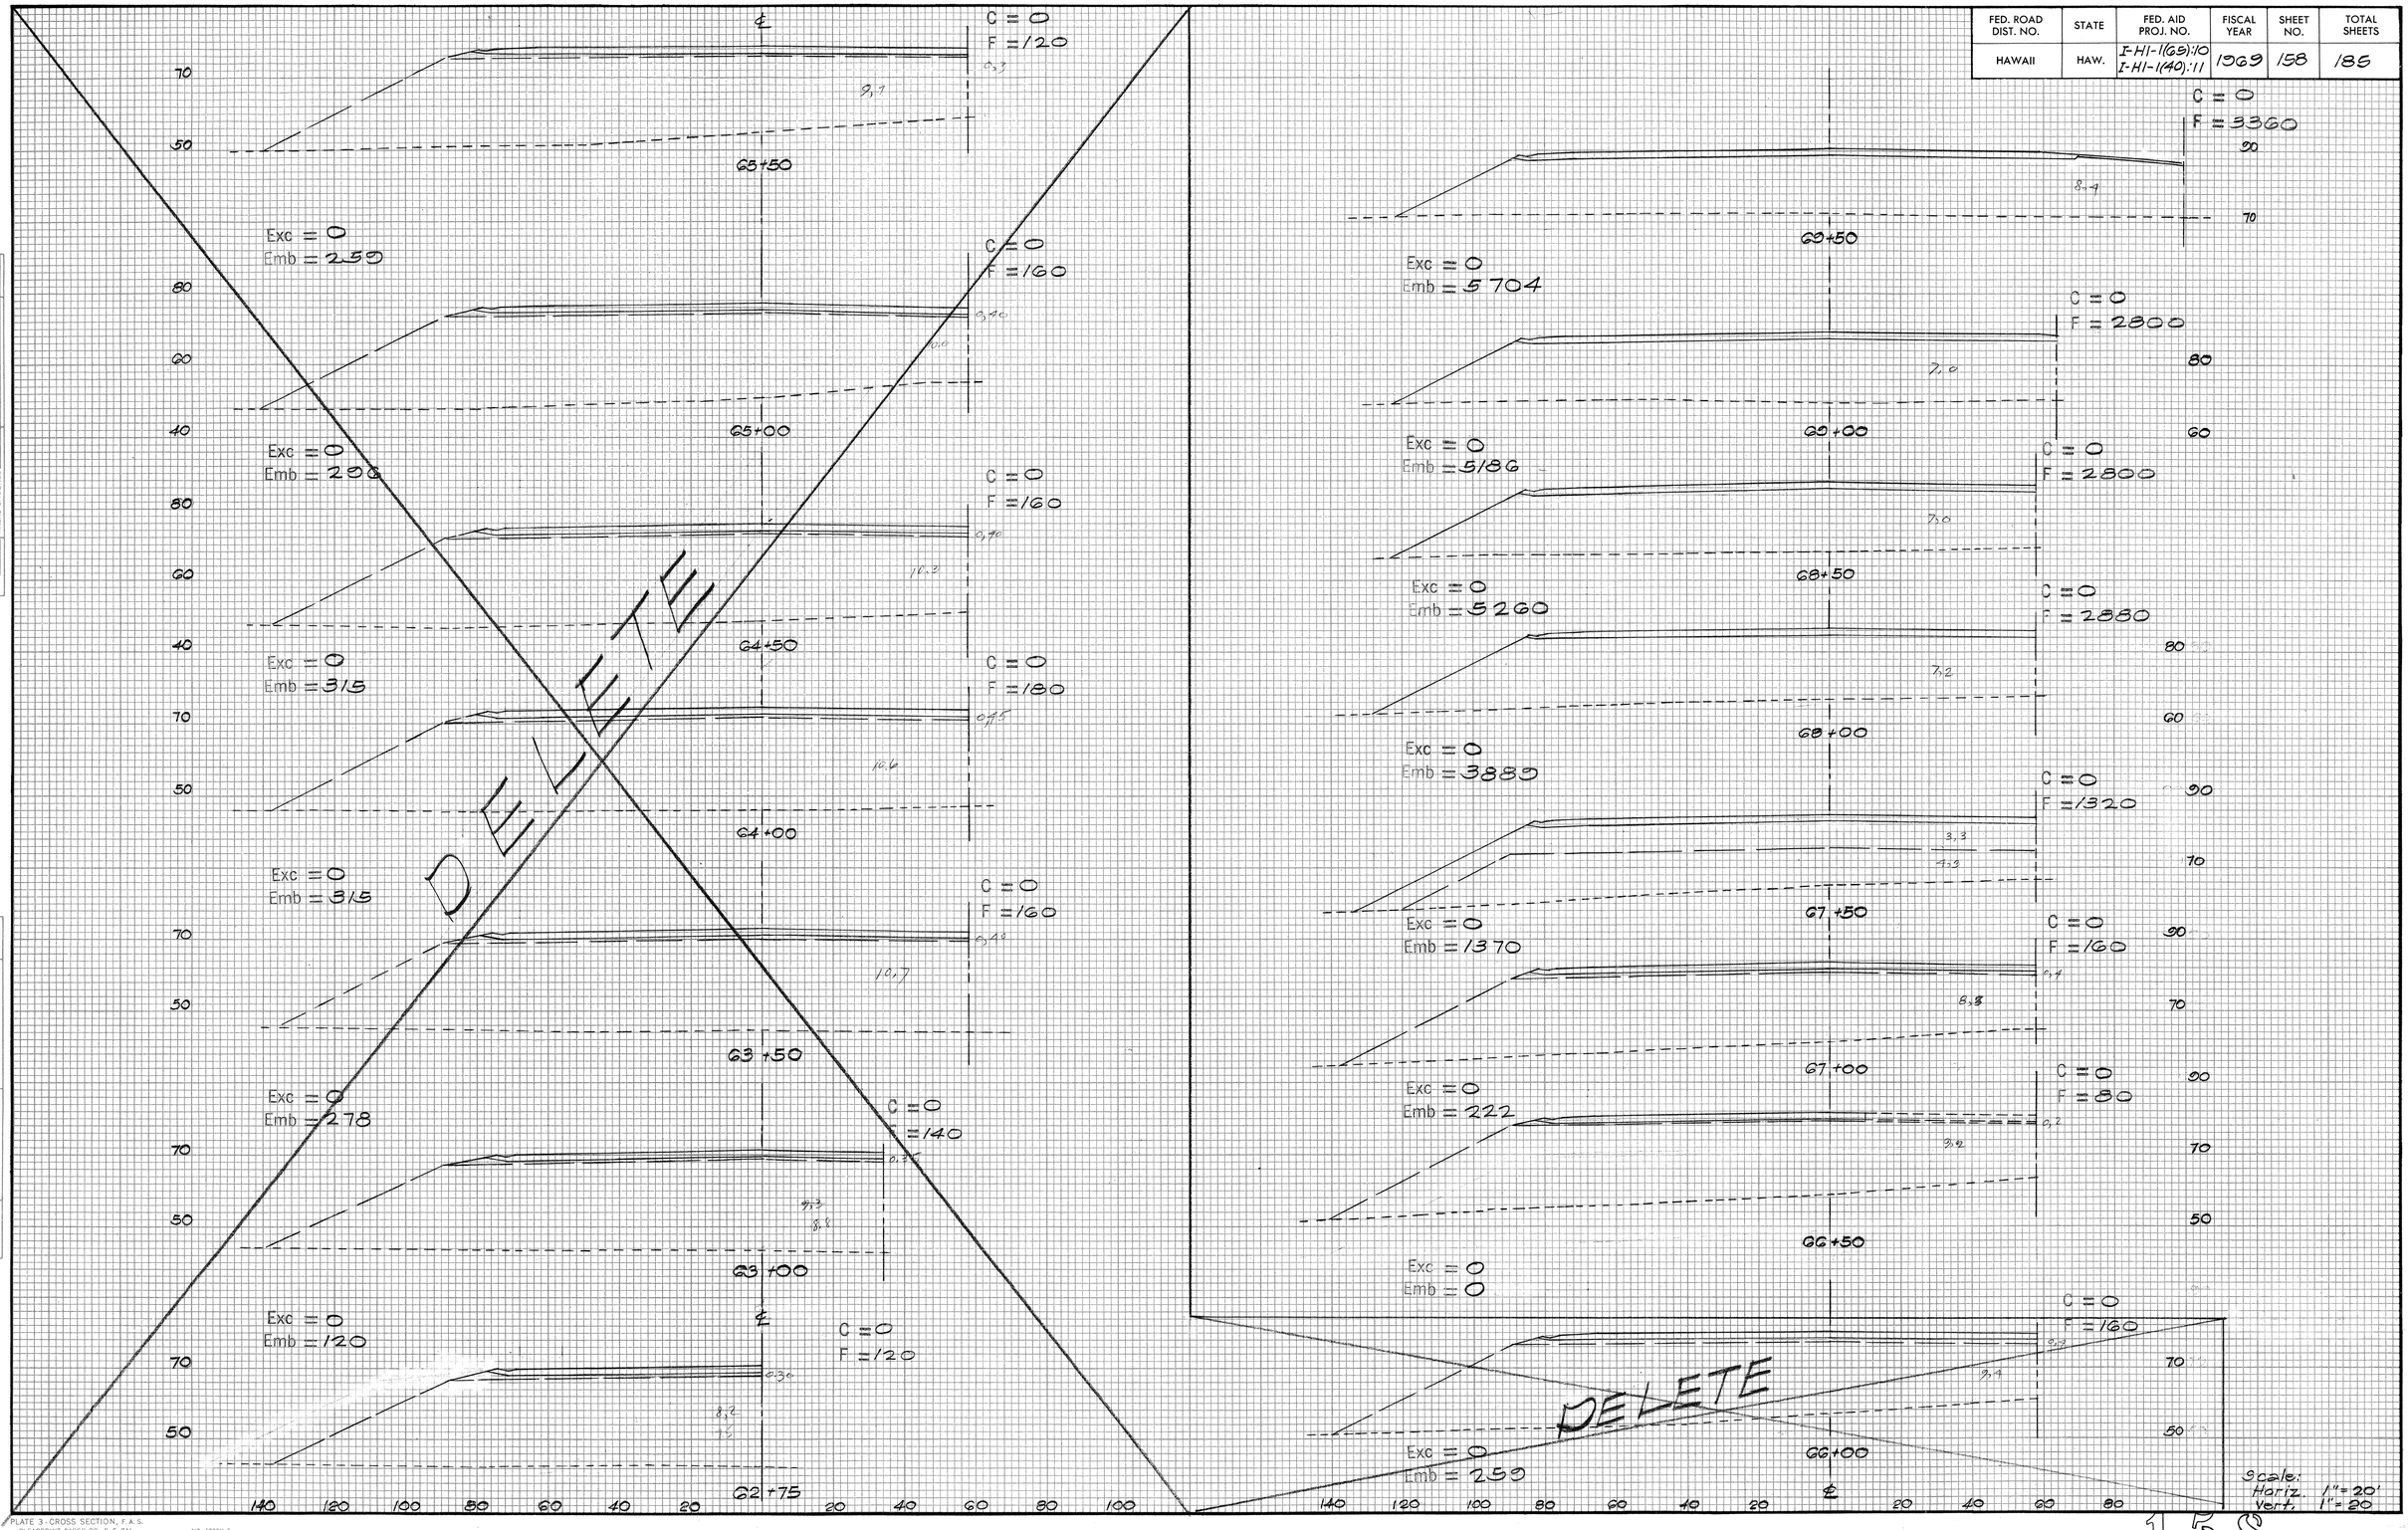

Scale: Horiz. 1" = 20'
Vert. 1" = 20

PLATE 3 - CROSS SECTION, F. A. S.
CLEARPRINT PAPER CO., S. F. CAL. NO. 1000H-3

158

FED. ROAD DIST. NO.	STATE	FED. AID PROJ. NO.	FISCAL YEAR	SHEET NO.	TOTAL SHEETS
HAWAII	HAW.	I-HI-1(65):10 I-HI-1(40):11	1969	159	185

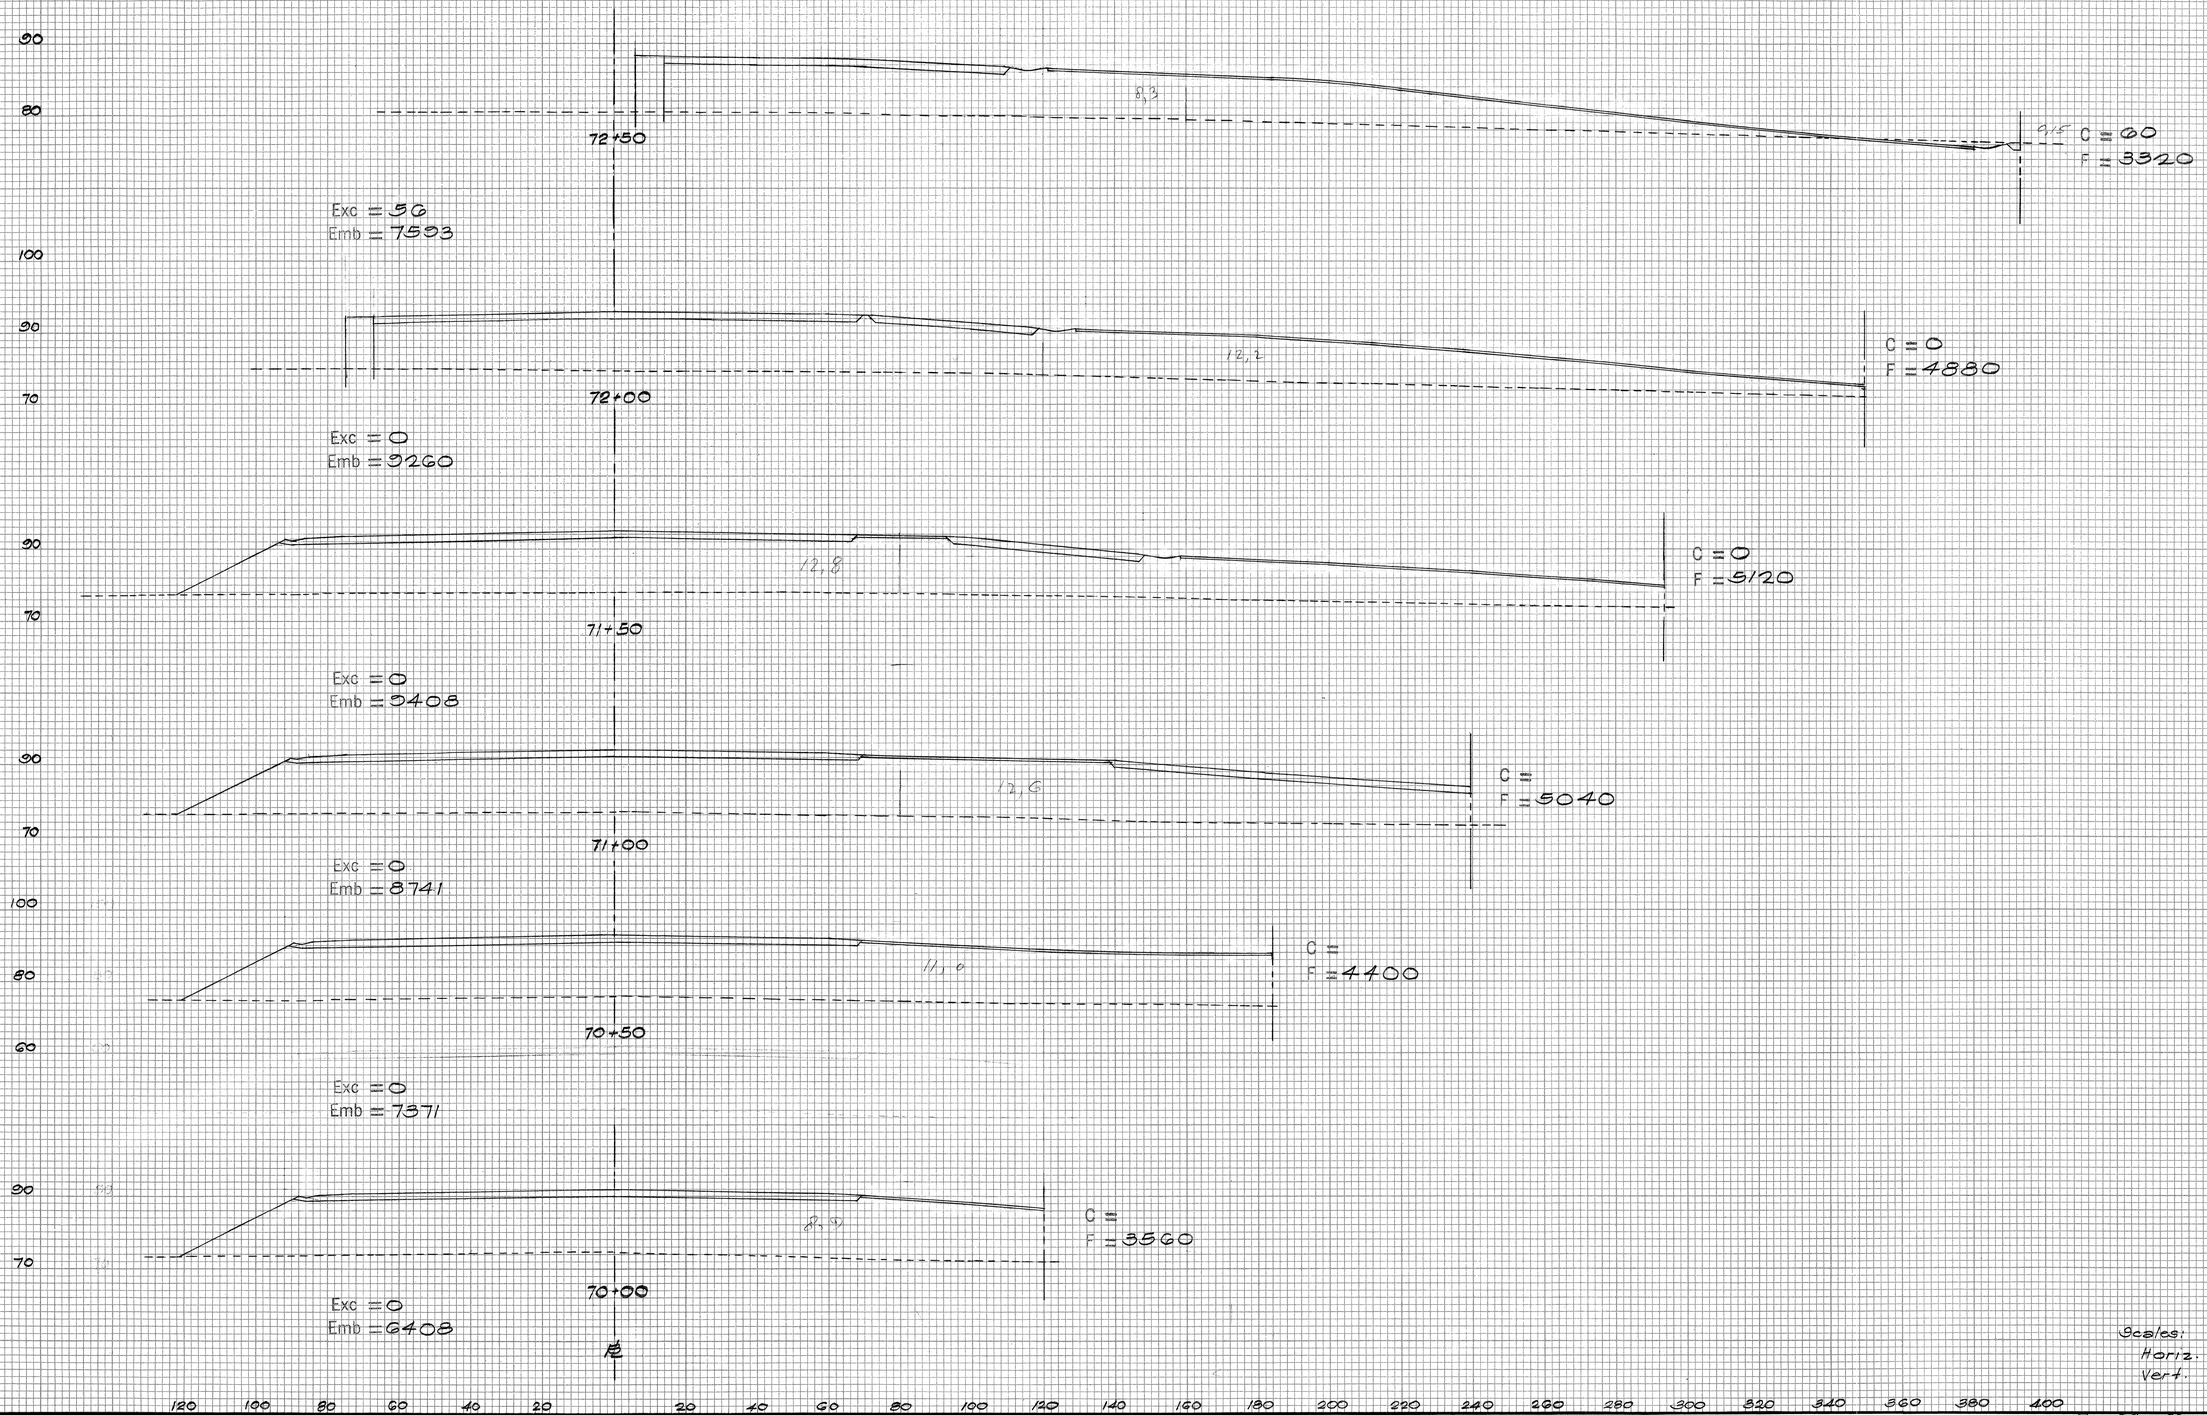

Scales:
Horiz. 1" = 20'
Vert. 1" = 20'

159

FINAL SURVEY — SURVEYED, PLOTTED, TEMPLATE, AREAS, AREAS CHECKED — NOTE BOOK NO. — BY — DATE

ORIGINAL SURVEY — SURVEYED, PLOTTED, TEMPLATE, AREAS, AREAS CHECKED — NOTE BOOK NO. — BY — DATE

PLATE 3 - CROSS SECTION, F. A. S.
CLEARPRINT PAPER CO., S. F. CAL. NO. 1000H-3

FED. ROAD DIST. NO.	STATE	FED. AID PROJ. NO.	FISCAL YEAR	SHEET NO.	TOTAL SHEETS
HAWAII	HAW.	I-HI-1(69):10 I-HI-1(40):11	1969	160	185

FINAL SURVEY — SURVEYED, PLOTTED, TEMPLATE, AREAS, AREAS CHECKED, NOTE BOOK, NO., BY, DATE

ORIGINAL SURVEY — SURVEYED, PLOTTED, TEMPLATE, AREAS, AREAS CHECKED, NOTE BOOK, NO., BY, DATE

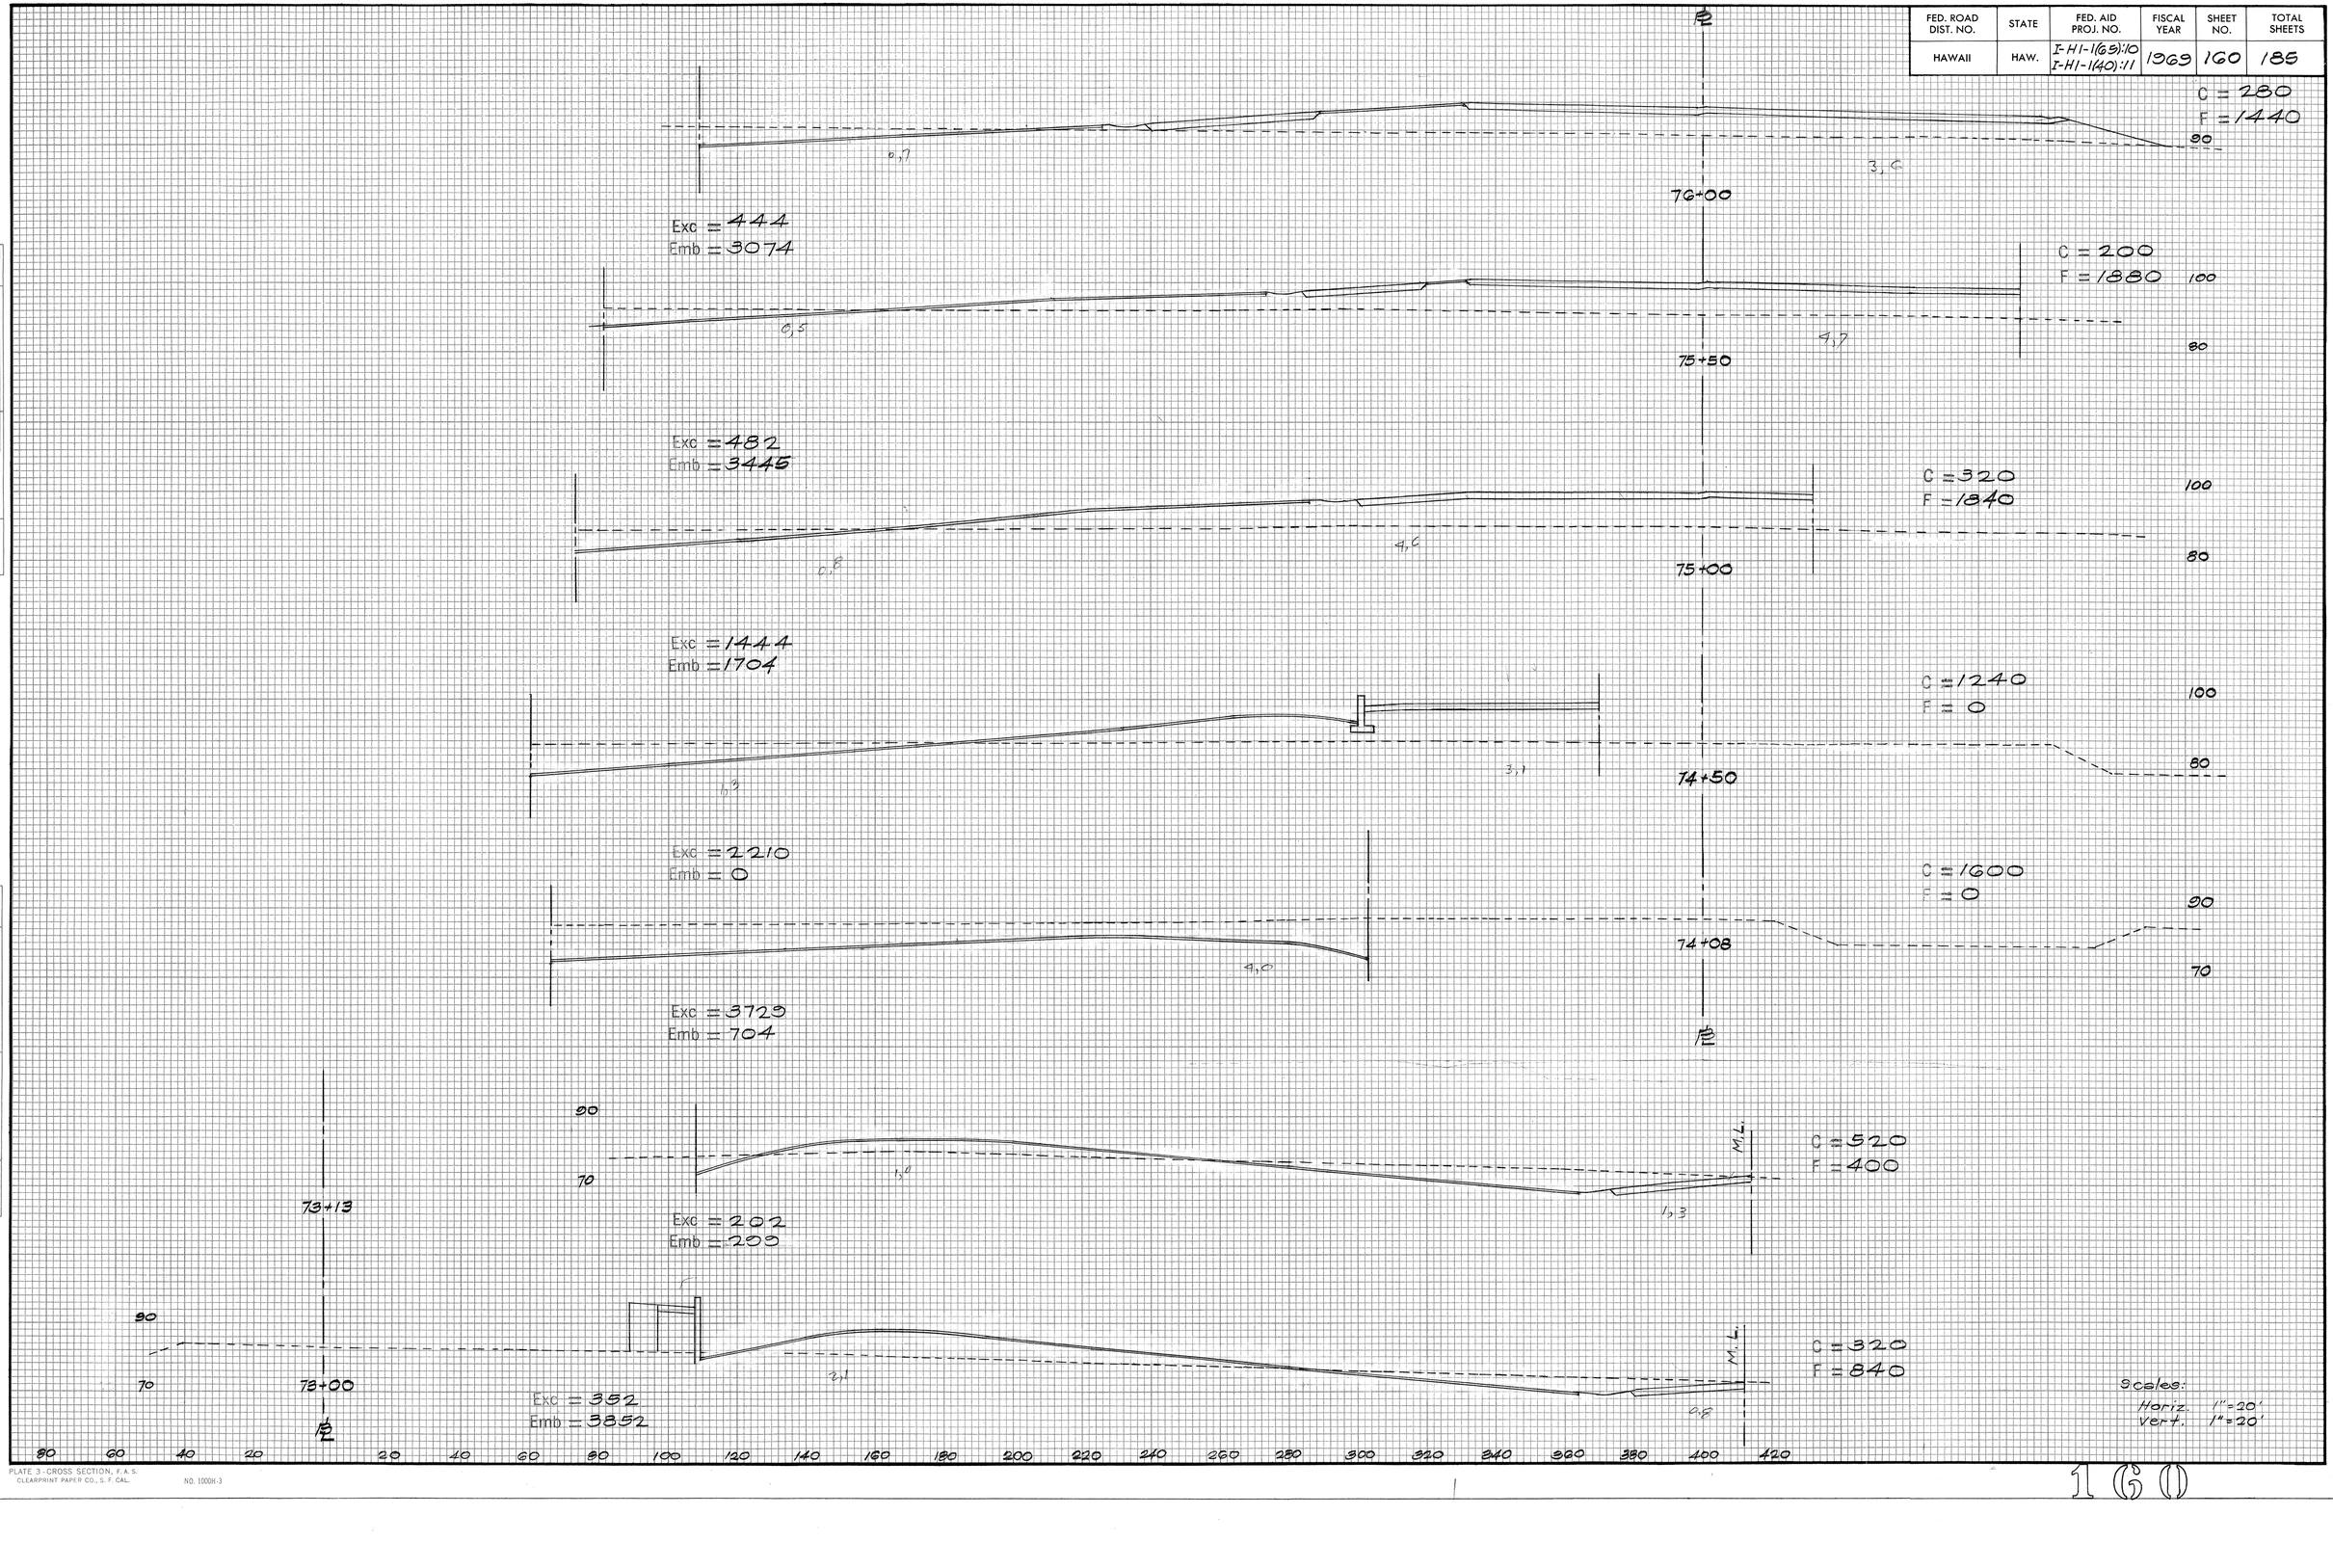

Scales:
Horiz. 1" = 20'
Vert. 1" = 20'

PLATE 3 - CROSS SECTION, F.A.S.
CLEARPRINT PAPER CO., S. F. CAL. NO. 1000H-3

160

FED. ROAD DIST. NO.	STATE	FED. AID PROJ. NO.	FISCAL YEAR	SHEET NO.	TOTAL SHEETS
HAWAII	HAW.	I-HI-1(69):10 I-HI-1(40):11	1969	161	185

FINAL SURVEY — SURVEYED, COMPUTED, TEMPLATE, AREAS, AREAS CHECKED, NOTE BOOK, NO., BY, DATE

ORIGINAL SURVEY — SURVEYED, COMPUTED, TEMPLATE, AREAS, AREAS CHECKED, NOTE BOOK, NO., BY, DATE

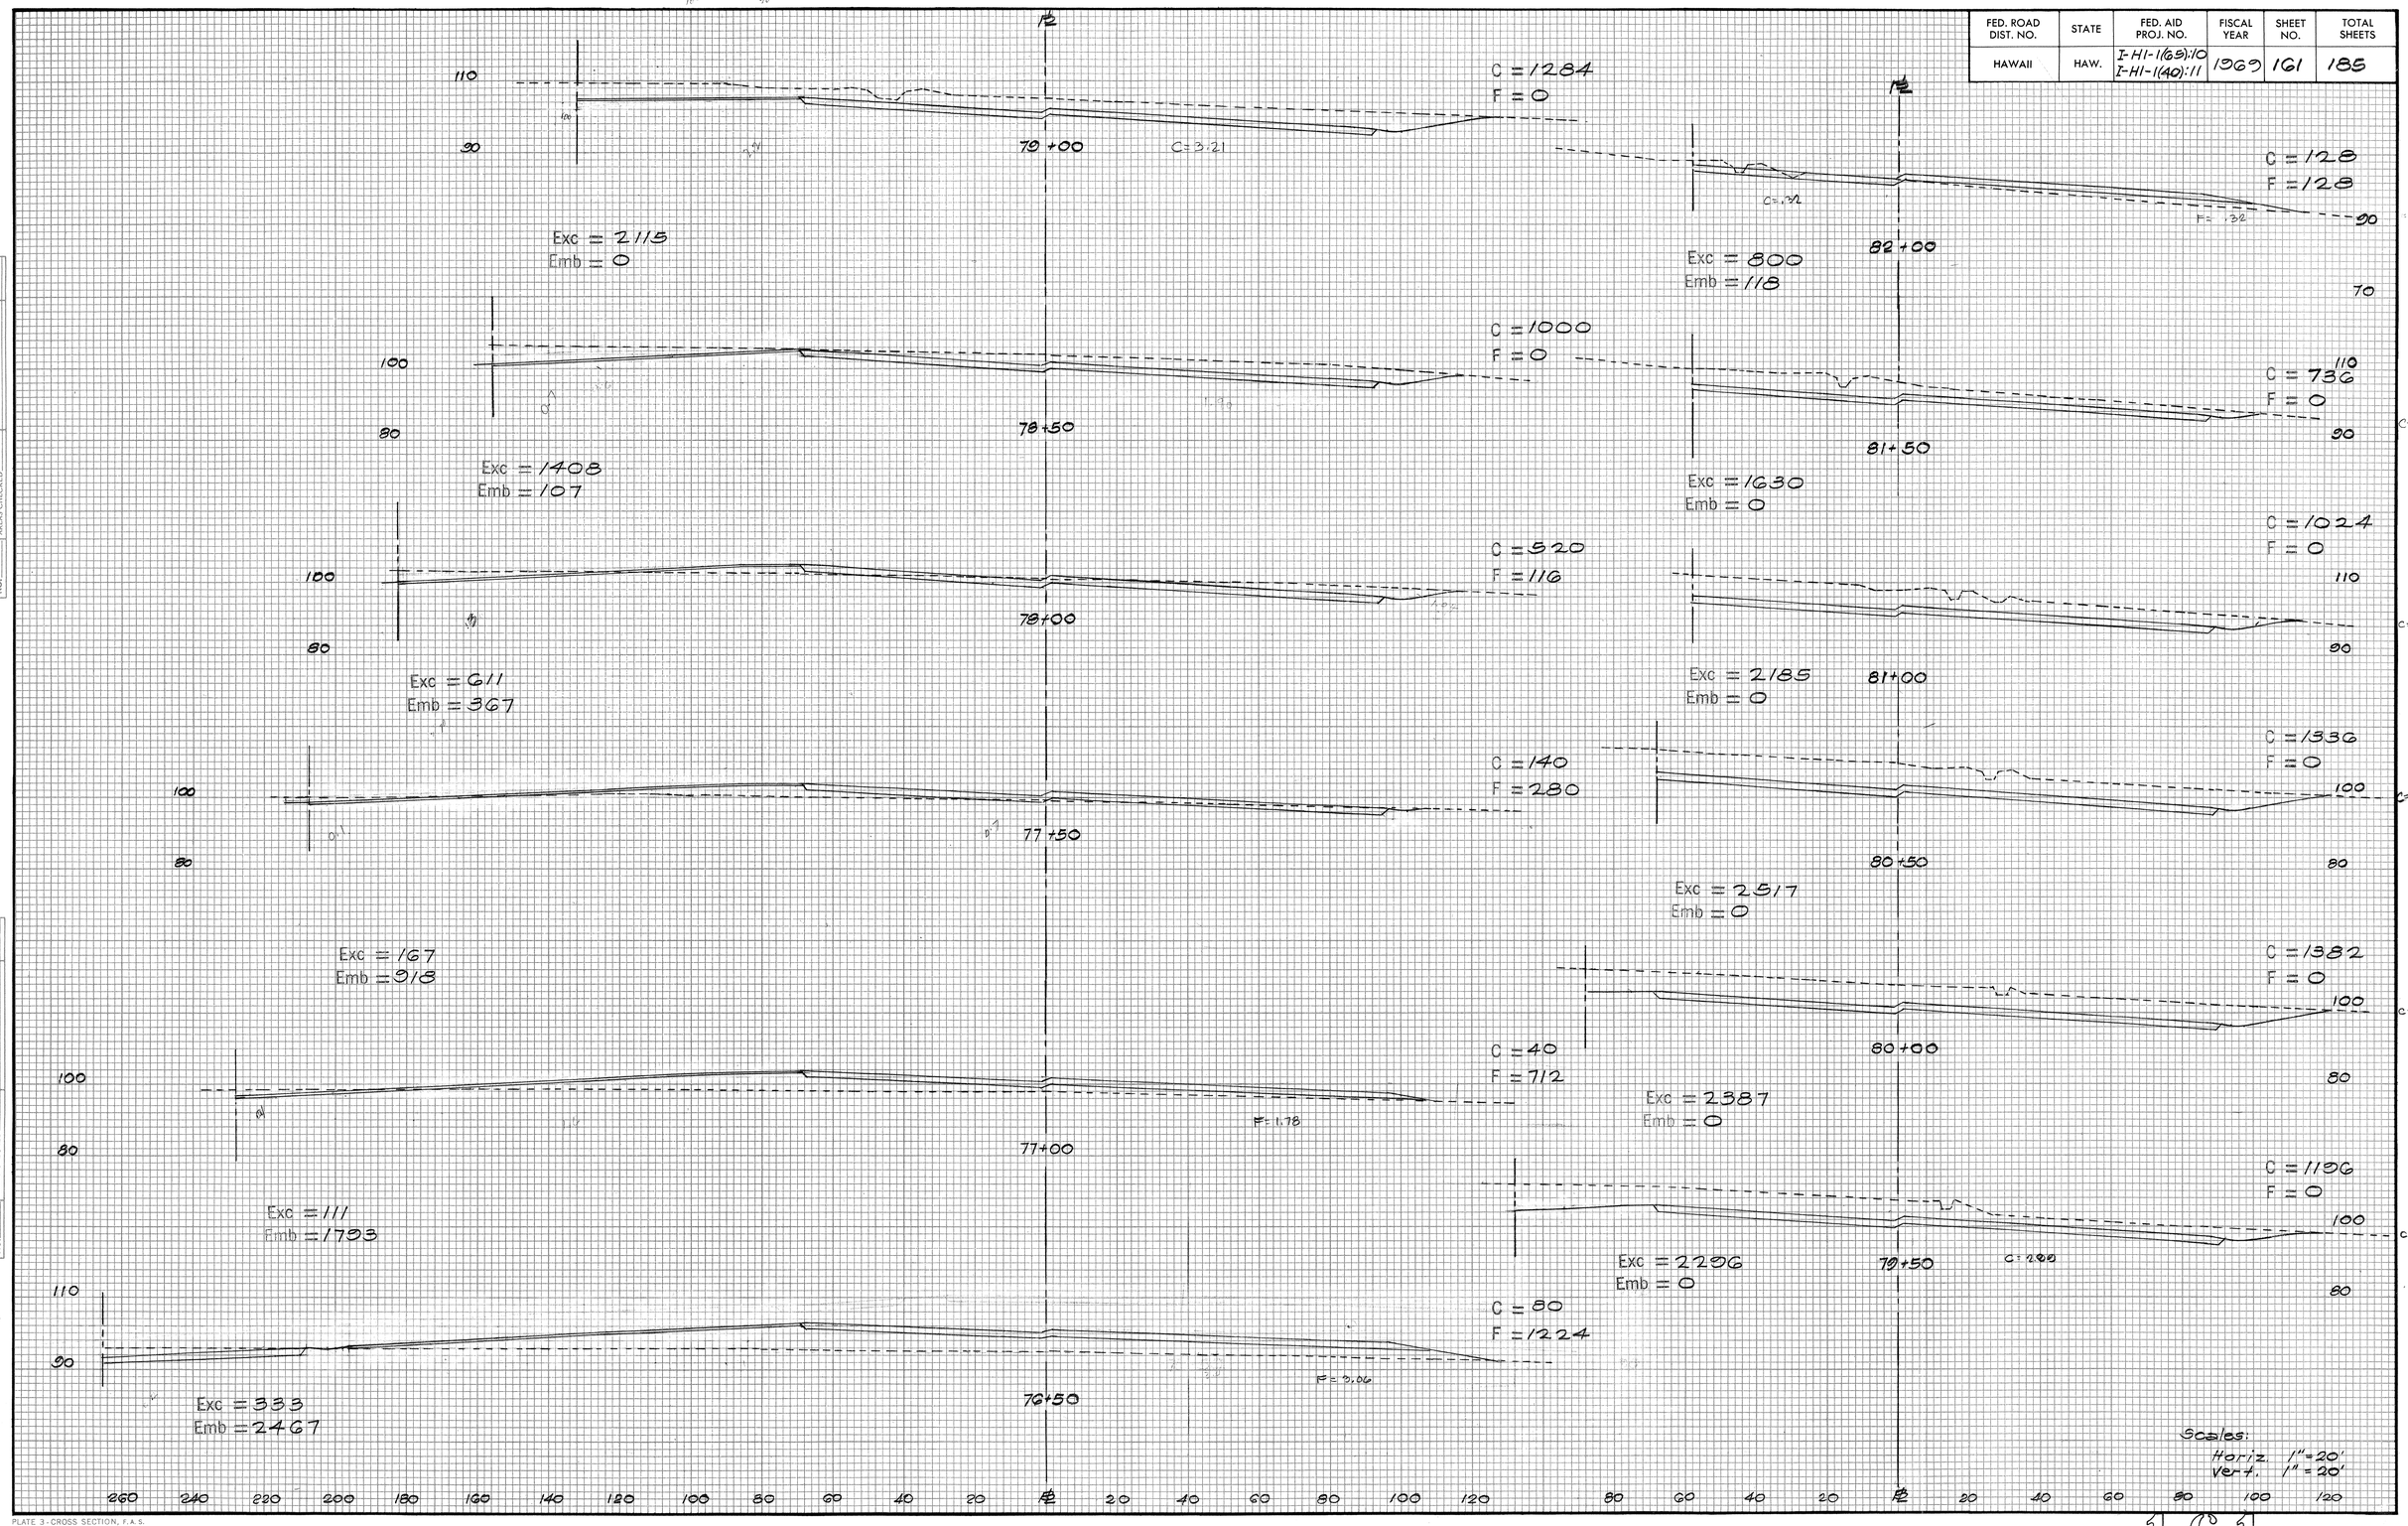

PLATE 3 - CROSS SECTION, F. A. S.
CLEARPRINT PAPER CO., S. F. CAL. NO. 1000H-3

161

FED. ROAD DIST. NO.	STATE	FED. AID PROJ. NO.	FISCAL YEAR	SHEET NO.	TOTAL SHEETS
HAWAII	HAW.	I-HI-1(65):10 I-HI-1(40):11	1969	162	185

FINAL SURVEY — SURVEYED, PLOTTED, FINAL PLATE, AREAS, AREAS CHECKED, NOTE BOOK, NO., BY, DATE

ORIGINAL SURVEY — SURVEYED, PLOTTED, FINAL PLATE, AREAS, AREAS CHECKED, NOTE BOOK, NO., BY, DATE

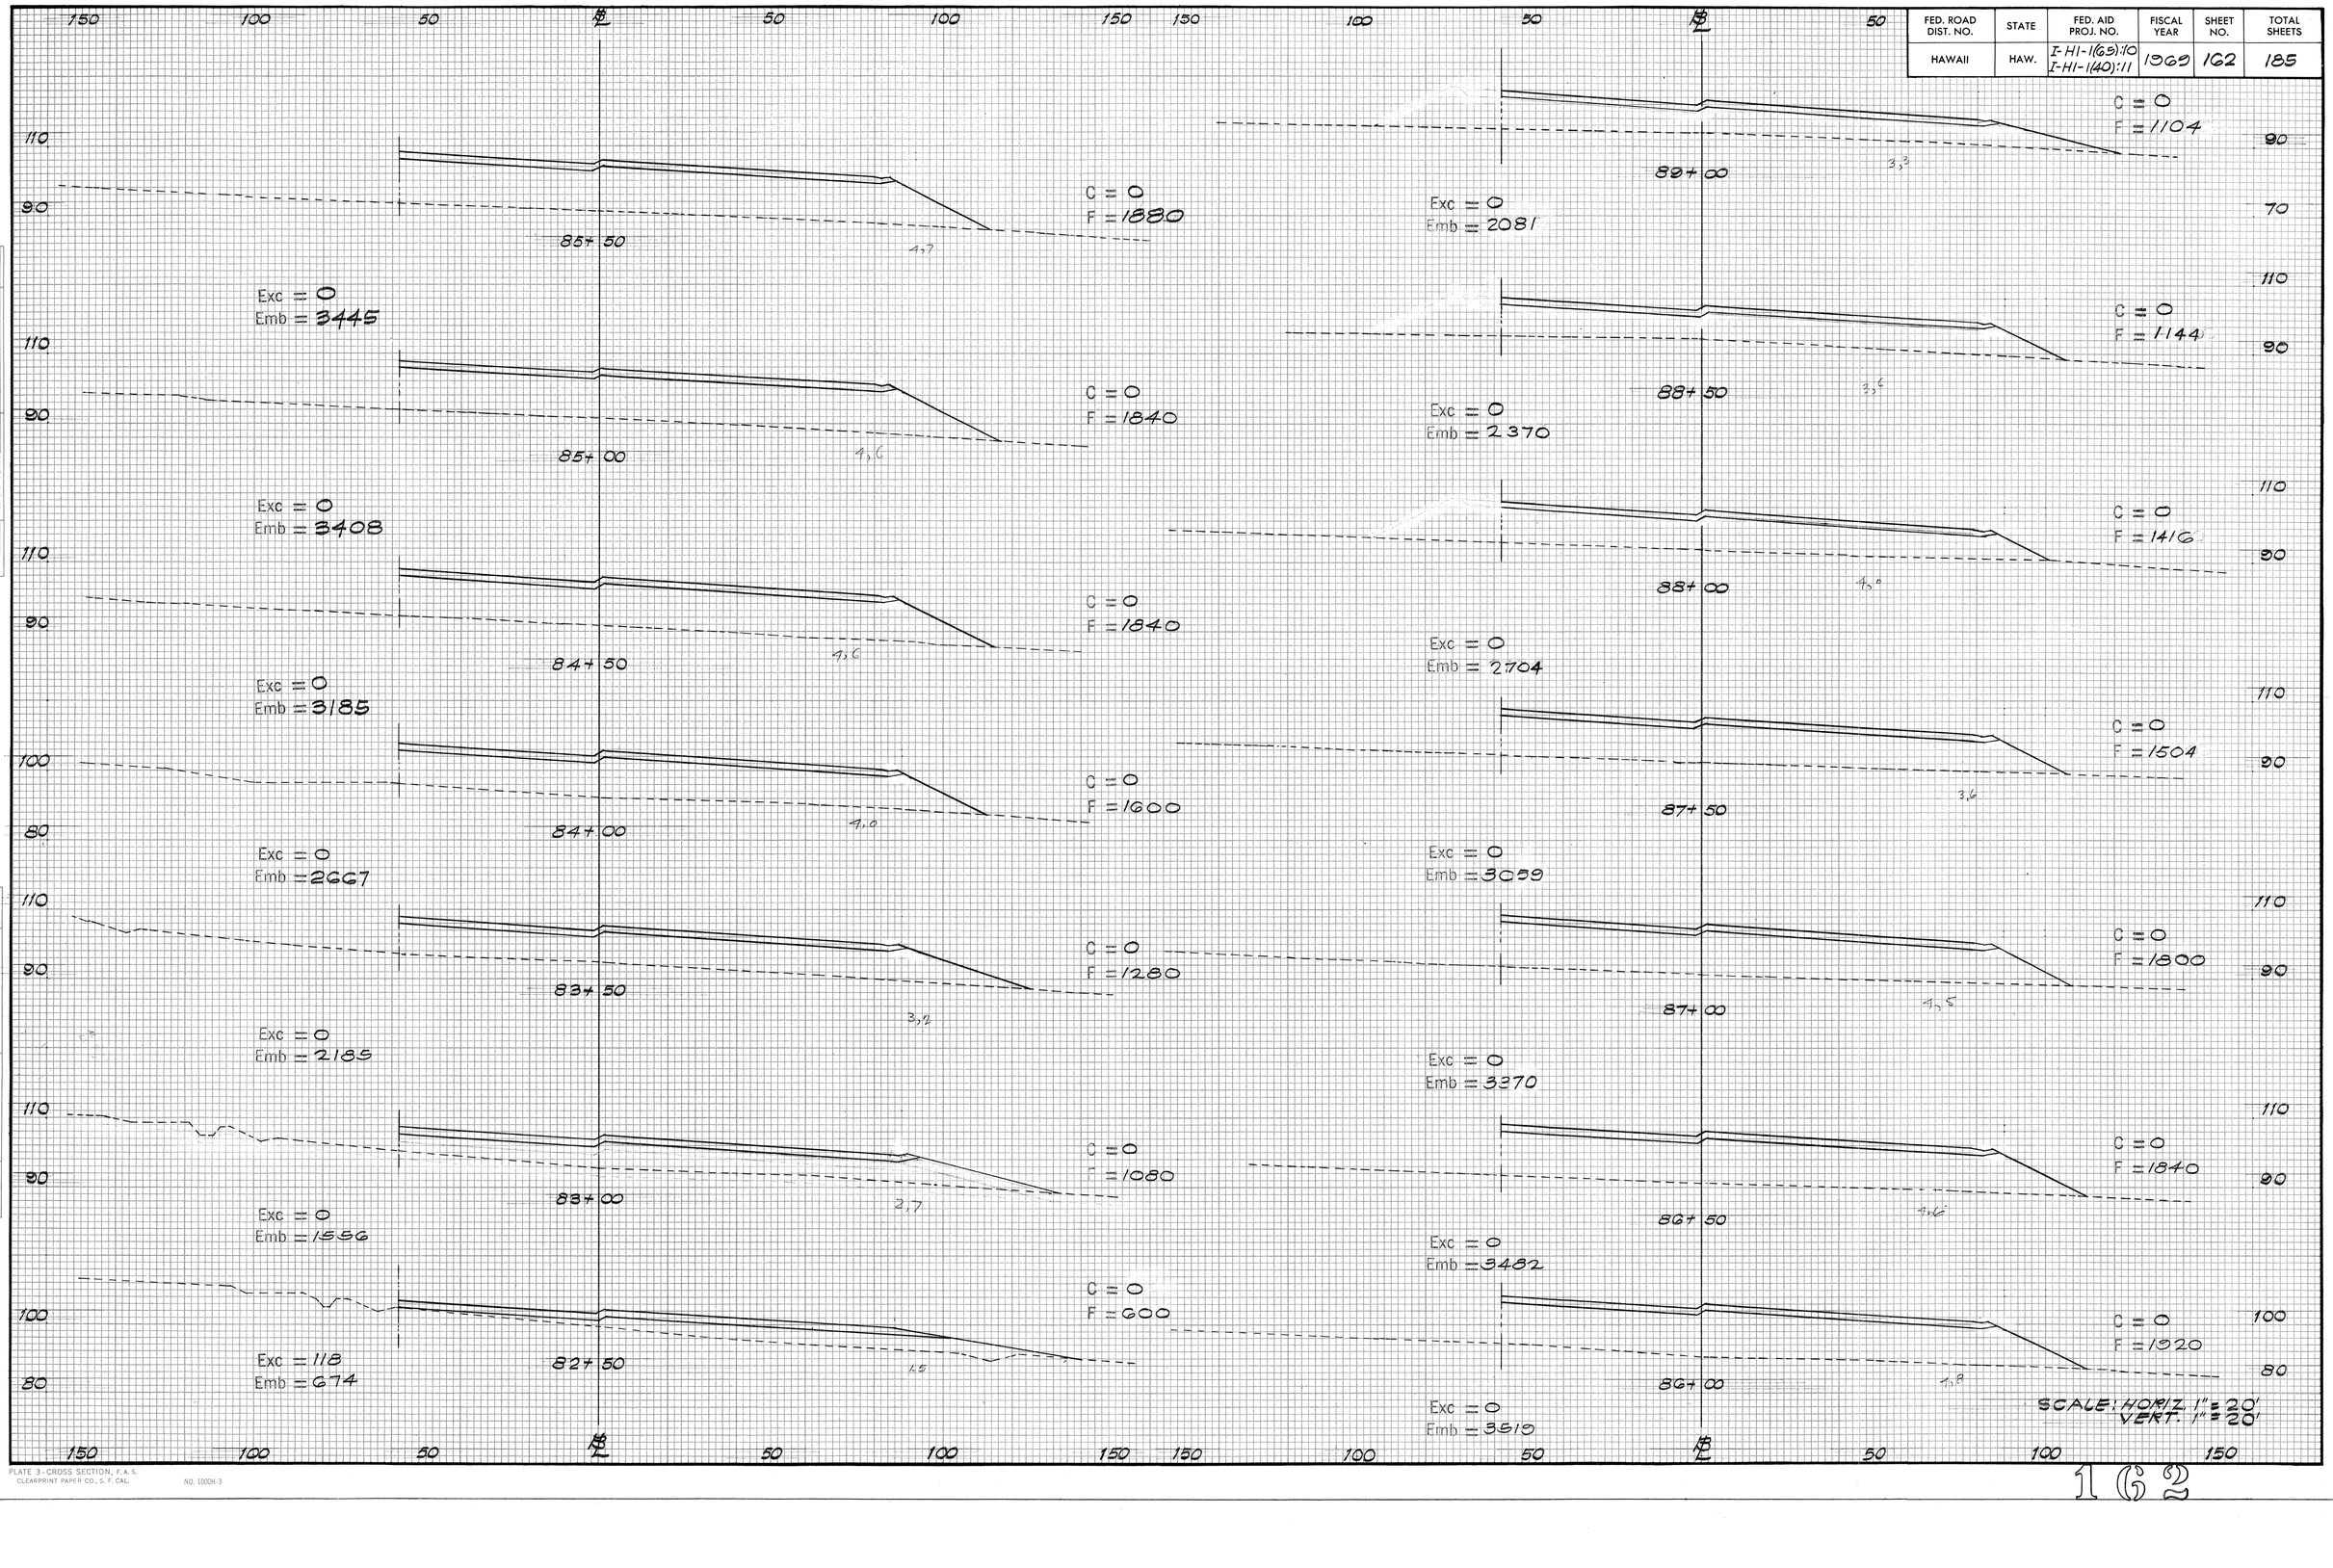

PLATE 3 - CROSS SECTION, F.A.S.
CLEARPRINT PAPER CO., S. F. CAL. NO. 1000H-3

162

FED. ROAD DIST. NO.	STATE	FED. AID PROJ. NO.	FISCAL YEAR	SHEET NO.	TOTAL SHEETS
HAWAII	HAW.	I-HI-1(65):10 I-HI-1(40):11	1969	163	185

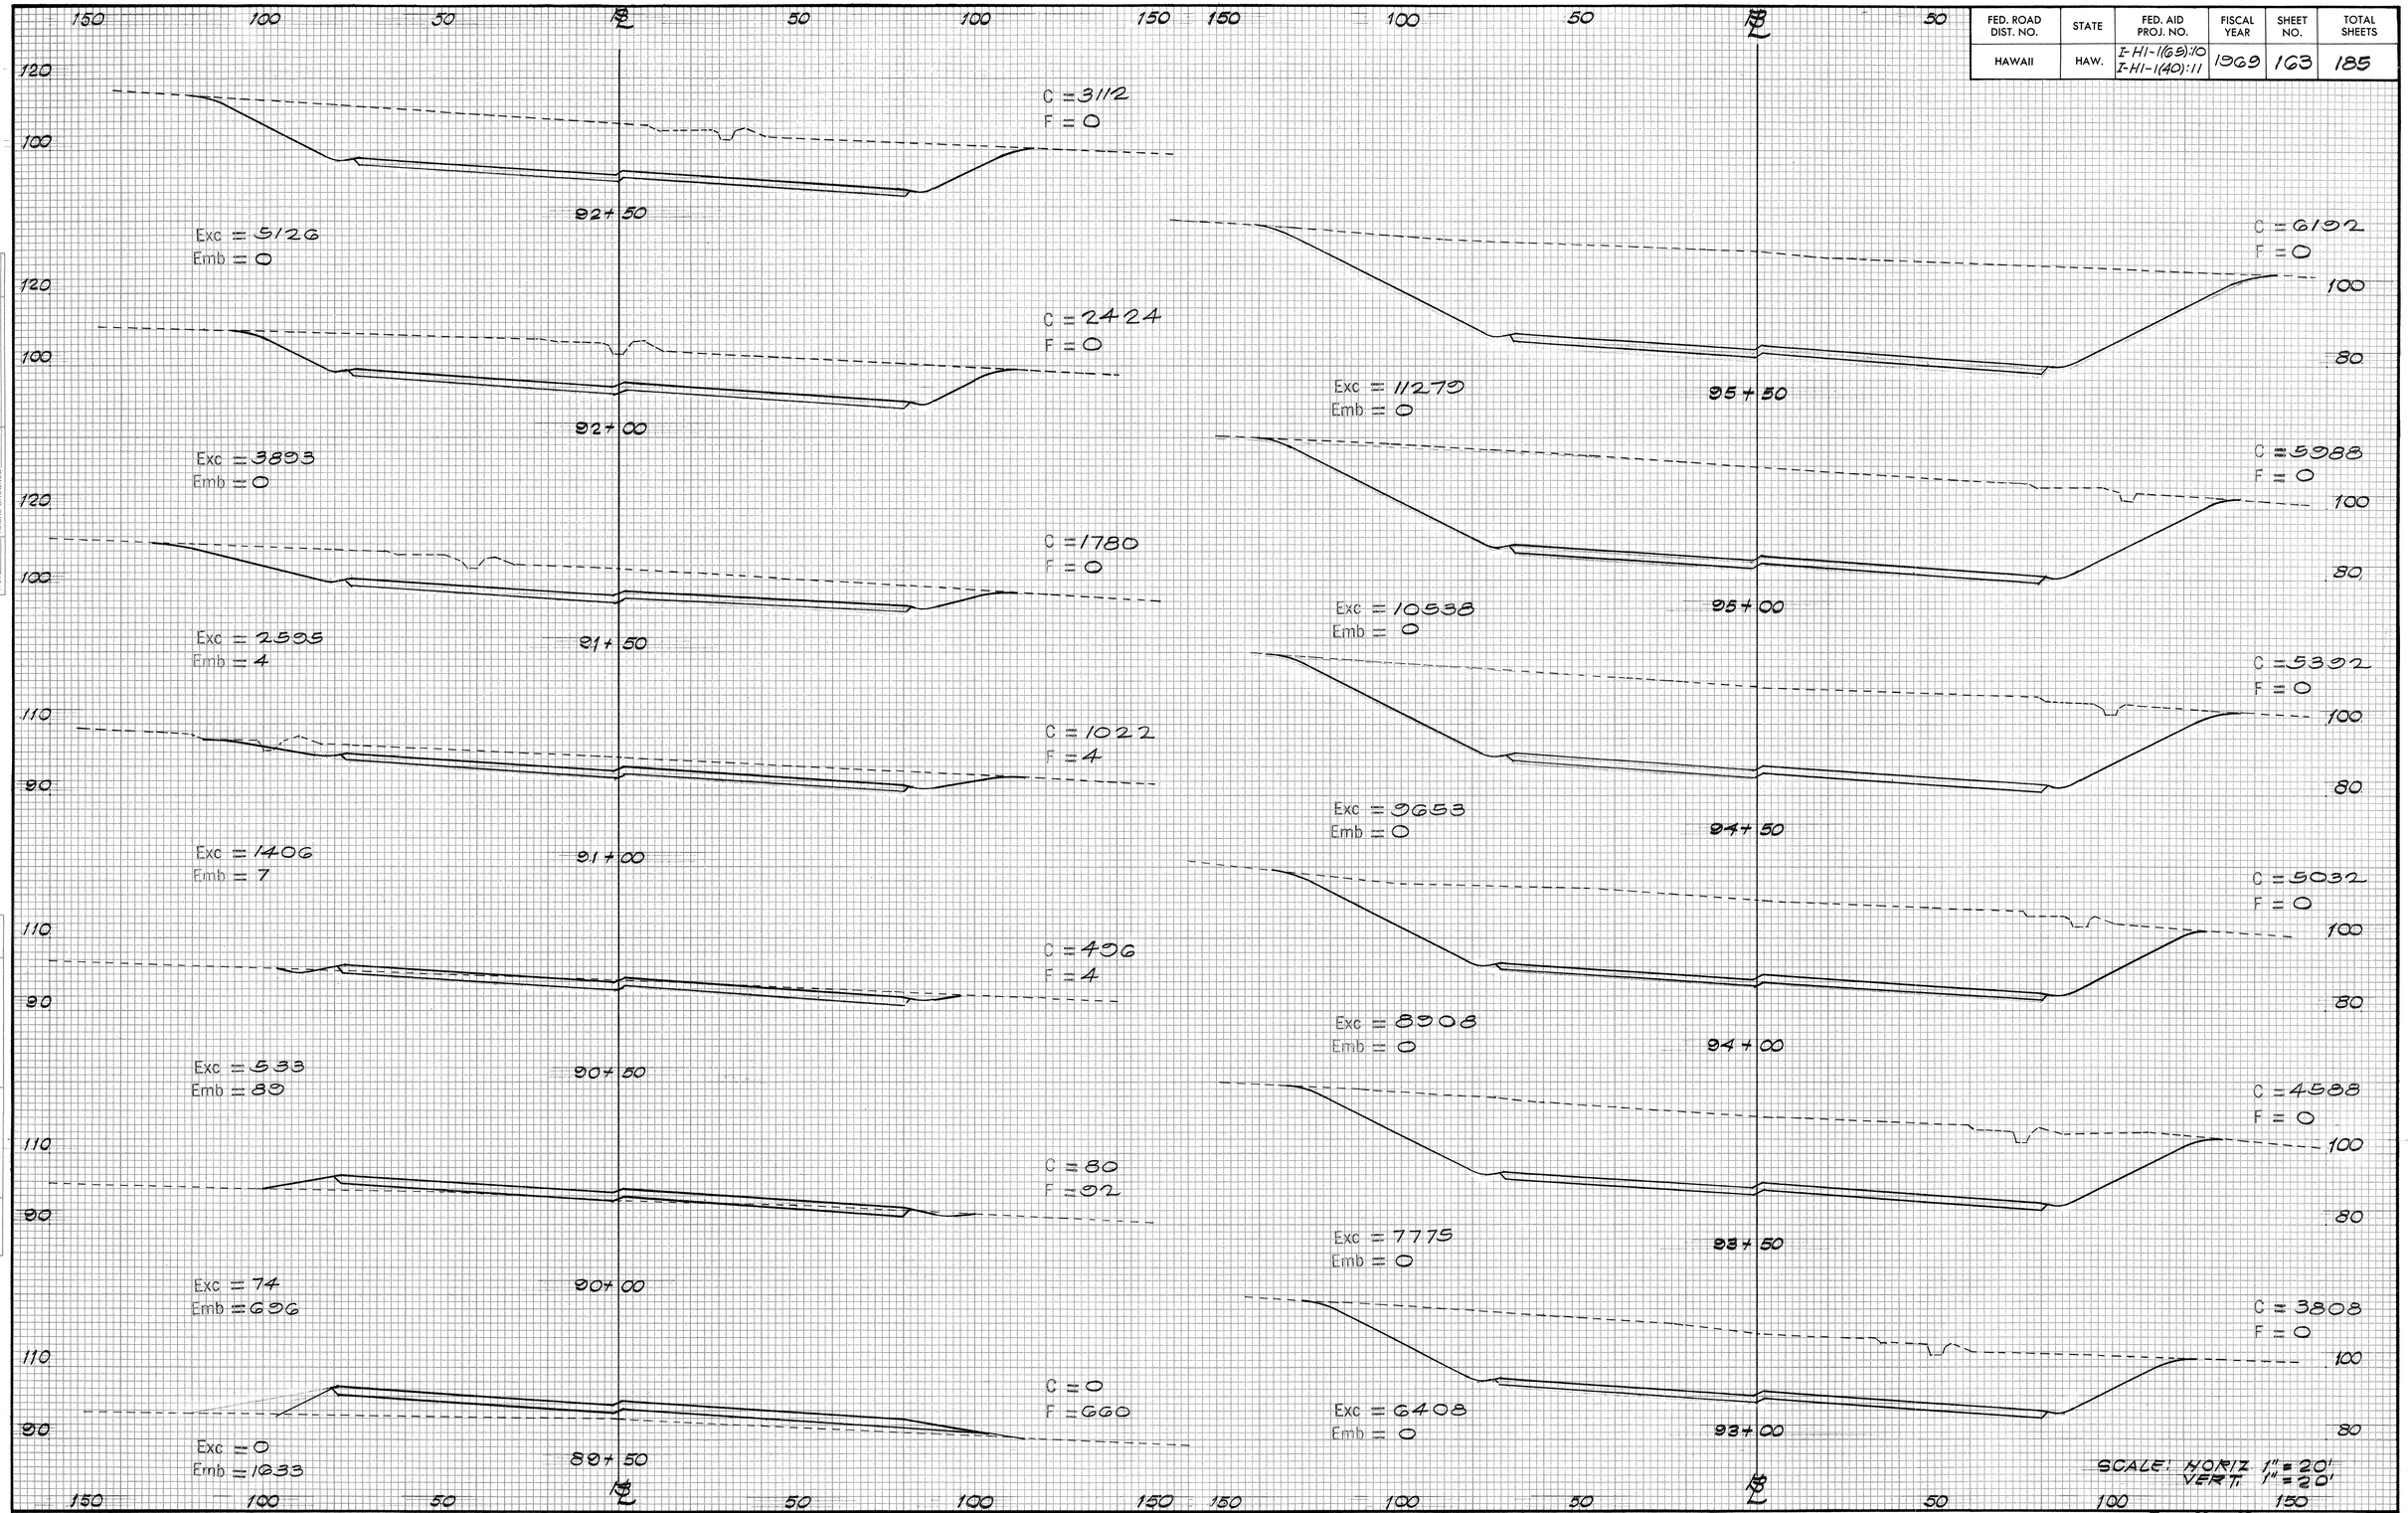

FINAL SURVEY — NOTE BOOK NO. — SURVEYED — PLOTTED — TEMPLATE — AREAS — AREAS CHECKED — BY — DATE

ORIGINAL SURVEY — NOTE BOOK NO. — SURVEYED — PLOTTED — TEMPLATE — AREAS — AREAS CHECKED — BY — DATE

PLATE 3-CROSS SECTION, F.A.S.
CLEARPRINT PAPER CO., S. F. CAL. NO. 1000H-3

FED. ROAD DIST. NO.	STATE	FED. AID PROJ. NO.	FISCAL YEAR	SHEET NO.	TOTAL SHEETS
HAWAII	HAW.	I-HI-1(62)10 I-HI-1(40):11	1969	164	185

FINAL SURVEY	SURVEYED	DATE
NOTE BOOK	PLOTTED	BY
NO.	TEMPLATE	
	AREAS	
	AREAS CHECKED	

ORIGINAL SURVEY	SURVEYED	DATE
NOTE BOOK	PLOTTED	BY
NO.	TEMPLATE	
	AREAS	
	AREAS CHECKED	

150 100 50 ℄ 50 100 150 150 100 50 ℄ 50 100 150

110 90 70

Exc = 12853
Emb = 0

11.1

98+00

C = 6840
F = 0

110 90 70

Exc = 12853
Emb = 0

17.1

97+50

C = 7040
F = 0

100 80

Exc = 6547
Emb = 0

12.2

97+00

C = 6840
F = 0

100 80

Exc = 6434
Emb = 0

17.0

P.T. 96+74.69

C = 7120
F = 0

100 80

Exc = 12705
Emb = 0

17.4

96+50

C = 6960
F = 0

100 80

Exc = 11054
Emb = 0

16.3

96+00

C = 6760
F = 0

Exc = 7815
Emb = 0

9.6

101+00

C = 3840
F = 0

90 70

Exc = 9186
Emb = 0

11.5

100+50

C = 4600
F = 0

100 80 60

Exc = 10207
Emb = 0

13.3

100+00

C = 5320
F = 0

100 80 60

Exc = 11001
Emb = 0

14.6

99+50

C = 5800
F = 0

100 80 60

Exc = 11260
Emb = 0

15.2

99+00

C = 6080
F = 0

100 80 60

Exc = 11964
Emb = 0

15.2

98+50

C = 6080
F = 0

100 80 60

150 100 50 ℄ 50 100 150 150 100 50 ℄ 50 100 150

SCALE: HORIZ. 1" = 20'
VERT. 1" = 20'

PLATE 3 - CROSS SECTION, F. A. S.
CLEARPRINT PAPER CO., S. F., CAL. NO. 1000H-3

164

FED. ROAD DIST. NO.	STATE	FED. AID PROJ. NO.	FISCAL YEAR	SHEET NO.	TOTAL SHEETS
HAWAII	HAW.	I-HI-1(65):10 I-HI-1(40):11	1969	165	185

FINAL SURVEY — NOTE BOOK NO. — SURVEYED — PLOTTED — TEMPLATE — AREAS — AREAS CHECKED — BY — DATE

ORIGINAL SURVEY — NOTE BOOK NO. — SURVEYED — PLOTTED — TEMPLATE — AREAS — AREAS CHECKED — BY — DATE

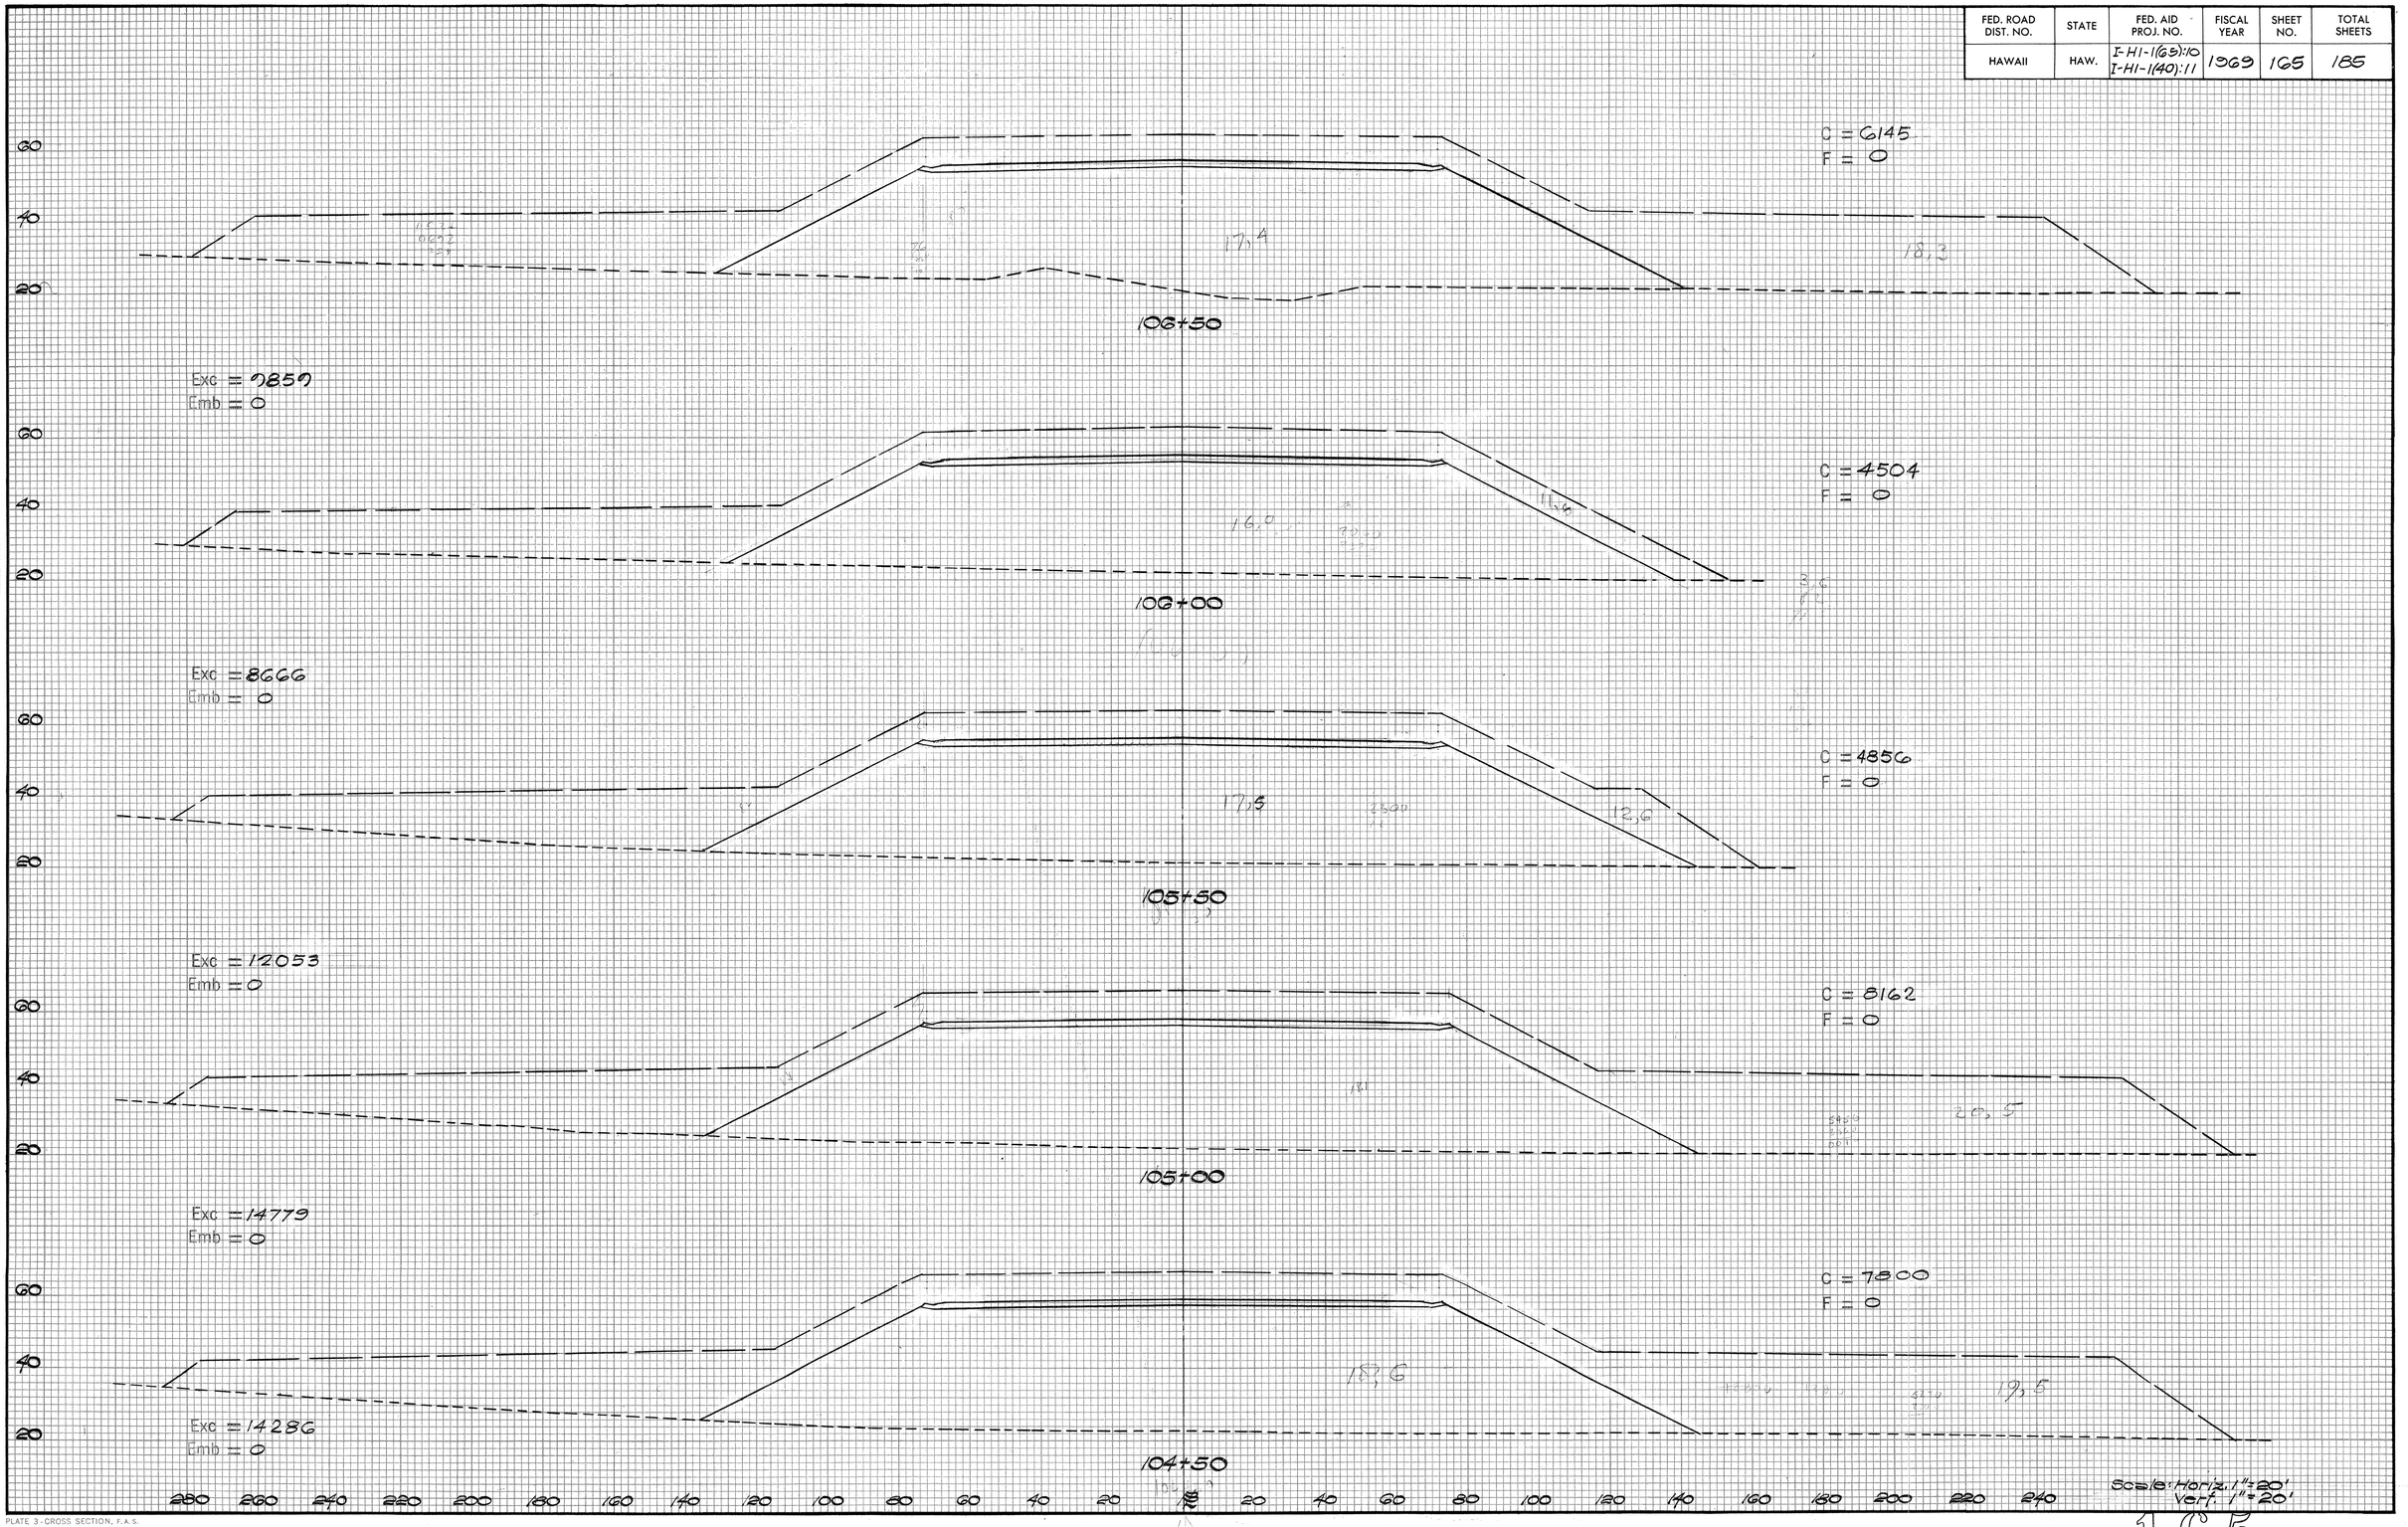

PLATE 3 - CROSS SECTION, F.A.S.
CLEARPRINT PAPER CO., S. F. CAL.
NO. 1000H-3

165

FED. ROAD DIST. NO.	STATE	FED. AID PROJ. NO.	FISCAL YEAR	SHEET NO.	TOTAL SHEETS
HAWAII	HAW.	I-HI-1(65):10 I-HI-1(90):11	1969	166	185

FINAL SURVEY — SURVEYED, PLOTTED, NOTE BOOK, NO., TEMPLATE, AREAS, AREAS CHECKED, BY, DATE

ORIGINAL SURVEY — SURVEYED, PLOTTED, NOTE BOOK, NO., TEMPLATE, AREAS, AREAS CHECKED, BY, DATE

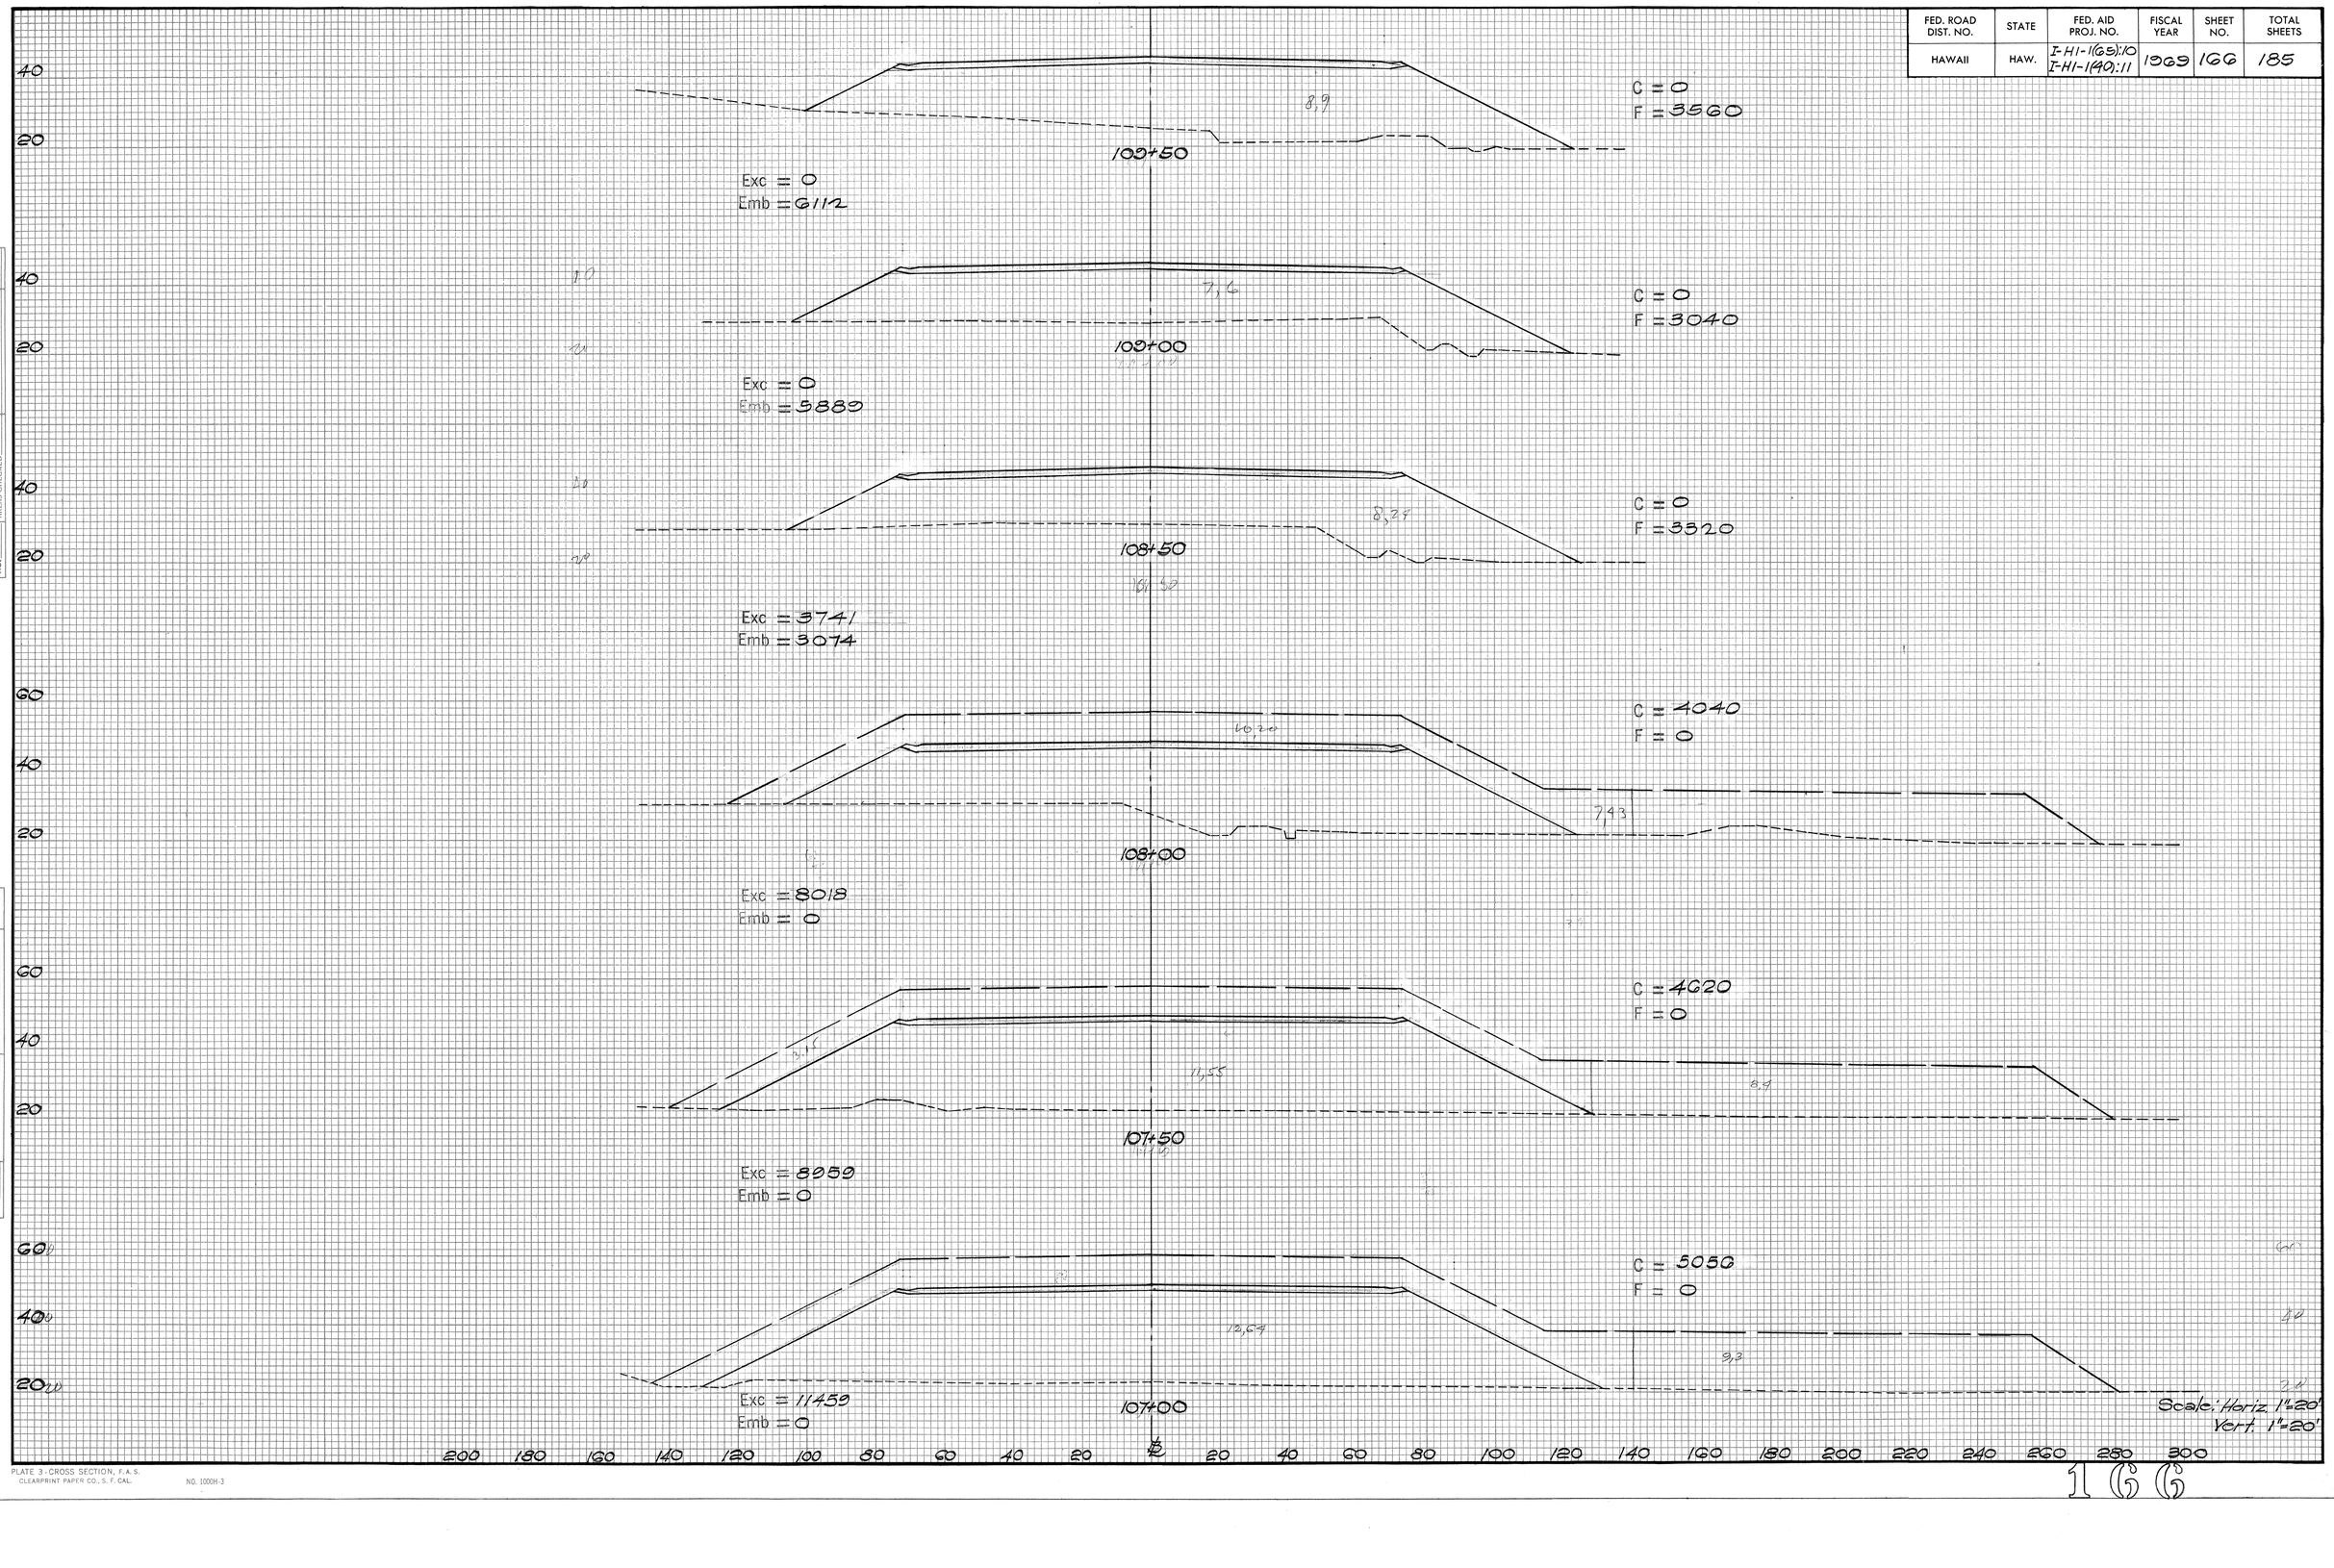

PLATE 3 - CROSS SECTION, F. A. S.
CLEARPRINT PAPER CO., S. F. CAL. NO. 1000H-3

166

FED. ROAD DIST. NO.	STATE	FED. AID PROJ. NO.	FISCAL YEAR	SHEET NO.	TOTAL SHEETS
HAWAII	HAW.	I-HI-1(65):10 I-HI-1(40):11	1969	167	185

FINAL SURVEY
SURVEYED
PLOTTED
TEMPLATE
AREAS
AREAS CHECKED
NOTE BOOK
NO.
BY
DATE

ORIGINAL SURVEY
SURVEYED
PLOTTED
TEMPLATE
AREAS
AREAS CHECKED
NOTE BOOK
NO.
BY
DATE

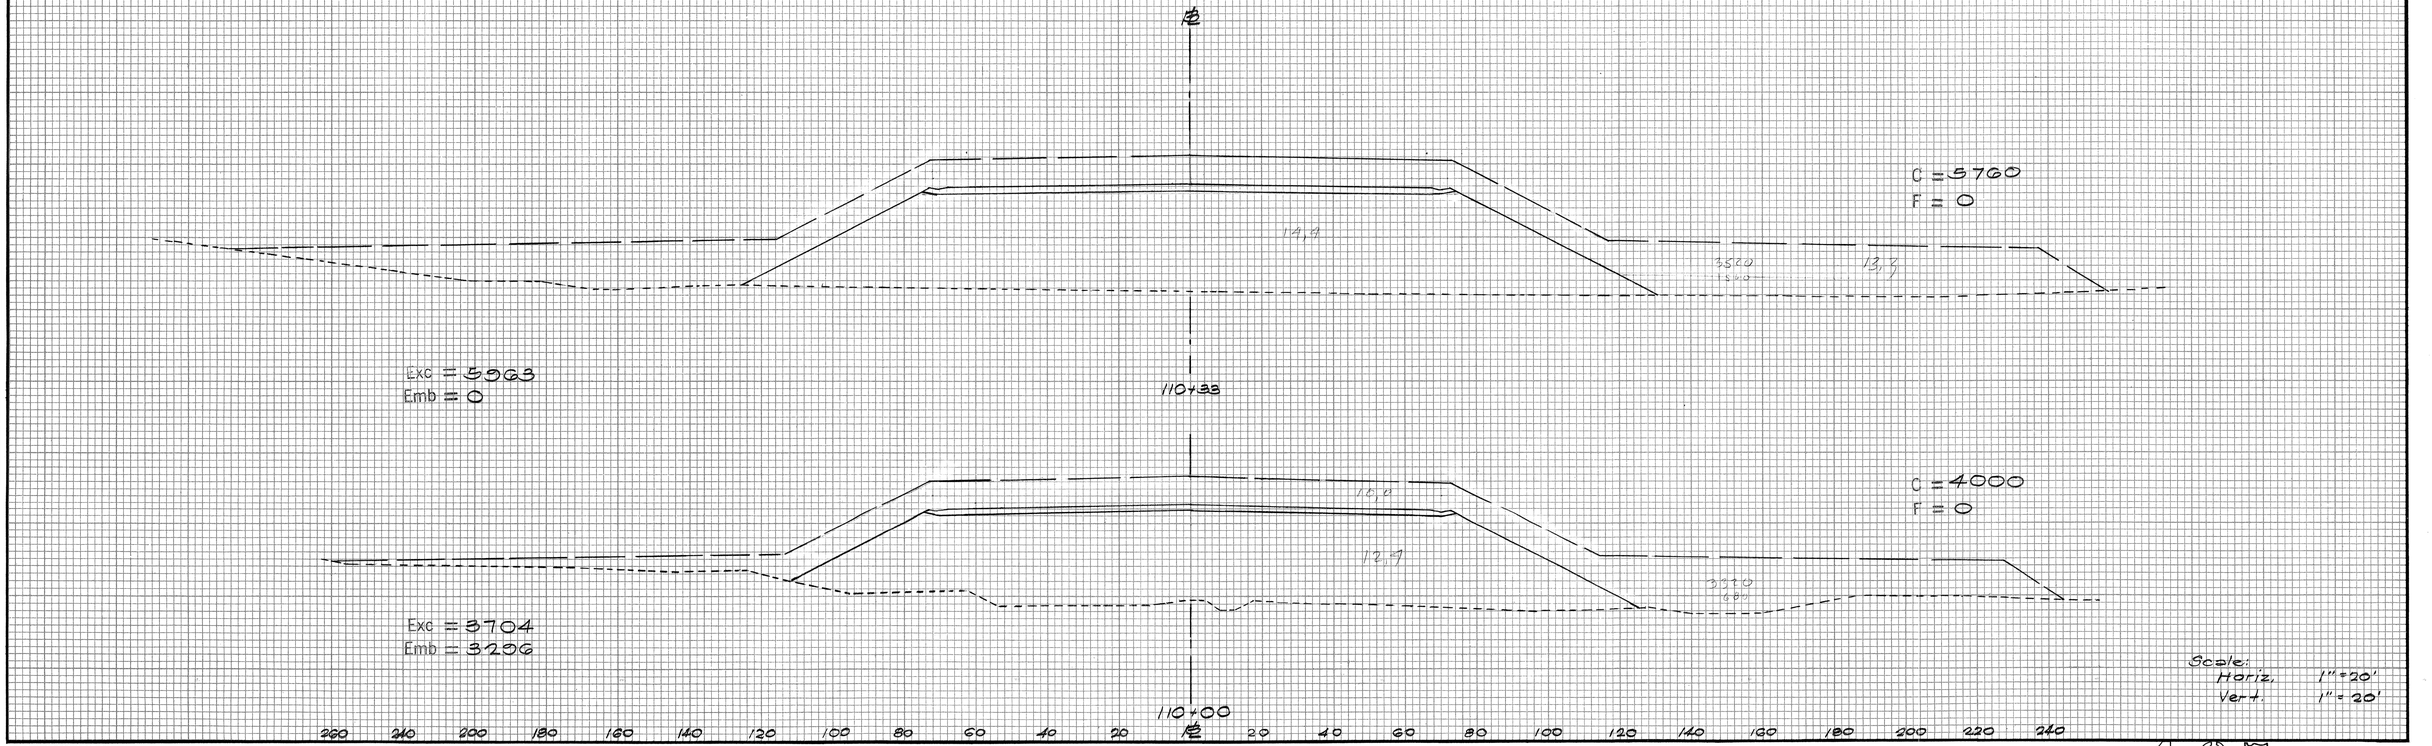

Scale:
Horiz. 1" = 20'
Vert. 1" = 20'

PLATE 3 - CROSS SECTION, F.A.S.
CLEARPRINT PAPER CO., S. F. CAL.
NO. 1000H-3

167

FED. ROAD DIST. NO.	STATE	FED. AID PROJ. NO.	FISCAL YEAR	SHEET NO.	TOTAL SHEETS
HAWAII	HAW.	I-HI-1(65):10 I-HI-1(40):11	1969	128	185

FINAL SURVEY — SURVEYED, PLOTTED, TEMPLATE, AREAS, AREAS CHECKED, NOTE BOOK, NO., BY, DATE

ORIGINAL SURVEY — SURVEYED, PLOTTED, TEMPLATE, AREAS, AREAS CHECKED, NOTE BOOK, NO., BY, DATE

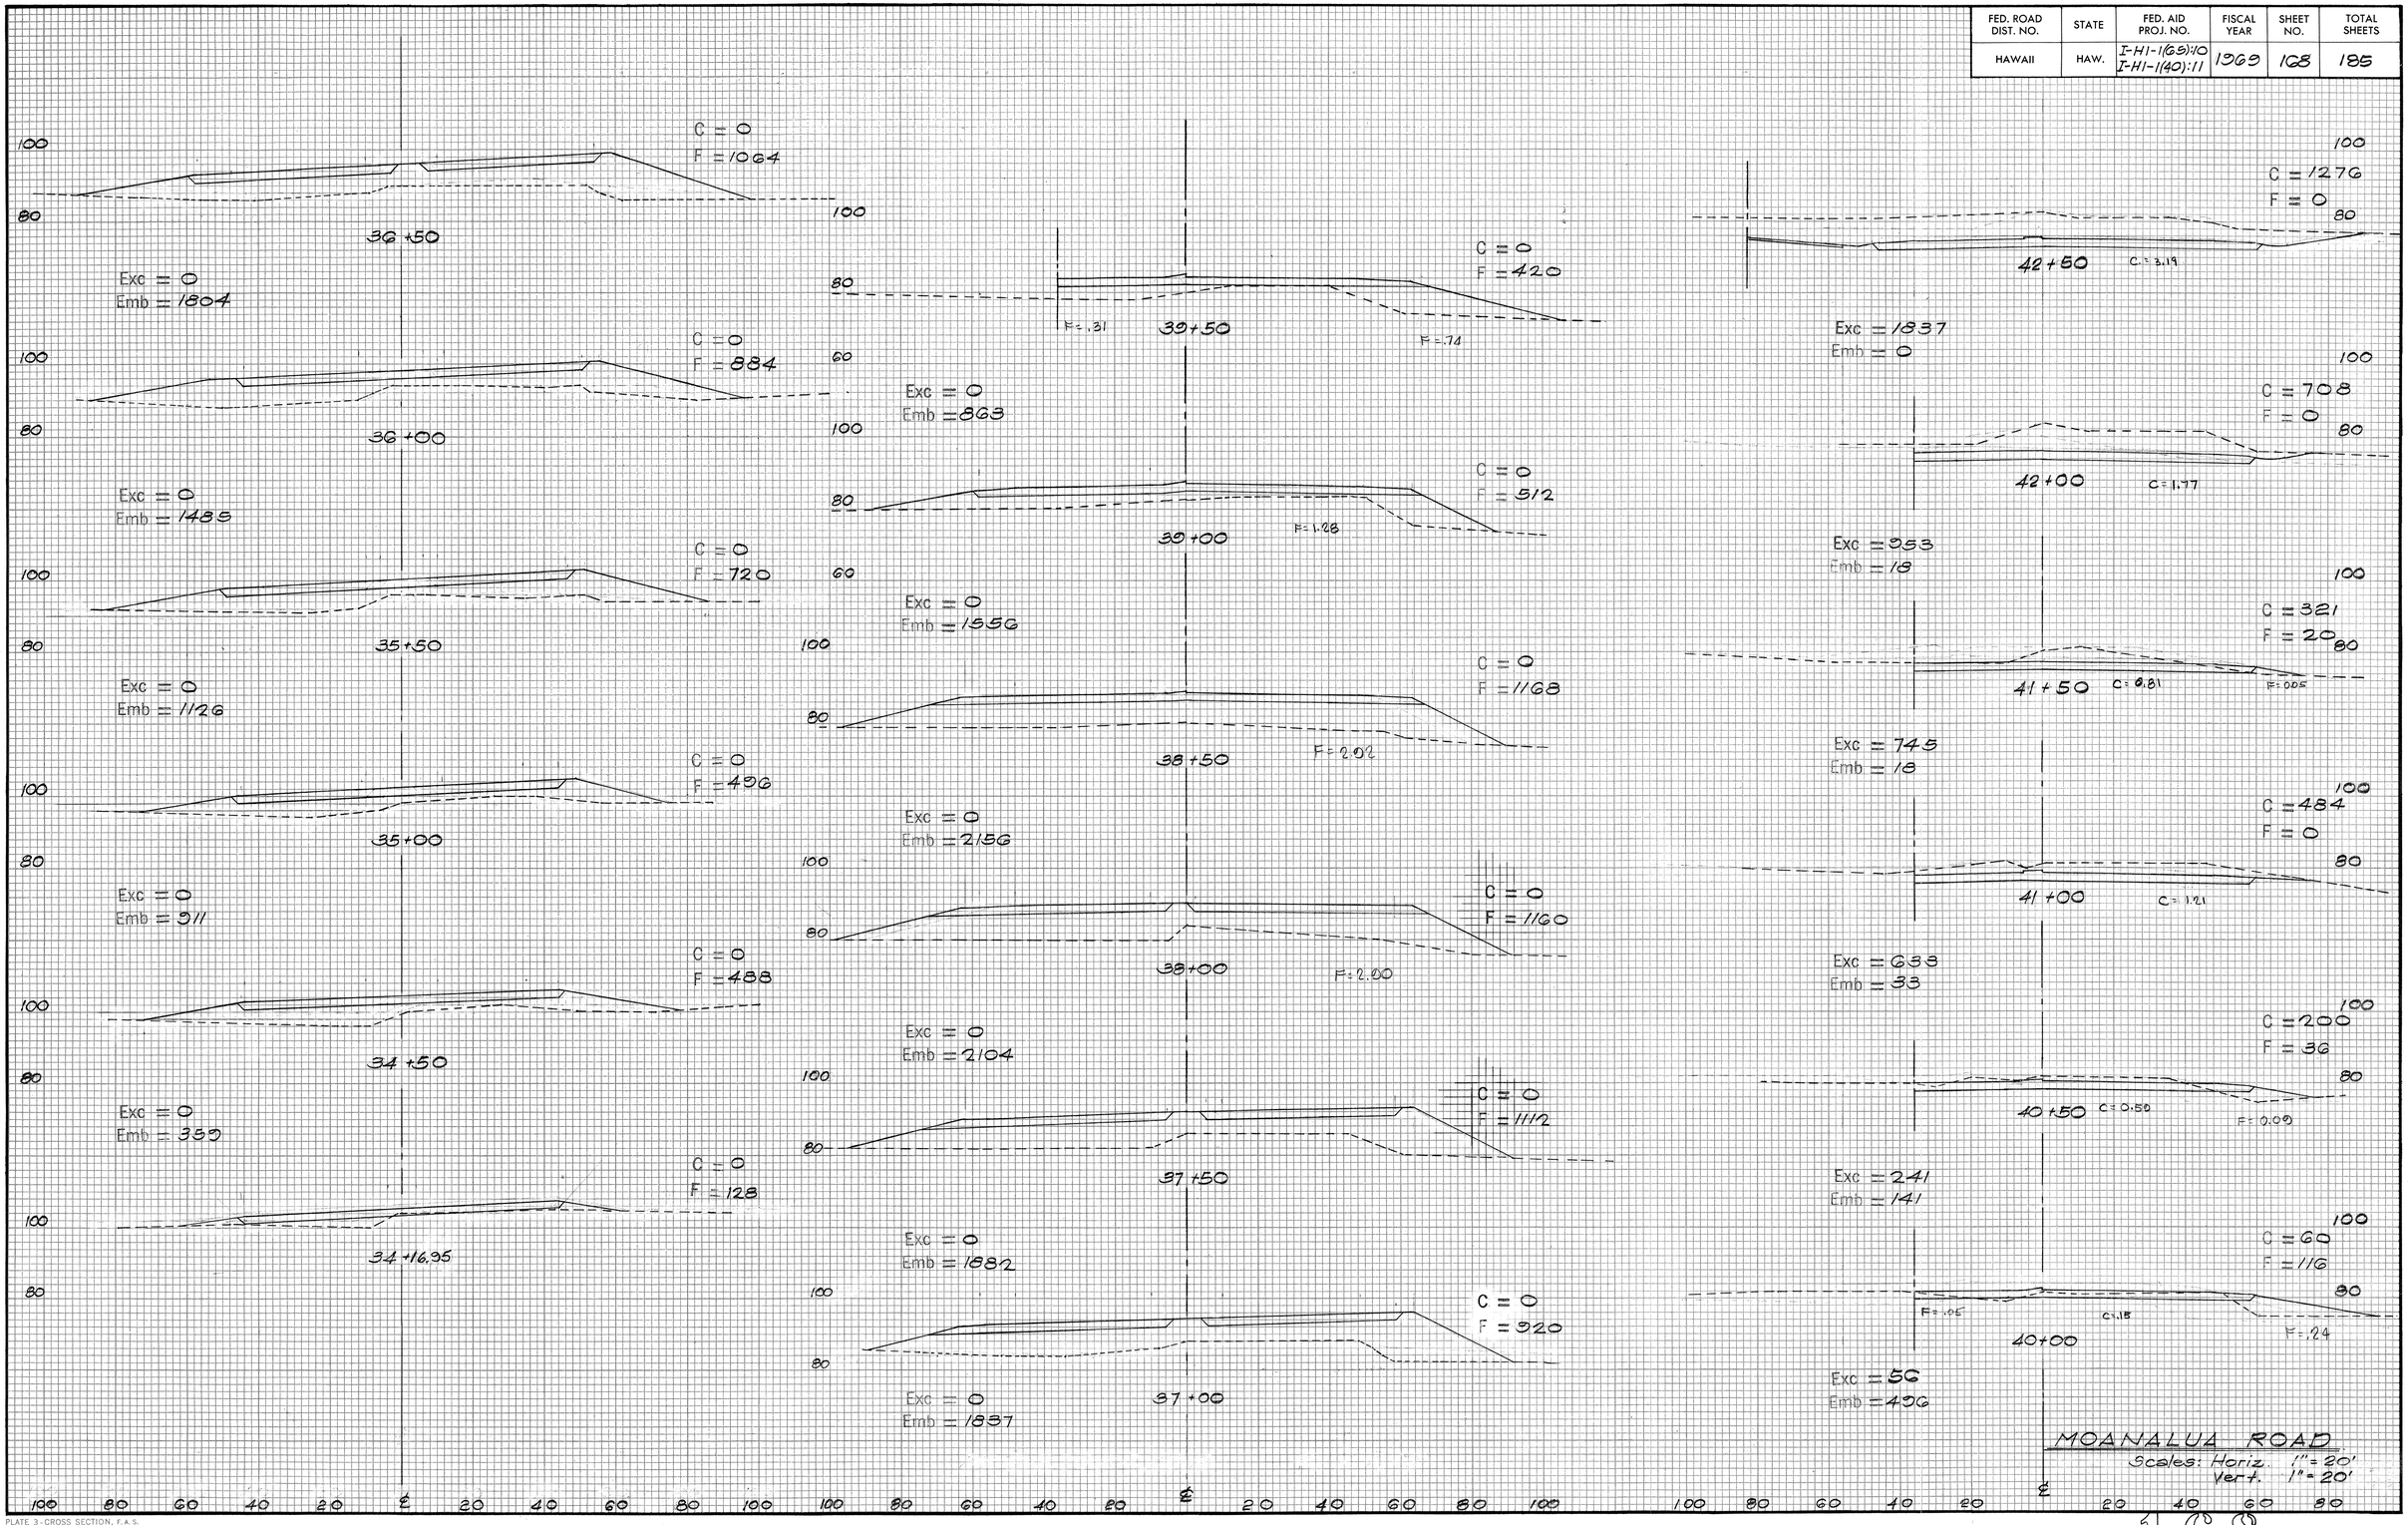

MOANALUA ROAD

Scales: Horiz. 1" = 20'
Vert. 1" = 20'

PLATE 3 - CROSS SECTION, F.A.S.
CLEARPRINT PAPER CO., S. F. CAL. NO. 1000H-3

C-07.20

FED. ROAD DIST. NO.	STATE	FED. AID PROJ. NO.	FISCAL YEAR	SHEET NO.	TOTAL SHEETS
HAWAII	HAW.	I-HI-1(63):10 I-HI-1(40):11	1969	160	185

FINAL SURVEY — NOTE BOOK — NO. — SURVEYED — PLOTTED — TEMPLATE — AREAS — AREAS CHECKED — BY — DATE

ORIGINAL SURVEY — NOTE BOOK — NO. — SURVEYED — PLOTTED — TEMPLATE — AREAS — AREAS CHECKED — BY — DATE

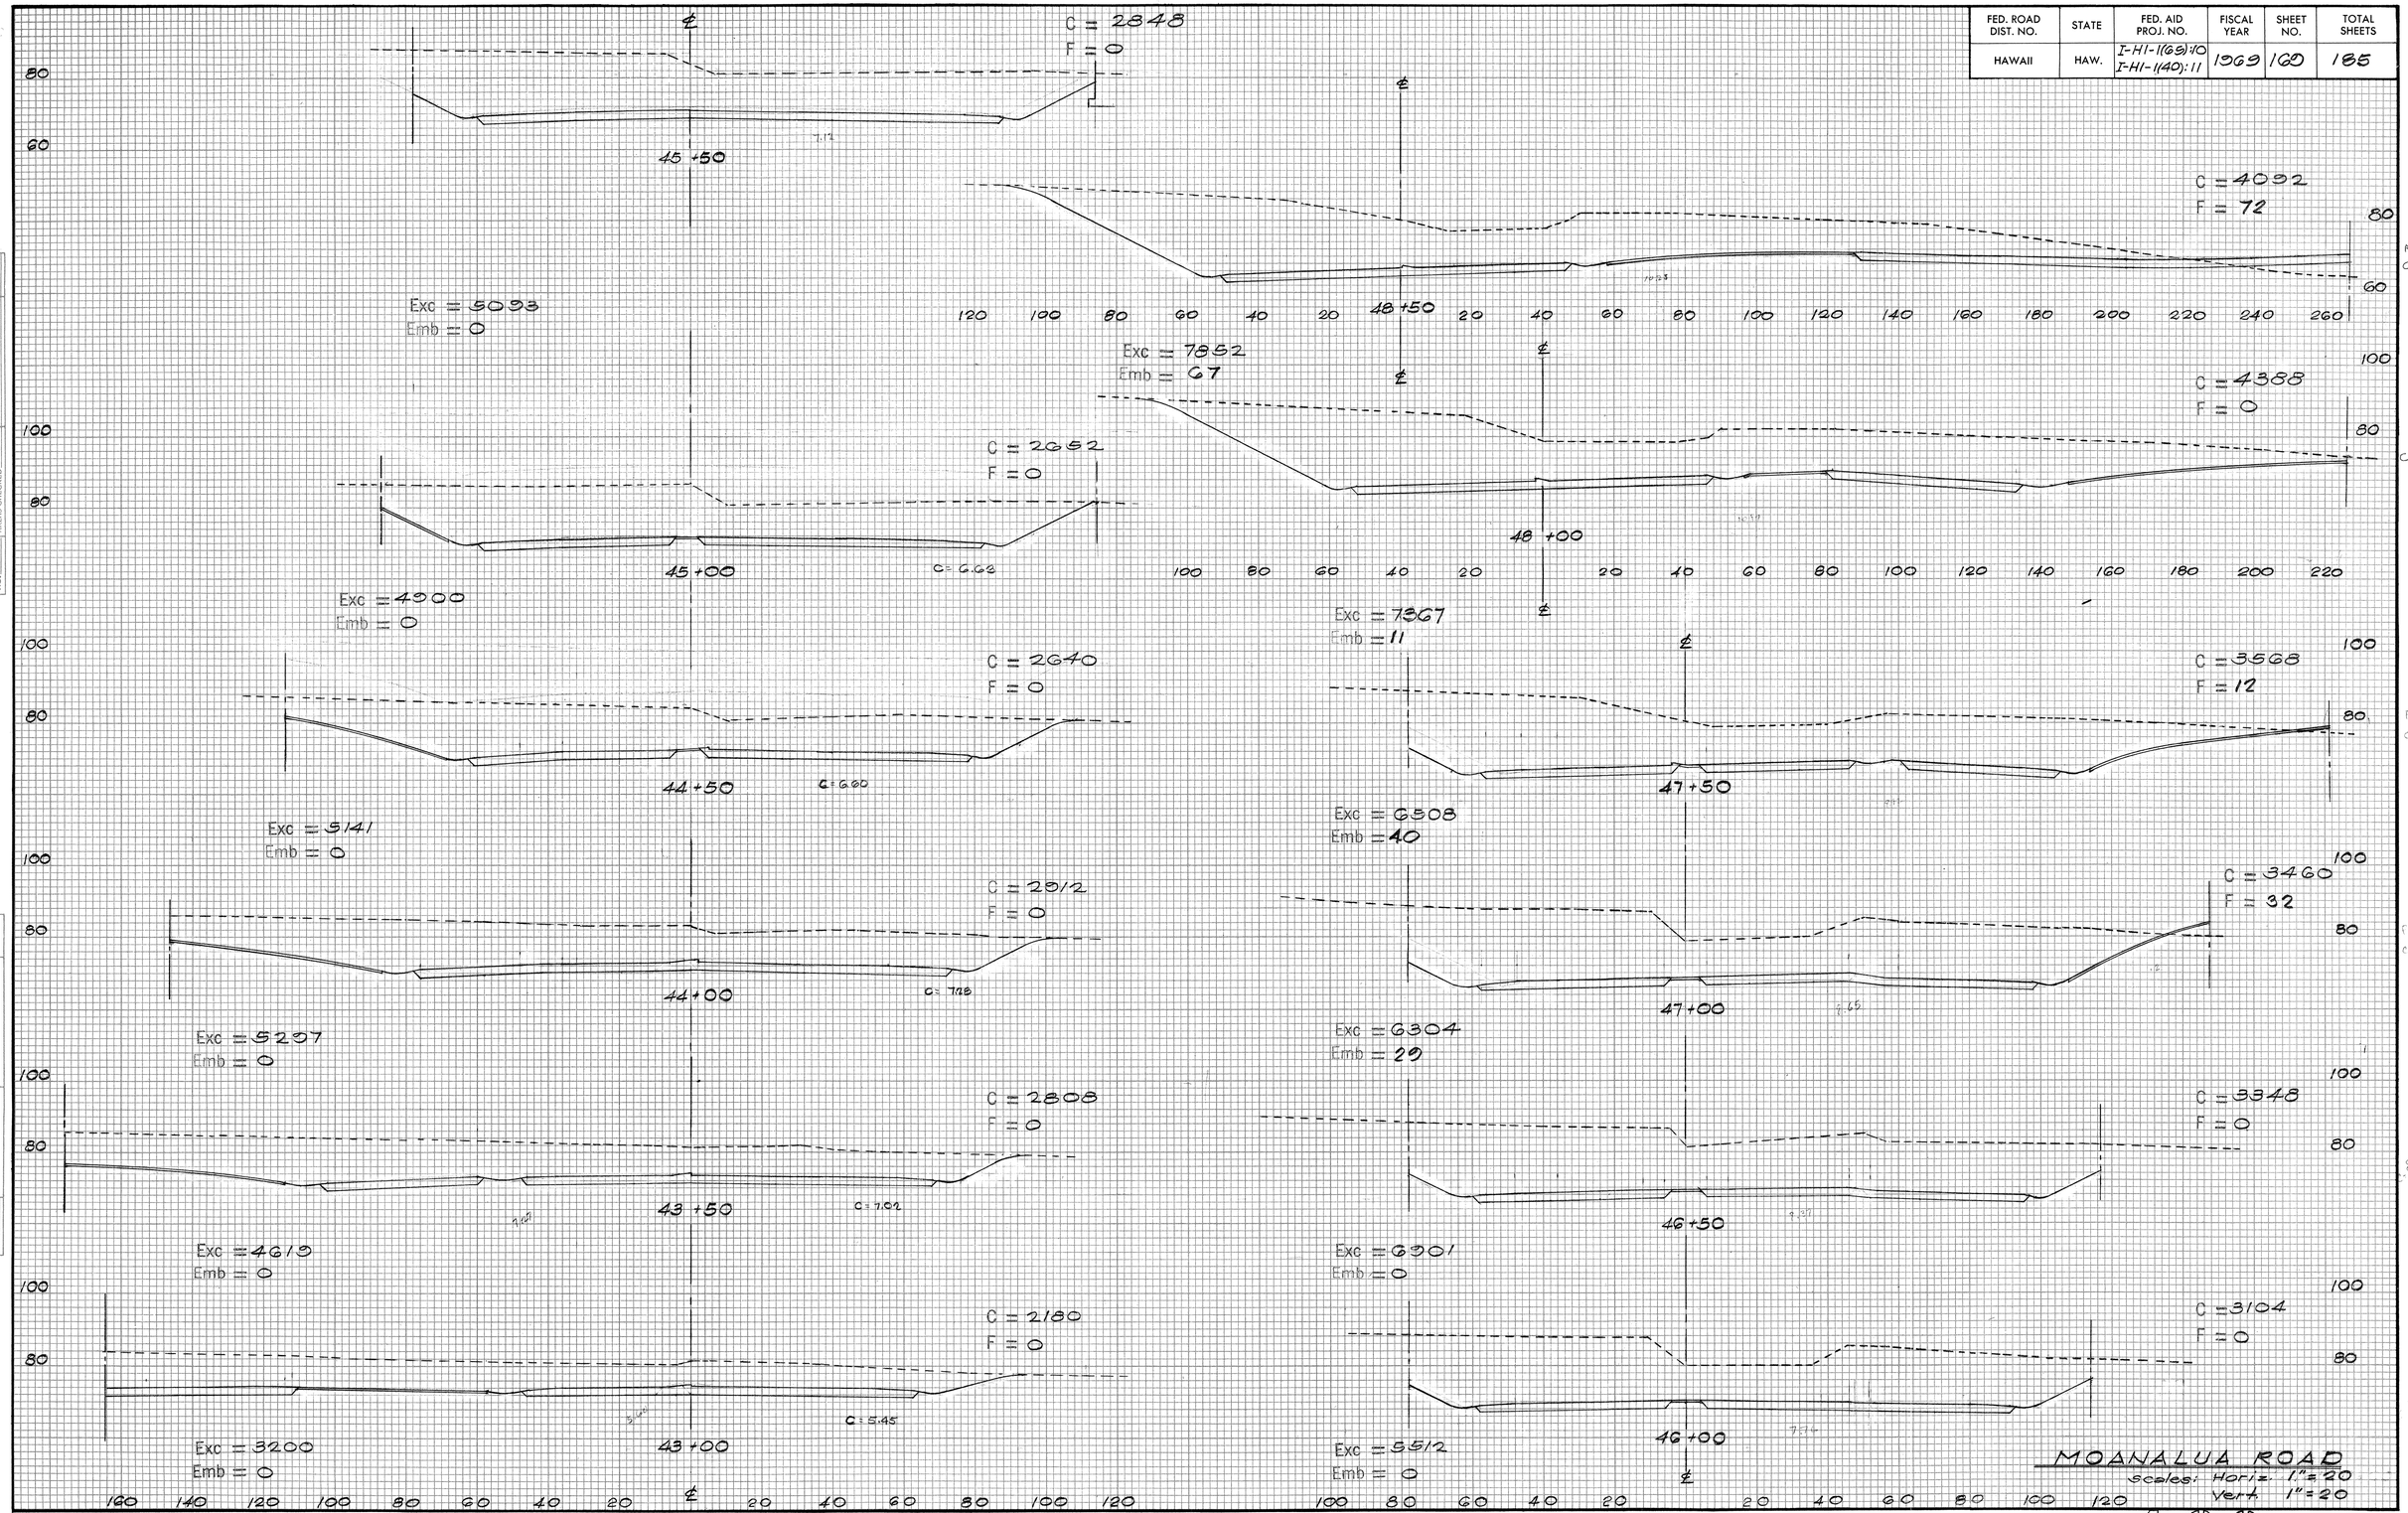

MOANALUA ROAD

Scales: Horiz. 1"=20
Vert. 1"=20

PLATE 3-CROSS SECTION, F.A.S.
CLEARPRINT PAPER CO., S. F. CAL. NO. 1000H-3

169

FED. ROAD DIST. NO.	STATE	FED. AID PROJ. NO.	FISCAL YEAR	SHEET NO.	TOTAL SHEETS
HAWAII	HAW.	I-HI-1(65):10 I-HI-1(40):11	1969	170	185

FINAL SURVEY — NOTE BOOK NO. — SURVEYED — PLOTTED — TEMPLATE — AREAS — AREAS CHECKED — BY — DATE

ORIGINAL SURVEY — NOTE BOOK NO. — SURVEYED — PLOTTED — TEMPLATE — AREAS — AREAS CHECKED — BY — DATE

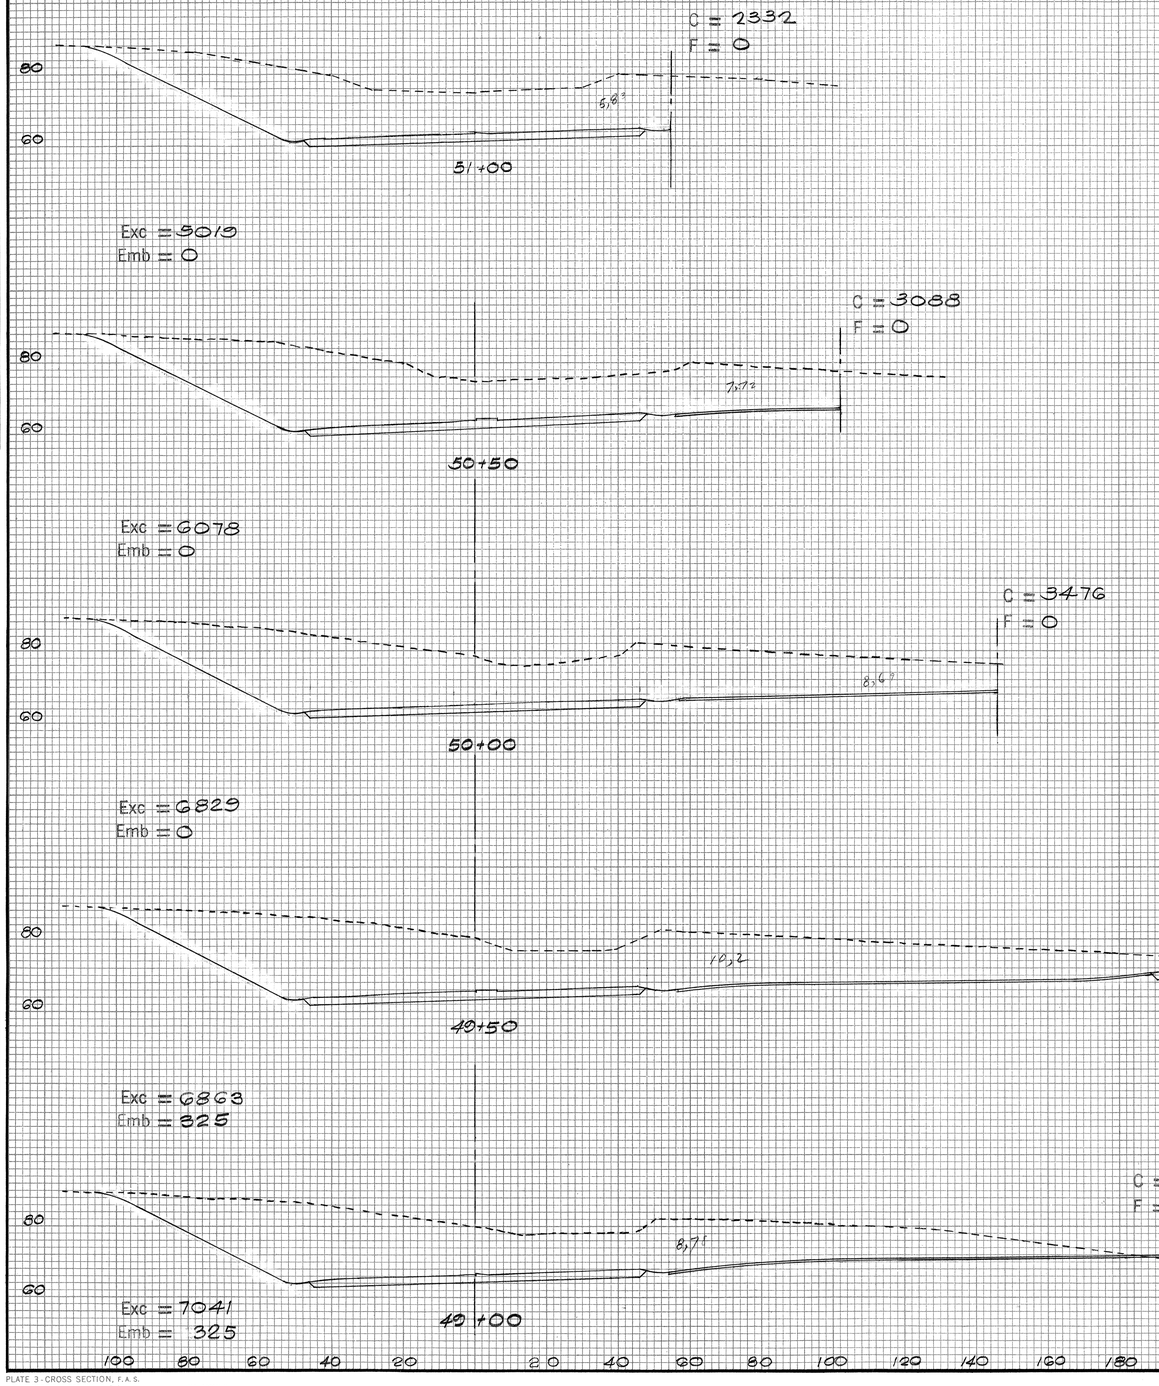

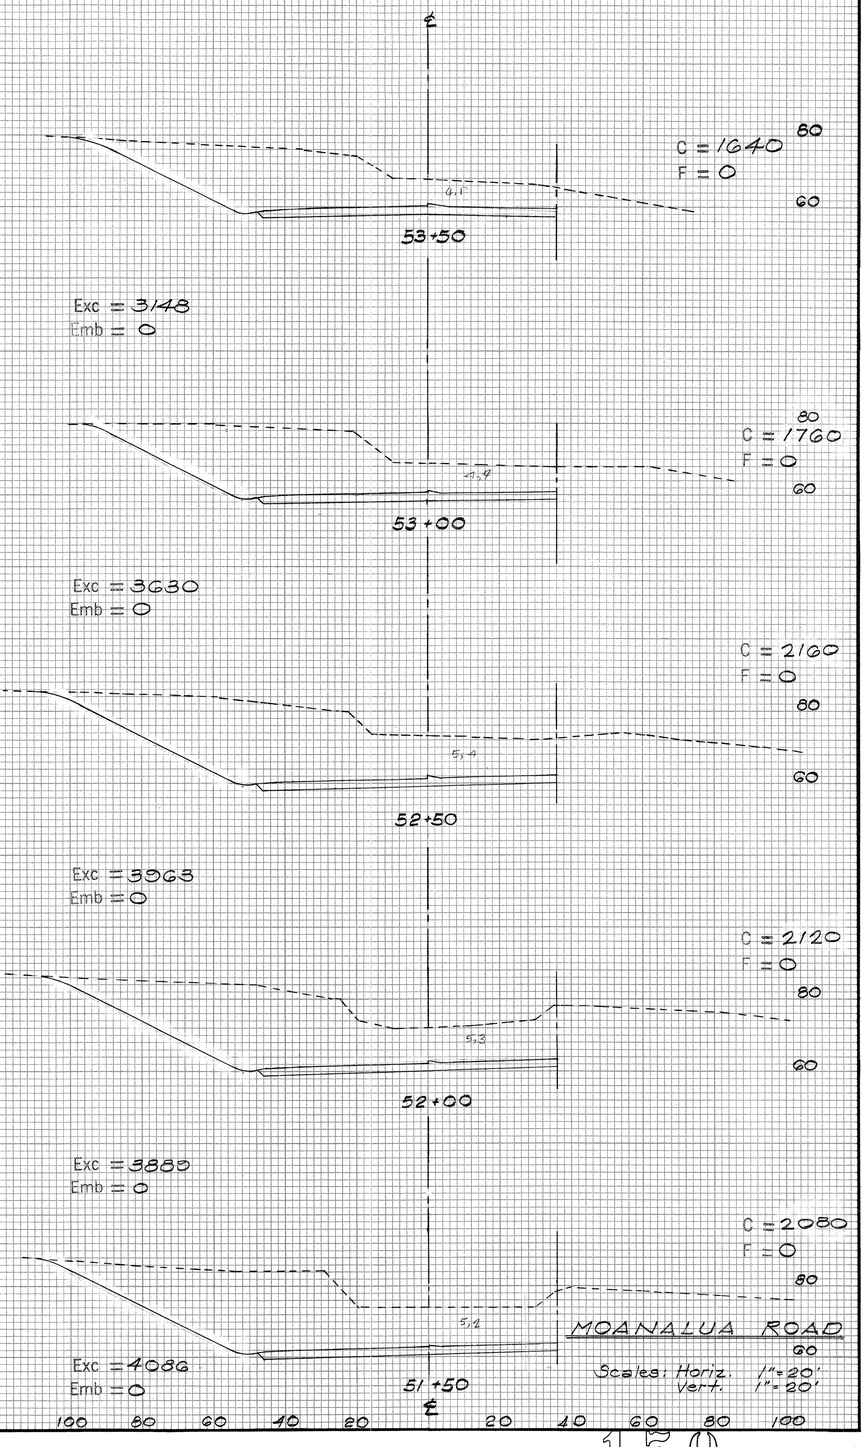

PLATE 3 - CROSS SECTION, F. A. S.
CLEARPRINT PAPER CO., S. F. CAL. NO. 1000H-3

FED. ROAD DIST. NO.	STATE	FED. AID PROJ. NO.	FISCAL YEAR	SHEET NO.	TOTAL SHEETS
HAWAII	HAW.	I-HI-1(65):10 I-HI-1(40):11	1969	171	185

FINAL SURVEY — NOTE BOOK — NO. — SURVEYED — PLOTTED — TEMPLATE — AREAS — AREAS CHECKED — BY — DATE

ORIGINAL SURVEY — NOTE BOOK — NO. — SURVEYED — PLOTTED — TEMPLATE — AREAS — AREAS CHECKED — BY — DATE

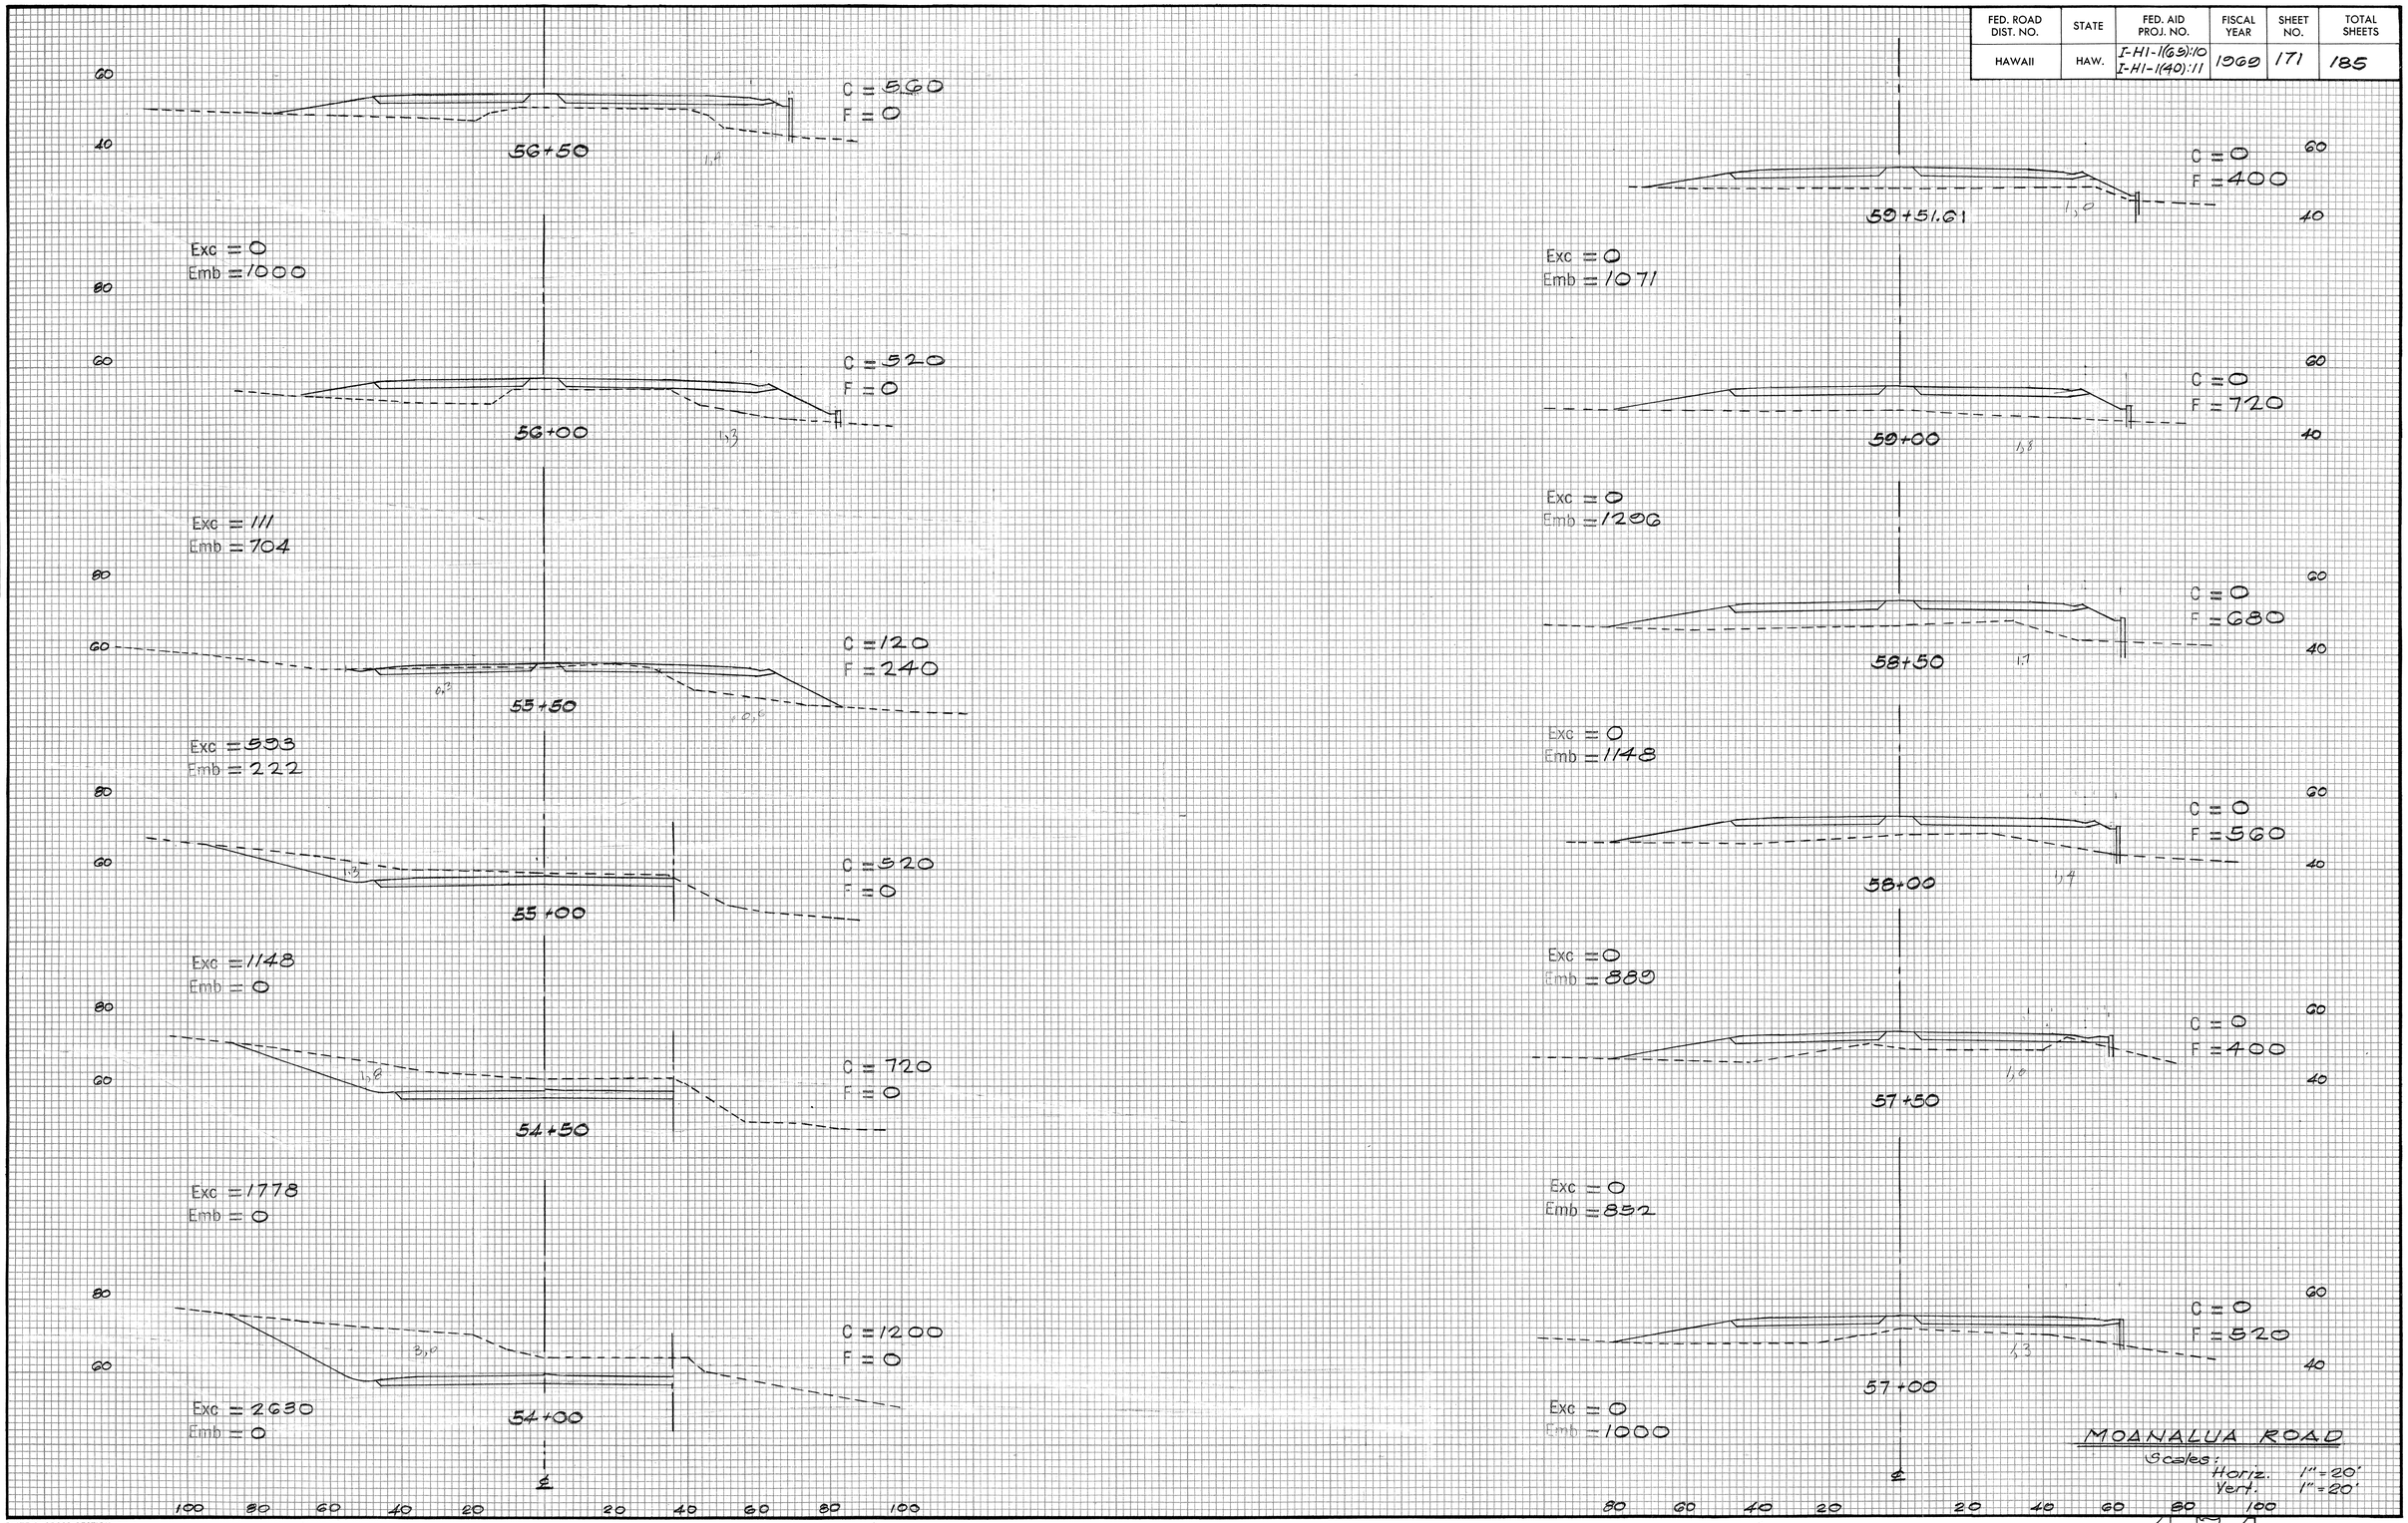

MOANALUA ROAD

Scales: Horiz. 1" = 20'
Vert. 1" = 20'

PLATE 3 - CROSS SECTION, F.A.S.
CLEARPRINT PAPER CO., S. F. CAL. NO. 1000H-3

171

FED. ROAD DIST. NO.	STATE	FED. AID PROJ. NO.	FISCAL YEAR	SHEET NO.	TOTAL SHEETS
HAWAII	HAW.	I-HI-1(65):10 I-HI-1(40):11	1969	172	185

FINAL SURVEY — NOTE BOOK — NO. — SURVEYED — PLOTTED — TEMPLATE — AREAS — AREAS CHECKED — BY — DATE

ORIGINAL SURVEY — NOTE BOOK — NO. — SURVEYED — PLOTTED — TEMPLATE — AREAS — AREAS CHECKED — BY — DATE

Temporary Viaduct Connection (By Others)

C = 0
F = 537

C = 0
F = 353

Exc = 0
Emb = 206

5+50

C = 0
F = 2197

Exc = 0
Emb = 650

3+50

Exc = 0
Emb = 3719

7+00

C = 0
F = 501

C = 0
F = 350

5+00

Exc = 0
Emb = 814

C = 0
F = 1820

Exc = 0
Emb = 636

3+00

DELETE

Exc = 0
Emb = 2707

6+50

C = 0
F = 379

C = 0
F = 337

4+50

C = 0
F = 1104

Exc = 0
Emb = 279

2+50

Exc = 0
Emb = 661

Exc = 0
Emb = 1519

6+00

C = 0
F = 0

C = 0
F = 338

2+05.14

Exc = 0
Emb = 630

4+00

RAMP "C"

Scale: Horiz. 1" = 10'
Vert. 1" = 10'

PLATE 3 - CROSS SECTION, F.A.S.
CLEARPRINT PAPER CO., S. F. CAL. NO. 1000H-3

172

FED. ROAD DIST. NO.	STATE	FED. AID PROJ. NO.	FISCAL YEAR	SHEET NO.	TOTAL SHEETS
HAWAII	HAW.	I-HI-1(65):10 I-HI-1(40):11	1969	173	185

FINAL SURVEY — NOTE BOOK NO. — SURVEYED — PLOTTED — TEMPLATE — AREAS — AREAS CHECKED — BY — DATE

ORIGINAL SURVEY — NOTE BOOK NO. — SURVEYED — PLOTTED — TEMPLATE — AREAS — AREAS CHECKED — BY — DATE

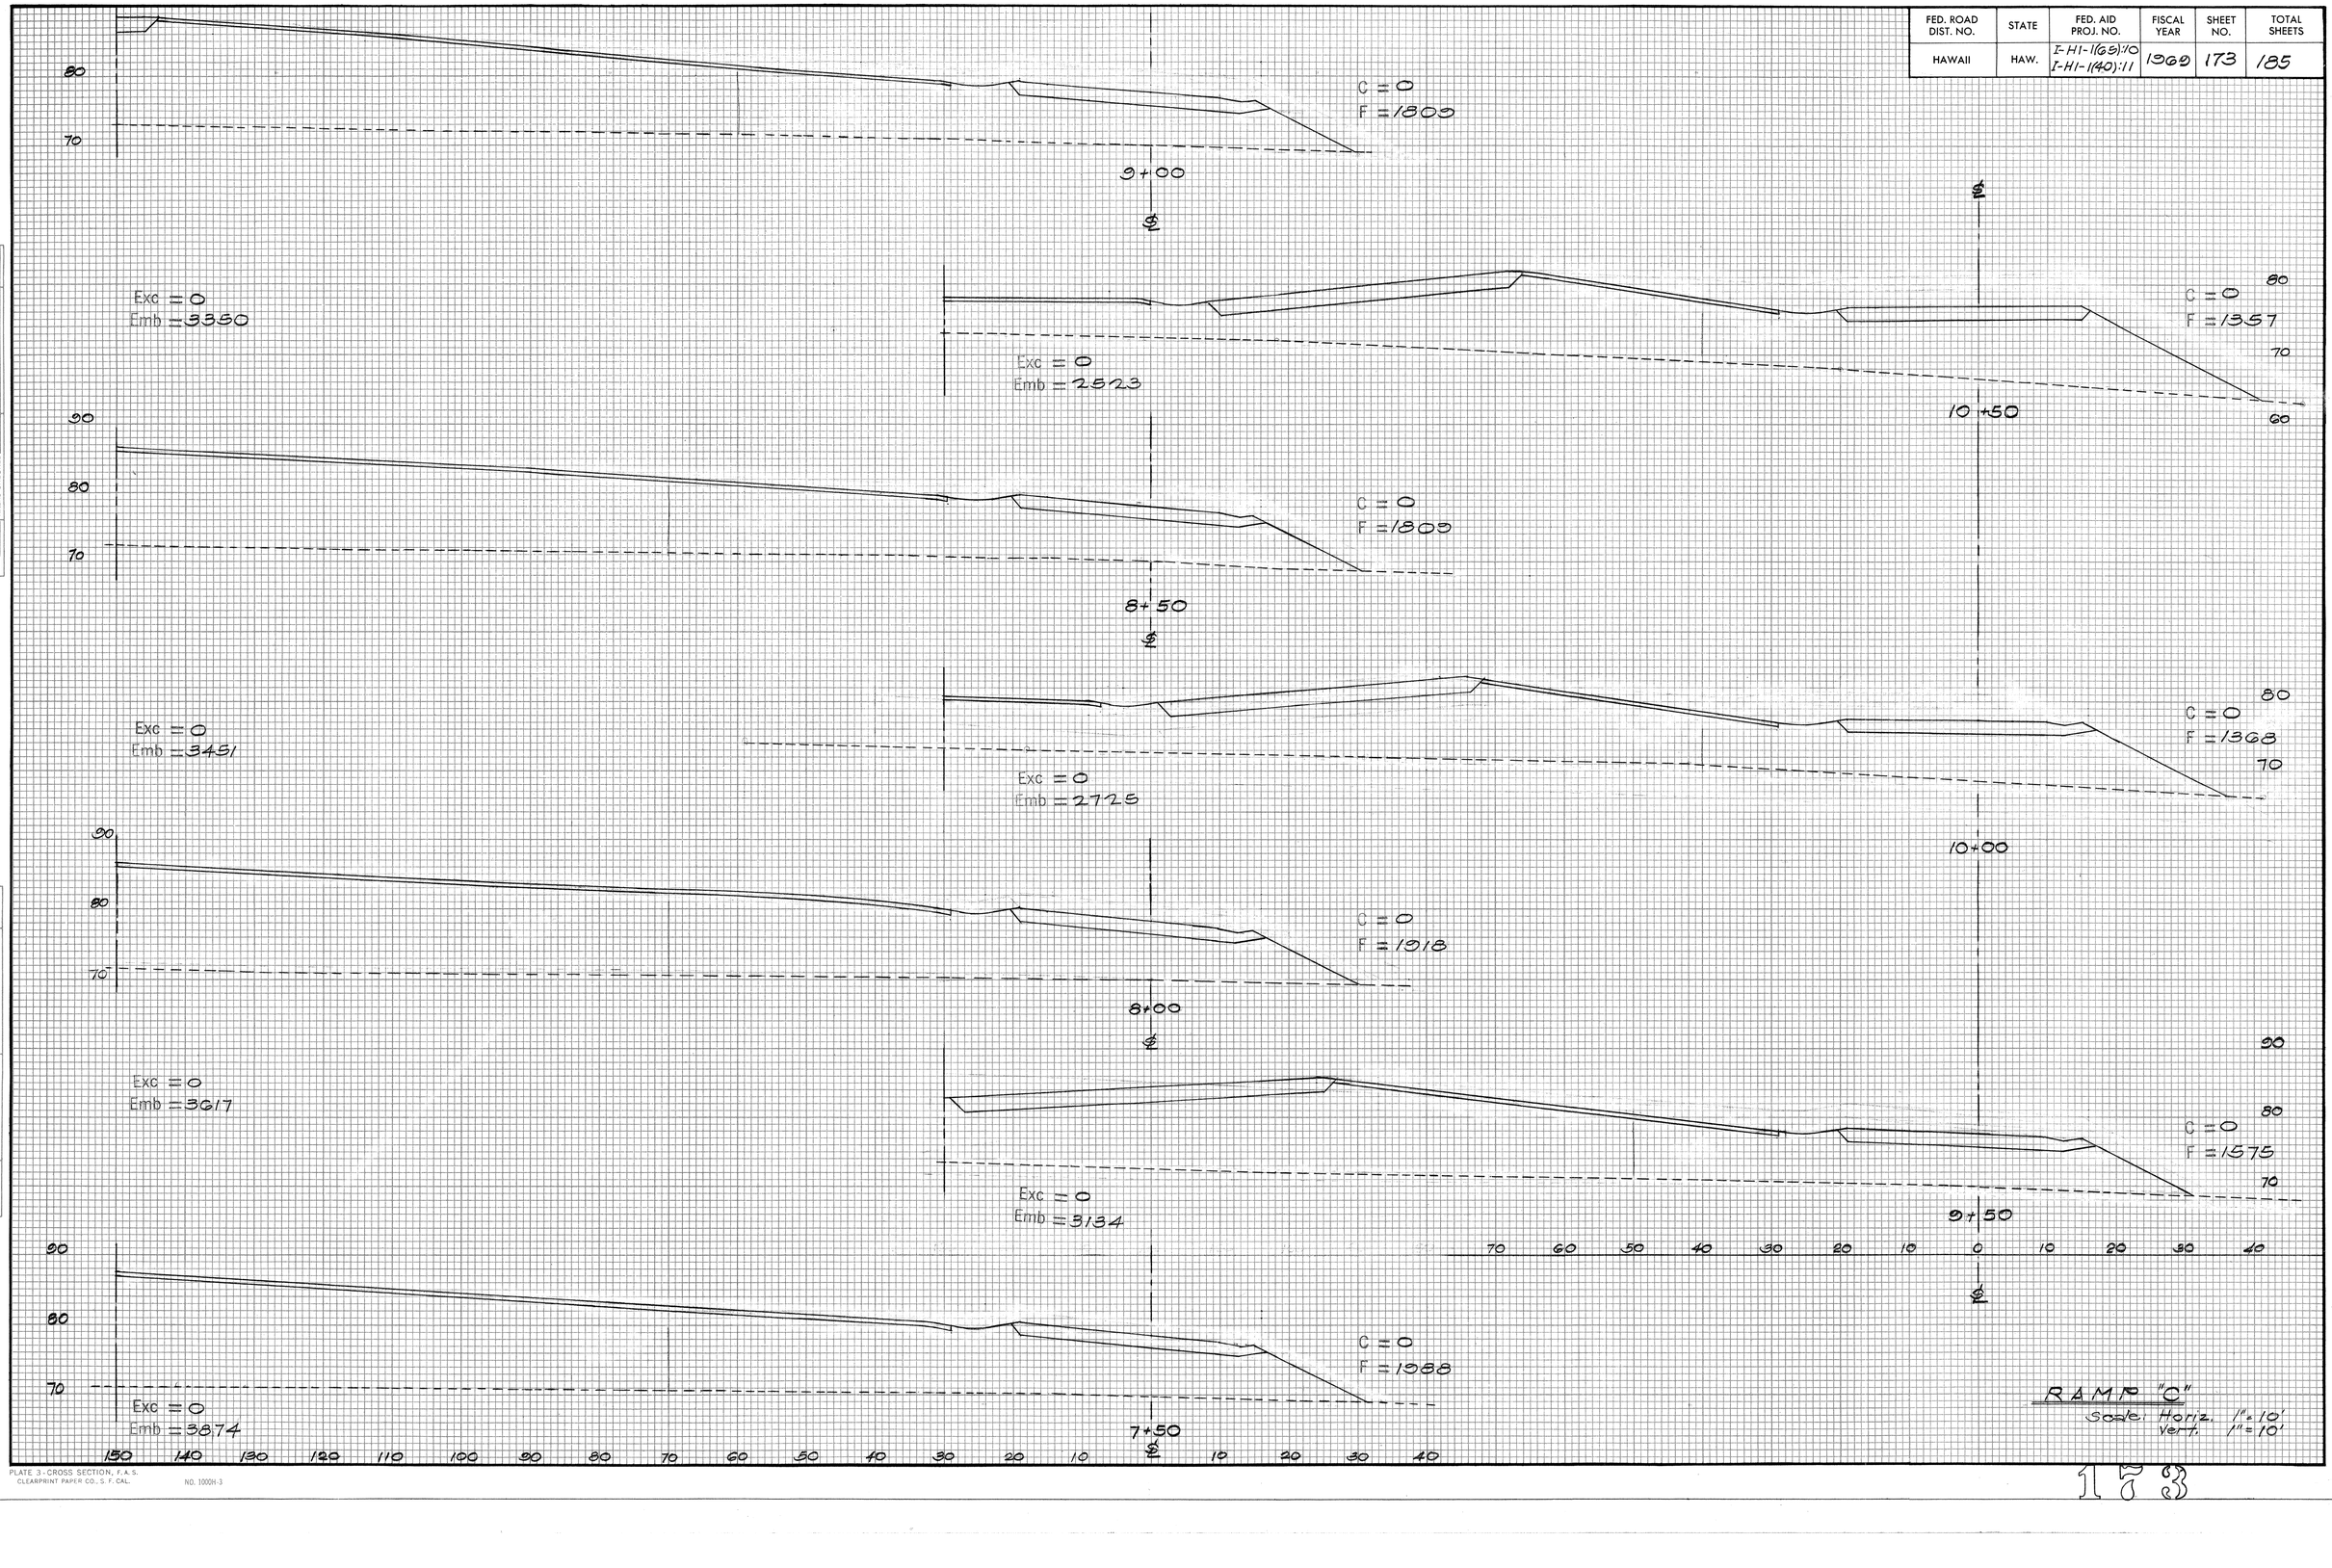

RAMP "C"

Scale: Horiz. 1" = 10'
Vert. 1" = 10'

PLATE 3 - CROSS SECTION, F.A.S.
CLEARPRINT PAPER CO., S. F. CAL. NO. 1000H-3

173

FED. ROAD DIST. NO.	STATE	FED. AID PROJ. NO.	FISCAL YEAR	SHEET NO.	TOTAL SHEETS
HAWAII	HAW.	I-HI-1(65):10 I-HI-1(40):11	1969	174	185

FINAL SURVEY — NOTE BOOK NO. — SURVEYED — PLOTTED — TEMPLATE — AREAS — AREAS CHECKED — BY — DATE

ORIGINAL SURVEY — NOTE BOOK NO. — SURVEYED — PLOTTED — TEMPLATE — AREAS — AREAS CHECKED — BY — DATE

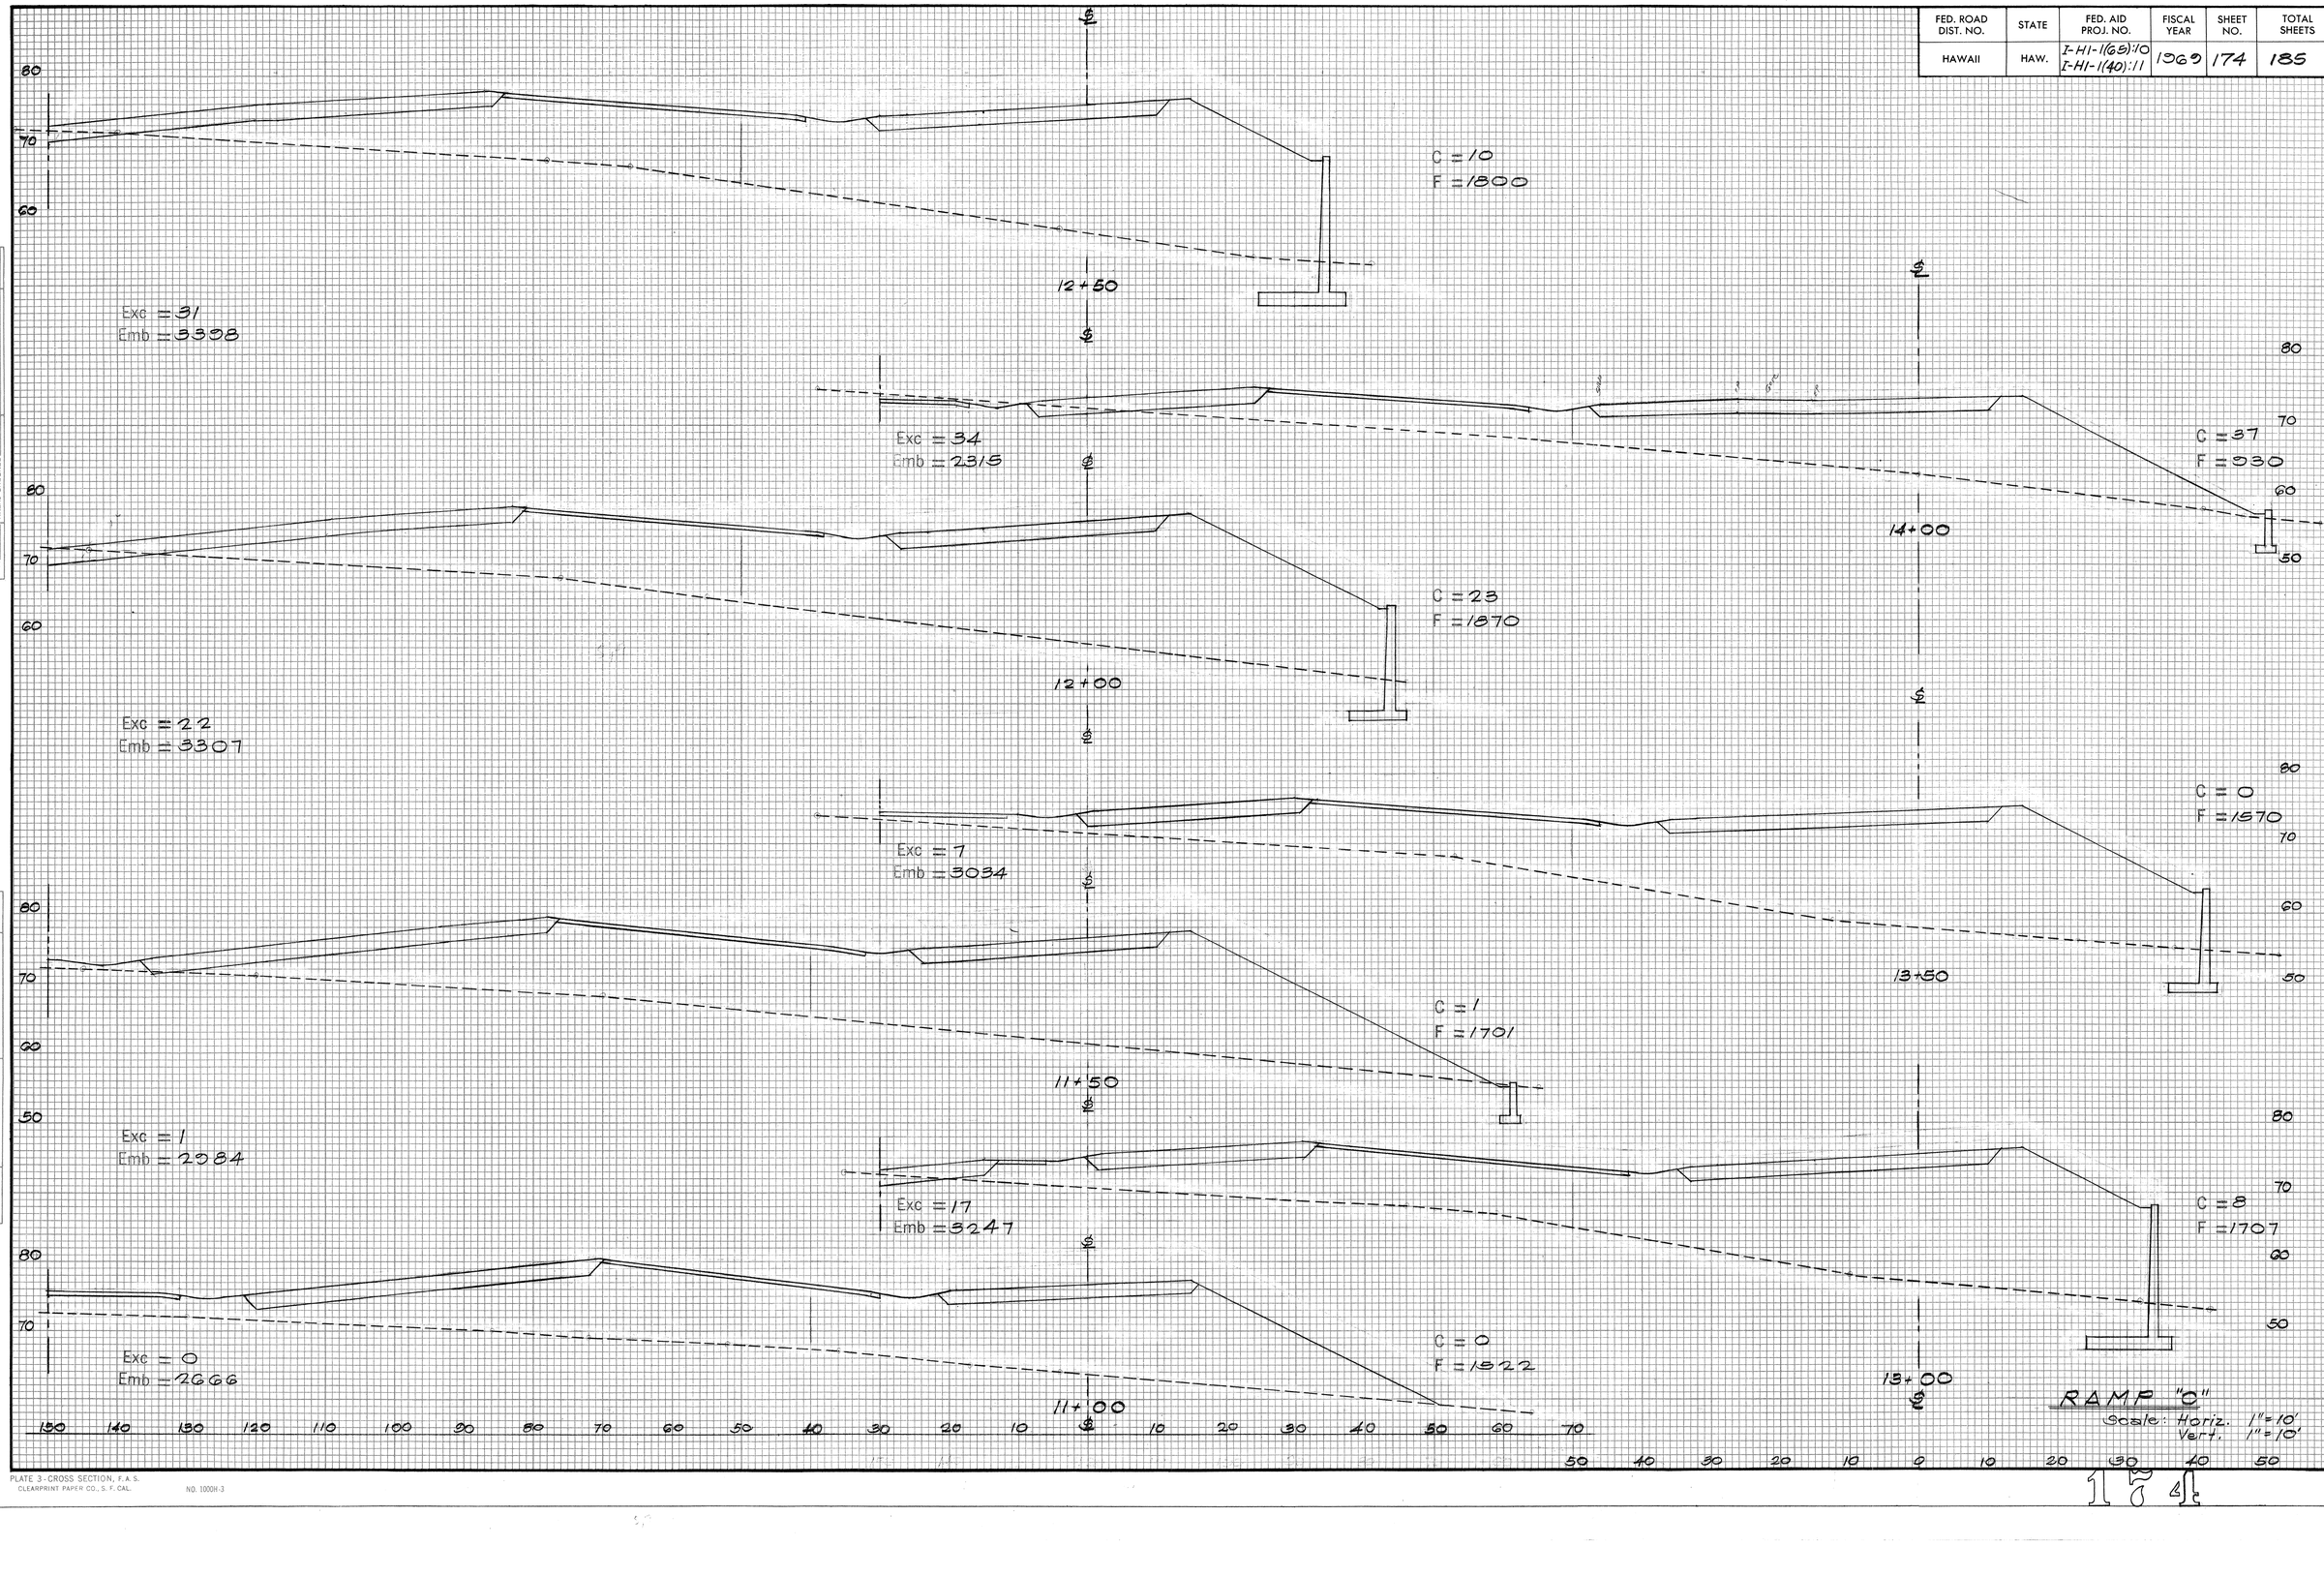

RAMP "O"
Scale: Horiz. 1"=10'
Vert. 1"=10'

PLATE 3 - CROSS SECTION, F. A. S.
CLEARPRINT PAPER CO., S. F. CAL. NO. 1000H-3

174

FED. ROAD DIST. NO.	STATE	FED. AID PROJ. NO.	FISCAL YEAR	SHEET NO.	TOTAL SHEETS
HAWAII	HAW.	I-HI-1(65):10 I-HI-1(40):11	1969	175	185

FINAL SURVEY — NOTE BOOK NO. — SURVEYED — PLOTTED — TEMPLATE — AREAS — AREAS CHECKED — BY — DATE

ORIGINAL SURVEY — NOTE BOOK NO. — SURVEYED — PLOTTED — TEMPLATE — AREAS — AREAS CHECKED — BY — DATE

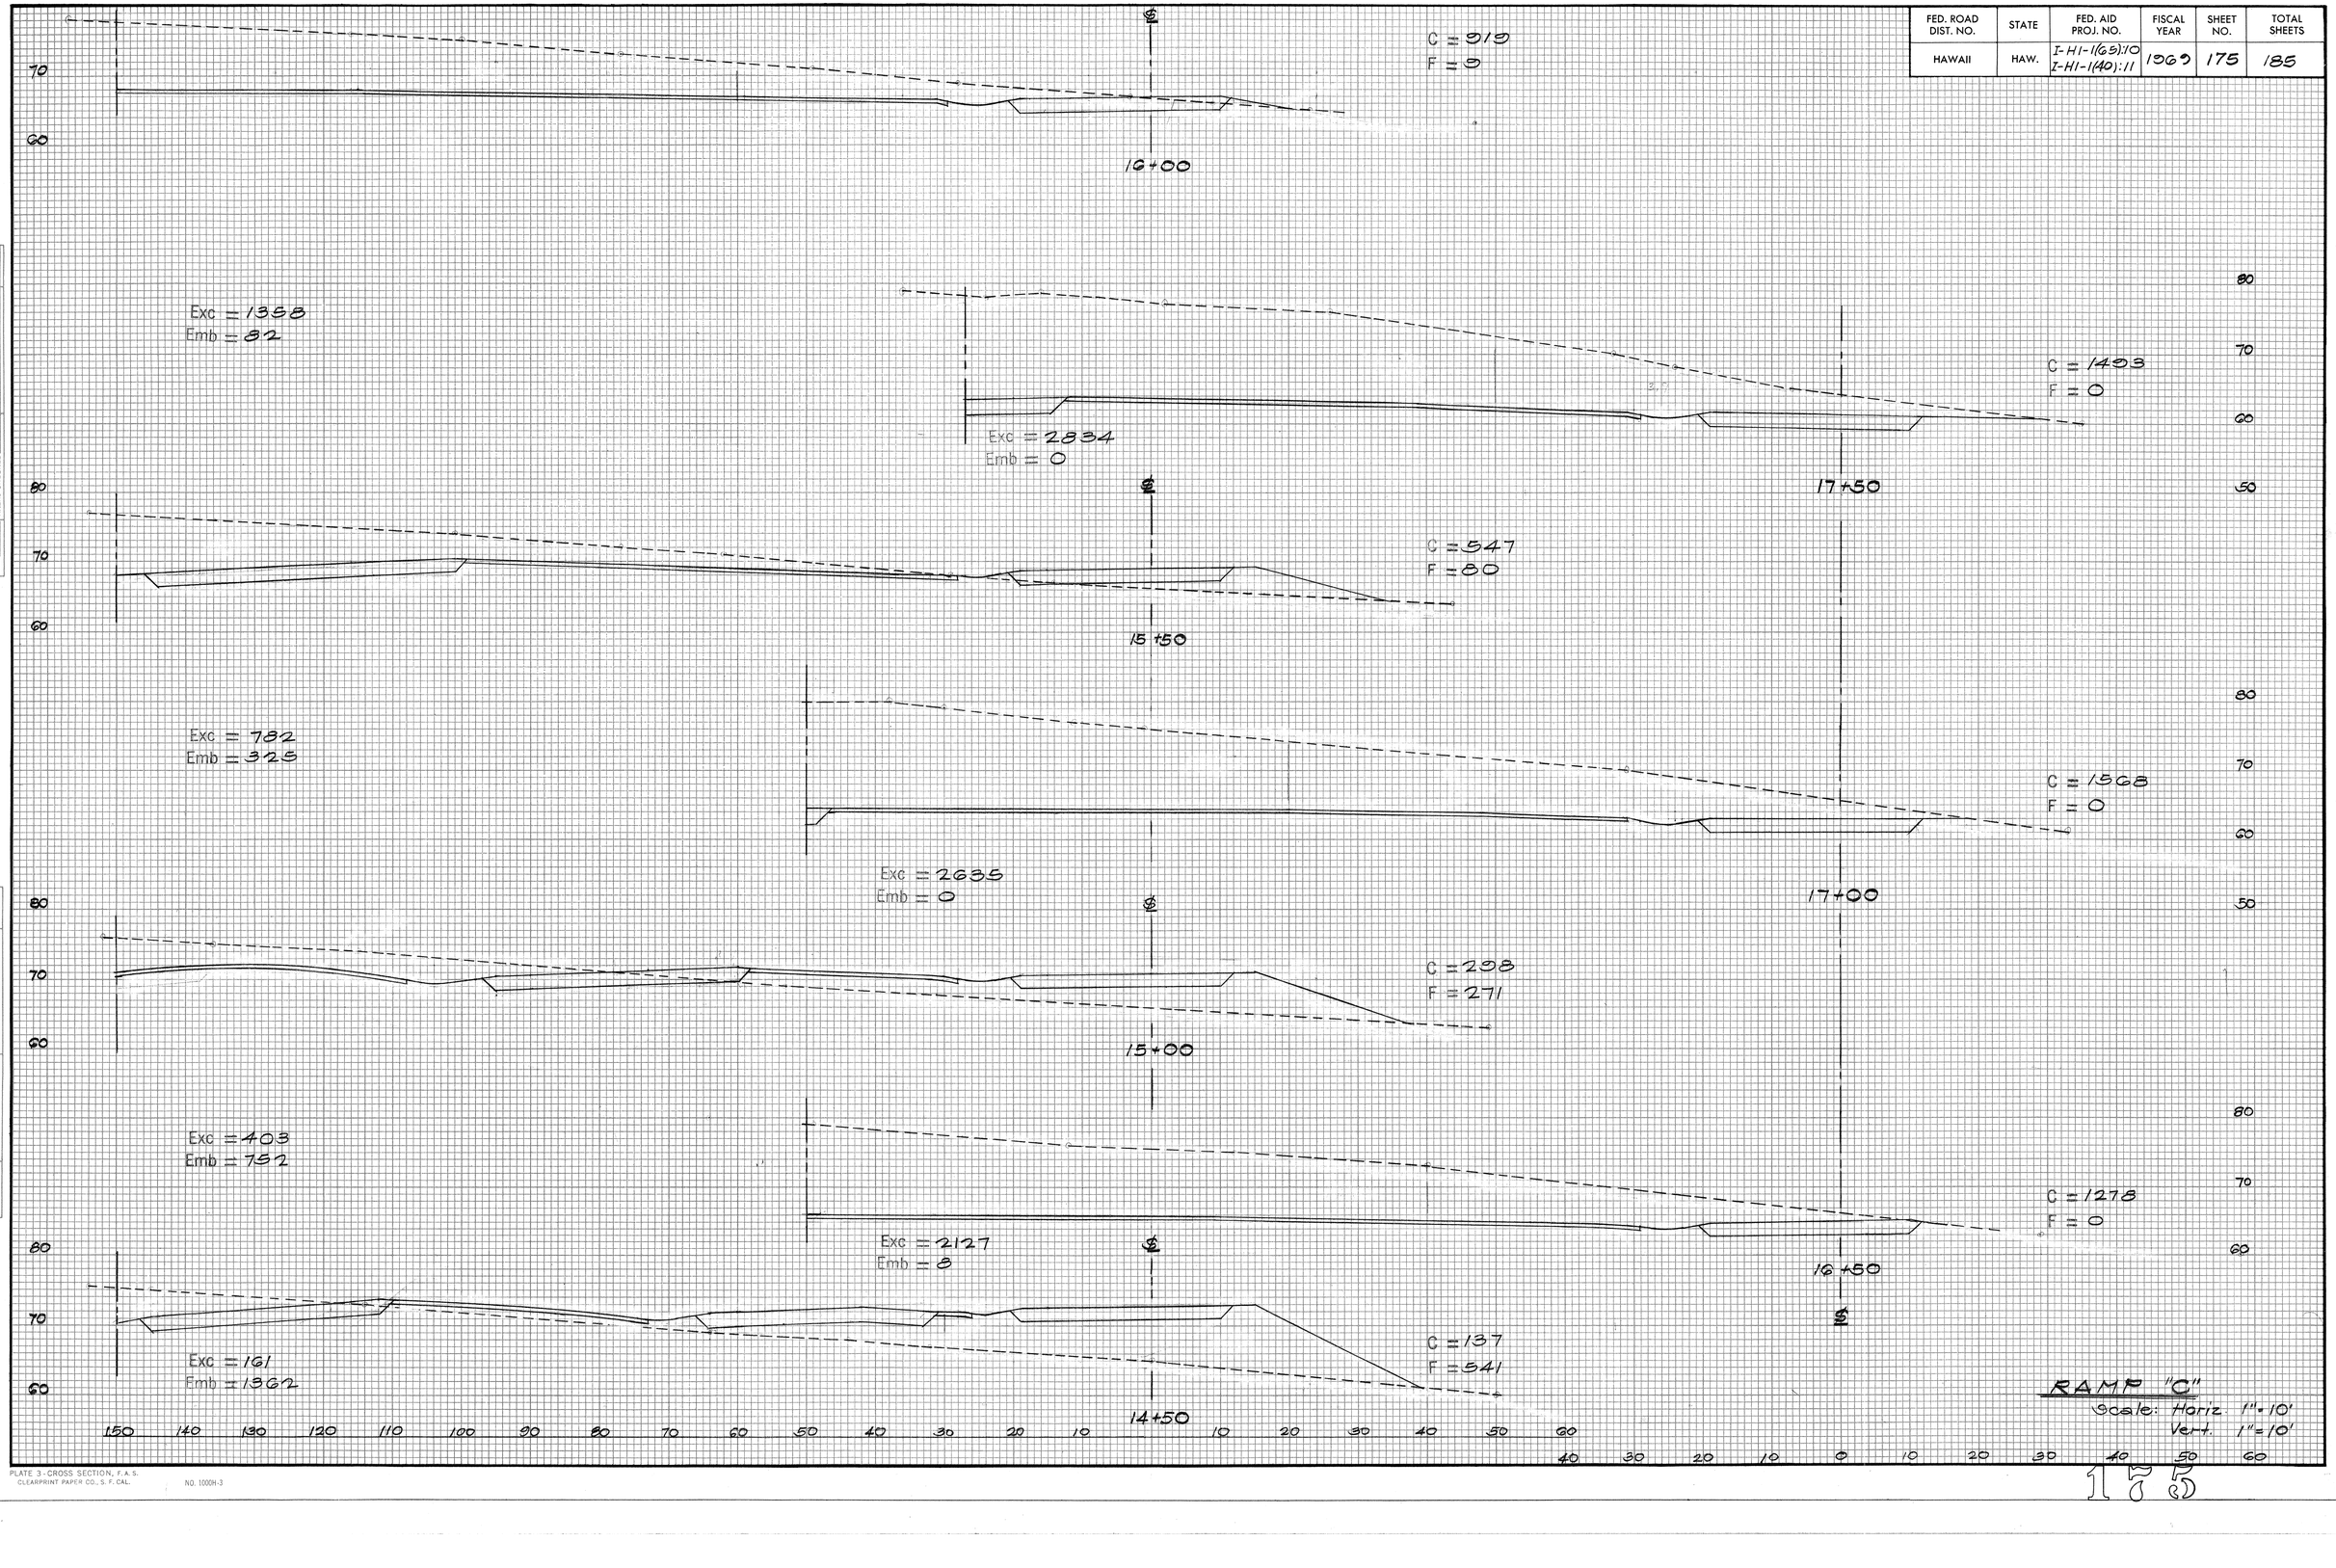

RAMP "C"
Scale: Horiz. 1"=10'
Vert. 1"=10'

PLATE 3 - CROSS SECTION, F. A. S.
CLEARPRINT PAPER CO., S. F. CAL.
NO. 1000H-3

175

FED. ROAD DIST. NO.	STATE	FED. AID PROJ. NO.	FISCAL YEAR	SHEET NO.	TOTAL SHEETS
HAWAII	HAW.	I-HI-1(65):10 I-HI-1(40):11	1960	176	185

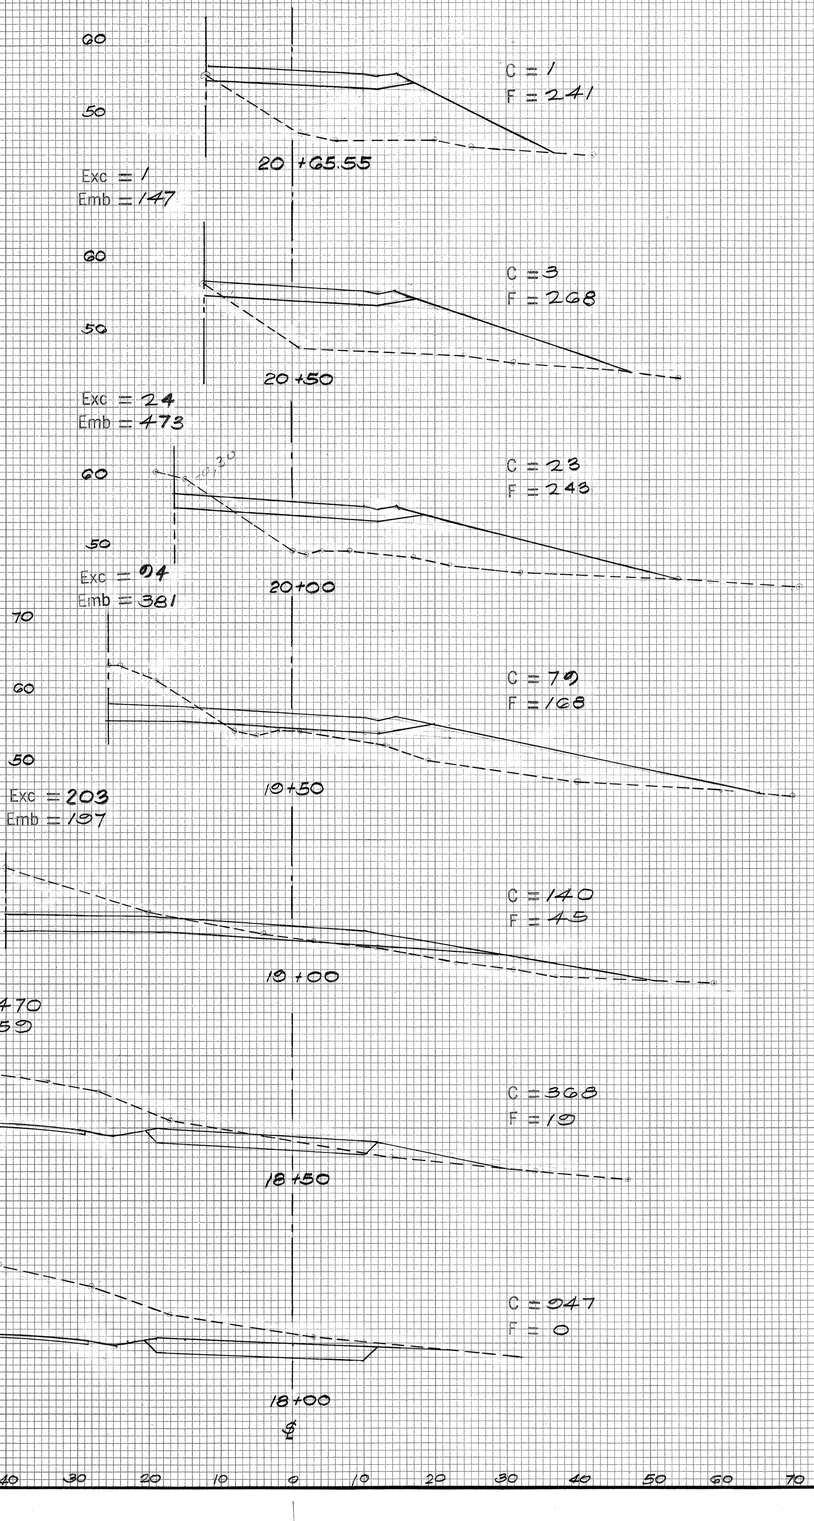

RAMP "O"

Scale: Horiz. 1"=10'
Vert. 1"=10'

FINAL SURVEY	SURVEYED	BY	DATE
NOTE BOOK	PLOTTED		
NO.	TEMPLATE		
	AREAS		
	AREAS CHECKED		

ORIGINAL SURVEY	SURVEYED	BY	DATE
NOTE BOOK	PLOTTED		
NO.	TEMPLATE		
	AREAS		
	AREAS CHECKED		

PLATE 3-CROSS SECTION, F.A.S.
CLEARPRINT PAPER CO., S. F. CAL. NO. 1000H-3

FED. ROAD DIST. NO.	STATE	FED. AID PROJ. NO.	FISCAL YEAR	SHEET NO.	TOTAL SHEETS
HAWAII	HAW.	I-HI-1(65):10 I-HI-1(40):11	1969	177	185

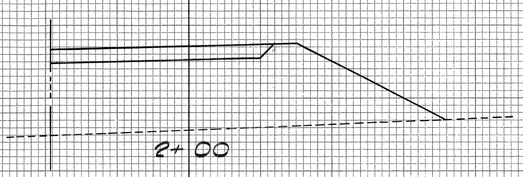

C = 0
F = 463

Exc = 0
Emb = 787

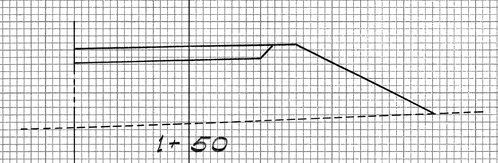

C = 0
F = 387

Exc = 0
Emb = 693

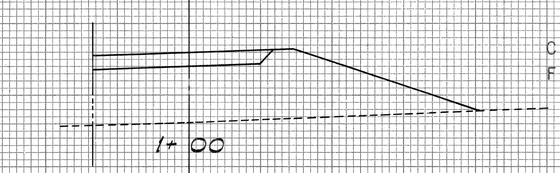

C = 0
F = 361

Exc = 0
Emb = 633

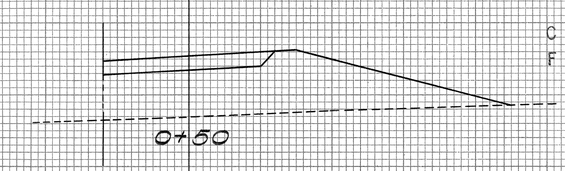

C = 0
F = 323

Exc = 0
Emb = 503

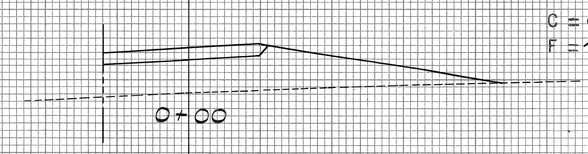

C = 0
F = 220

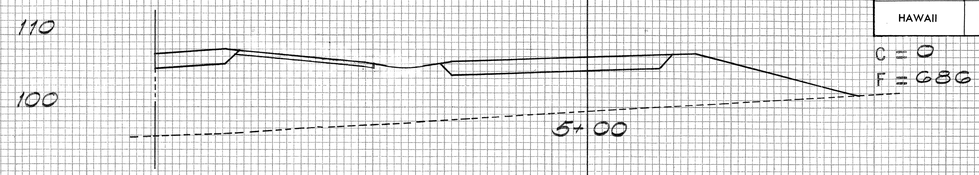

C = 0
F = 686

Exc = 0
Emb = 1307

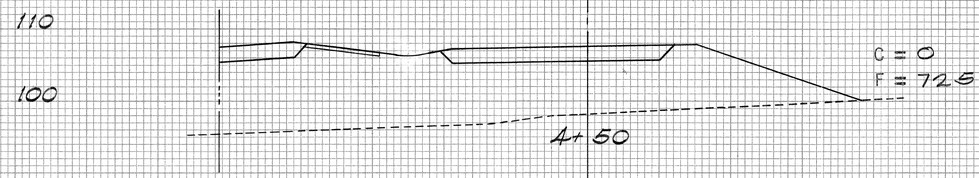

C = 0
F = 725

Exc = 0
Emb = 1341

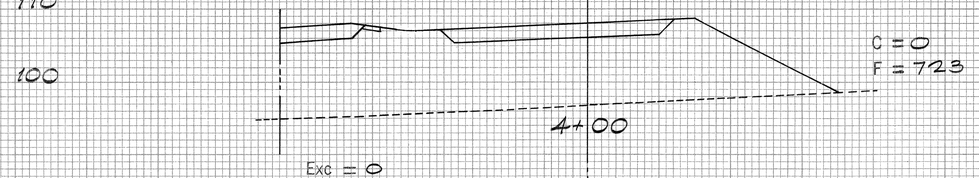

C = 0
F = 723

Exc = 0
Emb = 1205

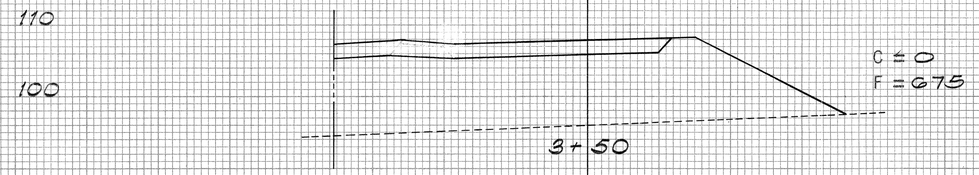

C = 0
F = 675

Exc = 0
Emb = 1207

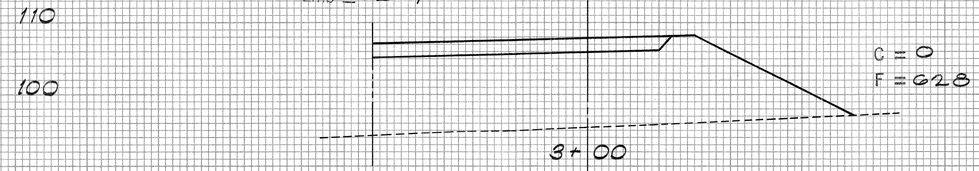

C = 0
F = 628

Exc = 0
Emb = 1085

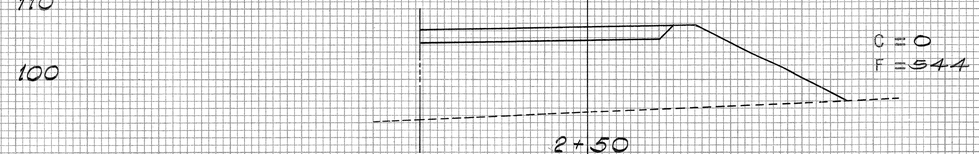

C = 0
F = 544

Exc = 0
Emb = 932

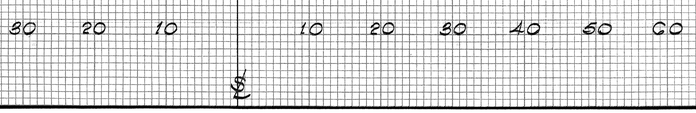

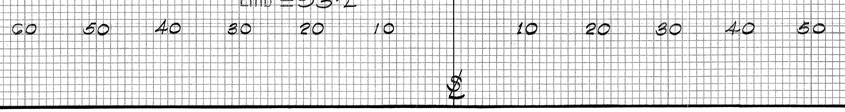

RAMP "E"
Scale: Horiz. 1"=10'
Vert. 1"=10'

FINAL SURVEY
NOTE BOOK
NO.
SURVEYED
PLOTTED
TRACED
AREAS
AREAS CHECKED
BY
DATE

ORIGINAL SURVEY
NOTE BOOK
NO.
SURVEYED
PLOTTED
TRACED
AREAS
AREAS CHECKED
BY
DATE

PLATE 3 - CROSS SECTION, F.A.S.
CLEARPRINT PAPER CO., S. F. CAL.
NO. 1000H-3

FED. ROAD DIST. NO.	STATE	FED. AID PROJ. NO.	FISCAL YEAR	SHEET NO.	TOTAL SHEETS
HAWAII	HAW.	I-HI-1(69):10 I-HI-1(40):11	1969	178	185

ORIGINAL SURVEY	BY	DATE
NOTE BOOK		
NO.		

SURVEYED
PLOTTED
FINAL ATE
AREAS
AREAS CHECKED

C = 2360
F = 0

120
110
100

7+50

Exc = 3369
Emb = 0

C = 1278
F = 0

120
110
100

7+00

Exc = 1934
Emb = 0

C = 811
F = 93

110
100

6+50

Exc = 867
Emb = 381

C = 125
F = 312

110
100

6+00

Exc = 116
Emb = 823

C = 0
F = 577

110
100

5+50

Exc = 0
Emb = 1170

℄

120 110 100 90 80 70 60 50 40 30 20 10 0 10 20 30 40 50 60 70 80 90 100 110 120

RAMP "E"

Scale: Horiz. 1"=10'
Vert. 1"=10'

PLATE 3-CROSS SECTION, F.A.S.
CLEARPRINT PAPER CO., S. F. CAL. NO. 1000H-3

178

FED. ROAD DIST. NO.	STATE	FED. AID PROJ. NO.	FISCAL YEAR	SHEET NO.	TOTAL SHEETS
HAWAII	HAW.	I-HI-1(63):10 I-HI-1(40):11	1969	179	185

FINAL SURVEY — NOTE BOOK NO. — SURVEYED, PLOTTED, TEMPLATE, AREAS, AREAS CHECKED — BY — DATE

ORIGINAL SURVEY — NOTE BOOK NO. — SURVEYED, PLOTTED, TEMPLATE, AREAS, AREAS CHECKED — BY — DATE

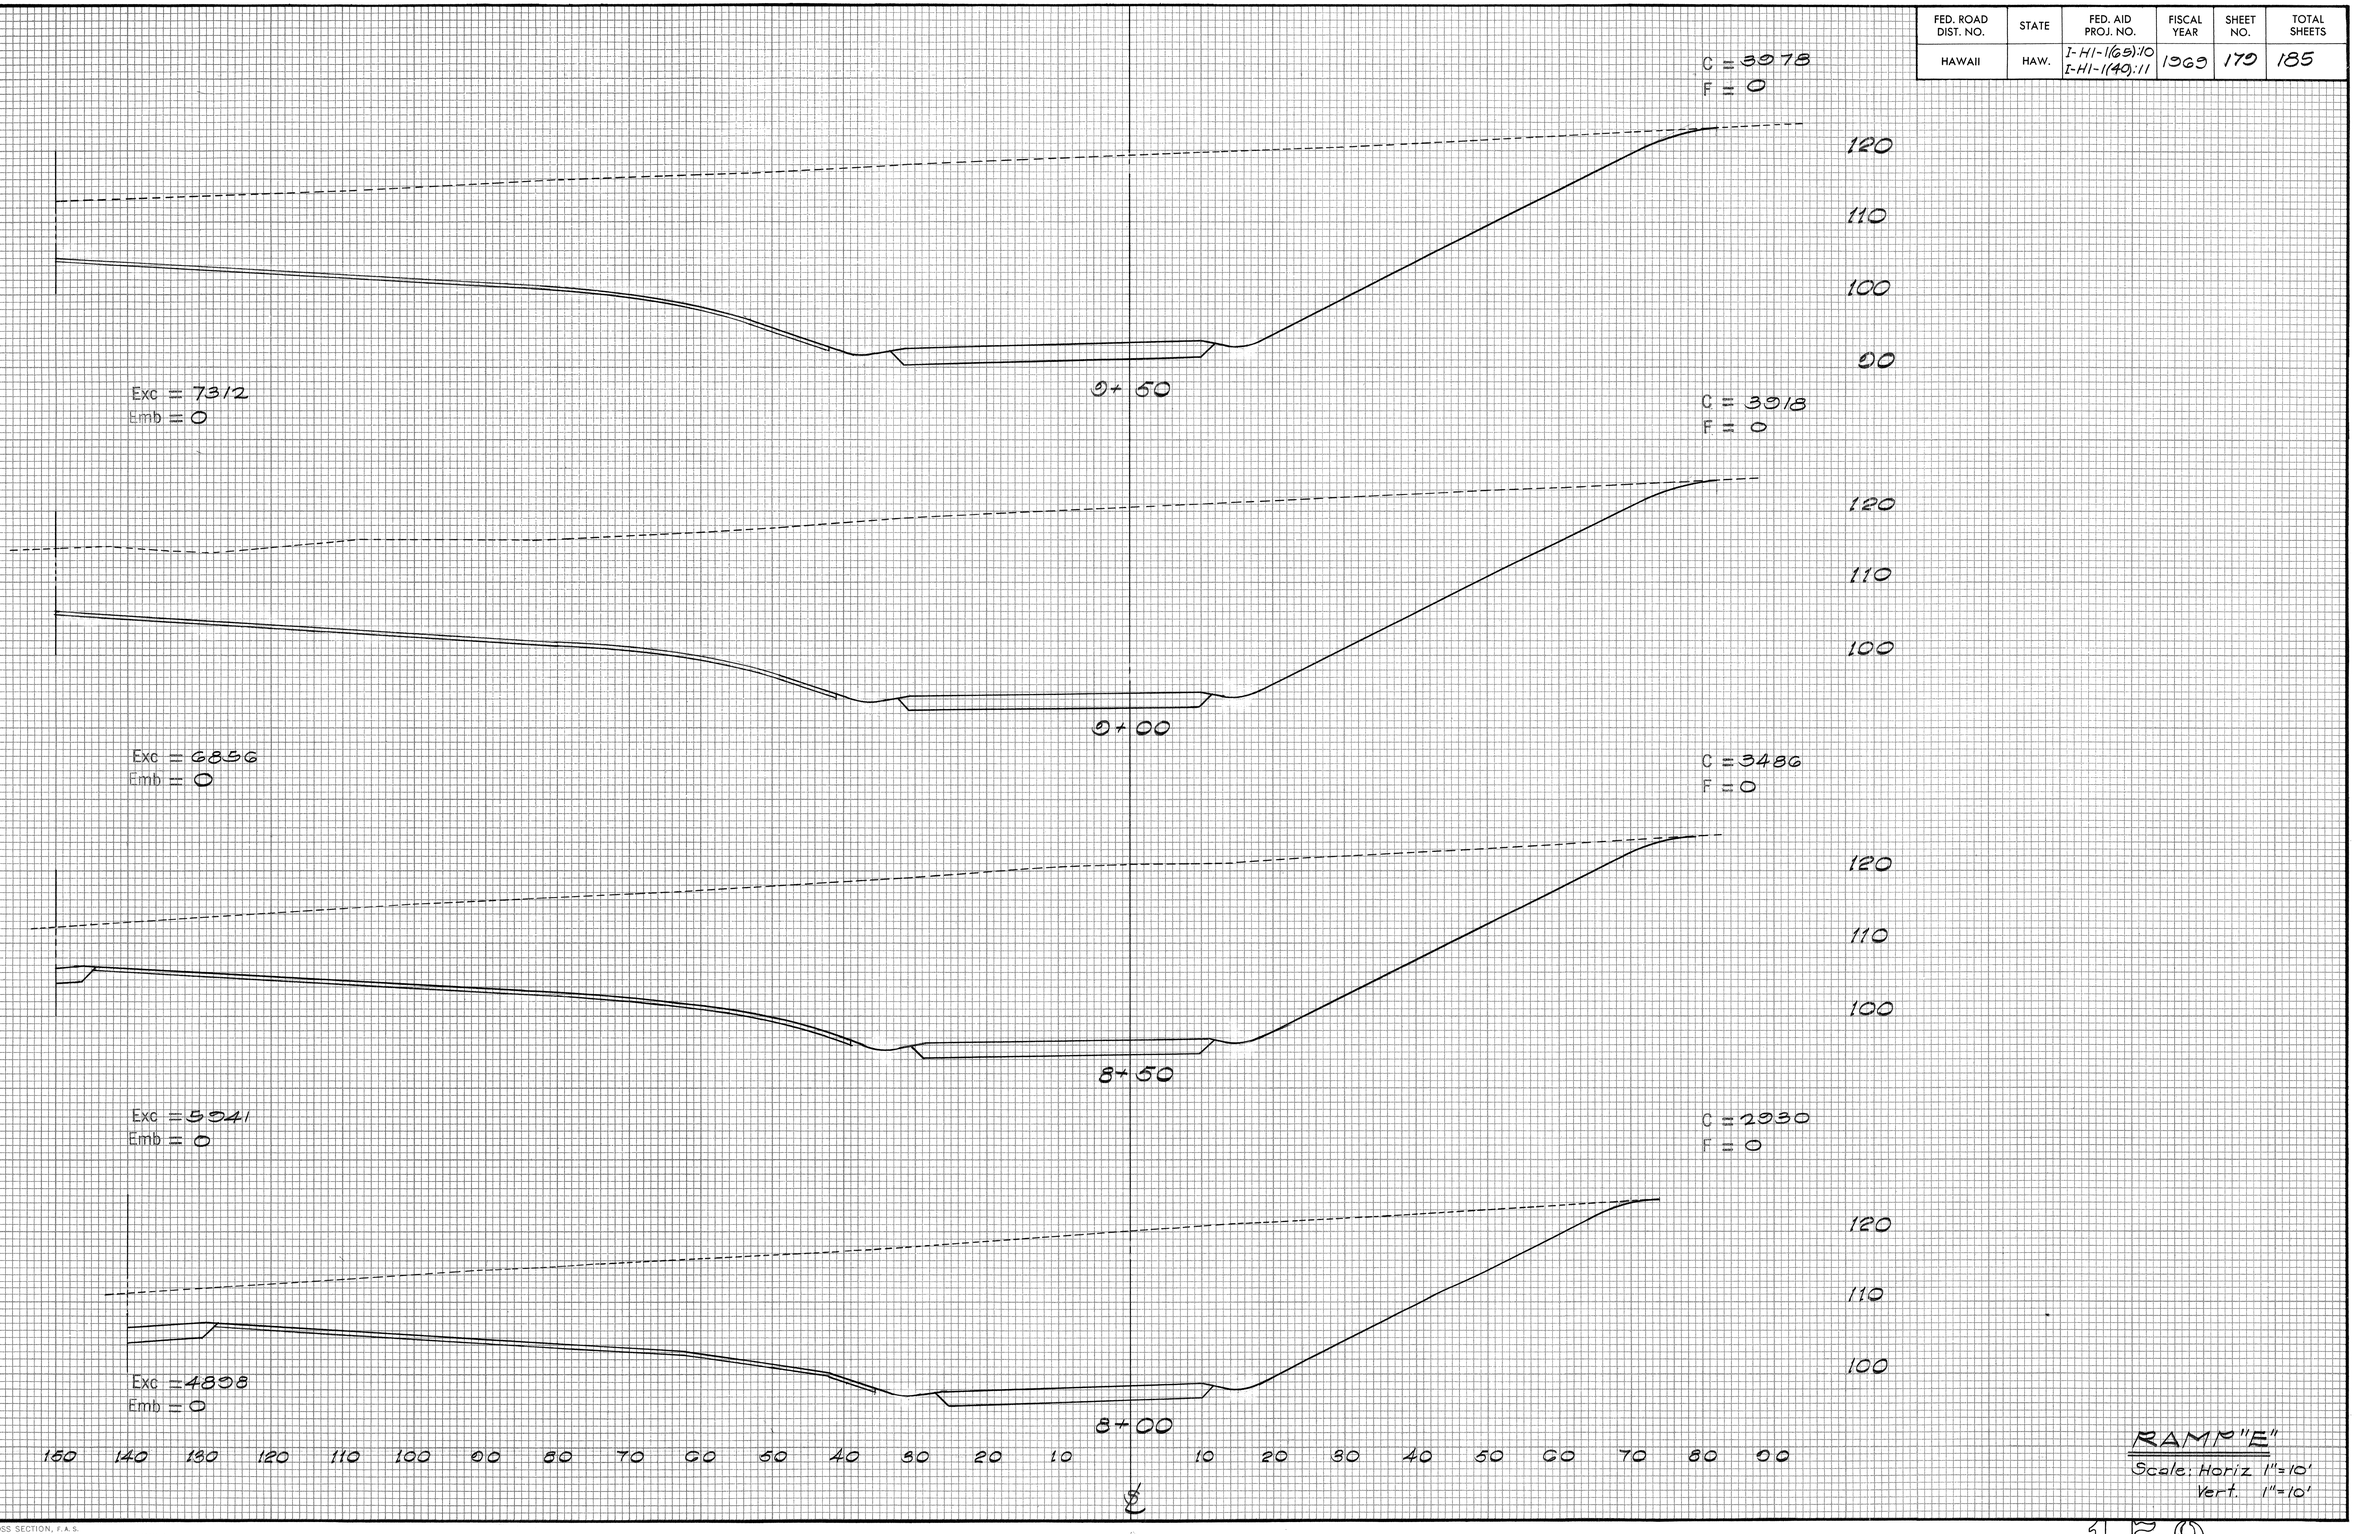

RAMP "E"
Scale: Horiz. 1"=10'
Vert. 1"=10'

PLATE 3 - CROSS SECTION, F.A.S.
CLEARPRINT PAPER CO., S. F. CAL.
NO. 1000H-3

FED. ROAD DIST. NO.	STATE	FED. AID PROJ. NO.	FISCAL YEAR	SHEET NO.	TOTAL SHEETS
HAWAII	HAW.	I-HI-1(65):10 I-HI-1(40):11	1969	180	185

FINAL SURVEY — NOTE BOOK NO. — SURVEYED — PLOTTED — TEMPLATE — AREAS — AREAS CHECKED — BY — DATE

ORIGINAL SURVEY — NOTE BOOK NO. — SURVEYED — PLOTTED — TEMPLATE — AREAS — AREAS CHECKED — BY — DATE

C = 3688
F = 0

110
100
90

11+50

Exc = 6029
Emb = 0

C = 3795
F = 0

120
110
100
90

11+00

Exc = 7062
Emb = 0

C = 3831
F = 0

120
110
100
90

10+50

Exc = 7256
Emb = 0

C = 4005
F = 0

120
110
100
90

10+00

Exc = 7592
Emb = 0

150 140 130 120 110 100 90 80 70 60 50 40 30 20 10 0 10 20 30 40 50 60 70 80 90 100 110

RAMP "E"

Scale: Horiz. 1"=10'
Vert. 1"=10'

PLATE 3 - CROSS SECTION, F.A.S.
CLEARPRINT PAPER CO., S. F., CAL. NO. 1000H-3

180

FED. ROAD DIST. NO.	STATE	FED. AID PROJ. NO.	FISCAL YEAR	SHEET NO.	TOTAL SHEETS
HAWAII	HAW.	I-HI-1(69):10 I-HI-1(40):11	1969	181	185

FINAL SURVEY — NOTE BOOK NO. — SURVEYED — PLOTTED — TEMPLATE — AREAS — AREAS CHECKED — BY — DATE

ORIGINAL SURVEY — NOTE BOOK NO. — SURVEYED — PLOTTED — TEMPLATE — AREAS — AREAS CHECKED — BY — DATE

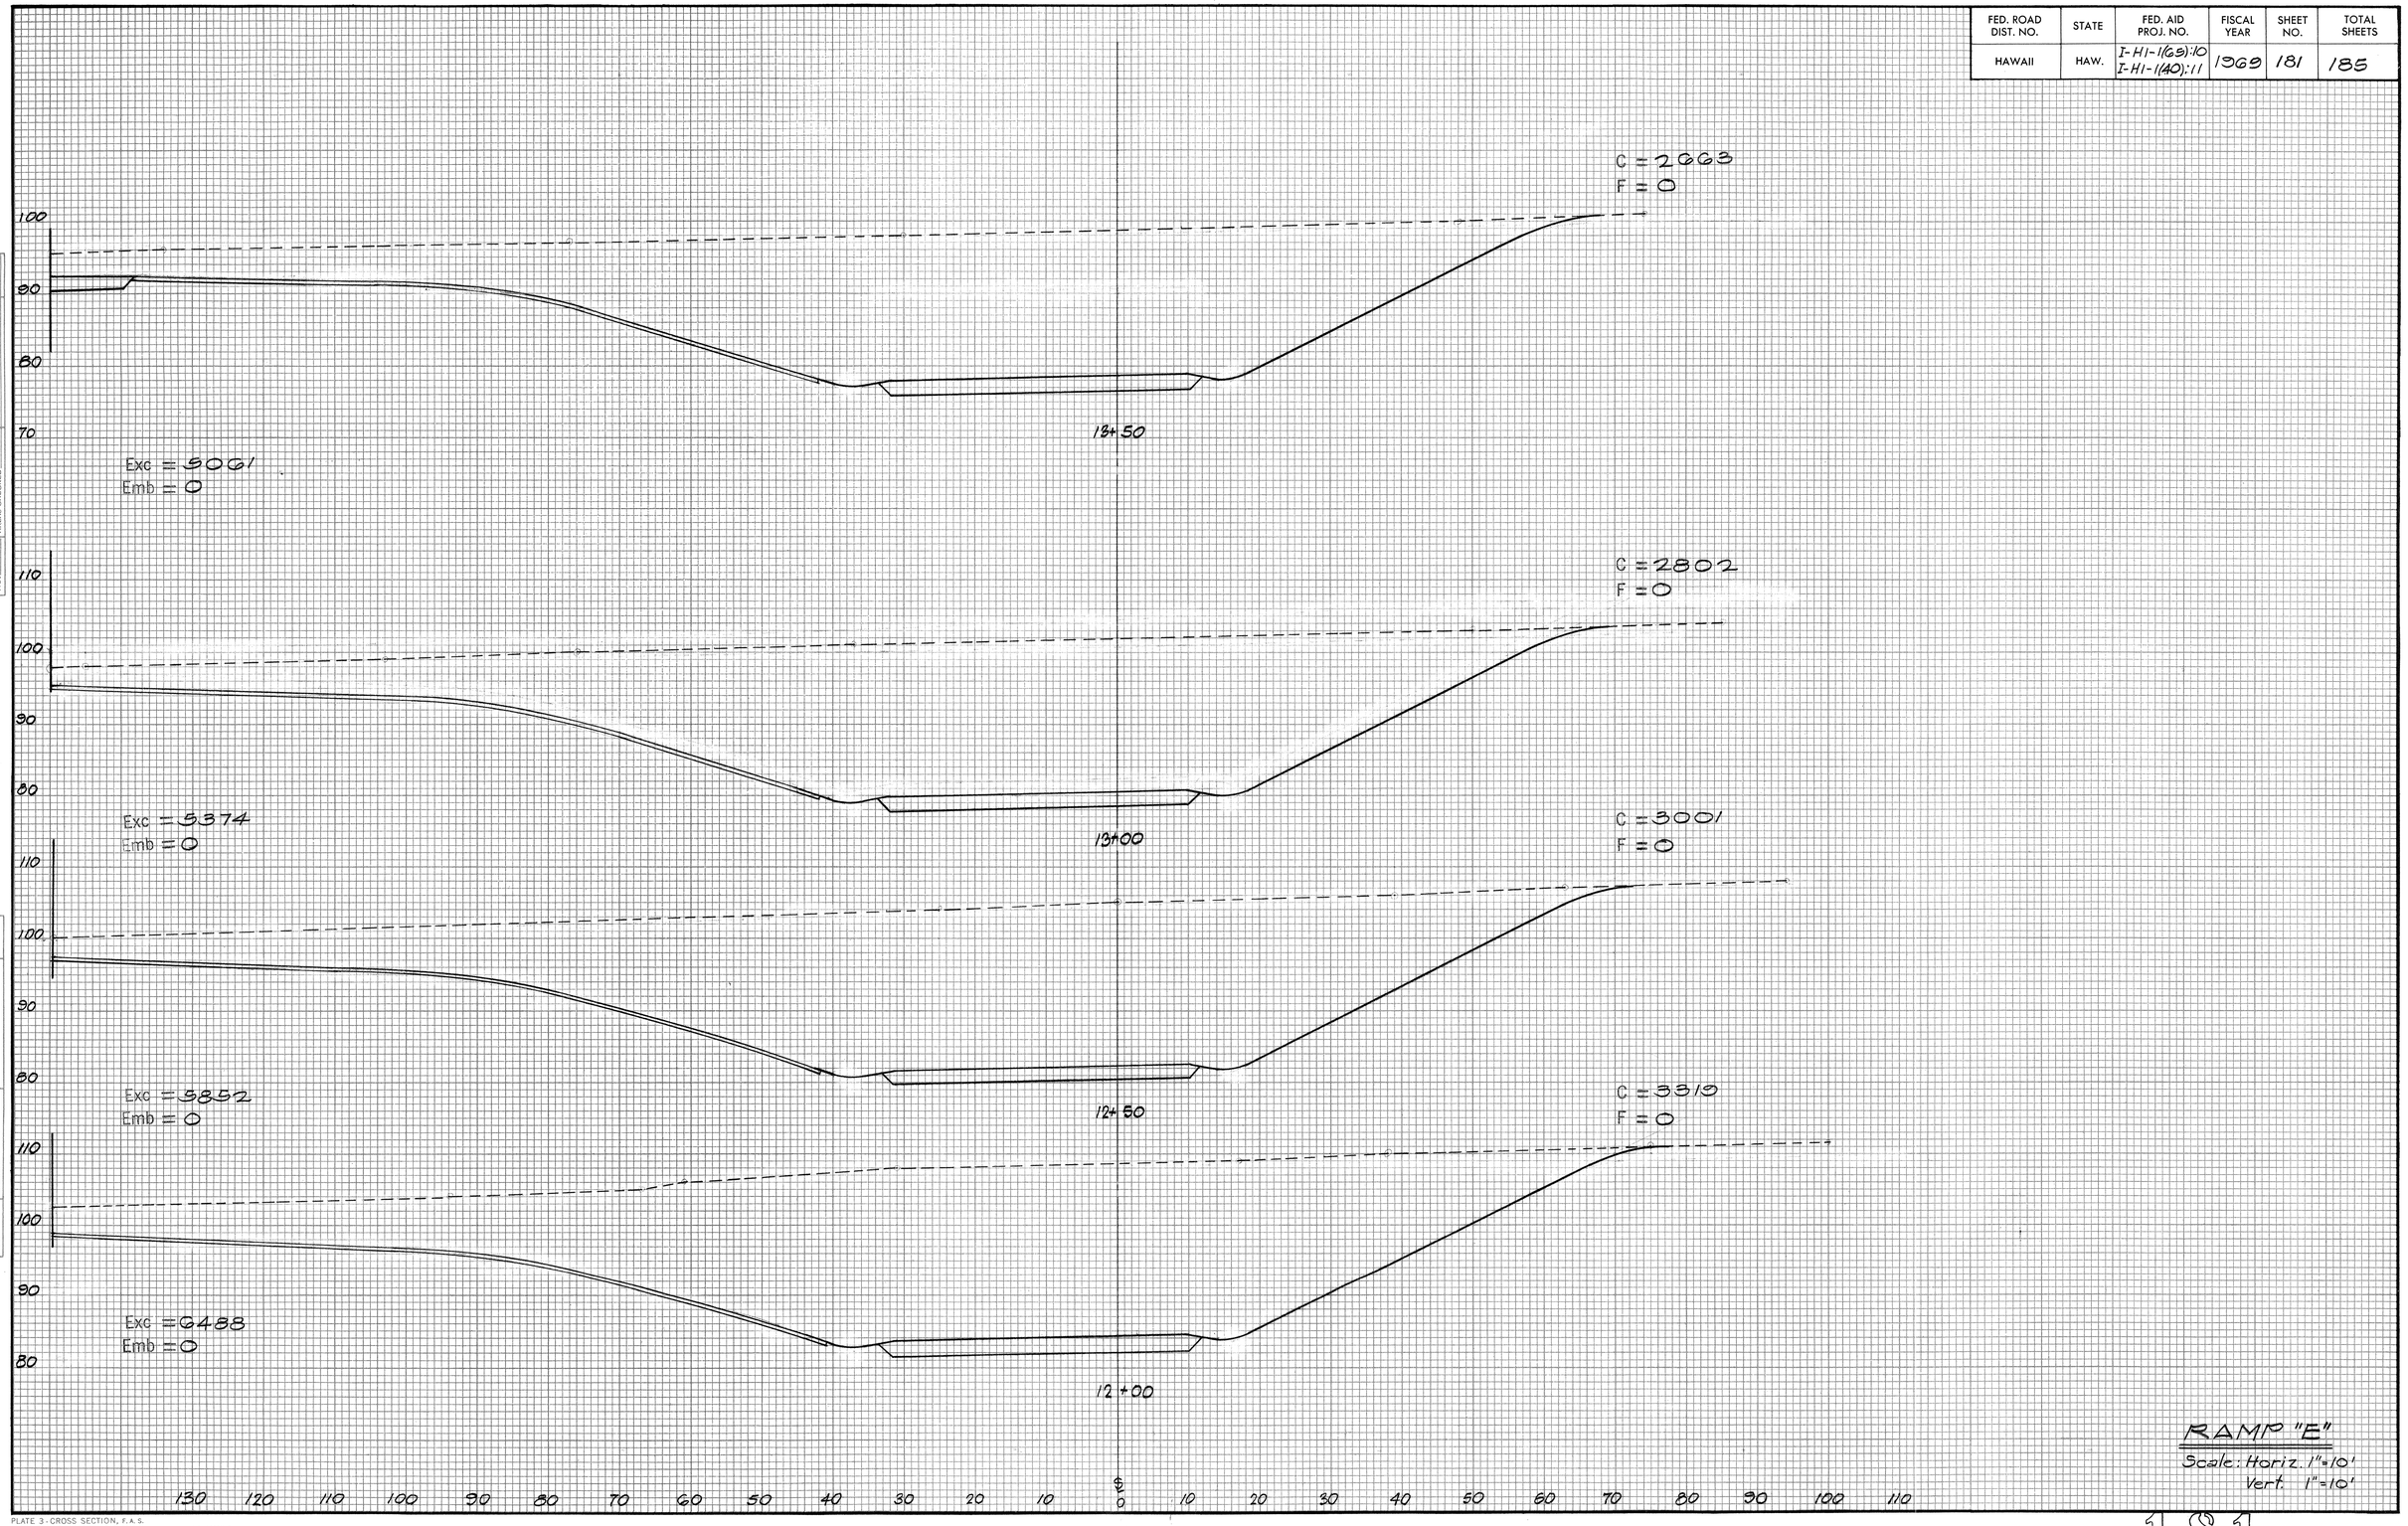

RAMP "E"

Scale: Horiz. 1"=10'
Vert. 1"=10'

PLATE 3 - CROSS SECTION, F. A. S.
CLEARPRINT PAPER CO., S. F. CAL. NO. 1000H-3

FED. ROAD DIST. NO.	STATE	FED. AID PROJ. NO.	FISCAL YEAR	SHEET NO.	TOTAL SHEETS
HAWAII	HAW.	I-HI-1(65):10 I-HI-1(40):11	1969	182	185

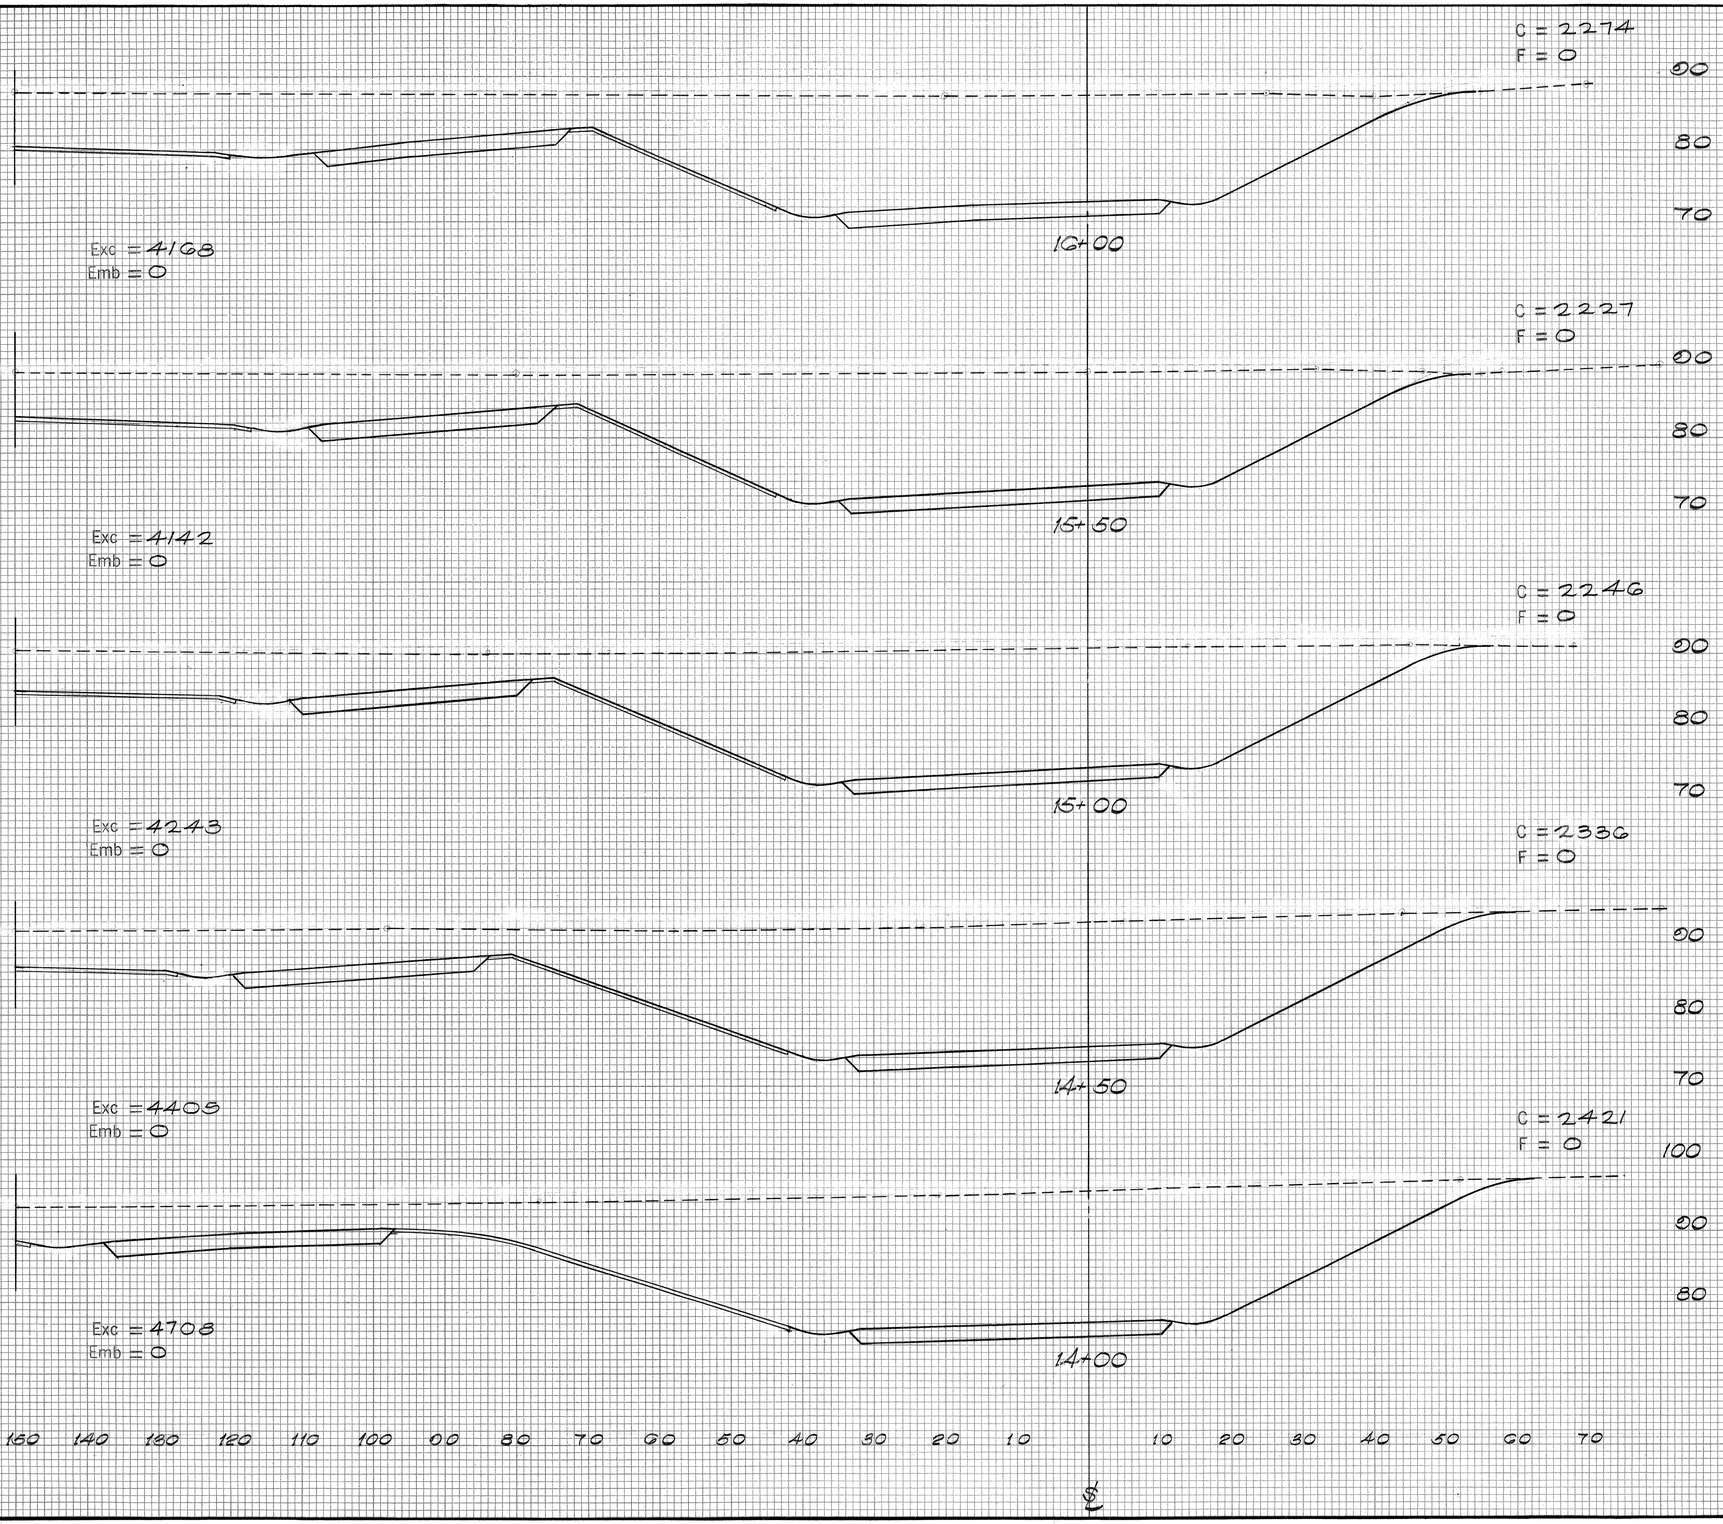

RAMP "E"
Scale: Horiz. 1"=10'
Vert. 1"=10'

182

PLATE 3-CROSS SECTION, F. A. S.
CLEARPRINT PAPER CO., S. F. CAL. NO. 1000H-3

FED. ROAD DIST. NO.	STATE	FED. AID PROJ. NO.	FISCAL YEAR	SHEET NO.	TOTAL SHEETS
HAWAII	HAW.	I-HI-1(65):10 I-HI-1(40):11	1969	183	185

FINAL SURVEY — NOTE BOOK — NO. — SURVEYED — PLOTTED — TEMPLATE — AREAS — AREAS CHECKED — BY — DATE

ORIGINAL SURVEY — NOTE BOOK — NO. — SURVEYED — PLOTTED — TEMPLATE — AREAS — AREAS CHECKED — BY — DATE

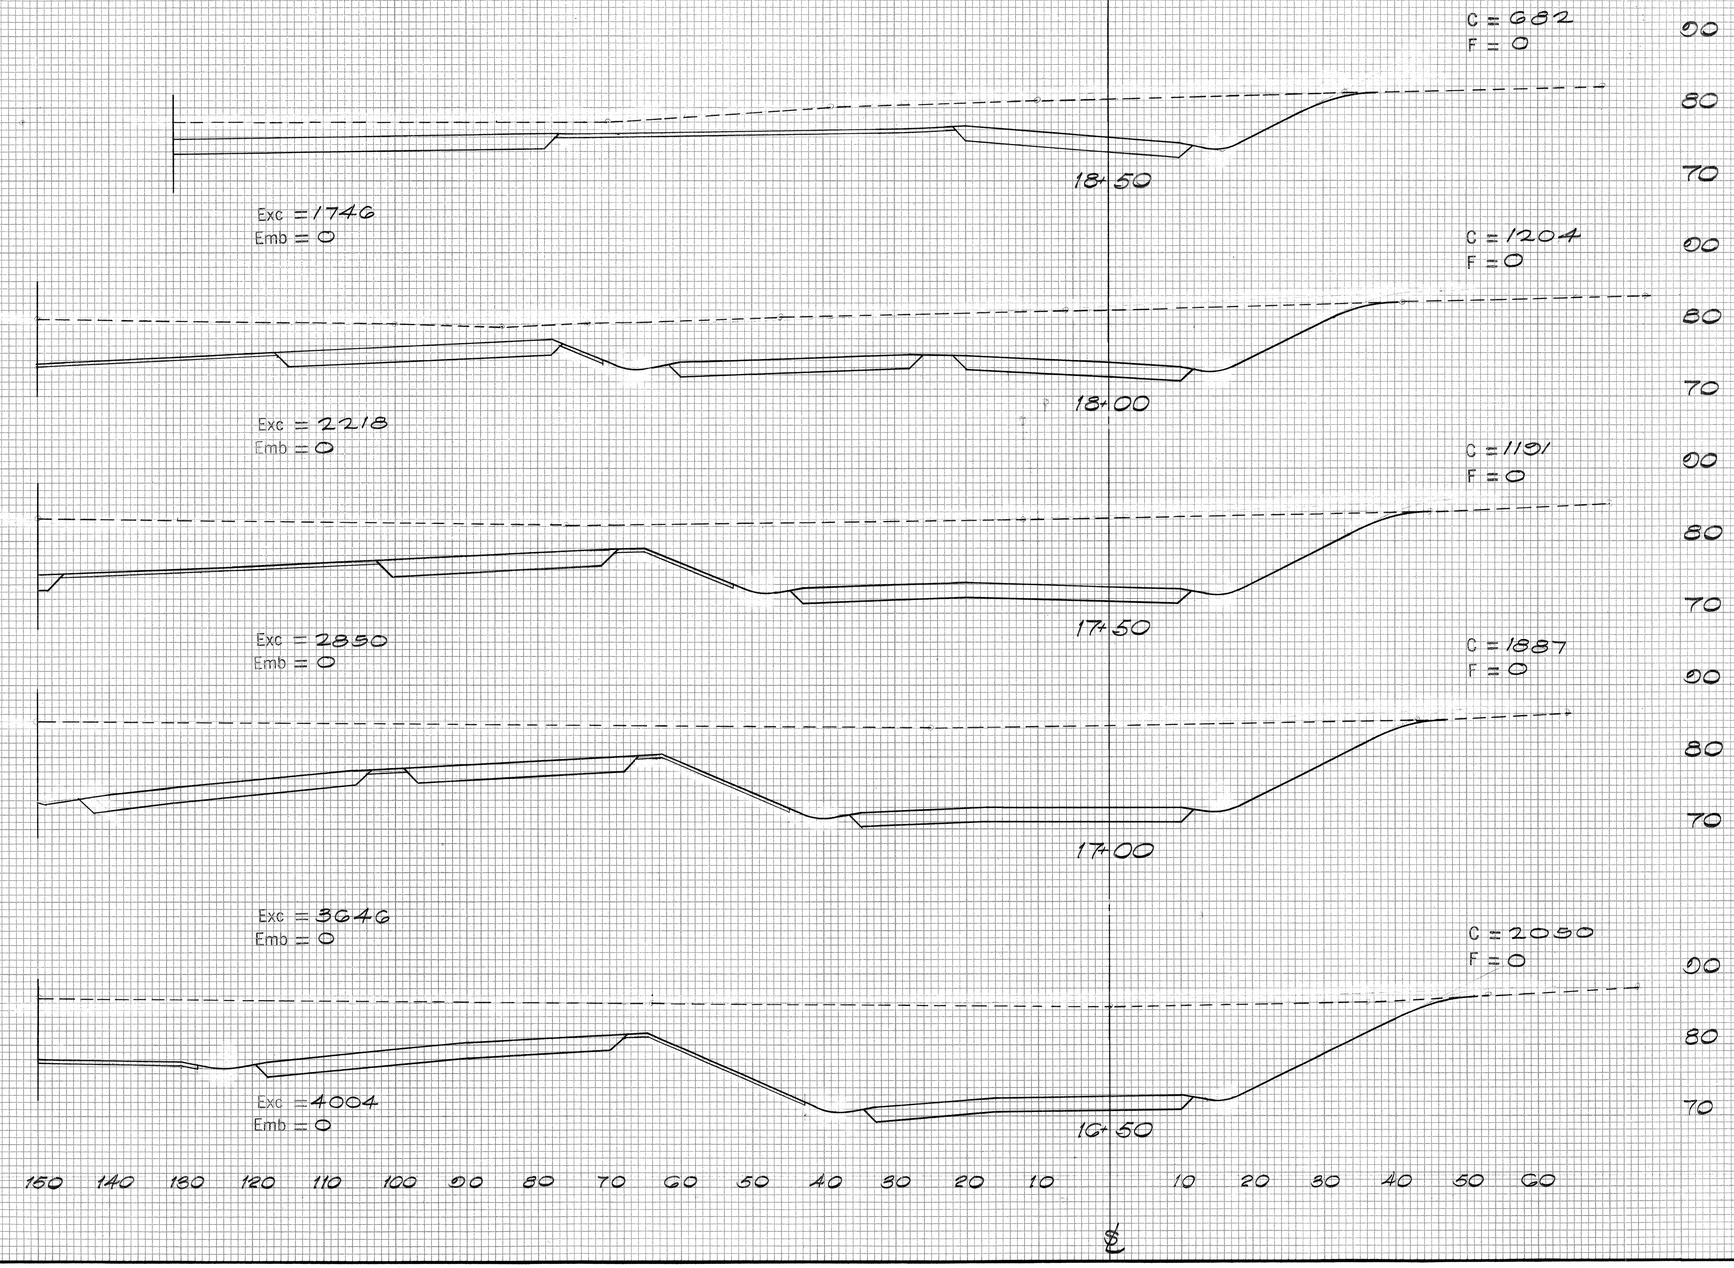

RAMP "E"
Scale: Horiz. 1"=10'
Vert. 1"=10'

PLATE 3 - CROSS SECTION, F.A.S.
CLEARPRINT PAPER CO., S. F. CAL. NO. 1000H-3

FED. ROAD DIST. NO.	STATE	FED. AID PROJ. NO.	FISCAL YEAR	SHEET NO.	TOTAL SHEETS
HAWAII	HAW.	I-HI-1(65):10 I-HI-1(40):11	1969	184	185

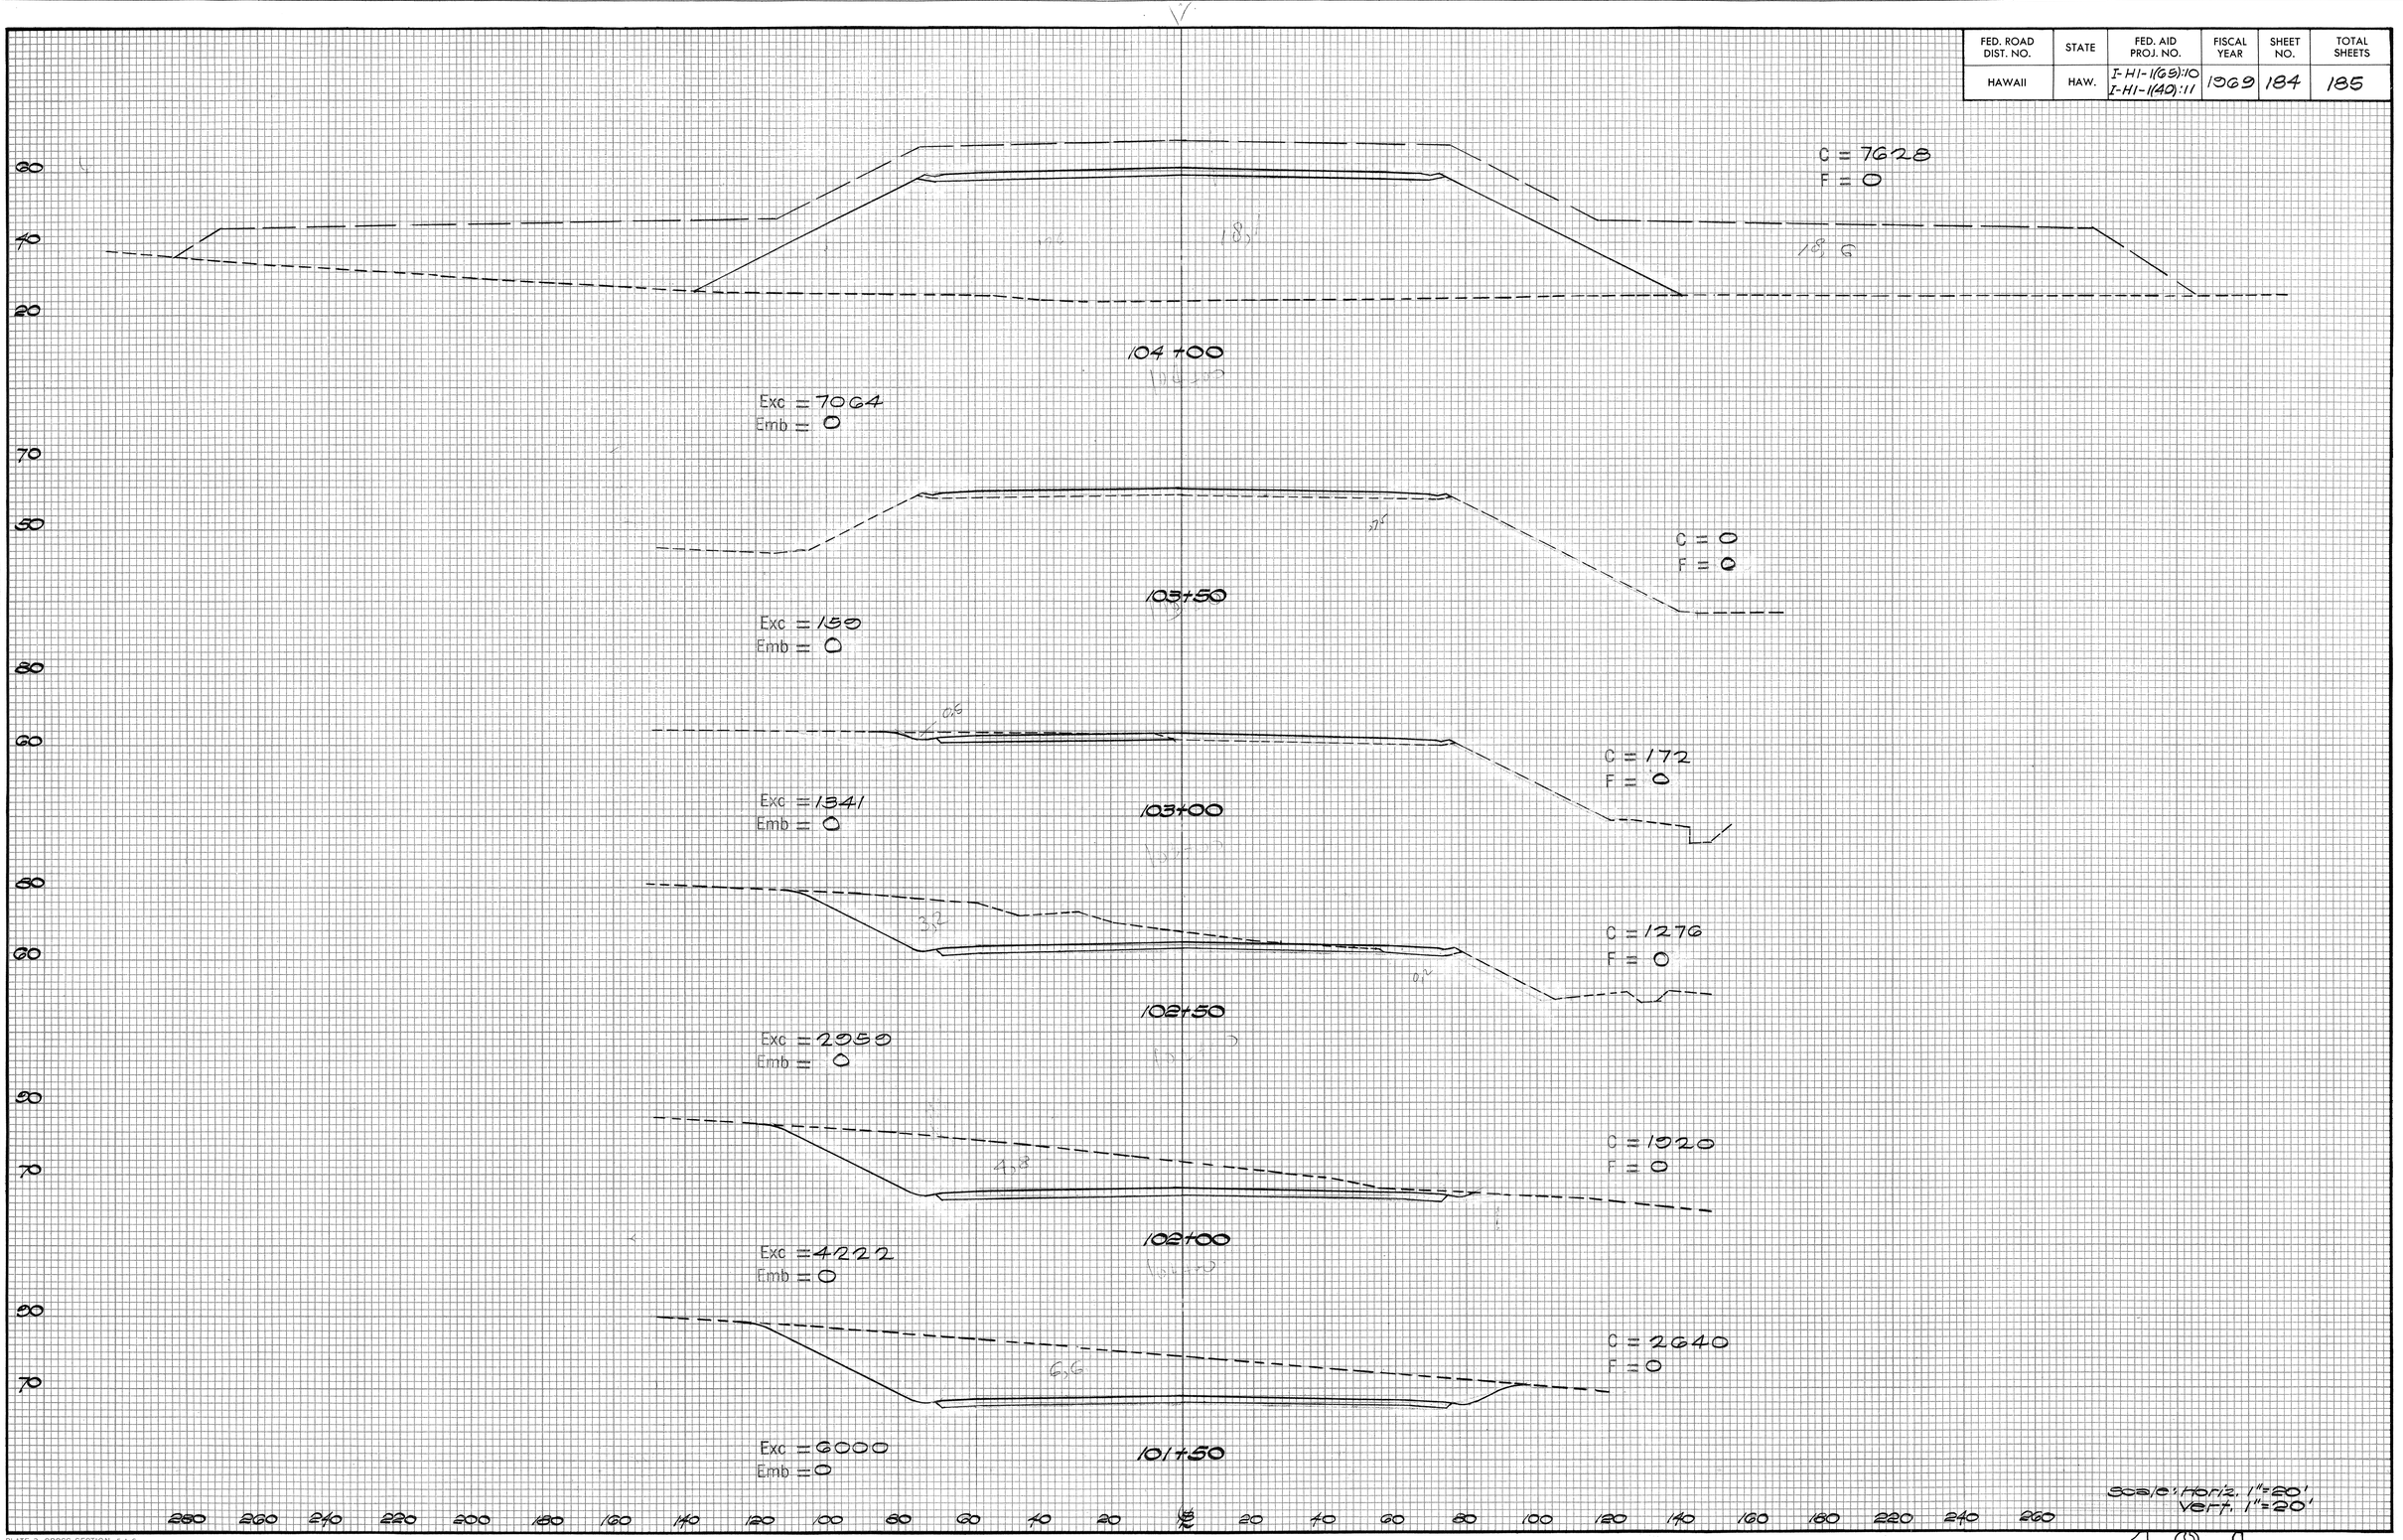

FINAL SURVEY — NOTE BOOK — NO. — SURVEYED — PLOTTED — TEMPLATE — AREAS — AREAS CHECKED — BY — DATE

ORIGINAL SURVEY — NOTE BOOK — NO. — SURVEYED — PLOTTED — TEMPLATE — AREAS — AREAS CHECKED — BY — DATE

PLATE 3 - CROSS SECTION, F. A. S.
CLEARPRINT PAPER CO., S. F. CAL. NO. 1000H-3

FED. ROAD DIST. NO.	STATE	FED. AID PROJ. NO.	FISCAL YEAR	SHEET NO.	TOTAL SHEETS
HAWAII	HAW.	I-HI-1(65):10 I-HI-1(40):11	1969	185	185

FINAL SURVEY — NOTE BOOK — NO. — SURVEYED — PLOTTED — TRIPLICATE AREAS — AREAS CHECKED — BY — DATE

ORIGINAL SURVEY — NOTE BOOK — NO. — SURVEYED — PLOTTED — TRIPLICATE AREAS — AREAS CHECKED — BY — DATE

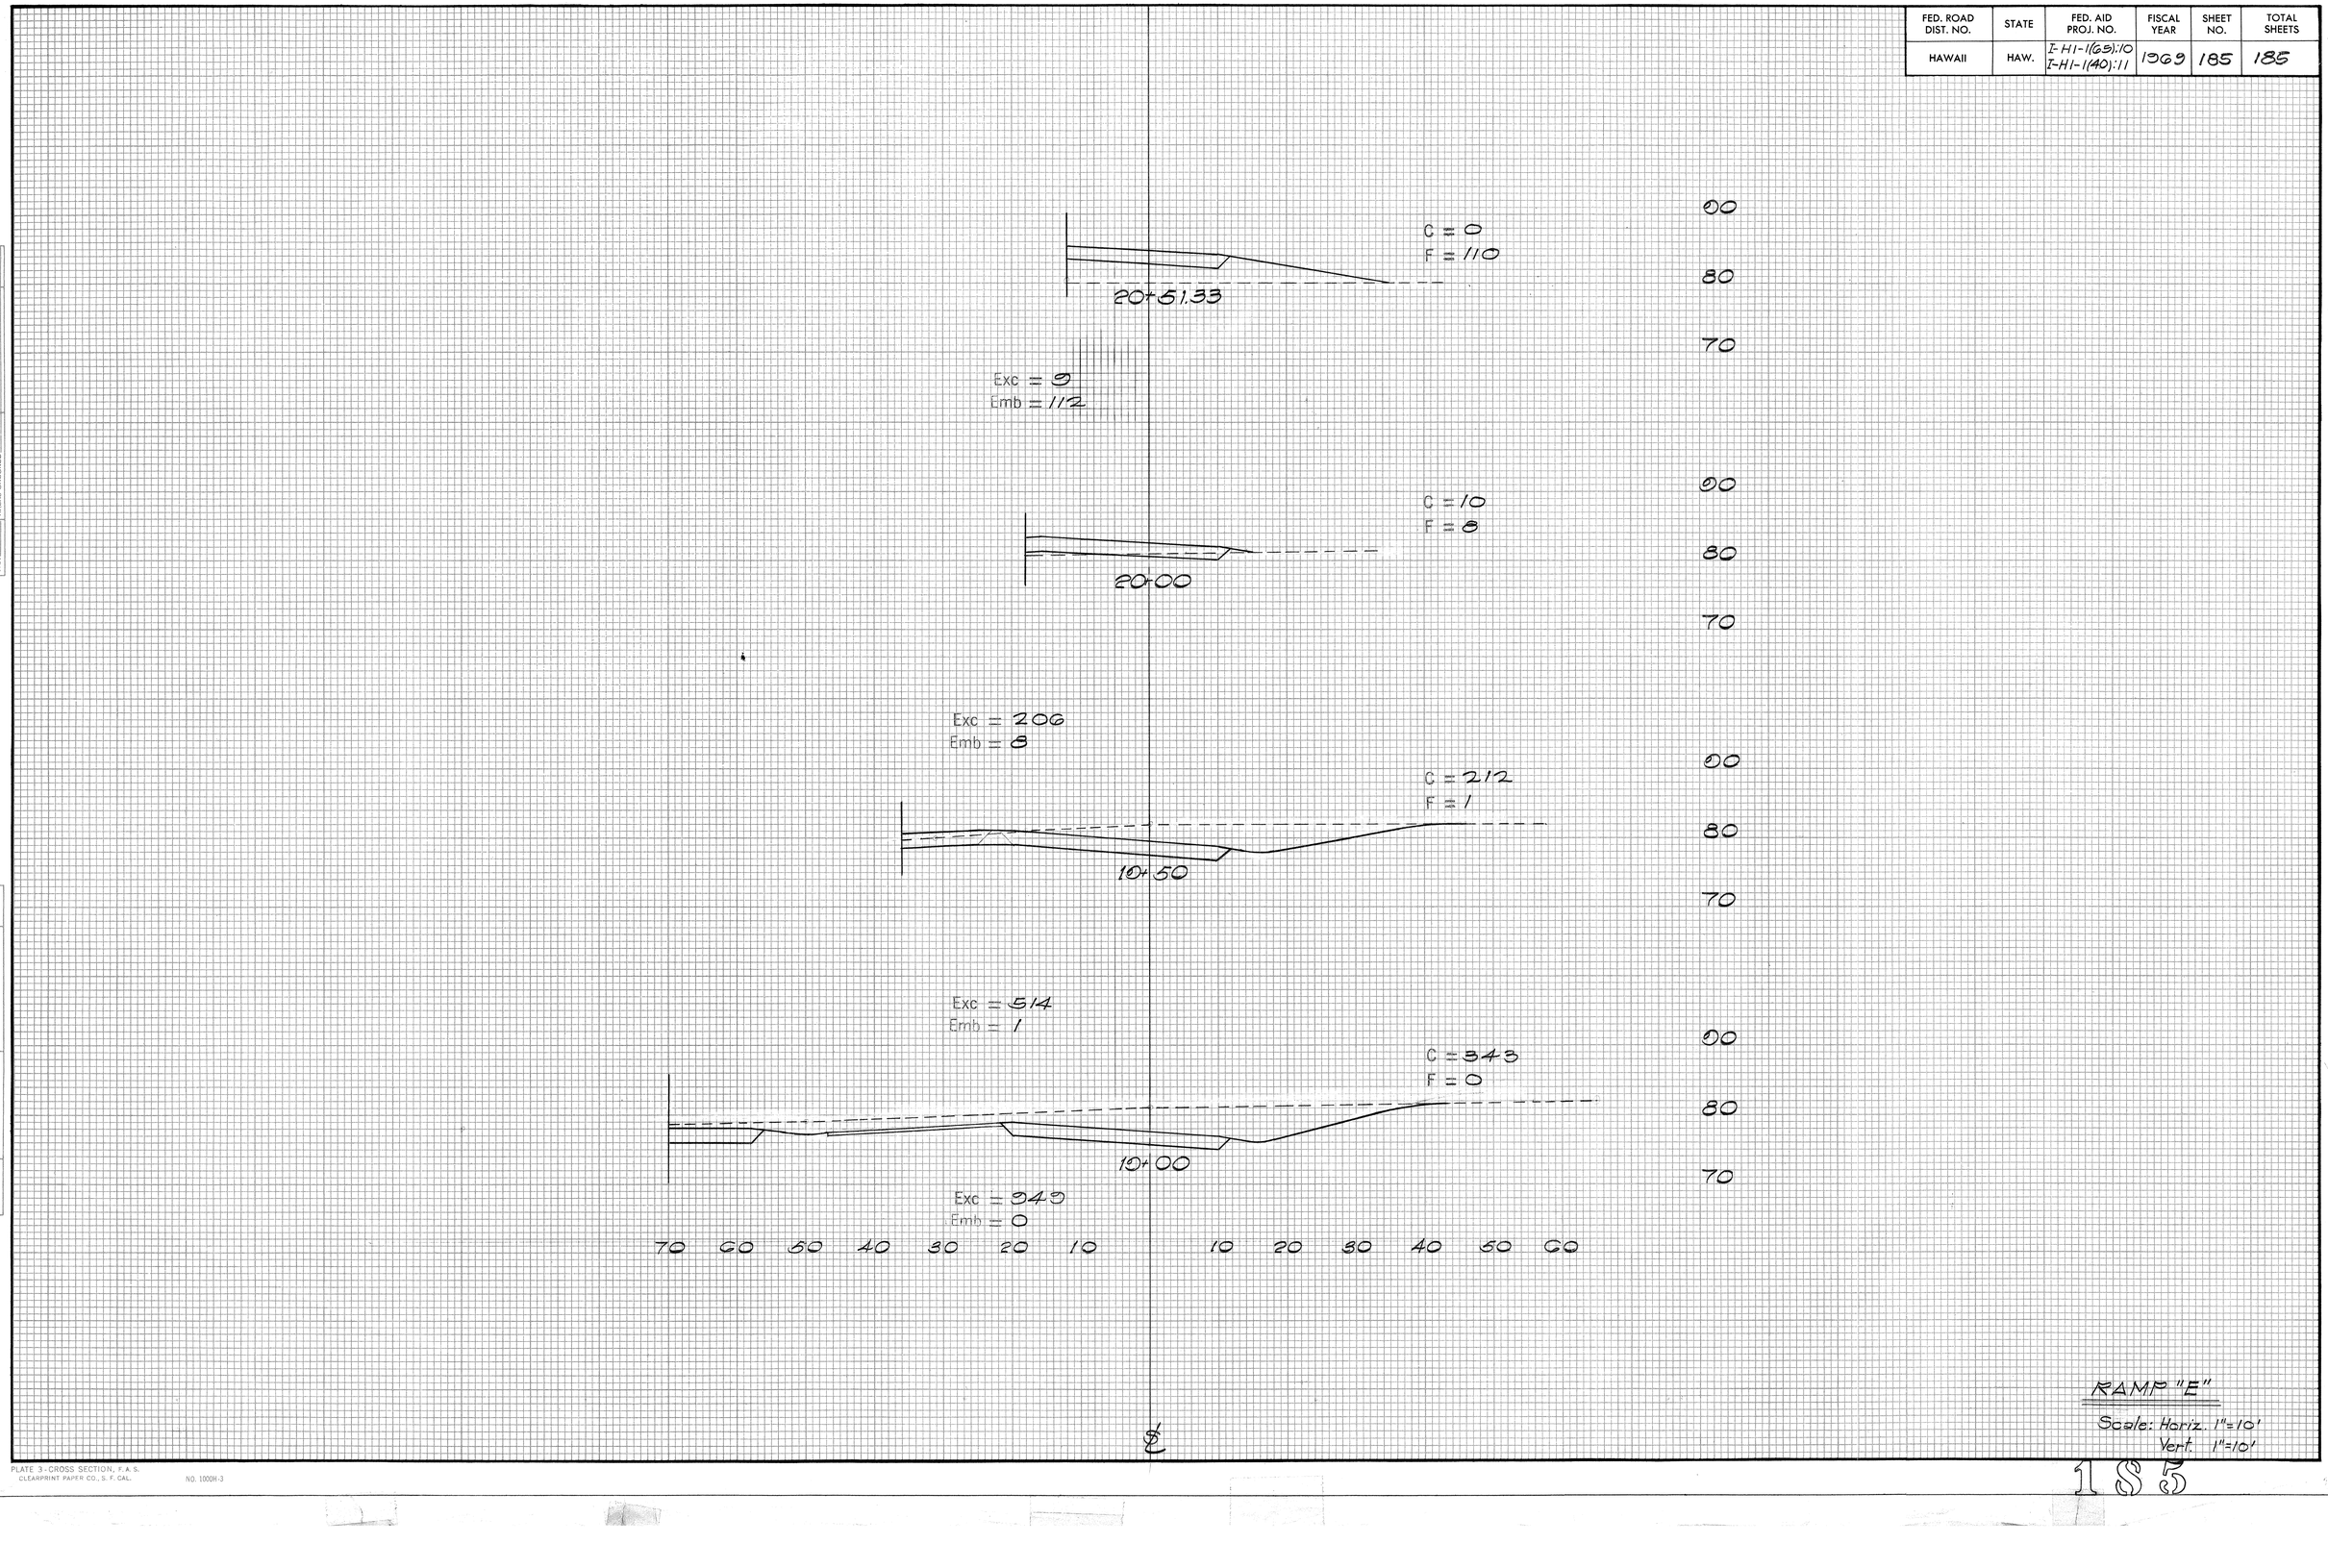

℄

RAMP "E"

Scale: Horiz. 1"=10'
Vert. 1"=10'

185

PLATE 3 - CROSS SECTION, F.A.S.
CLEARPRINT PAPER CO., S. F. CAL. NO. 1000H-3