

1. Azimuths and Coordinates are based on Plane Coordinates.
2. Bench Marks are referred to Mean Sea Level Datum.
3. Existing A.C. pavement not incorporated in the final plans shall be scarified and removed unless otherwise noted, and this cost shall be considered incidental to the various Contract items of work.
4. All Gutters except 6/21 on Cane Haul Road "A" to be installed on future Contract.
5. Existing irrigation flumes and ditches within the Interstate R/W shall be removed in its entirety. All ends shall be blocked off to prevent irrigation water from entering the R/W and all depressions within the R/W shall be filled and graded to match surrounding ground. Cost for this work shall be considered incidental to the various contract items of work.

- 2 CURVE #1 DATA


$\Delta = 14^{\circ} 24' 00''$
 $4/2 = 7^{\circ} 12' 00''$
 $R = 3224$
 $T = 407.29$
 $L_c = 810.28$
 $Ch = 808.15$

§ CURVE #4 DATA

$\Delta = 14^{\circ} 24' 00''$
 $\Delta/2 = 7^{\circ} 12' 00''$
 $R = 3000$
 $T = 378.99$
 $L_c = 753.98$
 $Ch = 752.00$

H-1 OUTBOUND TO H-2 OUTBOUND
& H-2 INBOUND TO H-1 INBOUND

SCALE: 1"=50'

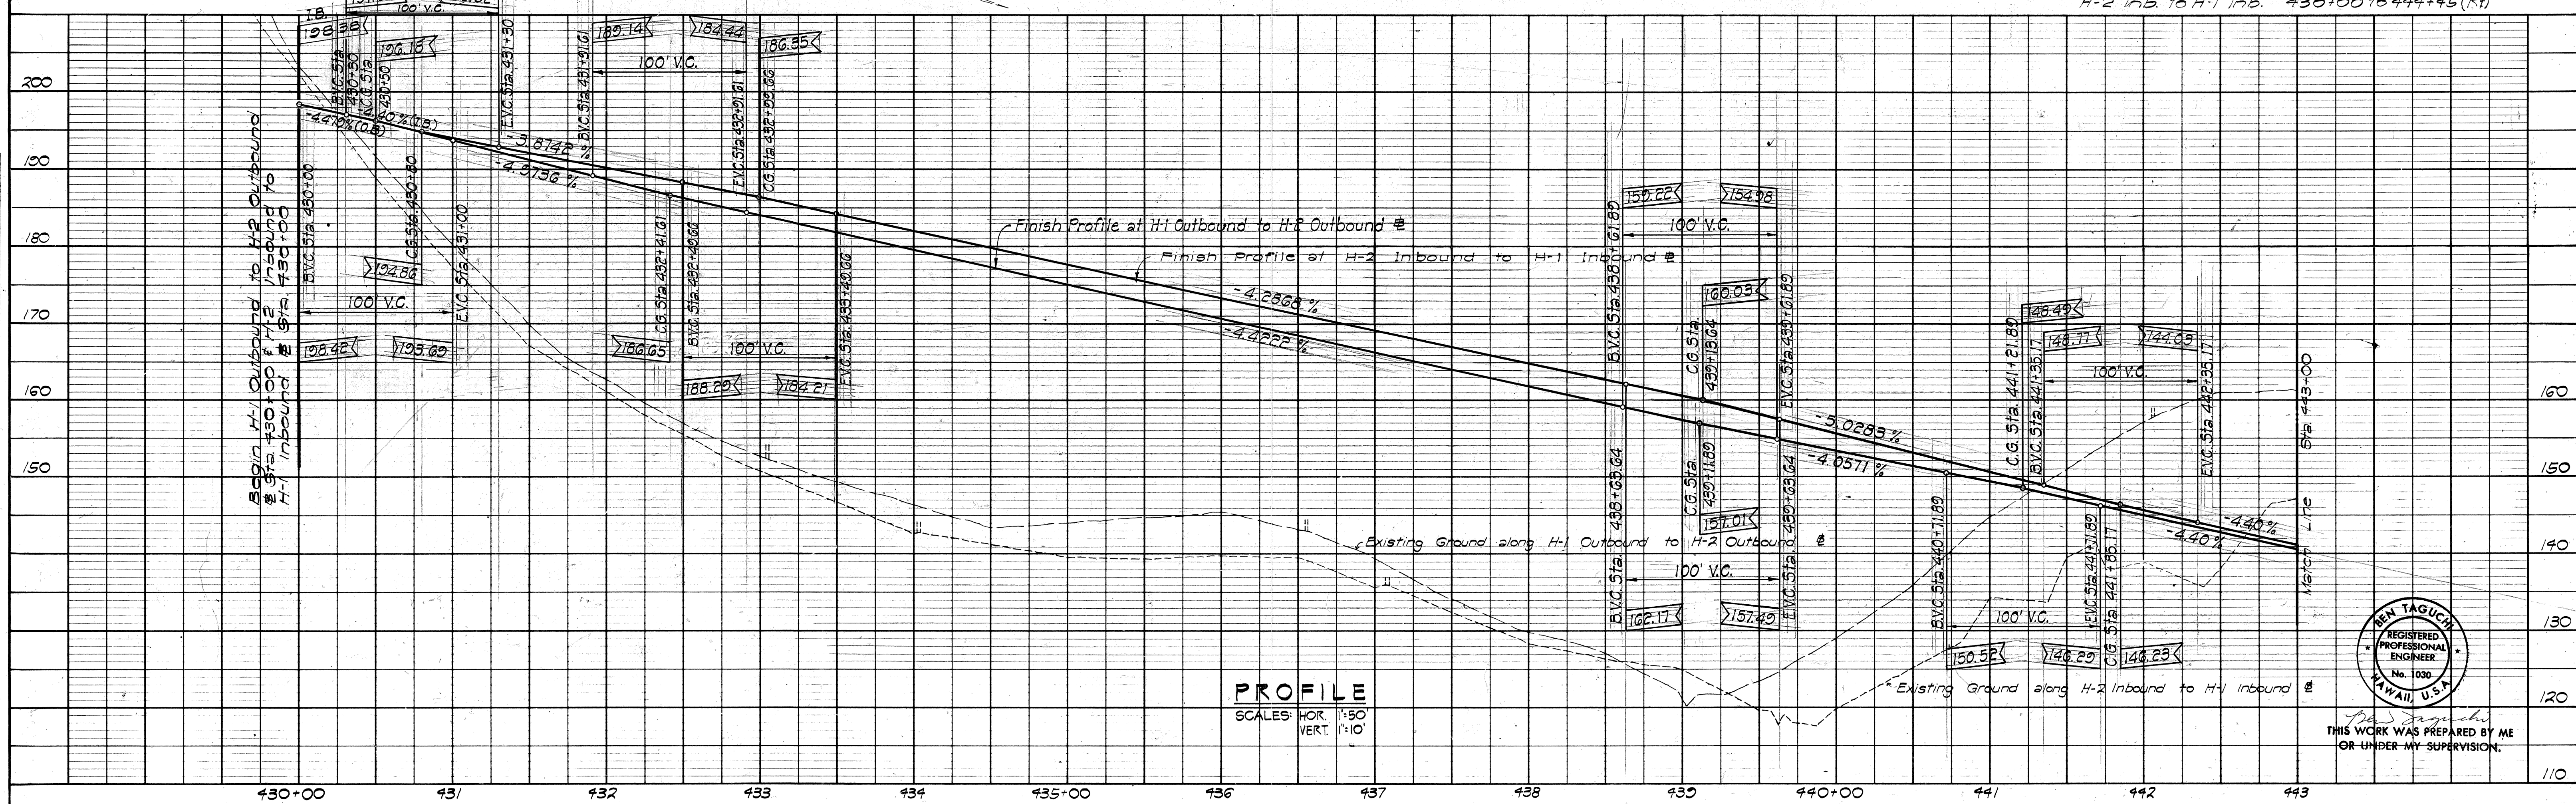

FED. ROAD DIST. NO.	STATE	FED. AID PROJ. NO.	FISCAL YEAR	SHEET NO.	TOTAL SHEETS
HAWAII	HAW.	I-HI-1(75)-8	1960	6	181

Revised: Jan. 17, 1970


THIS WORK WAS PREPARED BY ME
OR UNDER MY SUPERVISION.

November 29, 1971

CO. 6



PLAN		BY	DATE
NOTE BOOK			
SURVEYED			
PLOTTED			
ALIGNMENT CHECKED			
RT. OF WAY CHECKED			
NO.			

PROFILE		BY	DATE
NO	SURVEYED		
	PLOTTED		
	NOTE BOOK		
	GRADES CHECKED		
	B.M.'s NOTED		
	STRUCTURE NOTATIONS CH'KD		


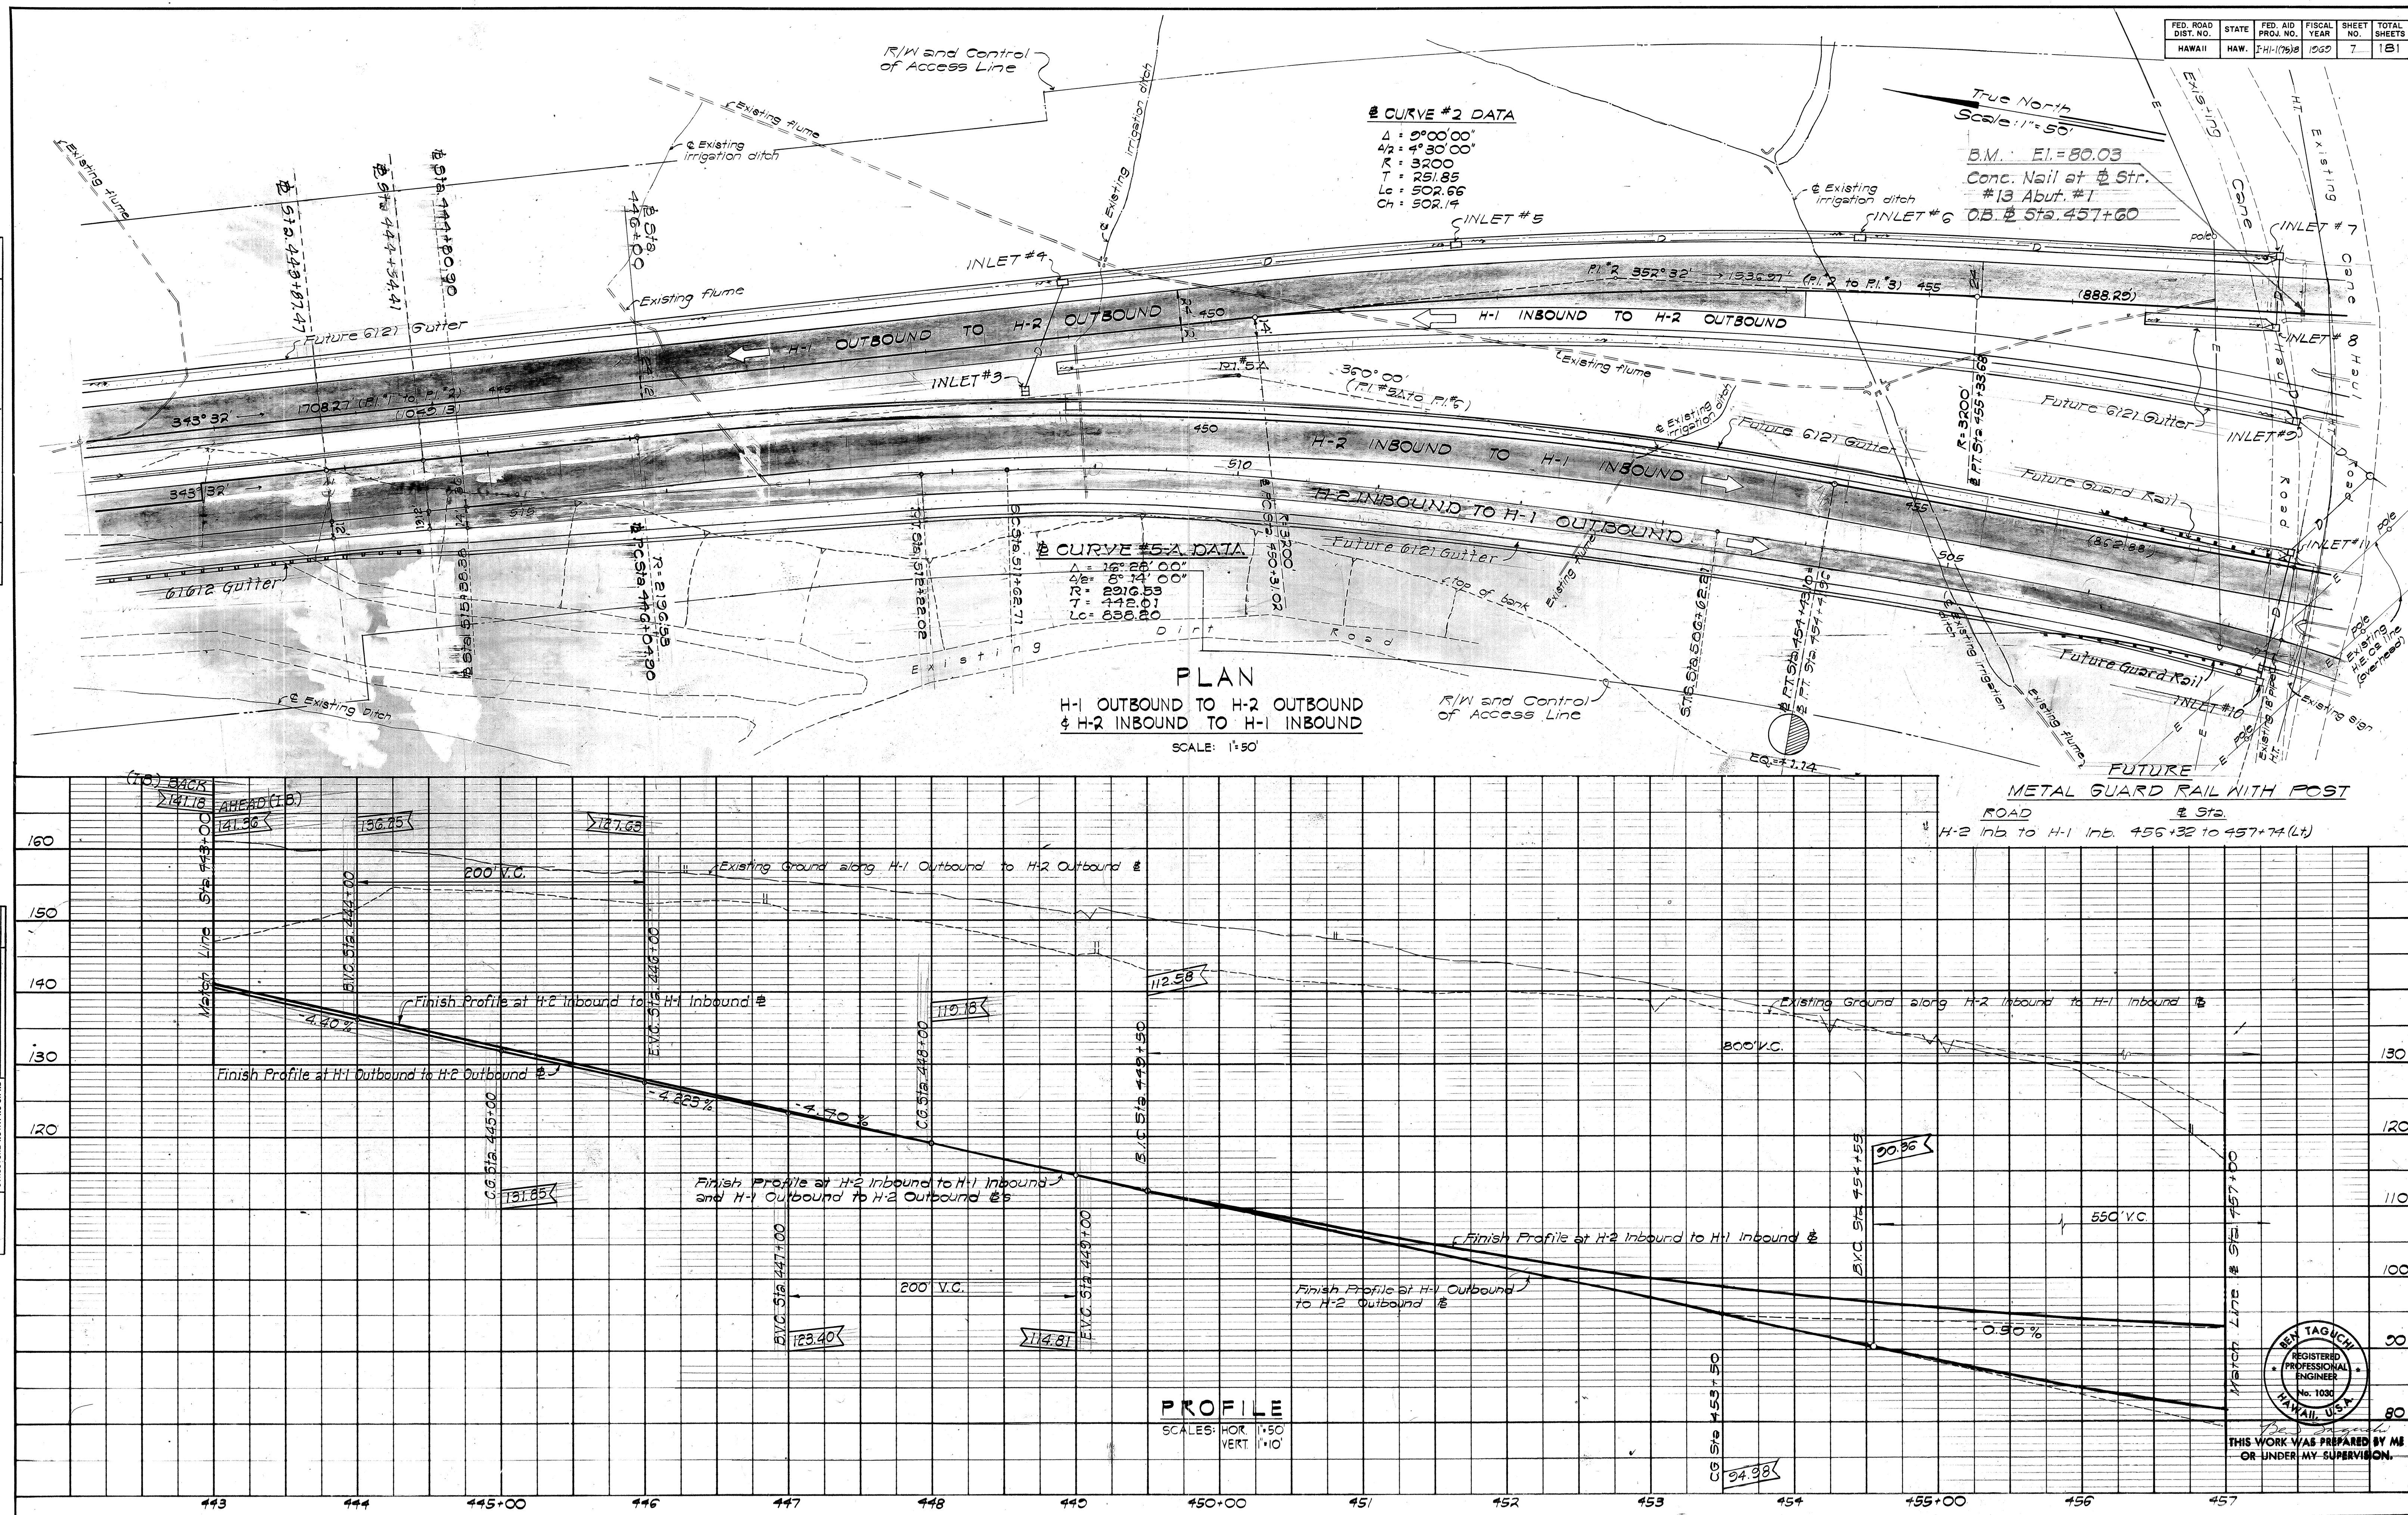


PLAN	DATE	BY
SURVEYED		
PLOTTED		
NOTE BOOK		
NO.		

PROFILE	DATE	BY
SURVEYED		
PLOTTED		
NOTE BOOK		
NO.		

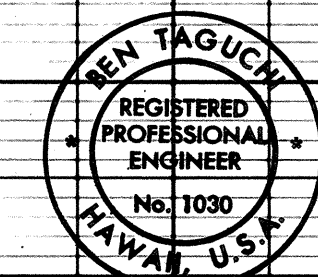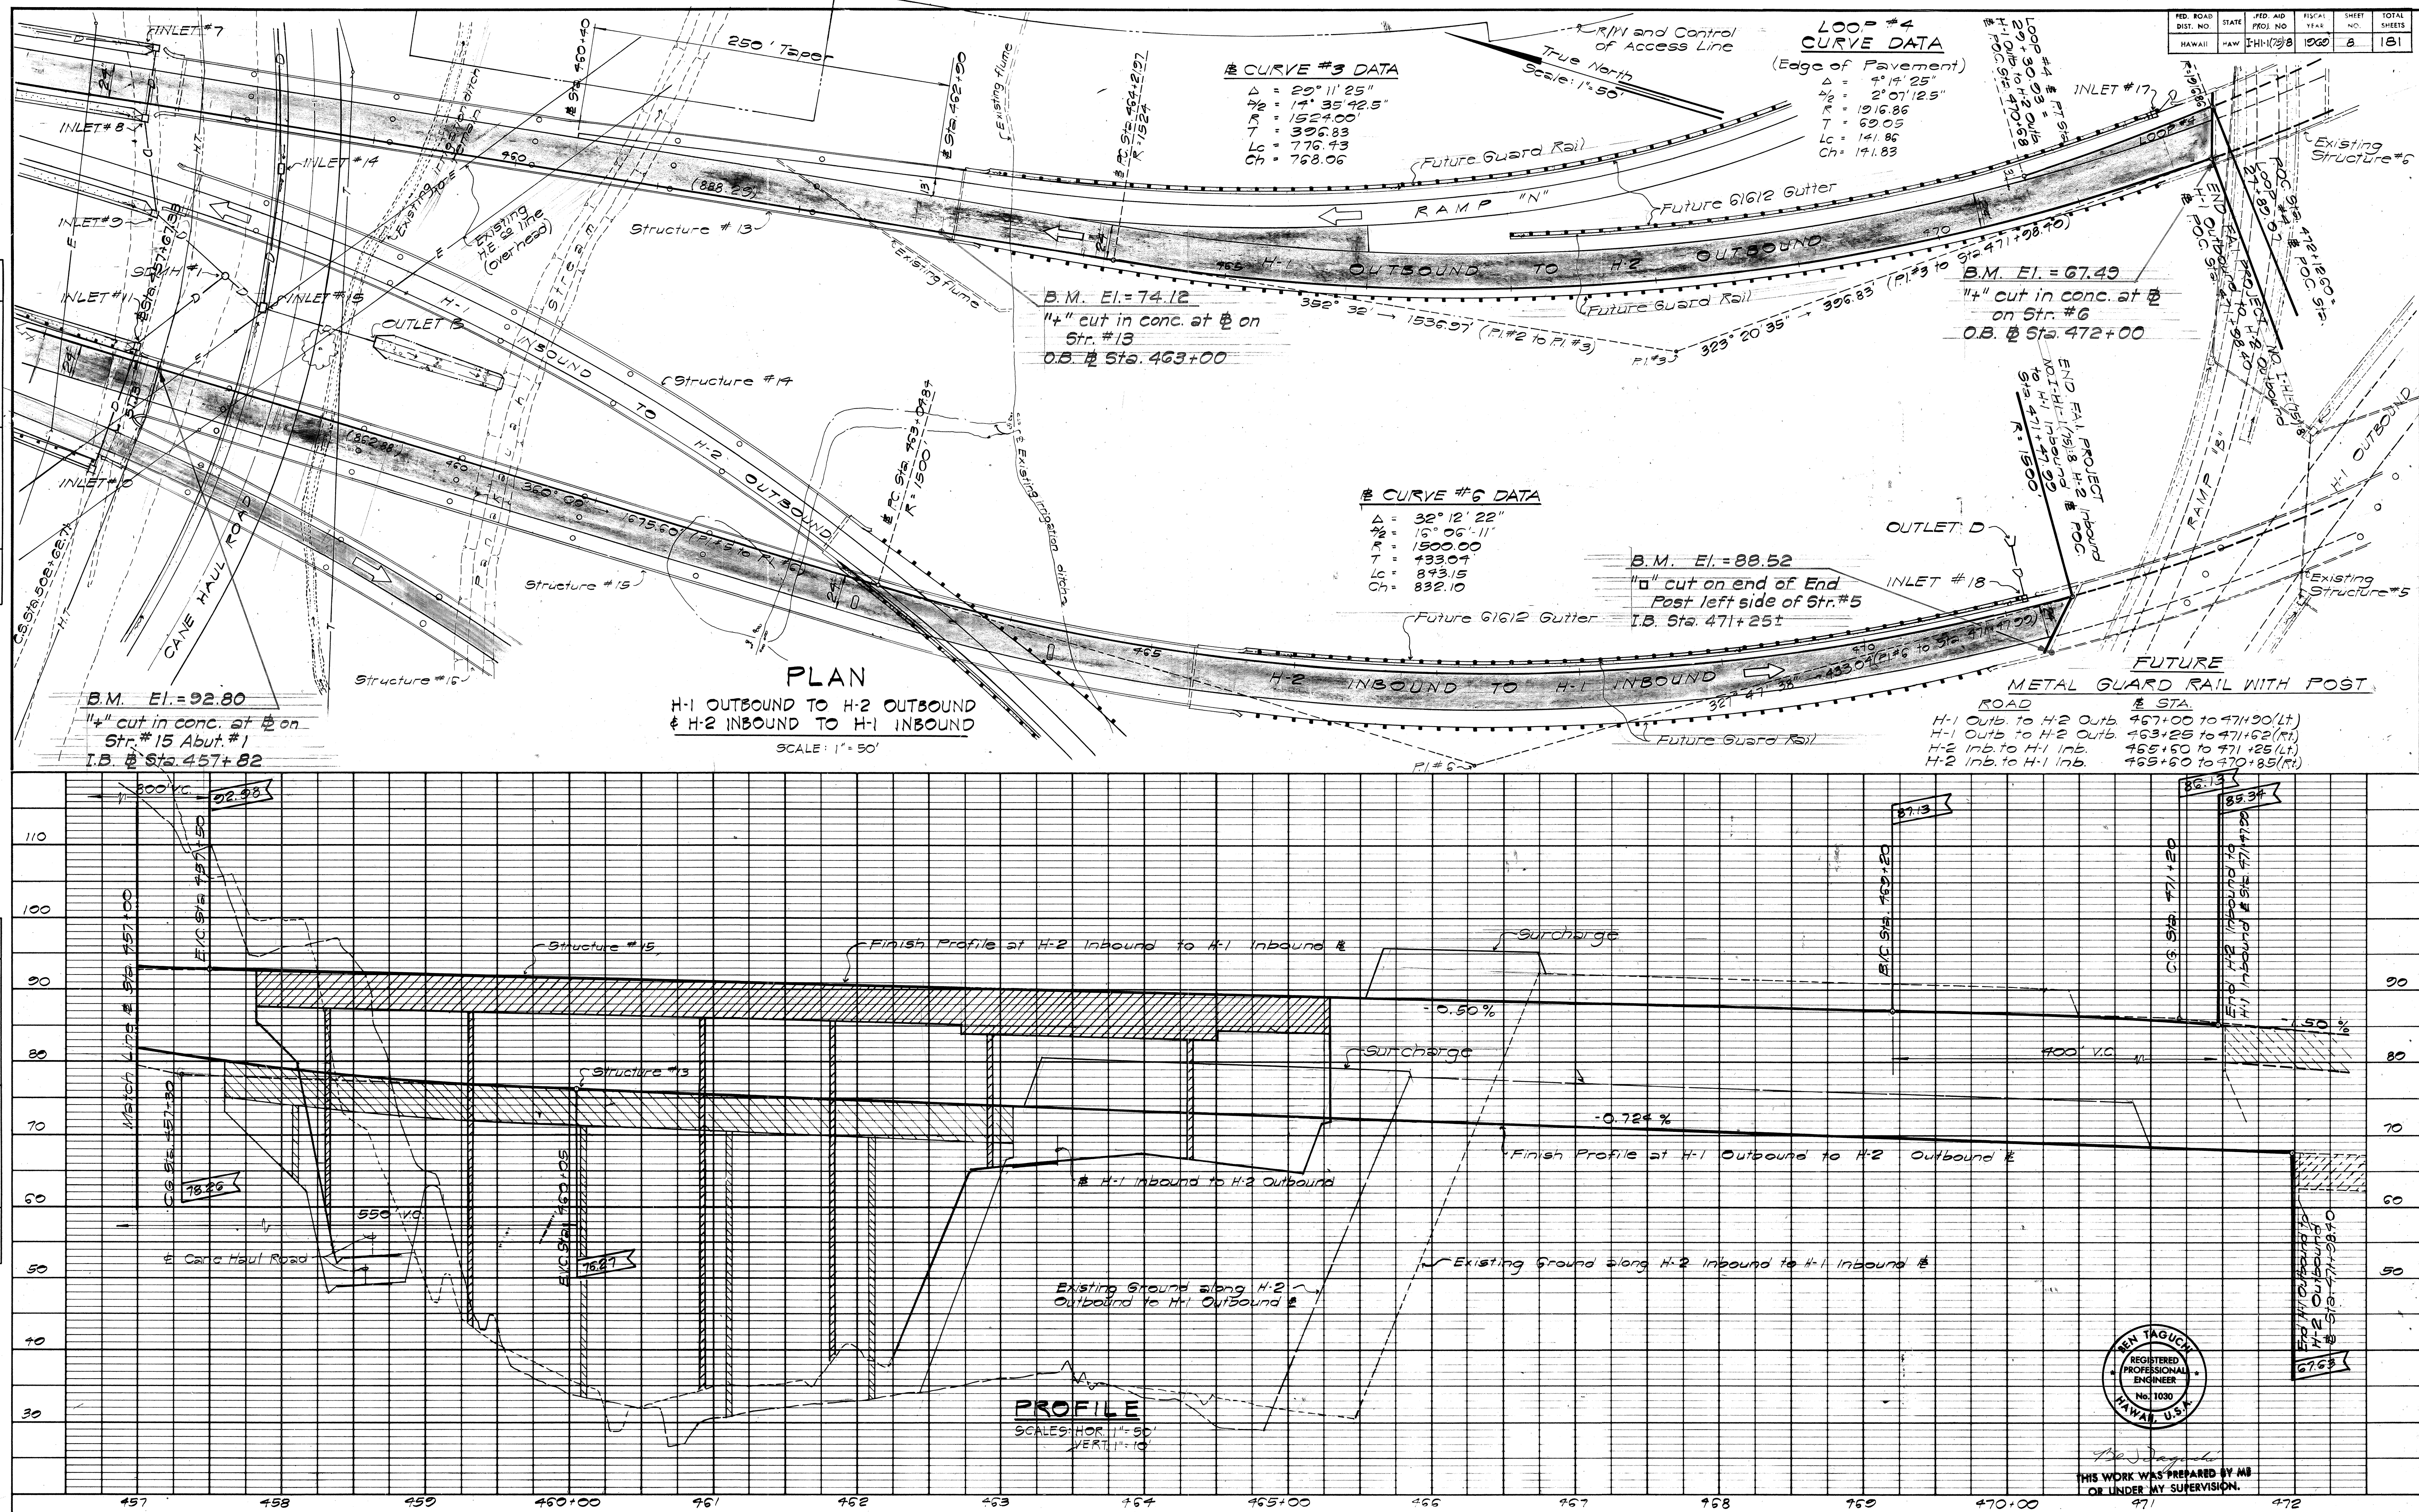

PLAN	BY	DATE
SURVEYED		
PLOTTED		
ALIGNMENT CHECKED		
RT OF WAY CHECKED		
NO. _____		


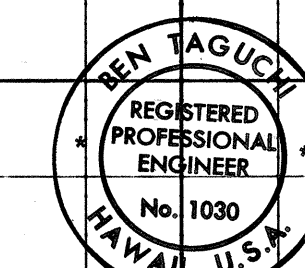
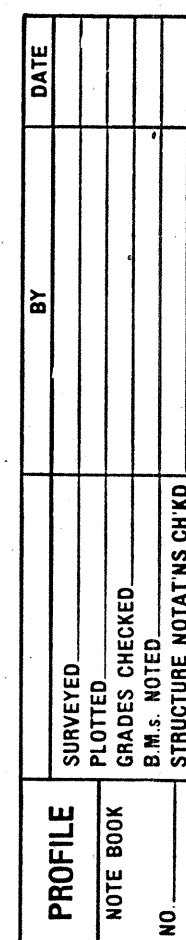


THIS WORK WAS PREPARED BY A
OR UNDER MY SUPERVISION.

FED. ROAD DIST. NO.	STATE	FED. AID PROJ. NO.	FISCAL YEAR	SHEET NO.	TOTAL SHEETS
HAWAII	HAW.	I-H-175/8	1969	13	121

PLAN	DATE	BY
SURVEYED		
PLOTTED		
NOTED		
BY		
NO.		

PROFILE	DATE	BY
SURVEYED		
PLOTTED		
NOTED		
BY		
NO.		

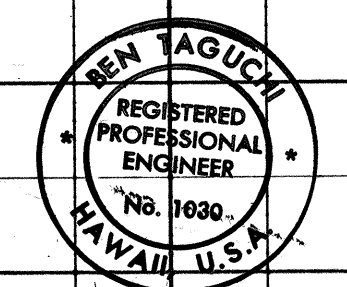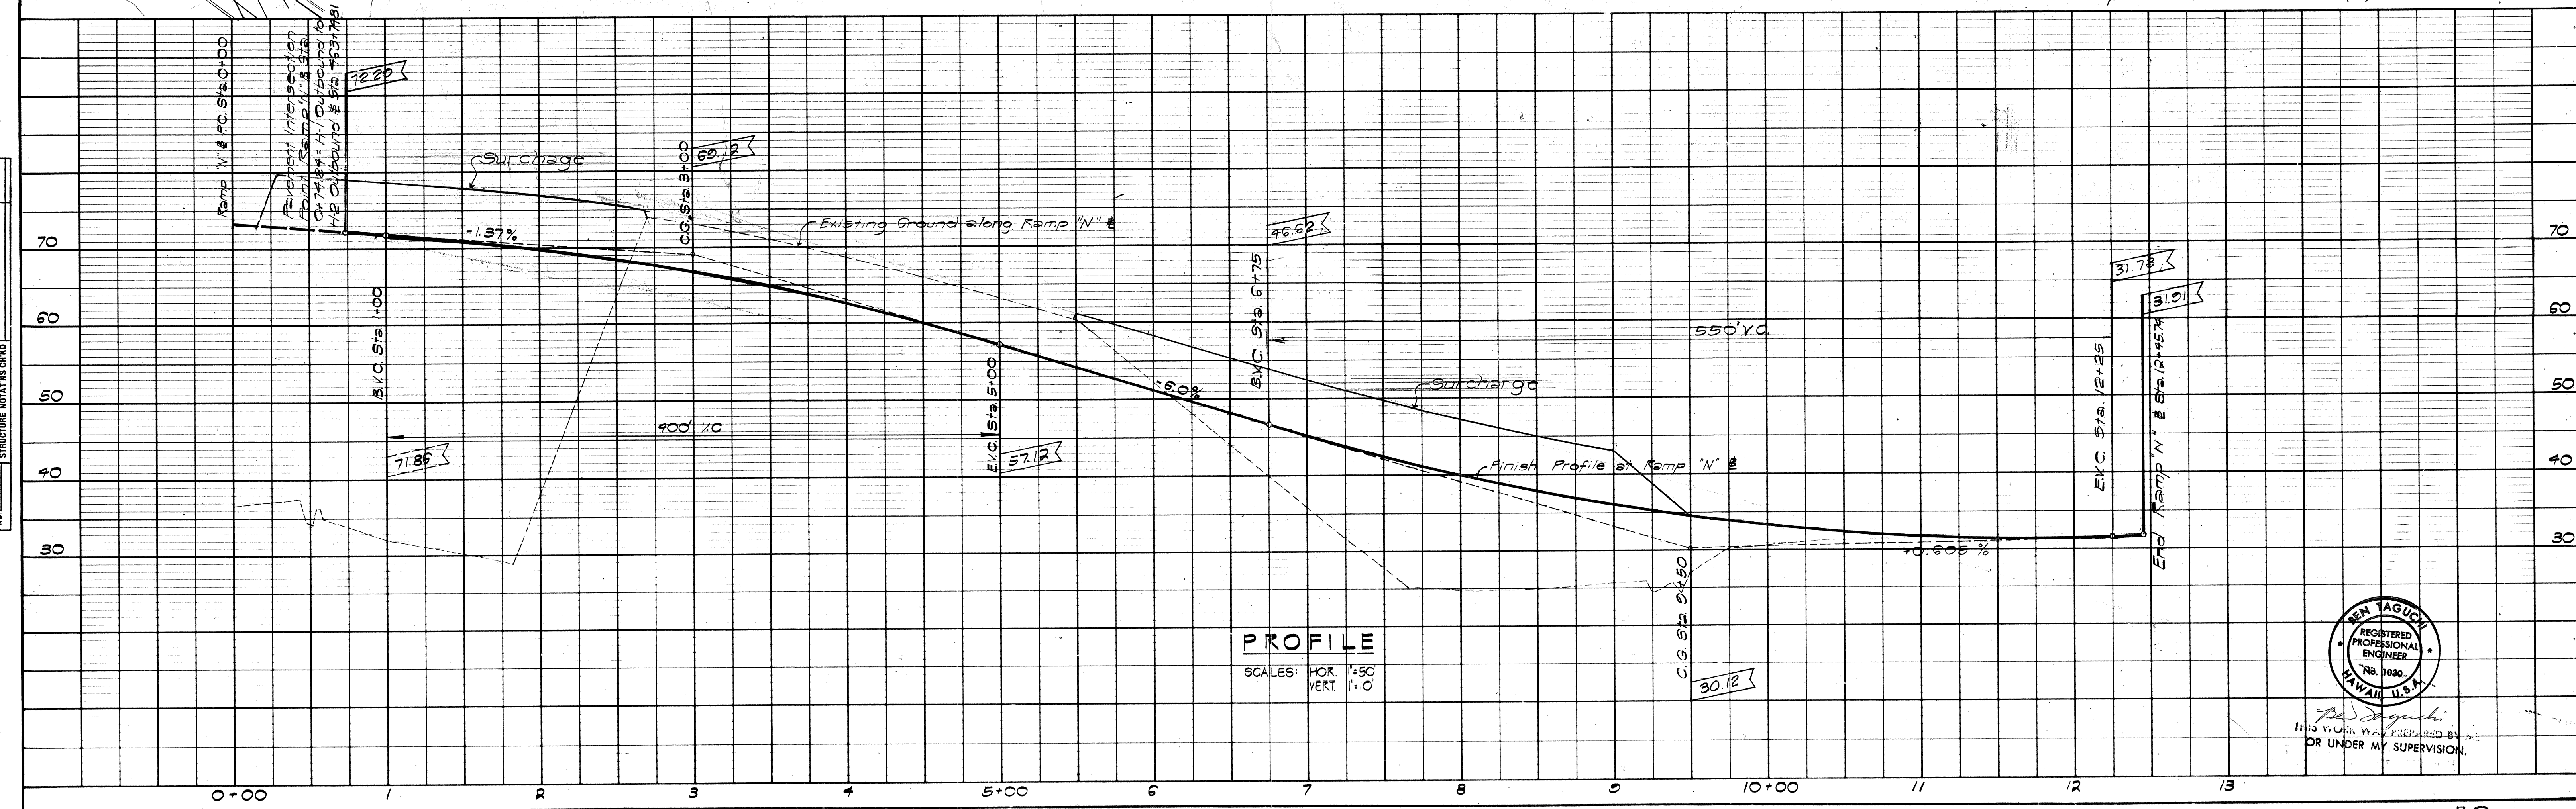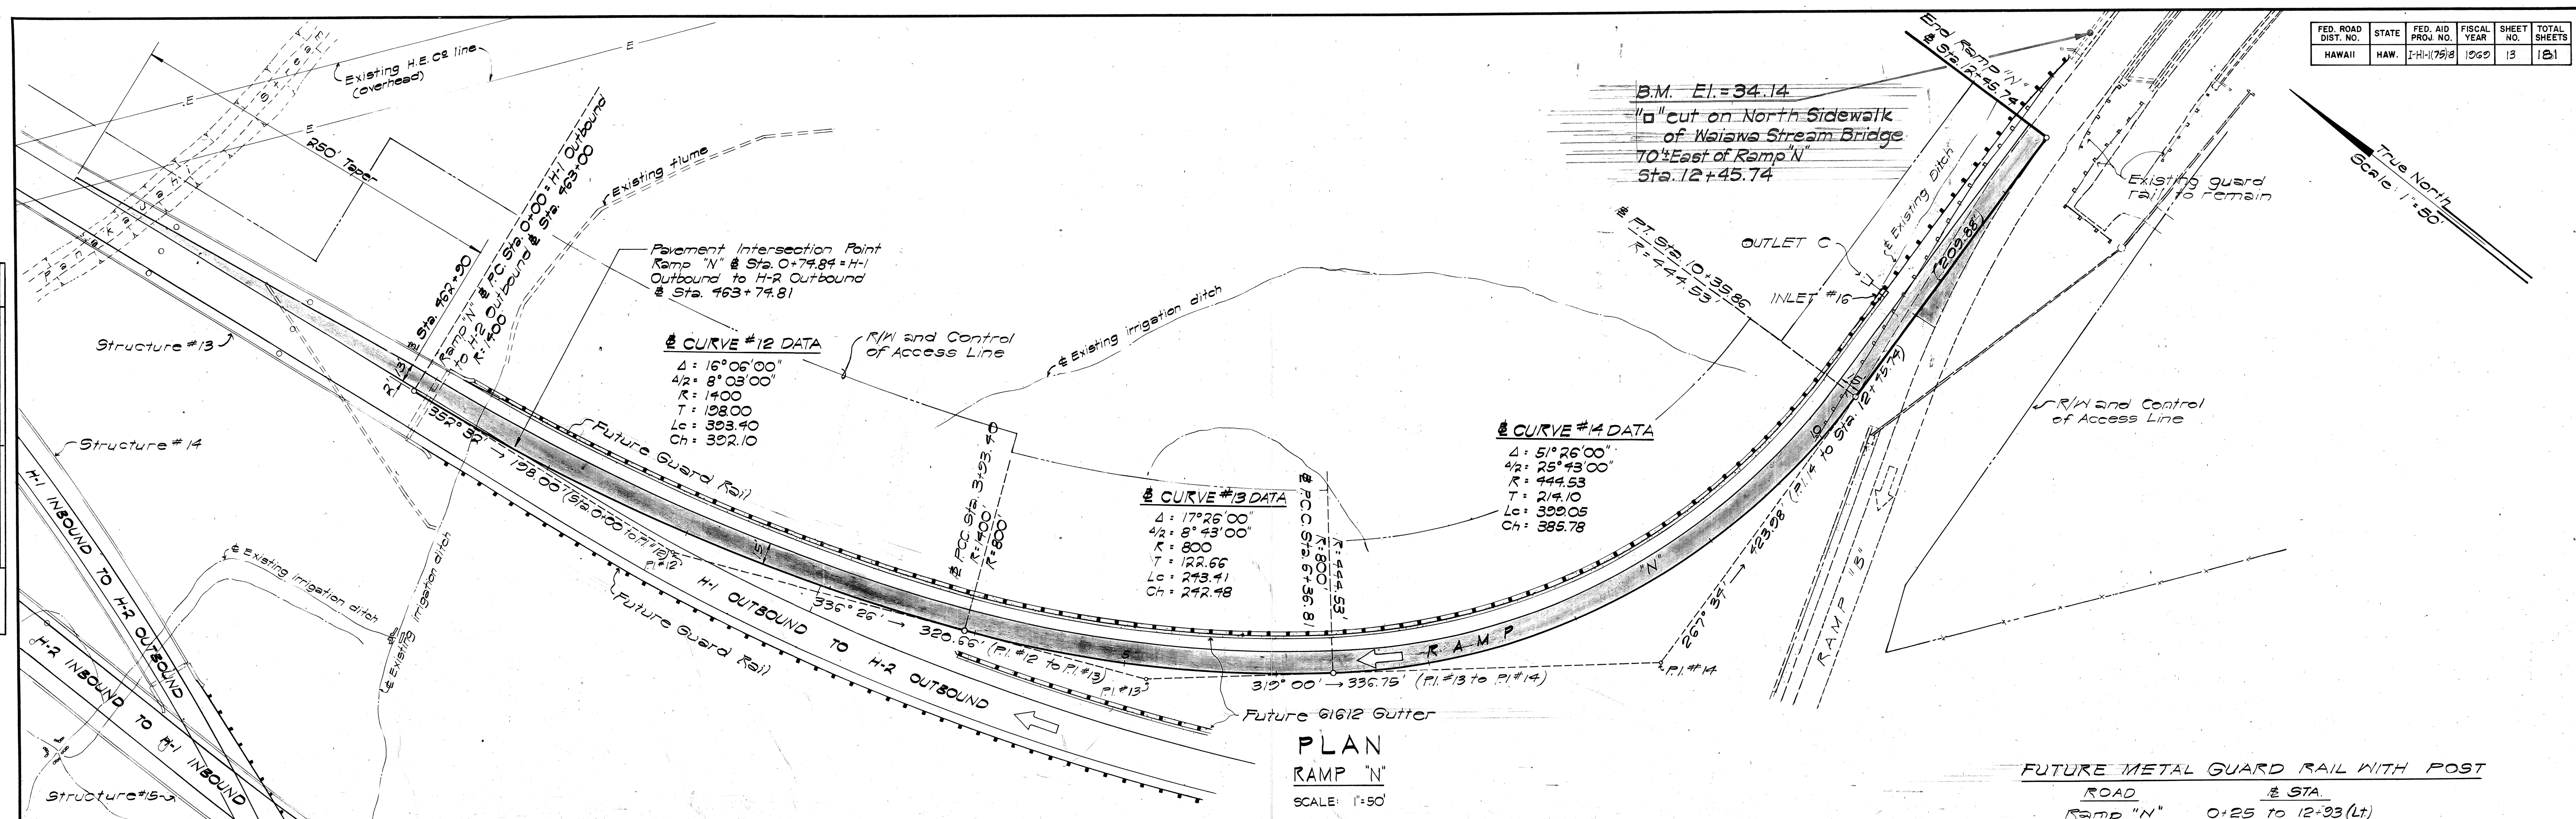


I hereby certify that the work was prepared by me or under my supervision.



PLAN	DATE	BY	DATE
SURVEYED			
PLOTTED			
ALIGNED CHECKED			
NOTE BOOK			
NO.			

PROFILE	DATE	BY	DATE
SURVEYED			
PLOTTED			
GRADES CHECKED			
NOTE BOOK			
NO.			

FED. ROAD DIST. NO.	STATE	FED. AID PROJ. NO.	FISCAL YEAR	SHEET NO.	TOTAL SHEETS

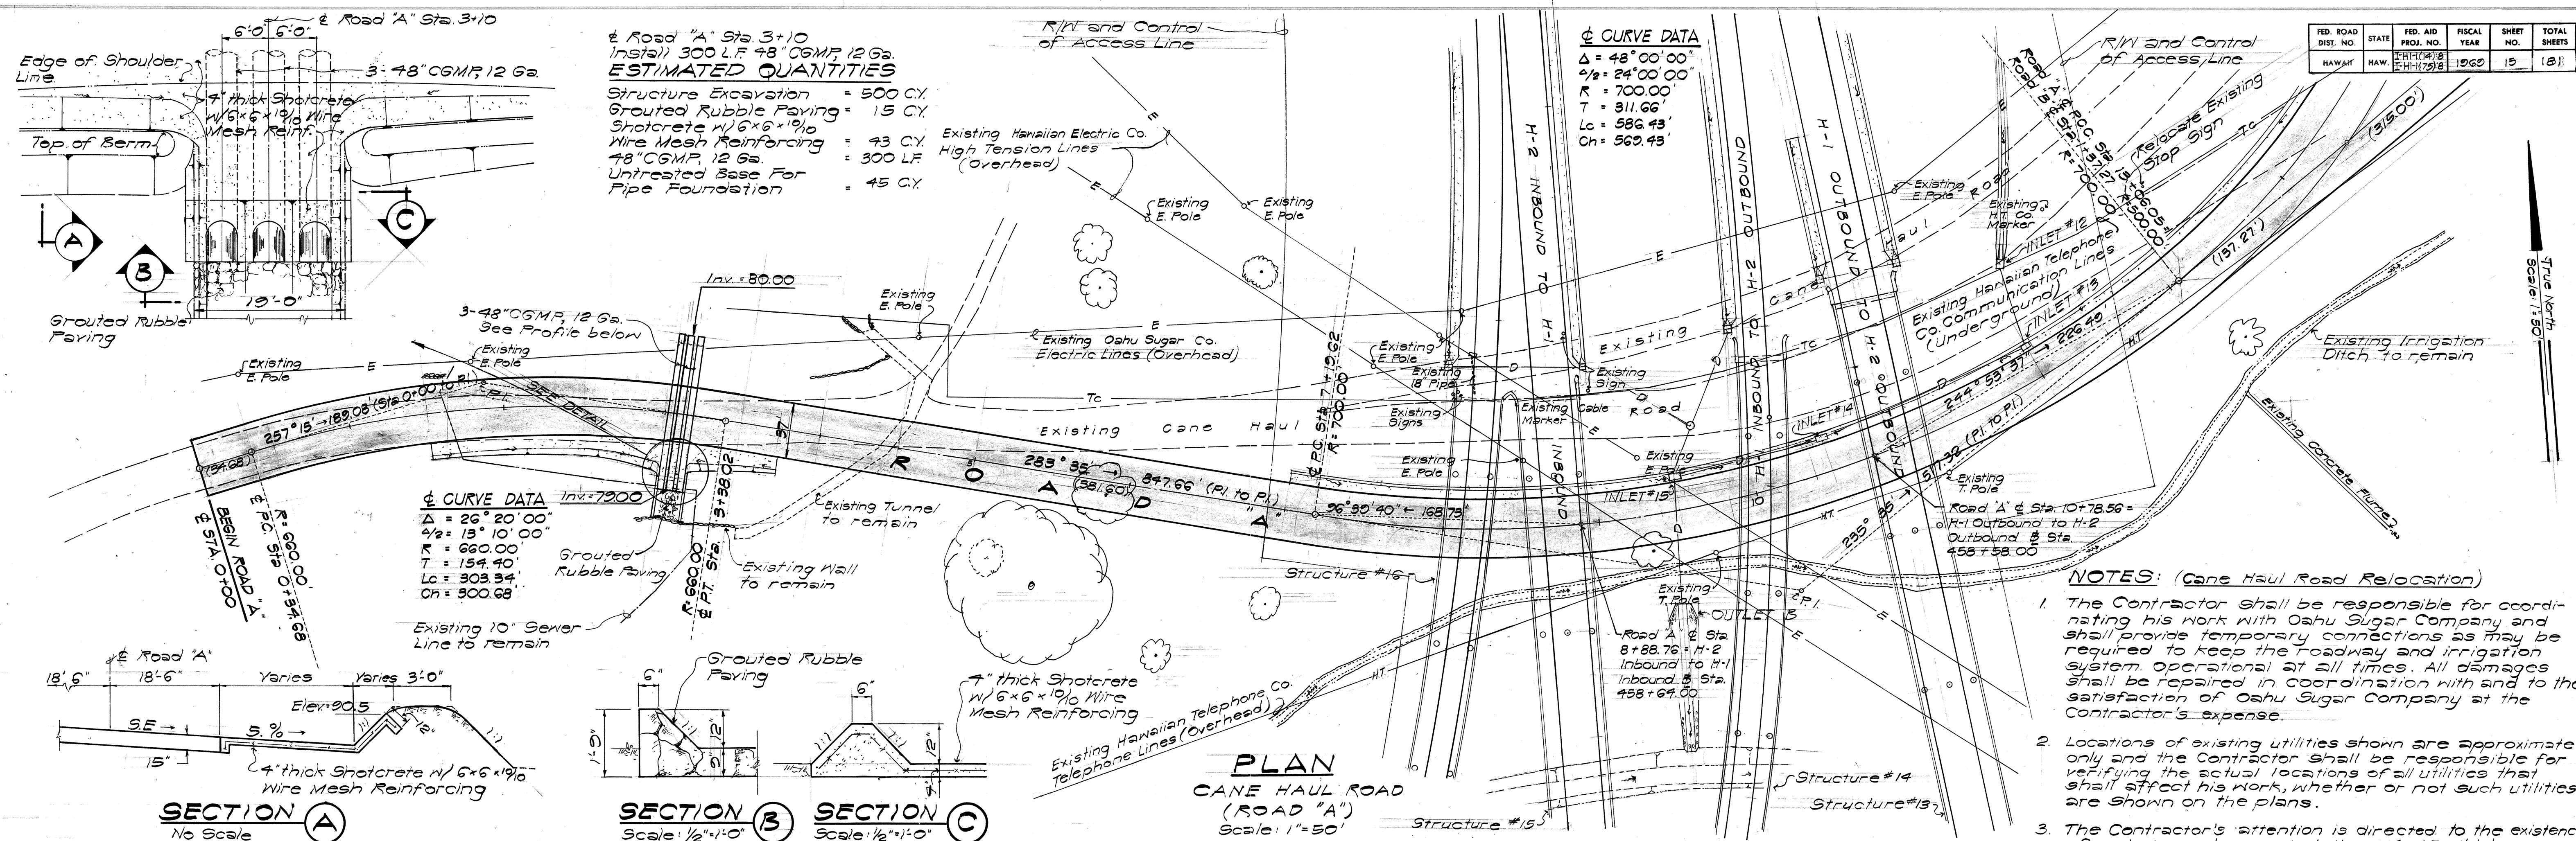

- NOTES: (Cane Haul Road Relocation)**
- The Contractor shall be responsible for coordinating his work with Oahu Sugar Company and shall provide temporary connections as may be required to keep the roadway and irrigation system operational at all times. All damages shall be repaired in coordination with and to the satisfaction of Oahu Sugar Company at the Contractor's expense.
 - Locations of existing utilities shown are approximate only and the Contractor shall be responsible for verifying the actual locations of all utilities that shall affect his work, whether or not such utilities are shown on the plans.
 - The Contractor's attention is directed to the existence of a drainage tunnel at station 4+45 which may be subject to possible damages from his construction operations. The Contractor shall be fully responsible for his construction methods and any damages resulting from his operations shall be repaired at the Contractor's expense.

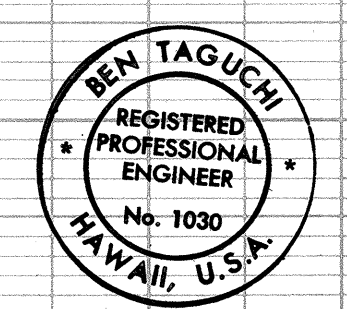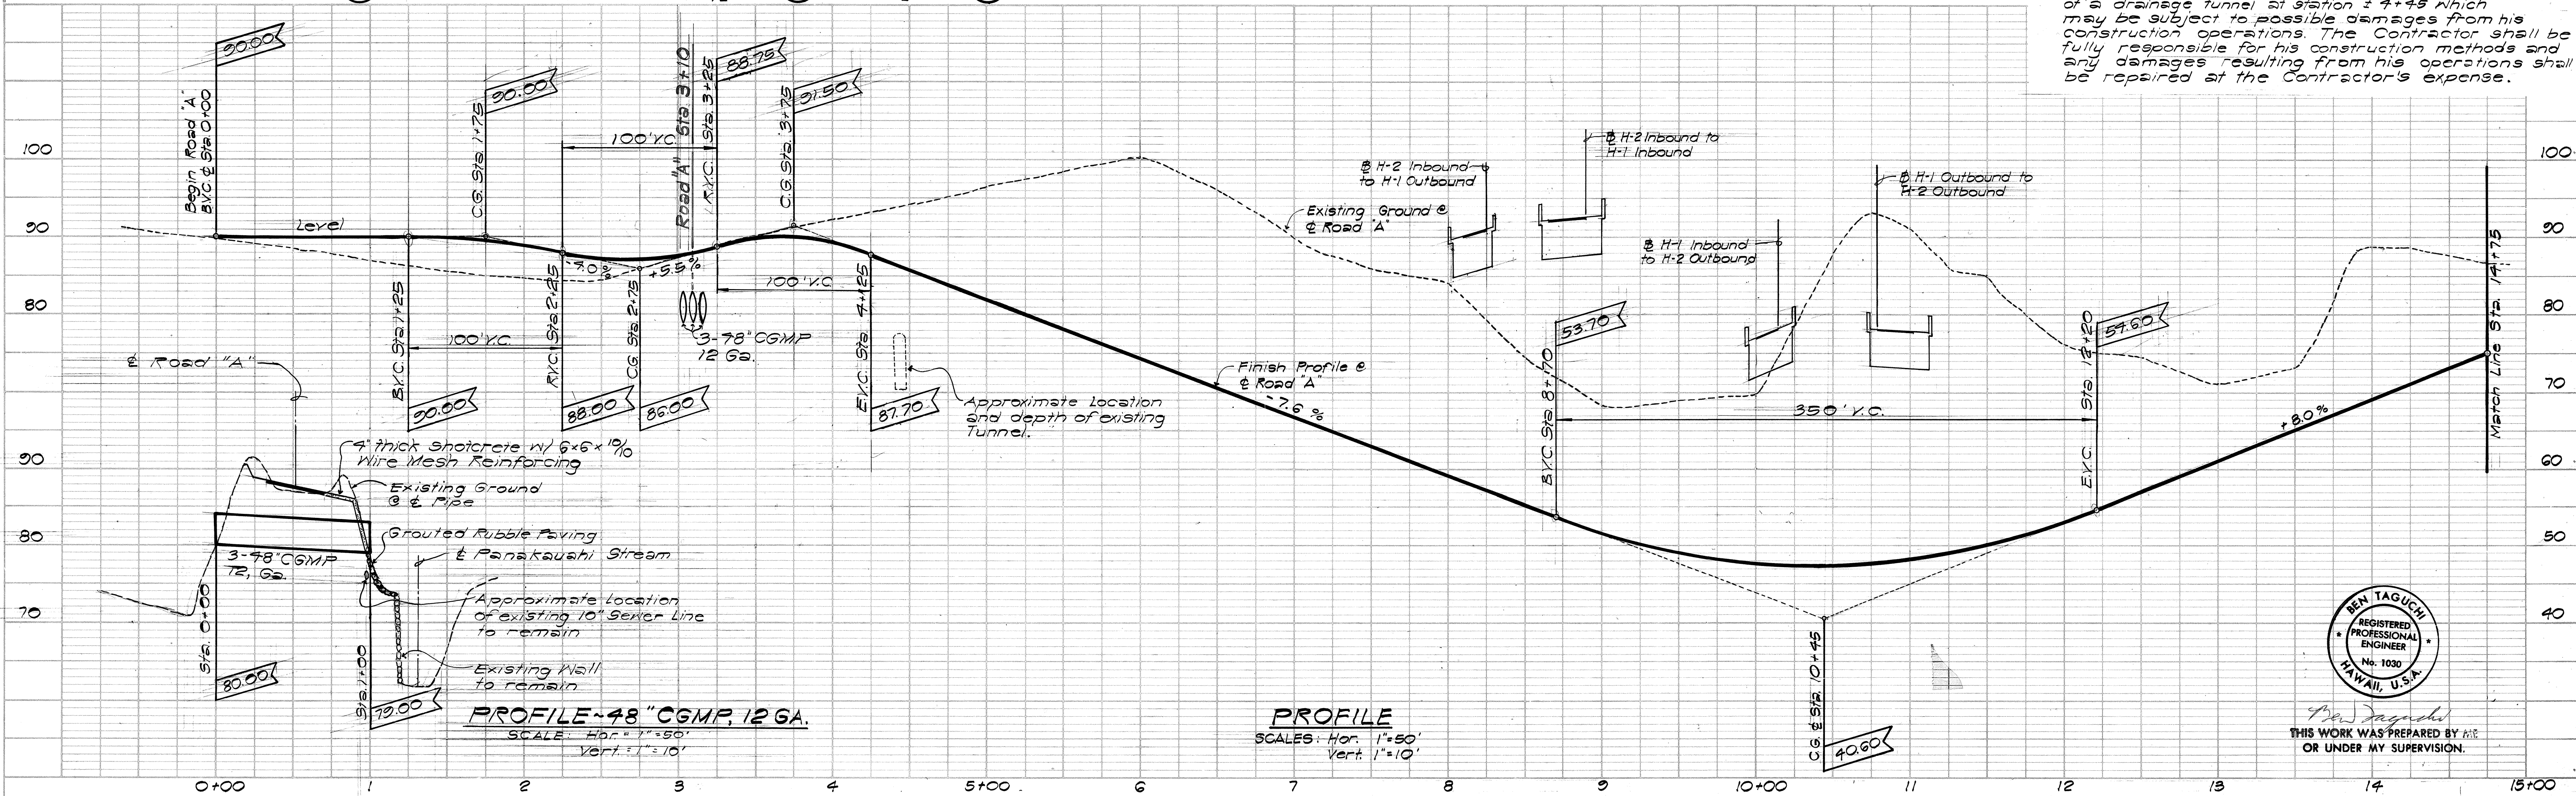

Ben Taguchi
 THIS WORK WAS PREPARED BY ME
 OR UNDER MY SUPERVISION.

PLAN	SURVEYED	DATE
PLANNED	BY	
NOTE BOOK	BY	
RT. UP. HAY CHECKED	BY	
NO.	BY	

PROFILE	SURVEYED	DATE
PLANNED	BY	
NOTE BOOK	BY	
GRADES CHECKED	BY	
STRUCTURE NOTATIONS CHECKED	BY	
NO.	BY	

