FED. ROAD DIST. NO.	STATE	FED. AID PROJ. NO.	FISCAL YEAR	SHEET NO.	TOTAL SHEETS
HAWAII	HAW.	I-HI-1(77):13	1969	1	154

INDEX TO DRAWINGS

SHEET NO.	DESCRIPTION
1	TITLE SHEET
2	GENERAL PLAN
3-5	TYPICAL SECTIONS
6-7	ROADWAY ALIGNMENT PLANS
8-9	ROADWAY PROFILES & S.E. DIAGRAMS
10-11	RAMP TERMINAL DETAILS
12-33	ROADWAY CONSTR. PLANS & DETAILS
34-50	DRAINAGE PLANS & DETAILS
51-54	CONSTR. SEQUENCE & TEMP. SIGNING
55-69	SIGNING PLANS & DETAILS
70-76	HIGHWAY LIGHTING & ELECTRICAL
77-112	UTILITY PLANS & DETAILS
113-114	BORING PROFILES
115-126	STRUCTURAL DRAWINGS
127	BOOSTER STATION WALL
128-133	STANDARD STRUCTURE DETAILS
134-135	CROSS SECTION KEY PLANS
136-154	CROSS SECTIONS

STATE OF HAWAII

DEPARTMENT OF TRANSPORTATION

HIGHWAYS DIVISION

HONOLULU, HAWAII

"AS BUILT"

PLANS FOR

CONSTRUCTION OF A PORTION OF

INTERSTATE ROUTE H-1

HALAWA INTERCHANGE

EAST OF AIEA STREAM TO KAIMAKANI STREET

FEDERAL AID INTERSTATE PROJECT NO. I-HI-1(77):13

DISTRICT OF EWA

ISLAND OF OAHU

SCALES:

PLANS ..... 1" = 50'

PROFILES ..... HOR. 1" = 50'
VER. 1" = 10'

DETAIL ROADWAY PLANS ..... 1" = 50'

CROSS SECTIONS ..... HOR. 1" = 10'
VER. 1" = 10'

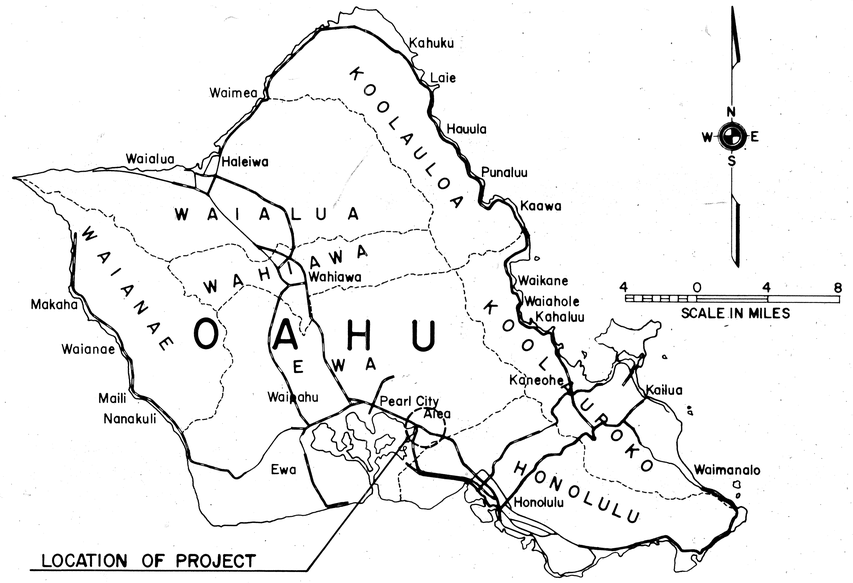

LOCATION OF PROJECT

Federal Aid Projects Previously Constructed or Under Construction

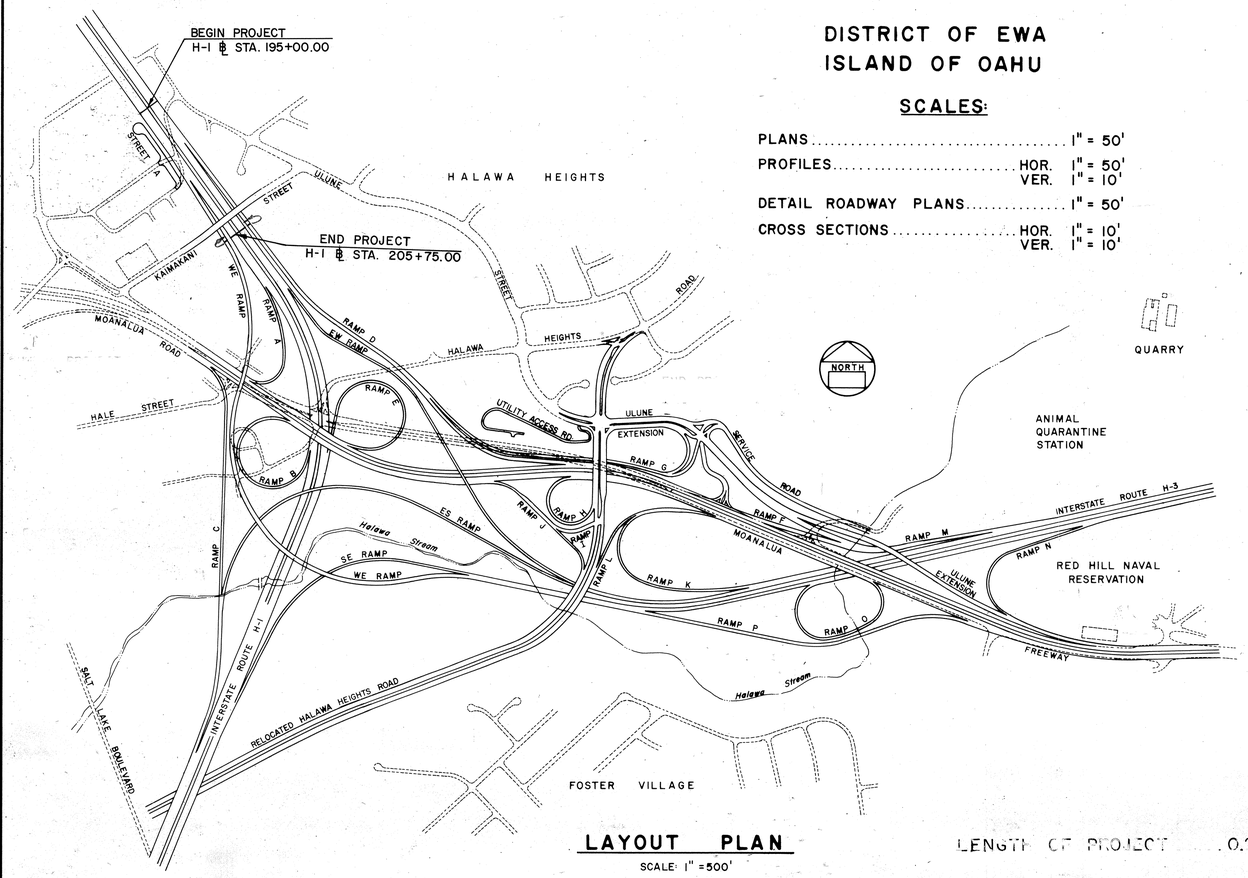

LAYOUT PLAN

SCALE: 1" = 500'

LENGTH OF PROJECT ..... 0.204 MI.

NOTE:

ALL CHANGES MADE DURING CONSTRUCTION HAVE BEEN NOTED IN RED ON THESE TRACINGS AND CHECKED BY:

for PROJECT ENGINEER

JULY 27, 1973

DATE

DESIGN CLASSIFICATION

DESIGN ADT (1990) 113,933

DHV 11,531

D 60/40

T 5%

V ..... 60 MPH

NOTE: "ALL THE QUANTITIES SHOWN ARE ORIGINAL THEORETICAL QUANTITIES. FOR ACTUAL QUANTITIES, REFER TO PROJECT LEDGER AND/OR COMPUTATION BOOK."

DEPARTMENT OF TRANSPORTATION BUREAU OF PUBLIC ROADS	
APPROVED:	
for DIVISION ENGINEER	2/25/70 DATE

DEPARTMENT OF TRANSPORTATION STATE OF HAWAII	
APPROVED:	
for DIR. OF TRANSPORTATION	12/10/69 DATE

R. Mikami December, 1969

DS-2-2/12-22