FED. ROAD DIST. NO.	STATE	FED. AID PROJ. NO.	FISCAL YEAR	SHEET NO.	TOTAL SHEETS
HAWAII	HAW.	I-H1-1 (103)19	1972	32	46

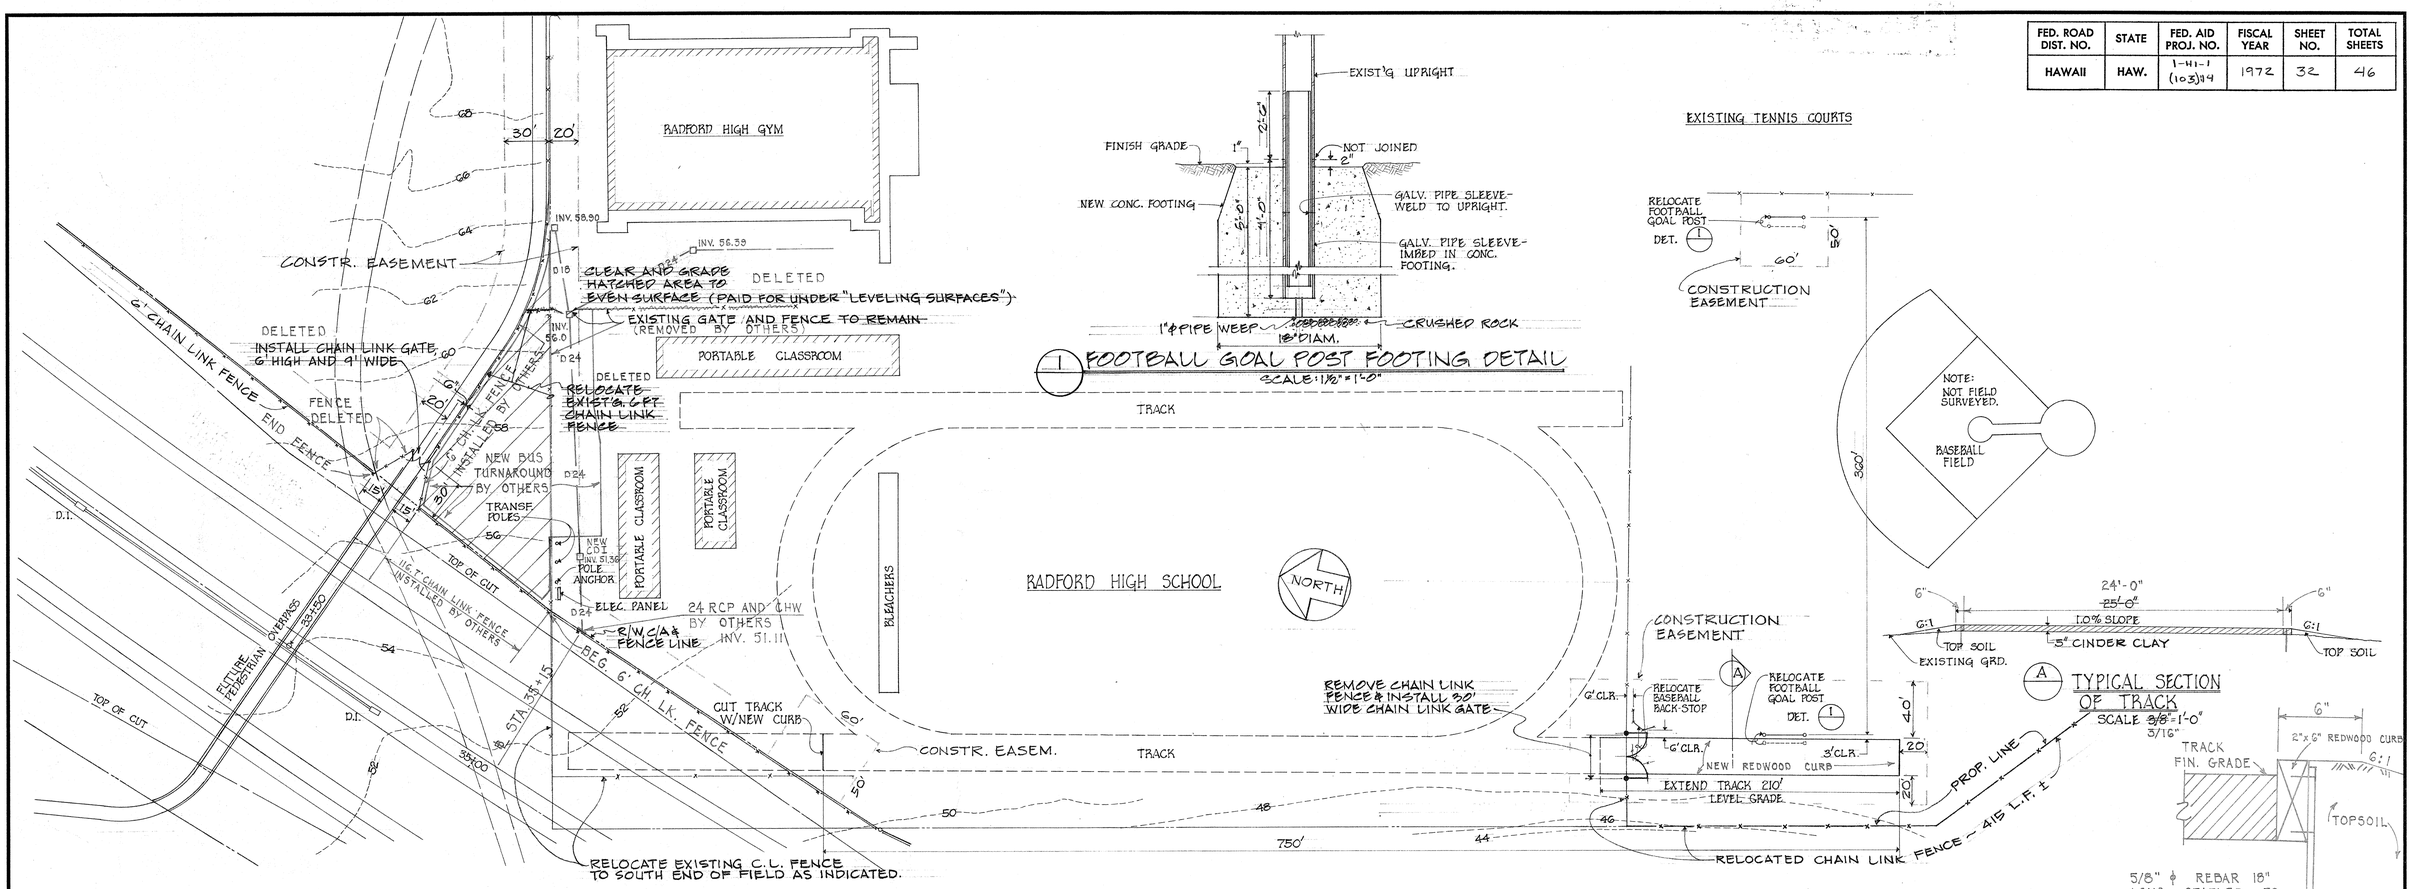

PLAN
SCALE: 1" = 50'

ORIGINAL PLAN		
	SURVEY PLOTTED BY	DATE
	DRAWN BY	"
	TRACED BY	"
NOTE BOOK	DESIGNED BY	"
	QUANTITIES BY	"
No.	CHECKED BY	"

JOHN B. K. SUR & ASSOCIATES, INC.

JOHN B. K. SUR REGISTERED PROFESSIONAL ENGINEER No. 806-E HAWAII, U.S.A.

THIS WORK WAS PREPARED BY ME OR UNDER MY SUPERVISION.

STATE OF HAWAII
DEPARTMENT OF TRANSPORTATION
HIGHWAYS DIVISION

ADJUSTMENTS TO RADFORD HIGH SCHOOL ATHLETIC FIELD

SHEET No. OF SHEETS

32

K+E CRYSTALENE® LA 2920 TRACING PAPER