FED. ROAD DIST. NO.	STATE	FED. AID PROJ. NO.	FISCAL YEAR	SHEET NO.	TOTAL SHEETS
HAWAII	HAW.	I-HI-I(101)8	1972	1	9

INDEX TO DRAWINGS

SHEET NO.	DESCRIPTION
1	Title Sheet
2	Layout Plan
3-7	Erosion Control Planting Plan
8	PROJECT INFORMATION SIGN
9	CONSTRUCTION IDENTIFICATION SIGN

STATE OF HAWAII

DEPARTMENT OF TRANSPORTATION
HIGHWAYS DIVISION

HONOLULU, HAWAII

"AS BUILT"
PLANS FOR

EROSION CONTROL PLANTING

INTERSTATE ROUTE H-1

WAIAWA INTERCHANGE

F. A. I. PROJ. NO. I-HI-I(101):8

DISTRICT OF EWA

ISLAND OF OAHU

SCALE

PLAN . . . . . 1" = 50'

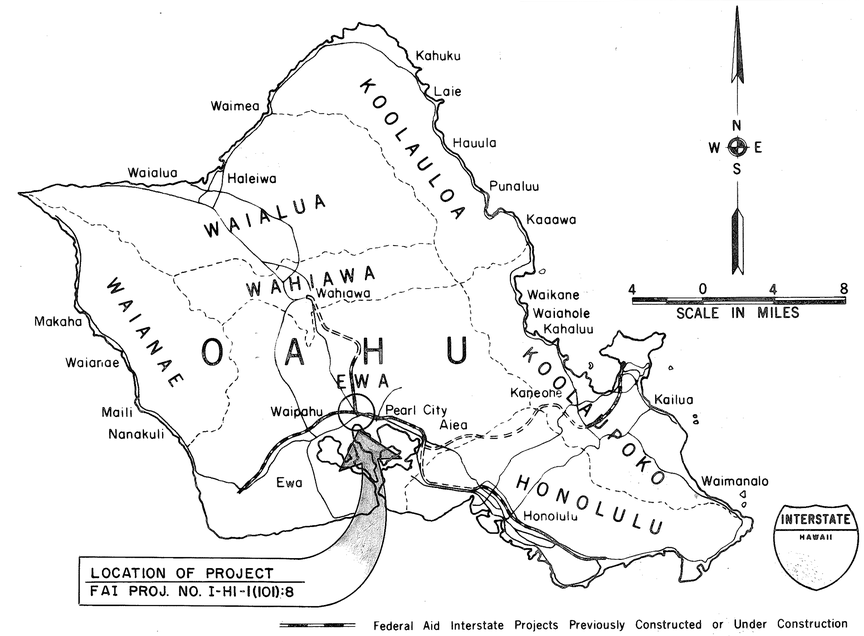

NOTE:
ALL CHANGES MADE DURING CONSTRUCTION HAVE BEEN NOTED IN RED ON THESE TRACINGS AND CHECKED BY:

Sterling H. Morikawa 29 Oct 76
PROJECT ENGINEER DATE

NOTE:
Refer to sheet No. 2 for basic interchange configuration and location.

DESIGN CLASSIFICATION

CURRENT ADT (1968)	0
DESIGN ADT (1988)	42,150
DHV	11%
D	65/35
T	3.5%
V	70 m.p.h.

DEPARTMENT OF TRANSPORTATION
FEDERAL HIGHWAY ADMINISTRATION
APPROVED:
Ralph T. Segawa 5.13.72
DIVISION ENGINEER DATE

DEPARTMENT OF TRANSPORTATION
STATE OF HAWAII
APPROVED:
Munny Lee 2/8/72
For DIR. OF TRANSPORTATION DATE

DESIGNED BY H. Tao P. S. & E. BY 548-7532 PHONE May, 1972 DATE