FED. ROAD DIST. NO.	STATE	FED. AID PROJ. NO.	FISCAL YEAR	SHEET NO.	TOTAL SHEETS
HAWAII	HAW.	I-HI-1(97):8	1973	1	27

INDEX TO DRAWINGS

SHEET NO.	DESCRIPTION
1	COVER SHEET
2	AREA LOCATION SHEET
3	GENERAL NOTES
4-8	SPRINKLER PLAN
9-10	WATER MAIN PROFILE
11S-1	ISOMETRIC DIAG. OF BRANCHES
12	MISC. PIPING DETAILS
13	MISC. DETAILS
△14	IRRIGATION SCHEDULE
15	CONTROL DIAGRAM
16-18	SUMMARY SHEETS
19-27	LANDSCAPE PLANS

Sheet Nos. 11S-1, △14S-1, 14S-2, & 14S-3 Control Wire Location for Controllers J, K, & L are supplementary sheets to this project.

NEW TOTAL SHEET COUNT: 31 Sheets

STATE OF HAWAII

DEPARTMENT OF TRANSPORTATION
HIGHWAYS DIVISION

HONOLULU, HAWAII

"AS BUILT"

PLANS FOR CONSTRUCTION OF A PORTION OF

INTERSTATE ROUTE H-1

WAIAWA INTERCHANGE

LANDSCAPING AND SPRINKLER SYSTEM H-2 SECTION

FEDERAL AID INTERSTATE PROJECT No. I-H1-1(97):8

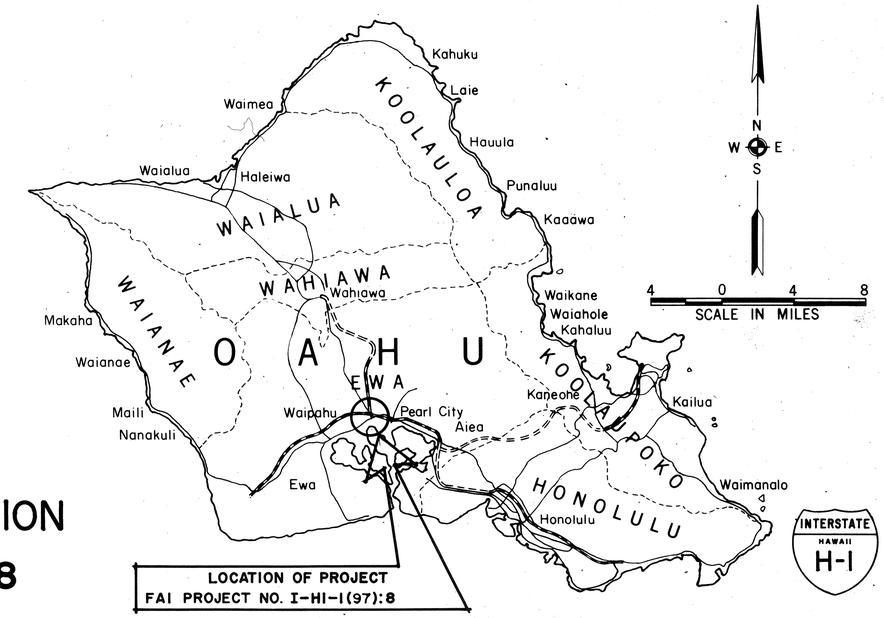

DISTRICT OF EWA, ISLAND OF OAHU

Herbert Tao — P. S. & E. BY
548-6932 — PHONE
May, 1973 — DATE

SCALES

PROFILE	HOR.	1" = 50'
	VERT.	1" = 5'
DETAIL ROADWAY PLAN		1" = 50'

DESIGN CLASSIFICATION

CURRENT ADT (1968)	0
DESIGN ADT (1988)	56,900
DHV	10%
D	60/40
T	35%
V	70 mph

NOTE:

REFER TO SHEET NO. 2 FOR BASIC INTERCHANGE CONFIGURATION AND LOCATION.

NOTE:
ALL CHANGES MADE DURING CONSTRUCTION HAVE BEEN INCORPORATED ON THESE PLANS IN RED.

ALL THE QUANTITIES SHOWN ARE ORIGINAL THEORETICAL QUANTITIES. FOR ACTUAL QUANTITIES, REFER TO PROJECT LEDGER AND/OR COMPUTATION BOOK.

for RESIDENT ENGINEER — 11-5-81 DATE