FED. ROAD DIST. NO.	STATE	FED. AID PROJ. NO.	FISCAL YEAR	SHEET NO.	TOTAL SHEETS
HAWAII	HAW.	I-HI-1(19)16	1975	194	200

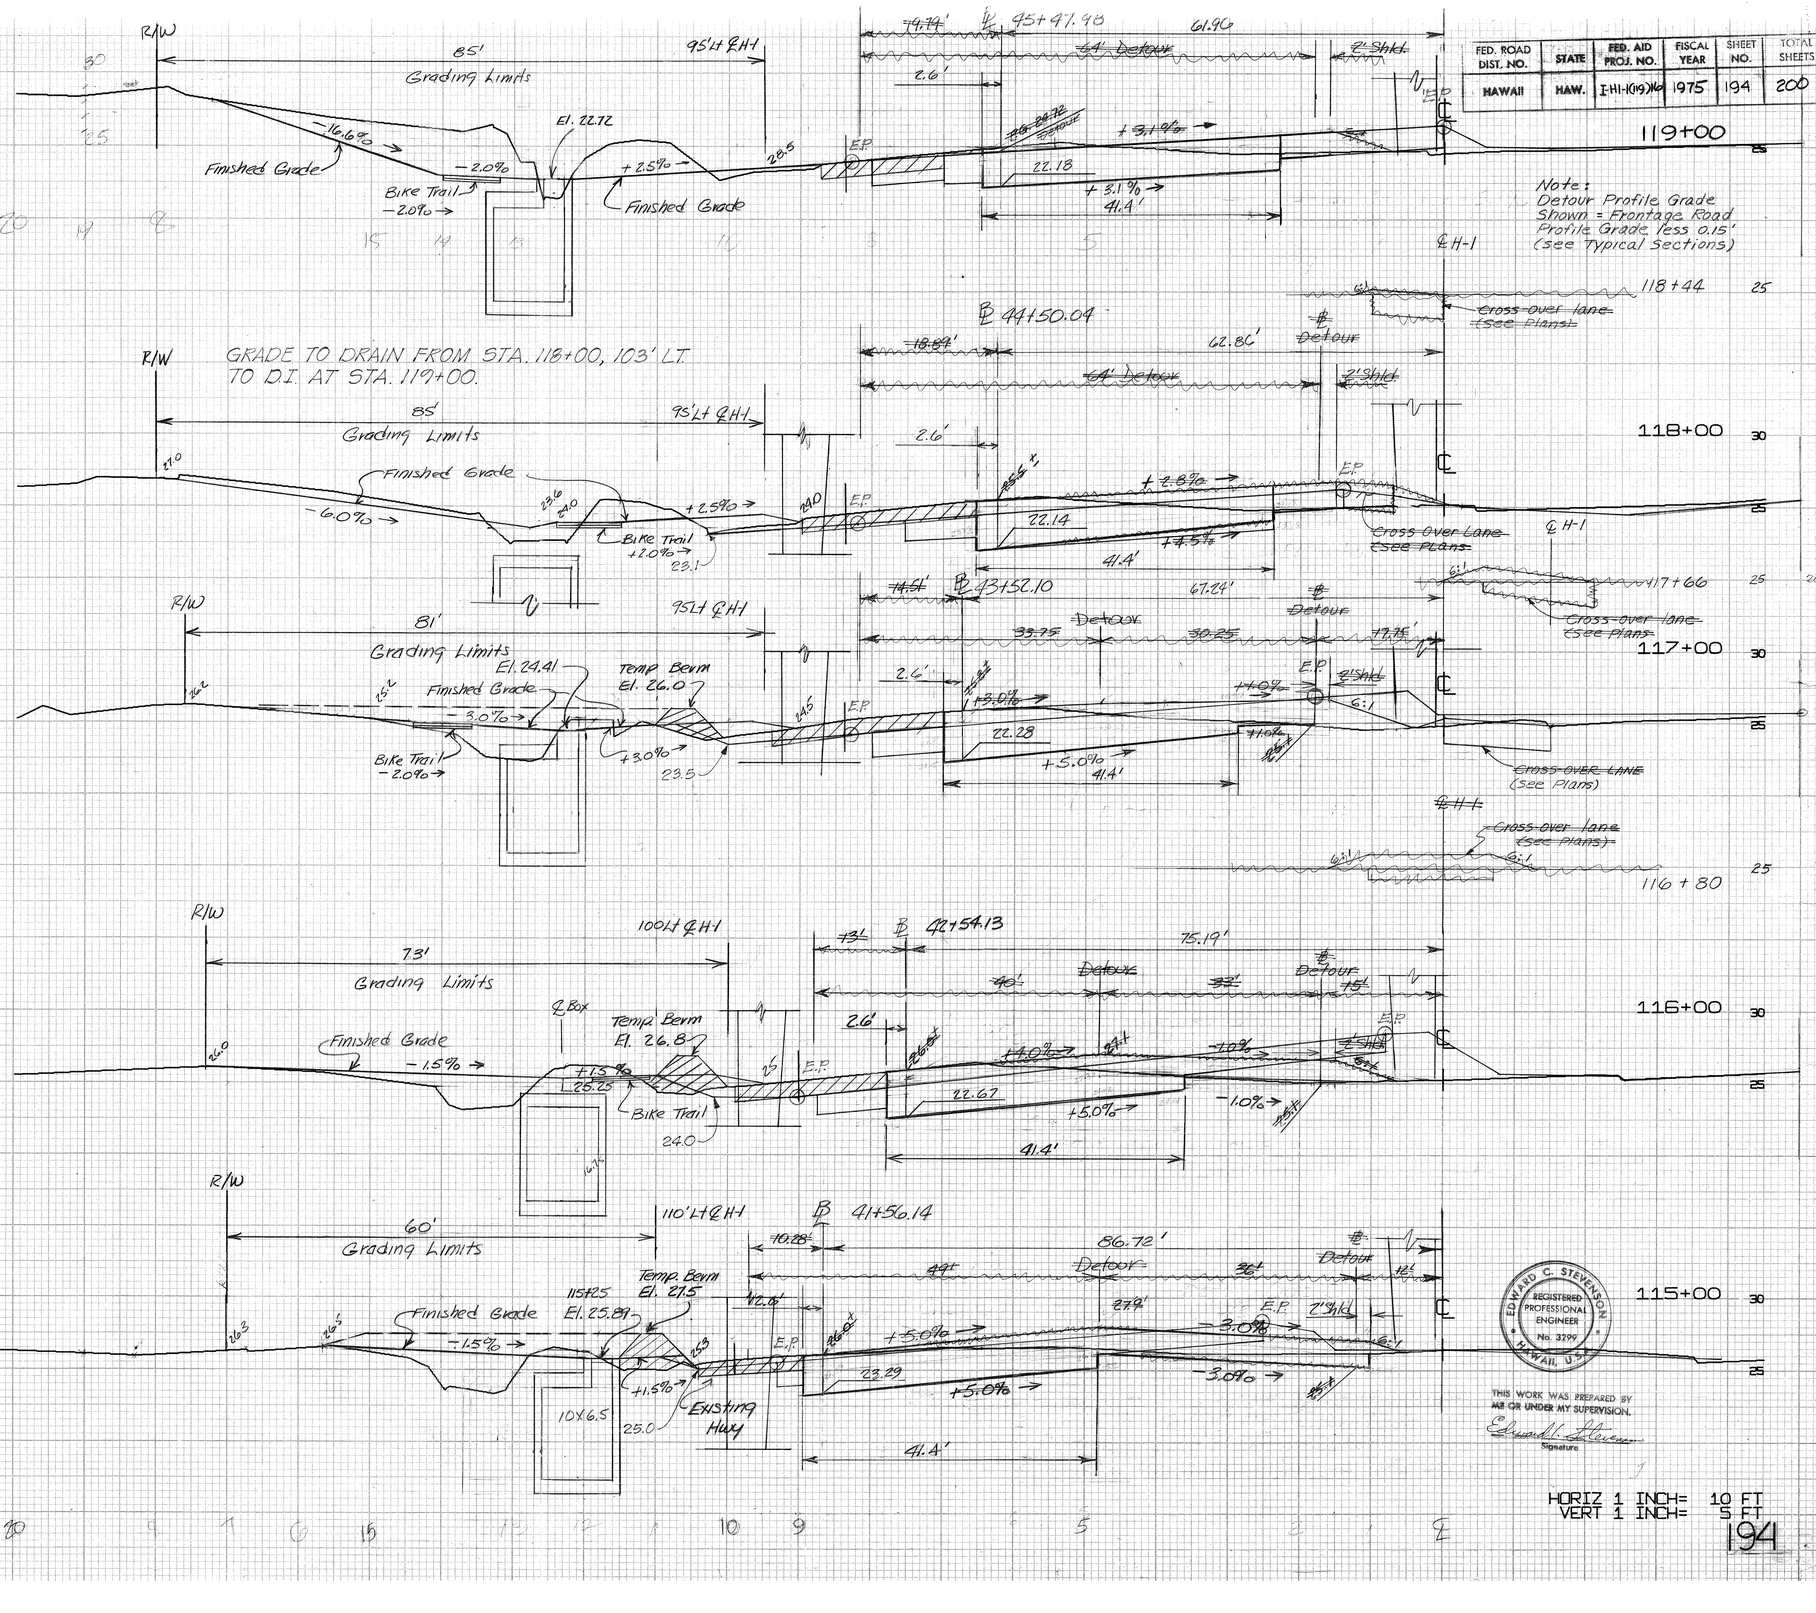

HORIZ 1 INCH= 10 FT
VERT 1 INCH= 5 FT

194

FED. ROAD DIST. NO.	STATE	FED. AID PROJ. NO.	FISCAL YEAR	SHEET NO.	TOTAL SHEETS
HAWAII	HAW.	I-HI-1(19)16	1975	195	200

Note:
Detour Profile Grade Shown = Frontage Road Profile Grade less 0.15'
(See Typical Sections)

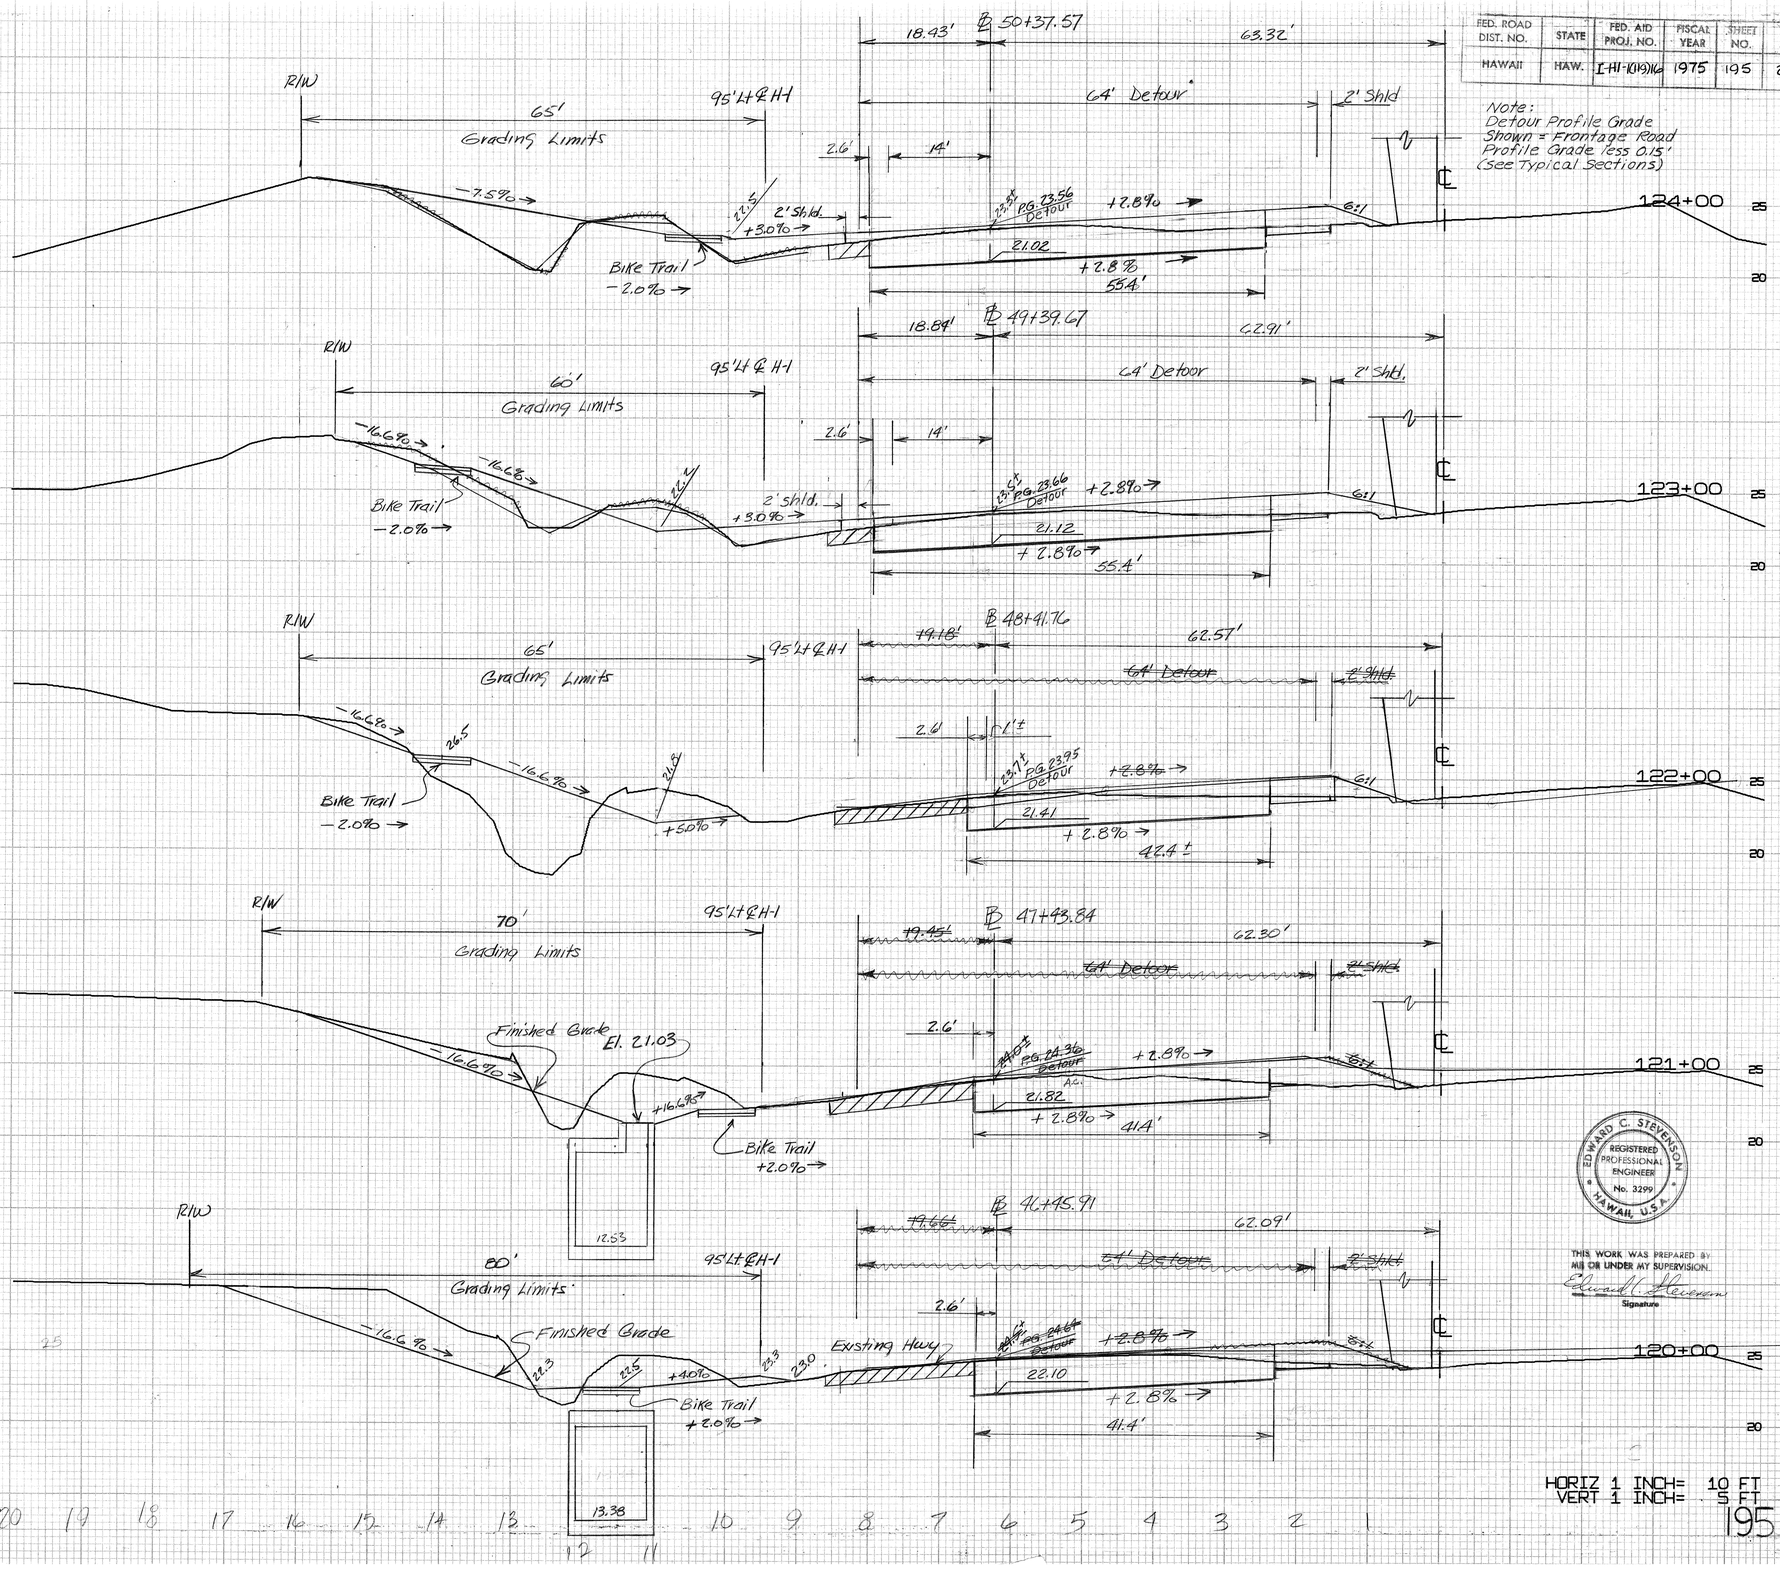

EDWARD C. STEVENSON
REGISTERED PROFESSIONAL ENGINEER
No. 3299
HAWAII, U.S.A.

THIS WORK WAS PREPARED BY ME OR UNDER MY SUPERVISION.
Edward C. Stevenson
Signature

HORIZ 1 INCH= 10 FT
VERT 1 INCH= 5 FT

FED. ROAD DIST. NO.	STATE	FED. AID PROJ. NO.	FISCAL YEAR	SHEET NO.	TOTAL SHEETS
HAWAII	HAW.	I-HH-019(16)	1975	196	200

MAUKA ℄ EQUATION

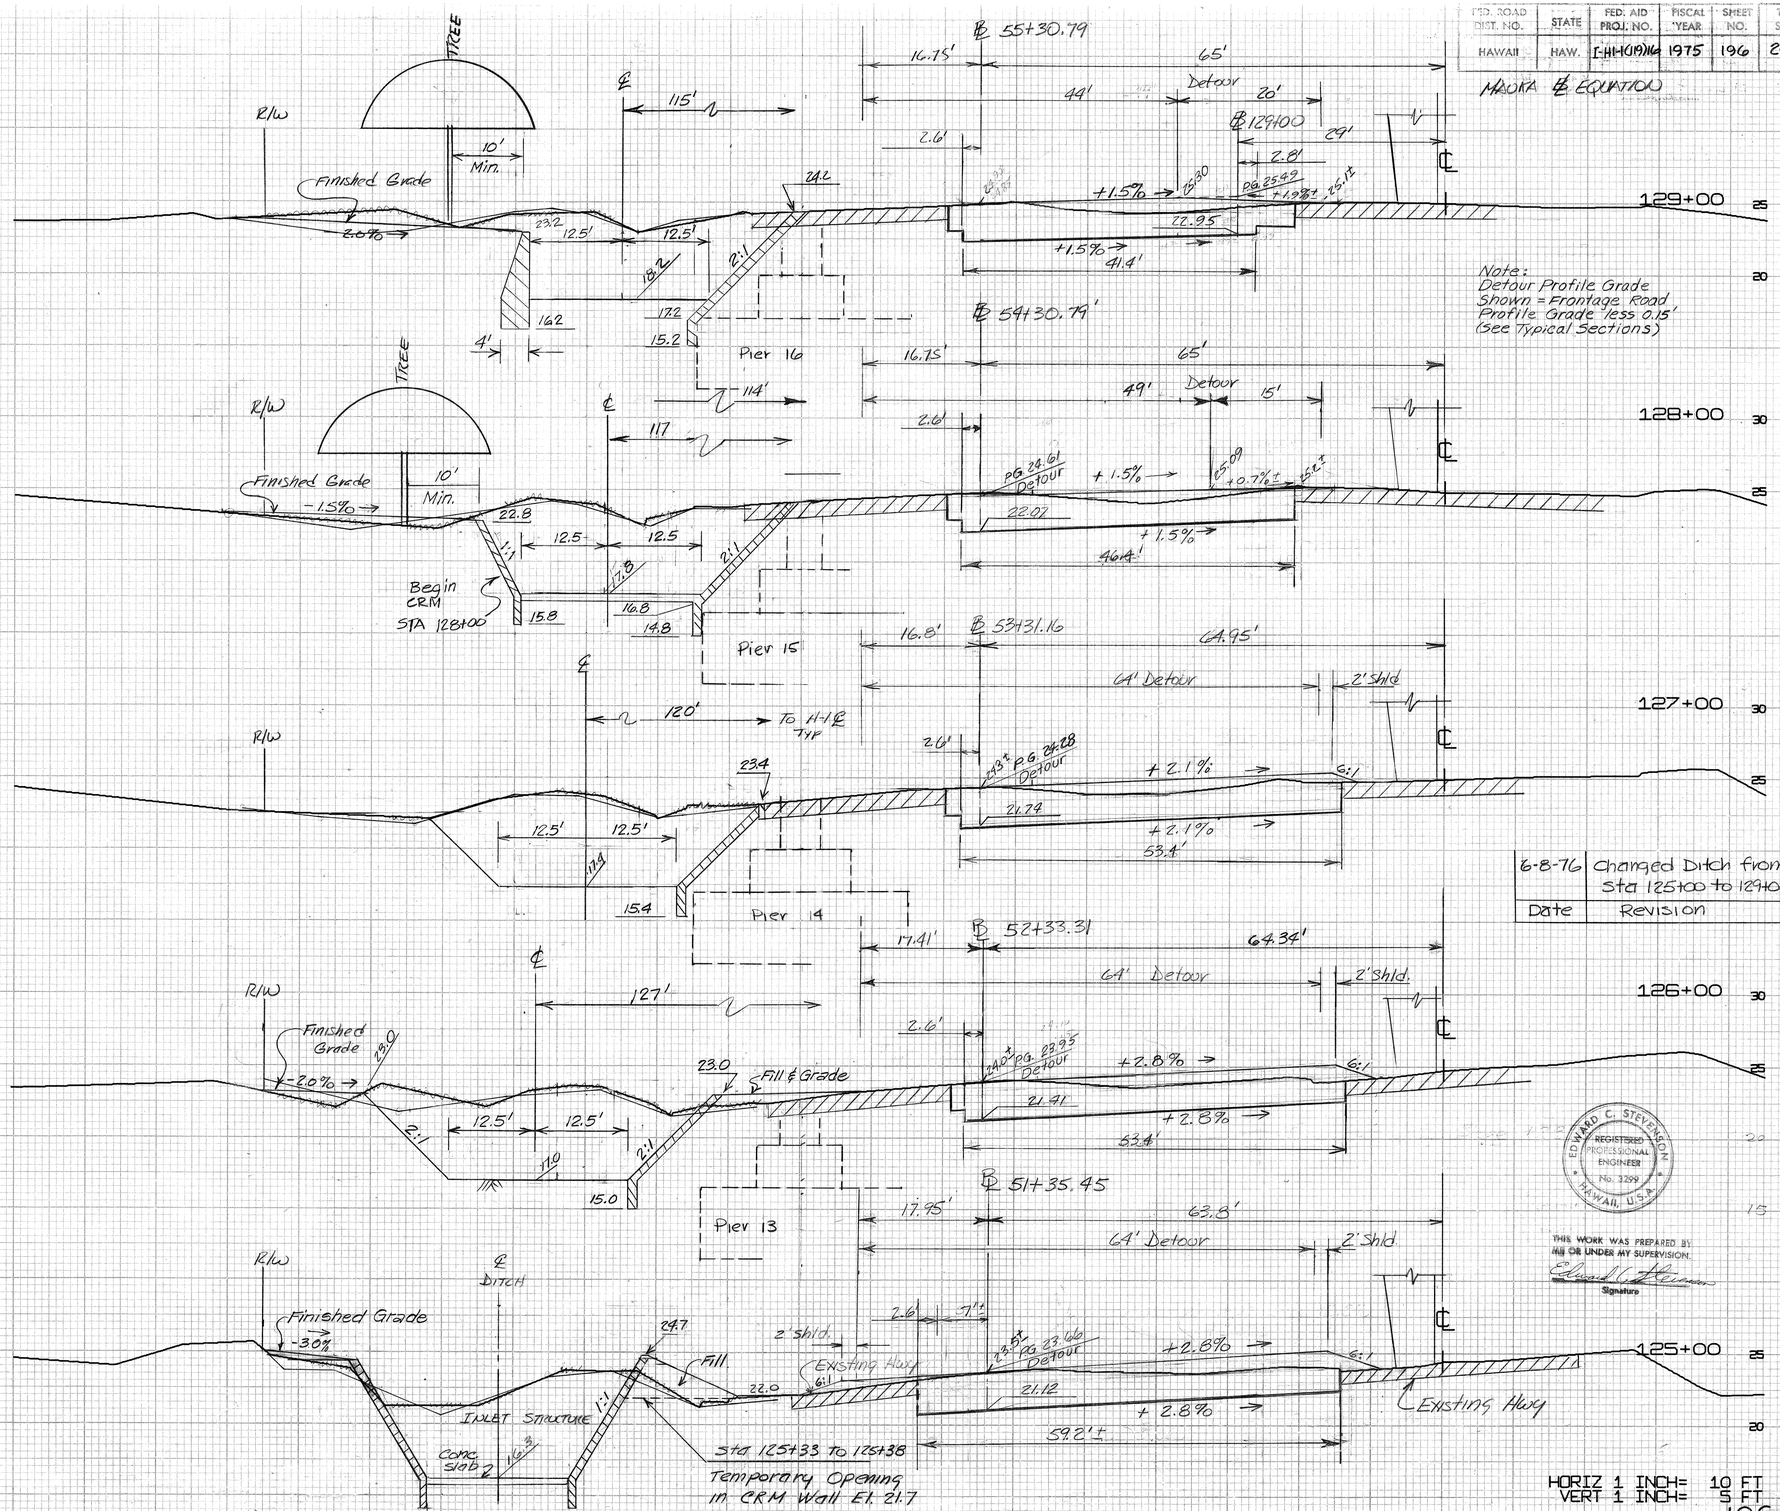

Date	Revision
6-8-76	Changed Ditch from Sta 125+00 to 129+00

EDWARD C. STEVENSON
REGISTERED PROFESSIONAL ENGINEER
No. 3299
HAWAII, U.S.A.

THIS WORK WAS PREPARED BY ME OR UNDER MY SUPERVISION.
Signature

HORIZ 1 INCH= 10 FT
VERT 1 INCH= 5 FT

FED. ROAD DIST. NO.	STATE	FED. AID PROJ. NO.	FISCAL YEAR	SHEET NO.	TOTAL SHEETS
HAWAII	HAW.	F-HI-(119)16	1975	197	200

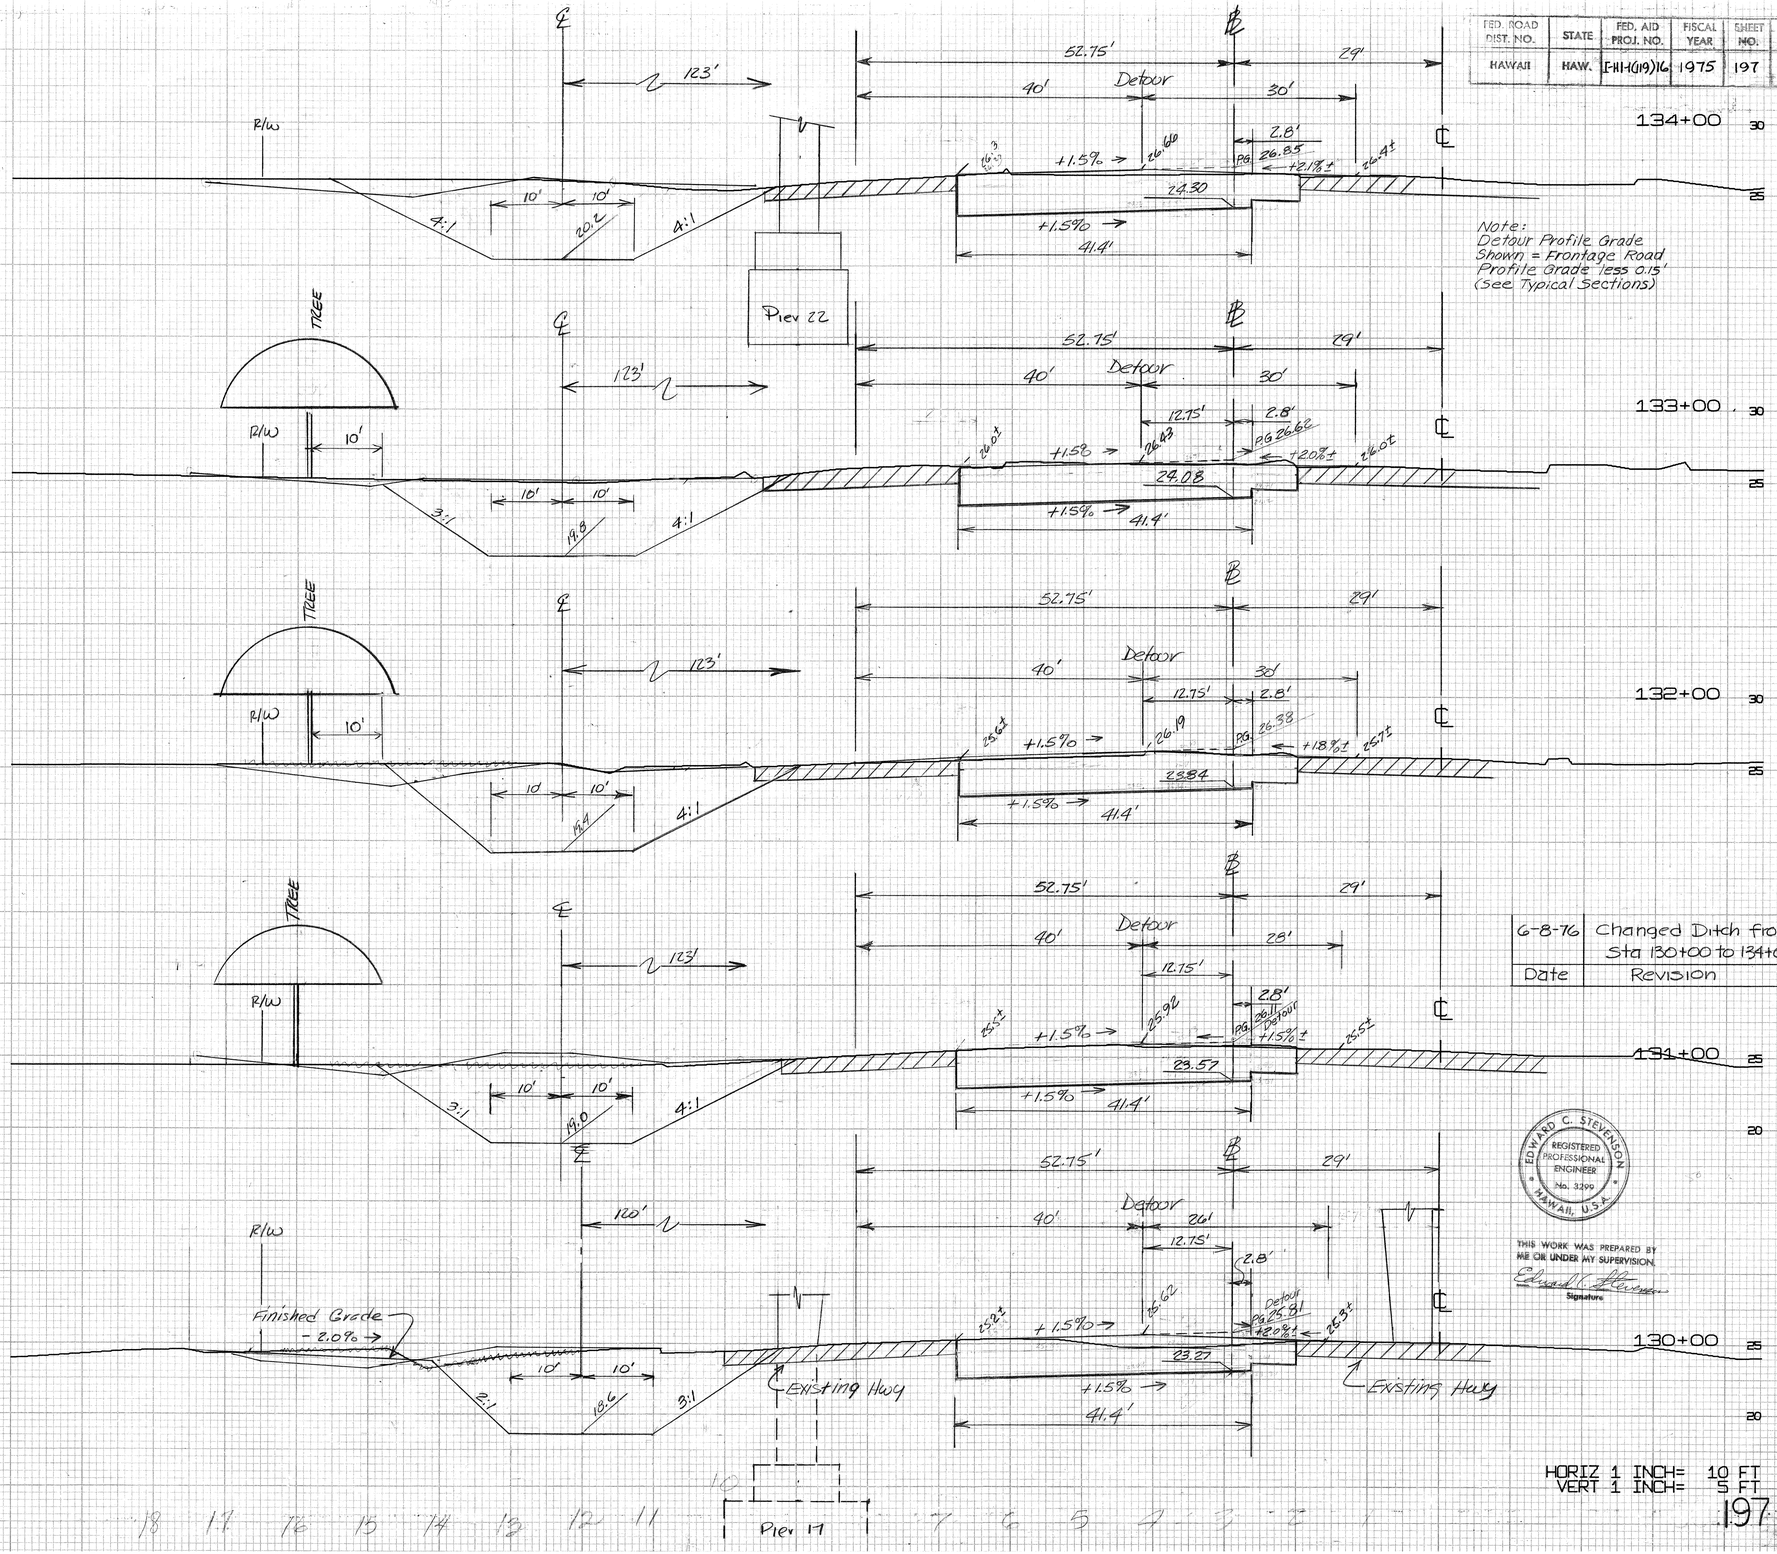

6-8-76	Changed Ditch from Sta 130+00 to 134+00
Date	Revision

EDWARD C. STEVENSON
REGISTERED PROFESSIONAL ENGINEER
No. 3299
HAWAII, U.S.A.

THIS WORK WAS PREPARED BY ME OR UNDER MY SUPERVISION.
Signature

HORIZ 1 INCH= 10 FT
VERT 1 INCH= 5 FT

FED. ROAD DIST. NO.	STATE	FED. AID PROJ. NO.	FISCAL YEAR	SHEET NO.	TOTAL SHEETS

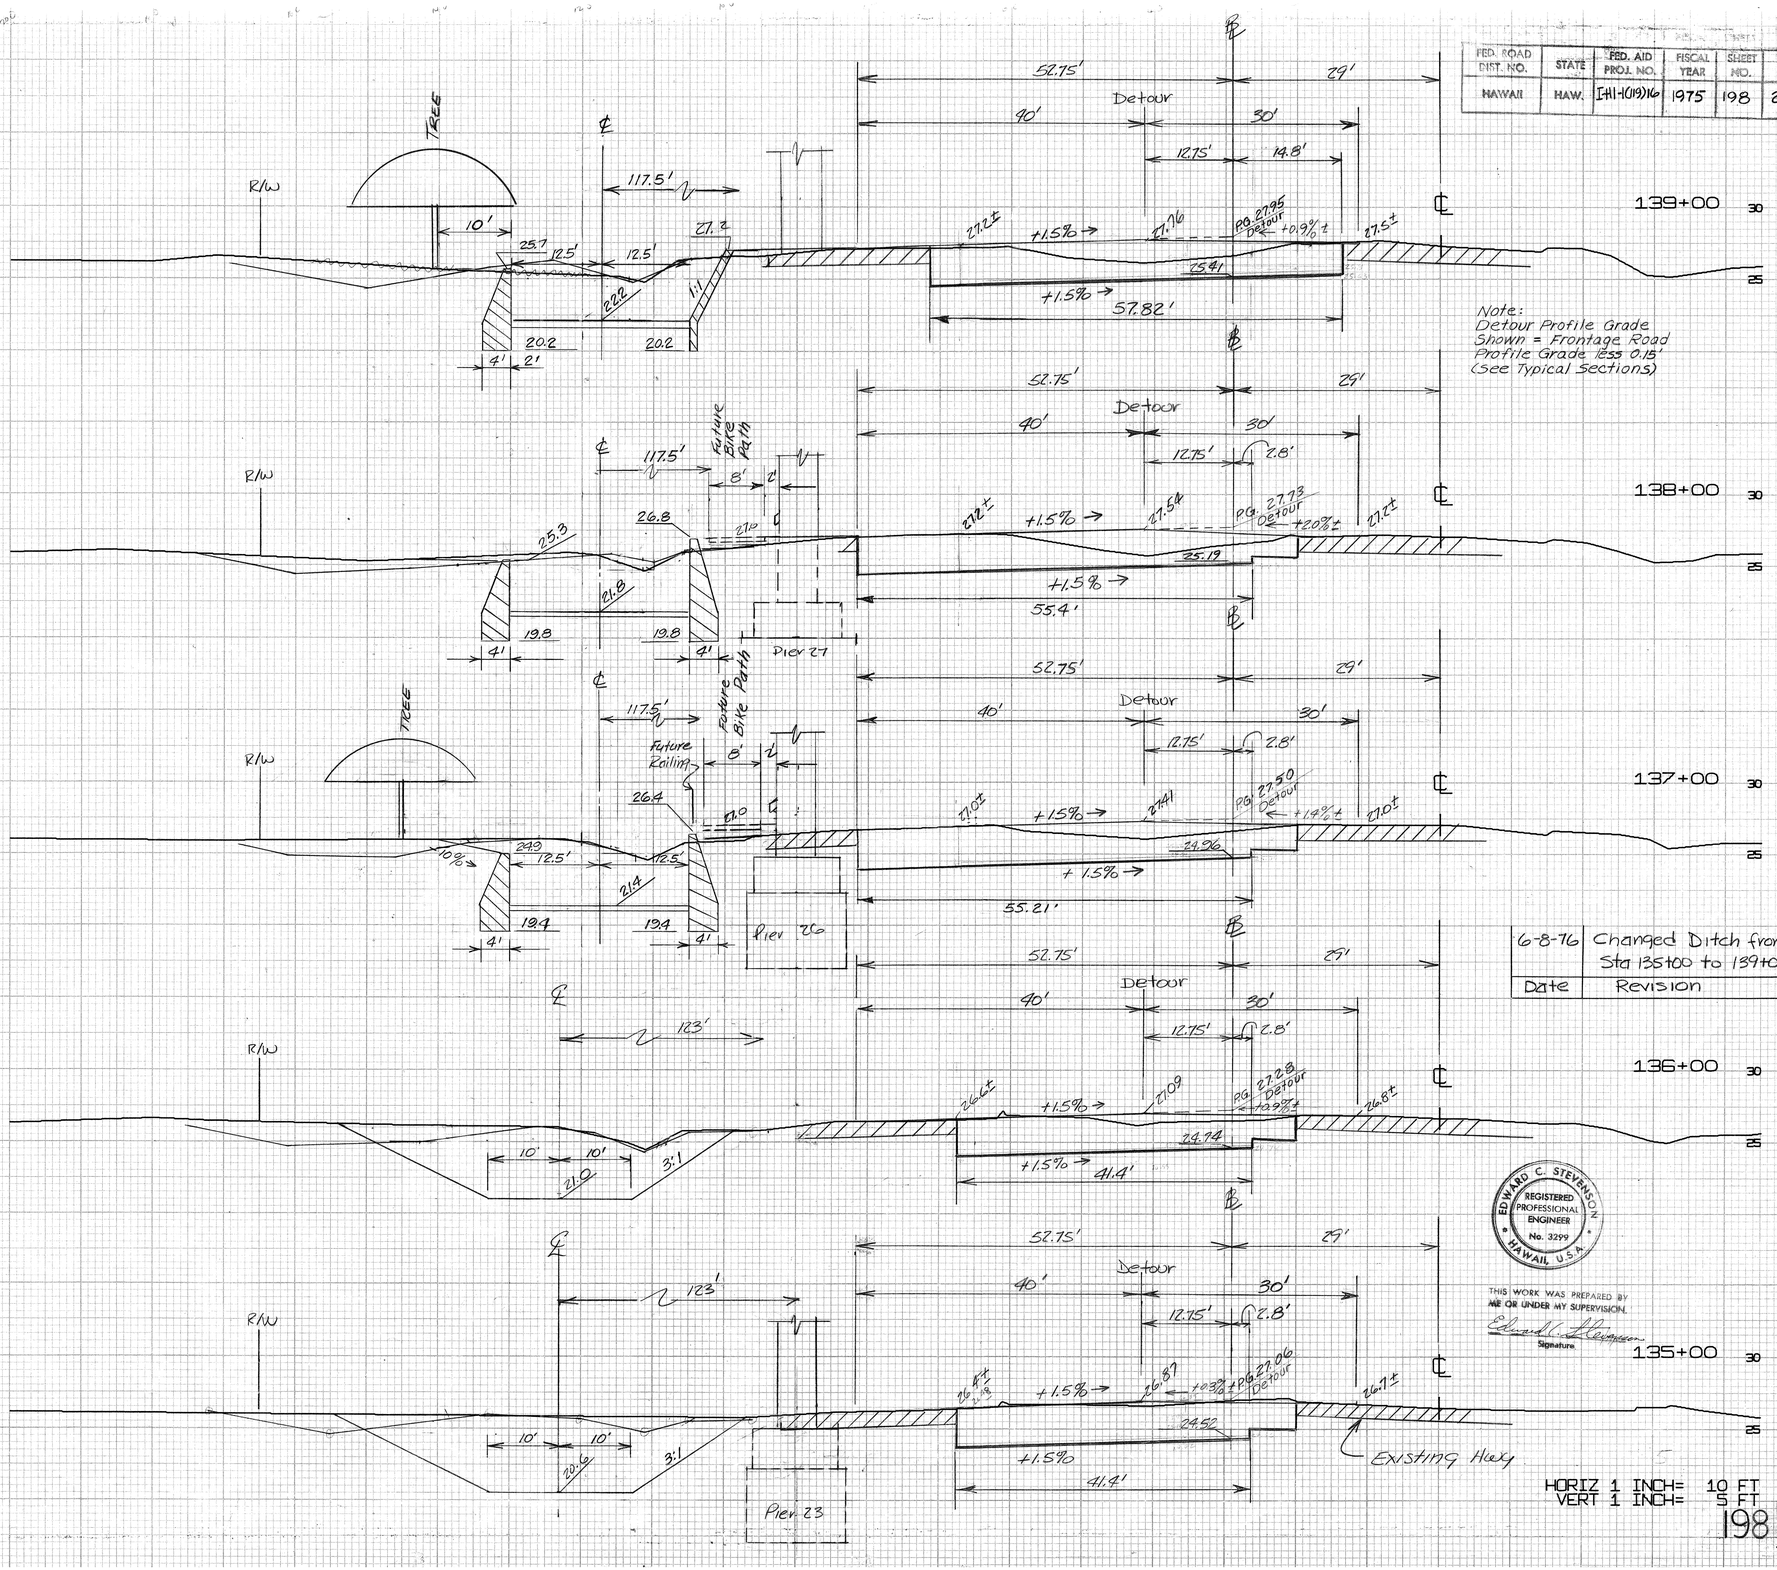

FED. ROAD DIST. NO.	STATE	FED. AID PROJ. NO.	FISCAL YEAR	SHEET NO.	TOTAL SHEETS
HAWAII	HAW.	[HI-7(119)16	1975	199	200

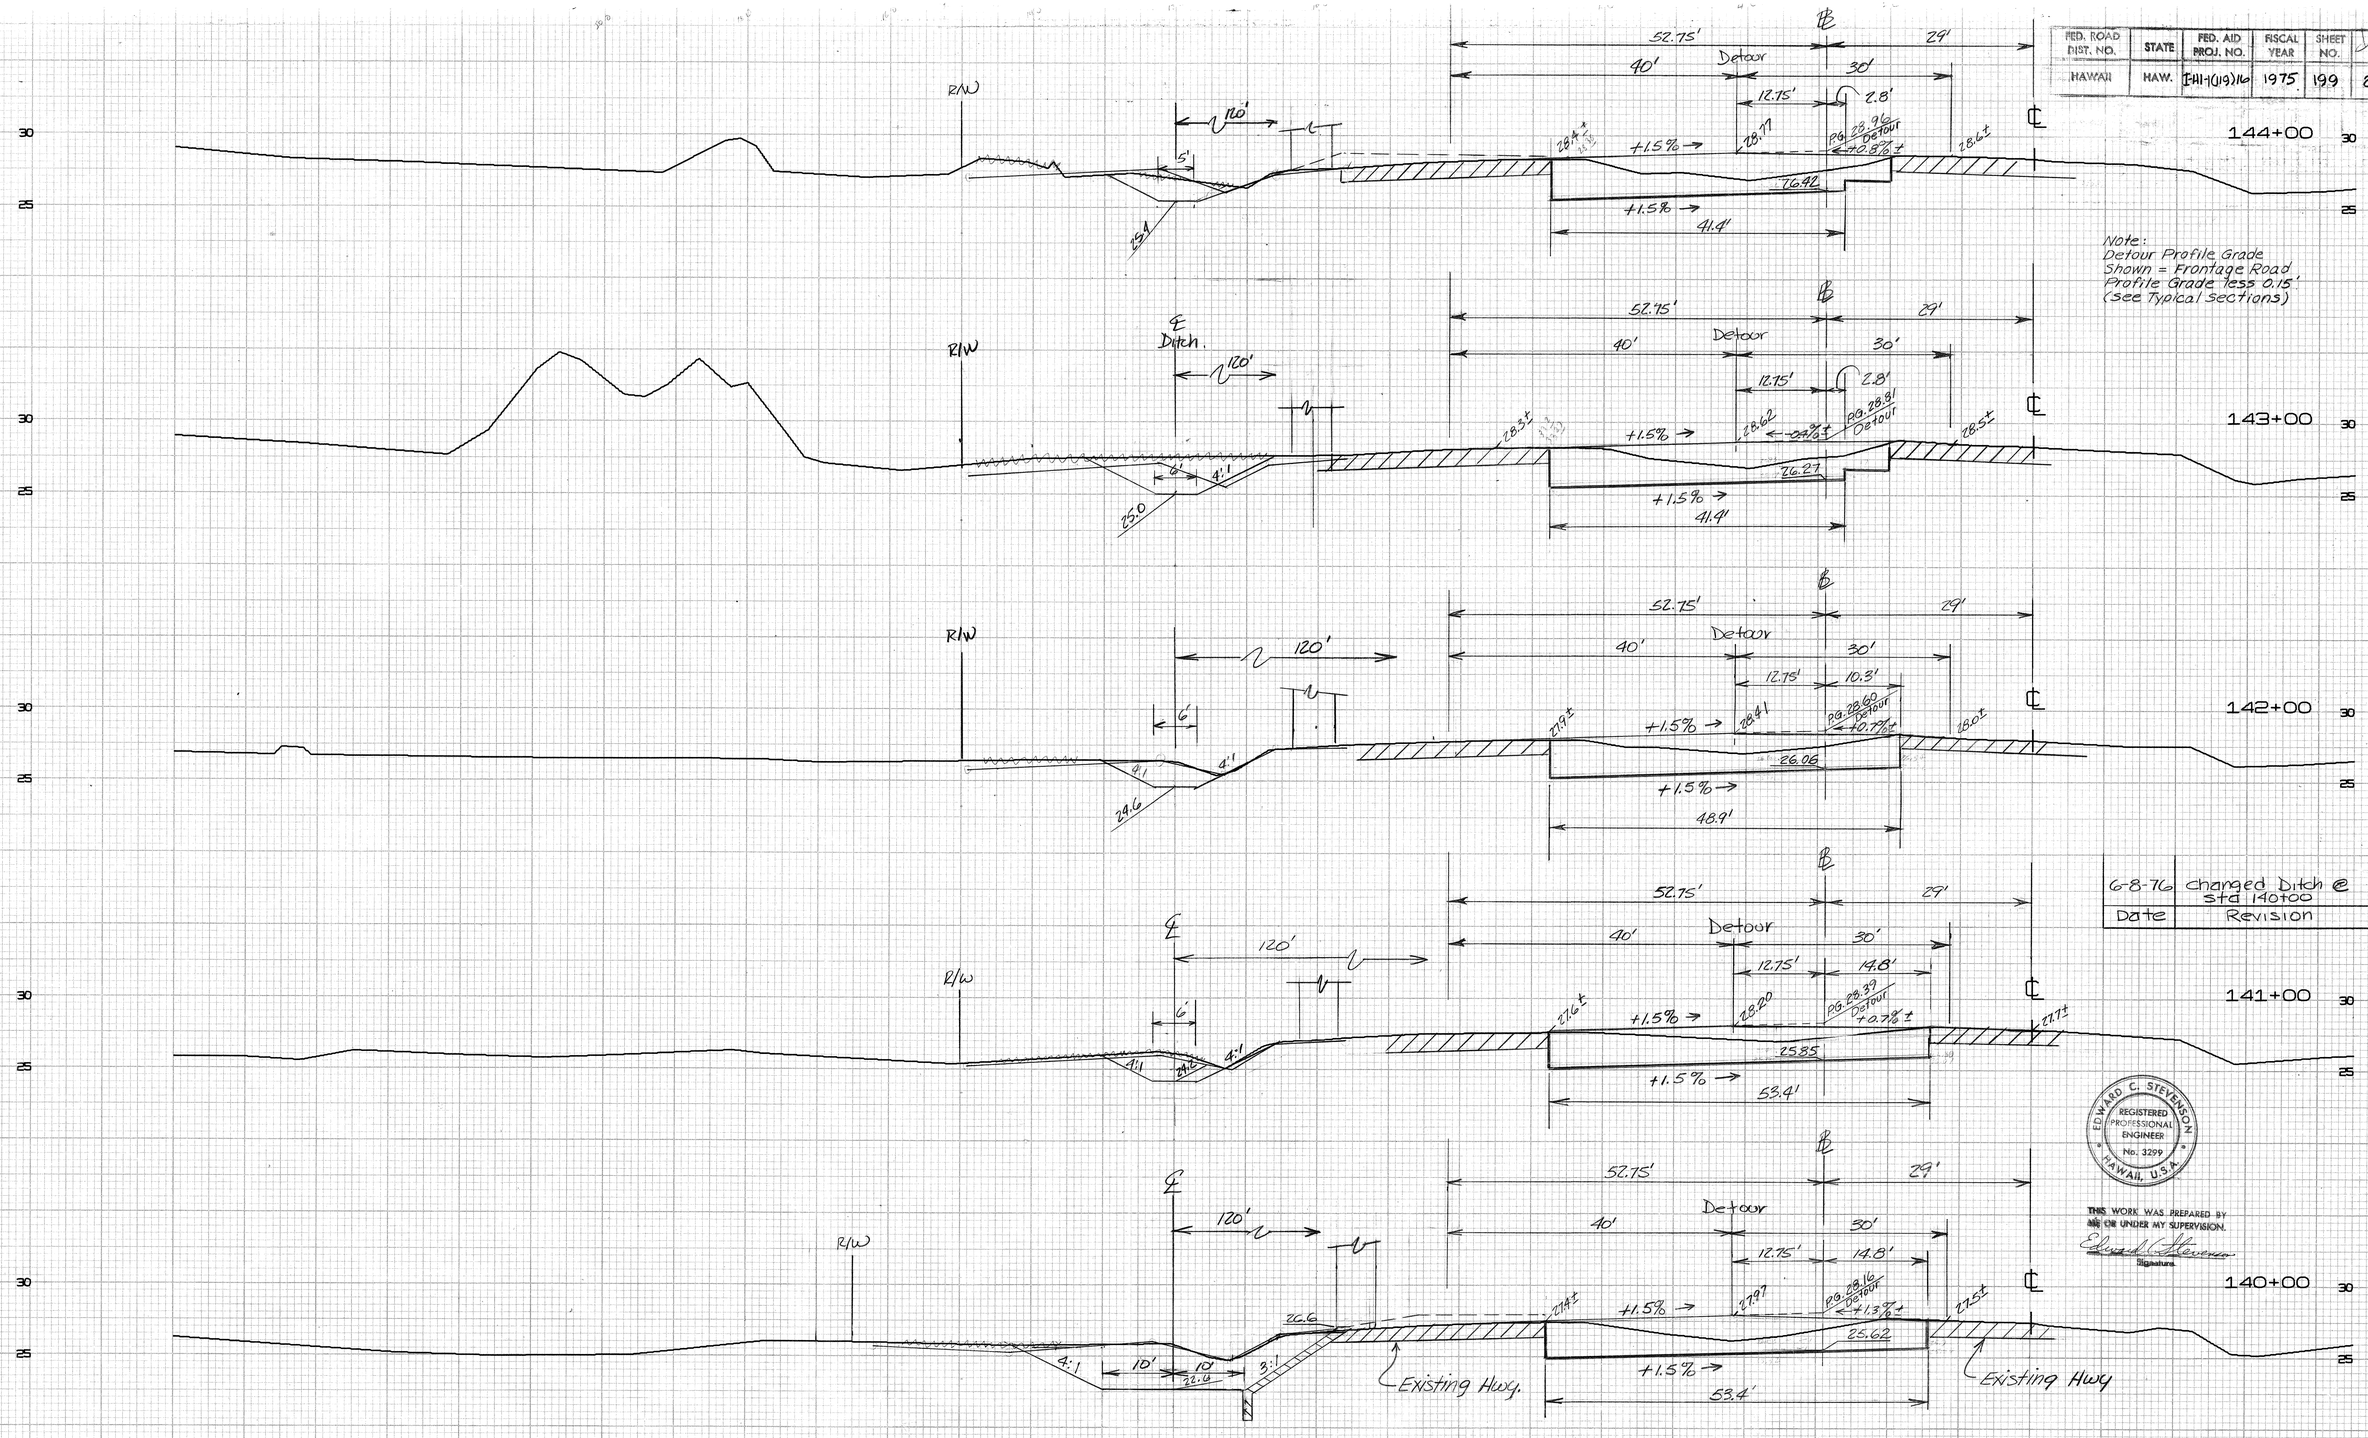

Note:
Detour Profile Grade Shown = Frontage Road Profile Grade less 0.15' (See Typical Sections)

Date	Revision
6-8-76	Changed Ditch @ Sta 140+00

EDWARD C. STEVENSON
REGISTERED PROFESSIONAL ENGINEER
No. 3299
HAWAII, U.S.A.

THIS WORK WAS PREPARED BY ME OR UNDER MY SUPERVISION.
Signature

HORIZ 1 INCH= 10 FT
VERT 1 INCH= 5 FT

FED. ROAD DIST. NO.	STATE	FED. AID PROJ. NO.	FISCAL YEAR	SHEET NO.	TOTAL SHEETS
HAWAII	HAW.	I-HI-1(119)16	1975	200	200

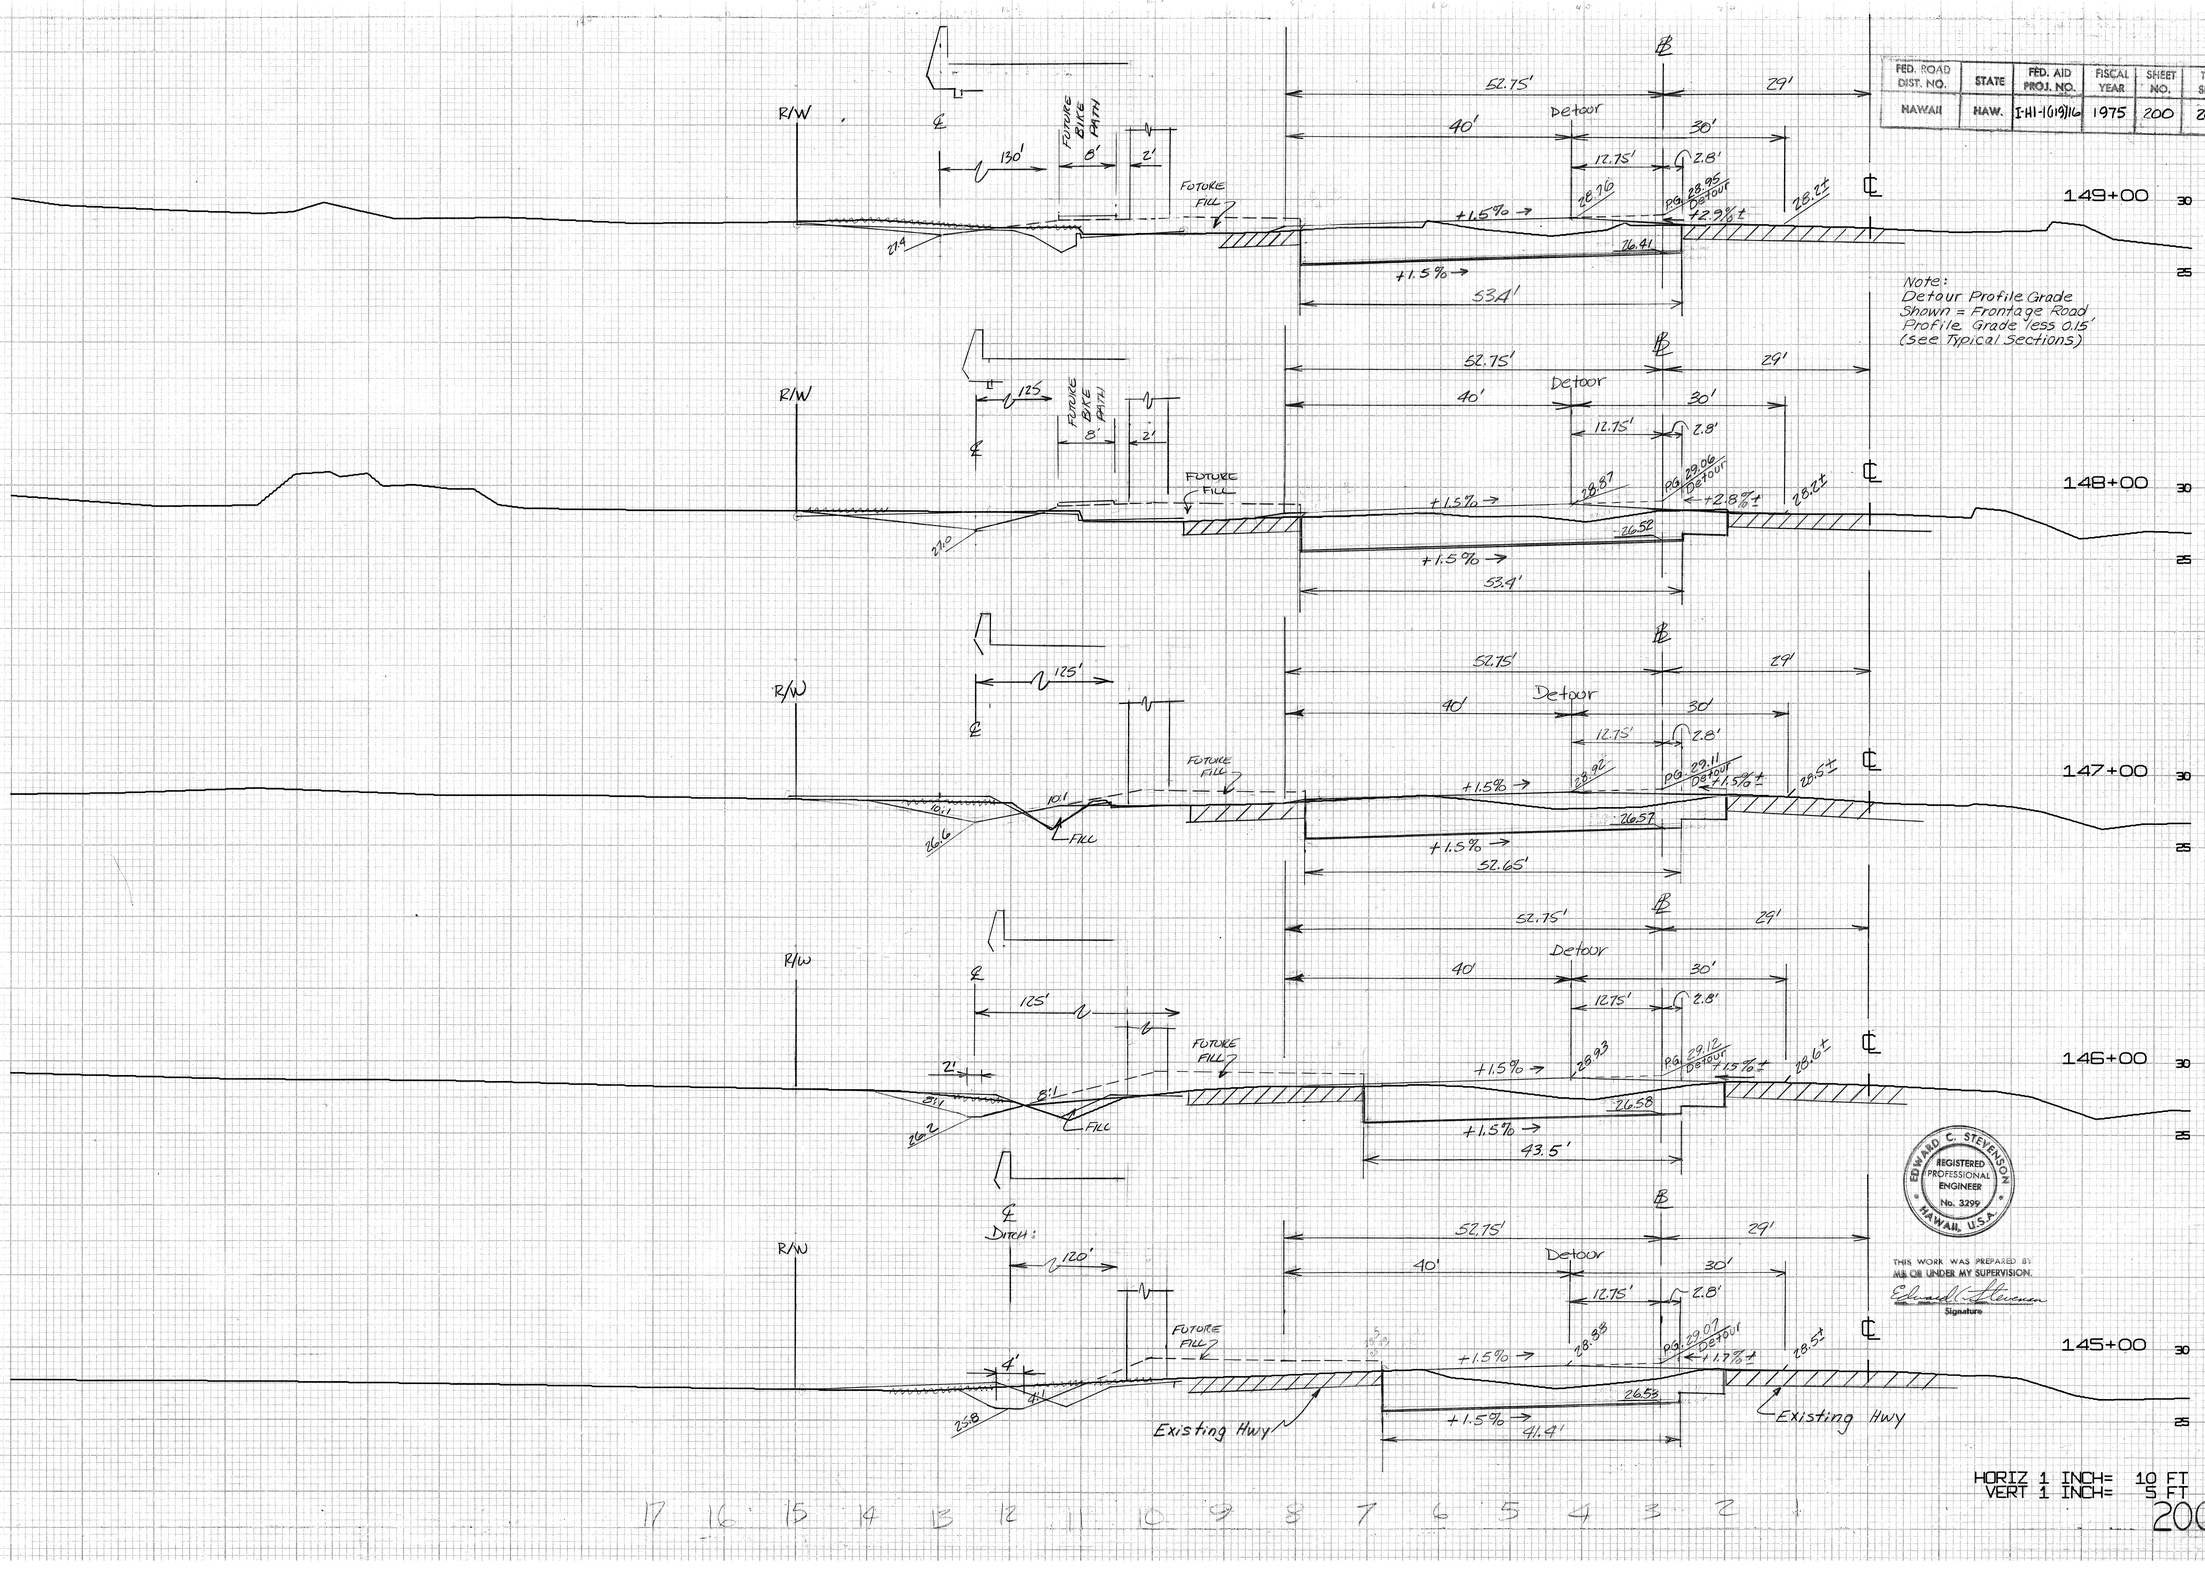

Note:
Detour Profile Grade Shown = Frontage Road Profile Grade less 0.15' (see Typical Sections)

EDWARD C. STEVENSON
REGISTERED PROFESSIONAL ENGINEER
No. 3299
HAWAII, U.S.A.

THIS WORK WAS PREPARED BY ME OR UNDER MY SUPERVISION.
Signature

HORIZ 1 INCH= 10 FT
VERT 1 INCH= 5 FT

17 16 15 14 13 12 11 10 9 8 7 6 5 4 3 2 1

200