FED. ROAD DIST. NO.	STATE	PROJ. NO.	FISCAL YEAR	SHEET NO.	TOTAL SHEETS
HAWAII	HAW.	HI-01-75 HWY-0-0472	1975	1	17

INDEX TO DRAWINGS	
SHEET NO.	DESCRIPTION
1	TITLE SHEET
2-5	PROJECT NO. HI-01-75
6-15	PROJECT NO. HWY-0-04-72
16-17	SPRINKLER DETAILS

STATE OF HAWAII

DEPARTMENT OF TRANSPORTATION
HIGHWAYS DIVISION

HONOLULU, HAWAII

PLANS OF

CONVERSION OF MANUAL SPRINKLER SYSTEMS TO AUTOMATIC CONTROL ALONG INTERSTATE ROUTE H-1, PUNCHBOWL ST. TO AINAKOA AVE.

PUNCHBOWL STREET TO KEEAUMOKU STREET
PROJECT NO. HI-01-75

KAPIOLANI INTERCHANGE TO AINAKOA AVENUE
PROJECT NO. HWY-0-04-72

DISTRICT OF HONOLULU
ISLAND OF OAHU

"AS BUILT PLANS"

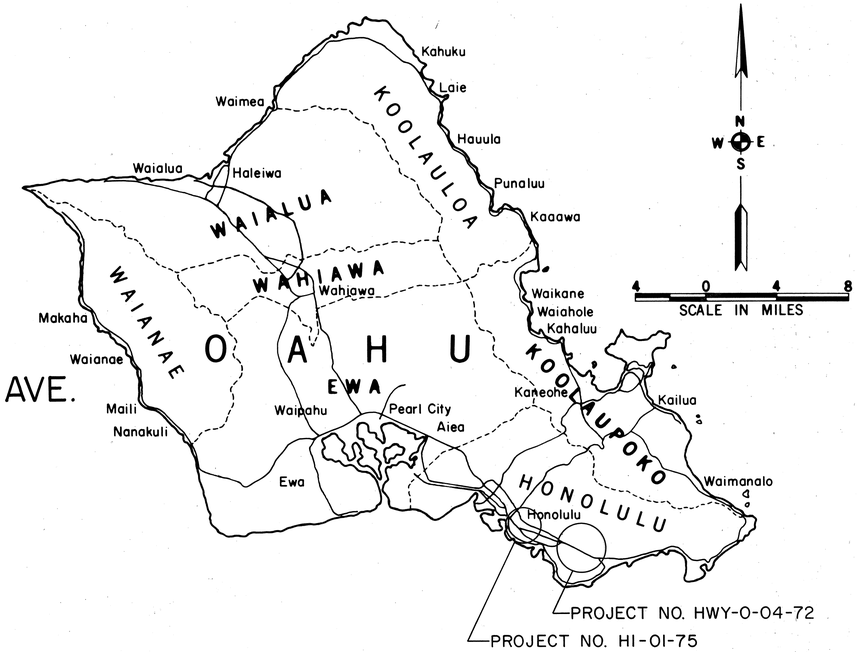

NOTE:
ALL CHANGES MADE DURING CONSTRUCTION HAVE BEEN INCORPORATED ON THESE PLANS.

Phillip J. Ahncastle
PROJECT ENGINEER

9/10/76
DATE

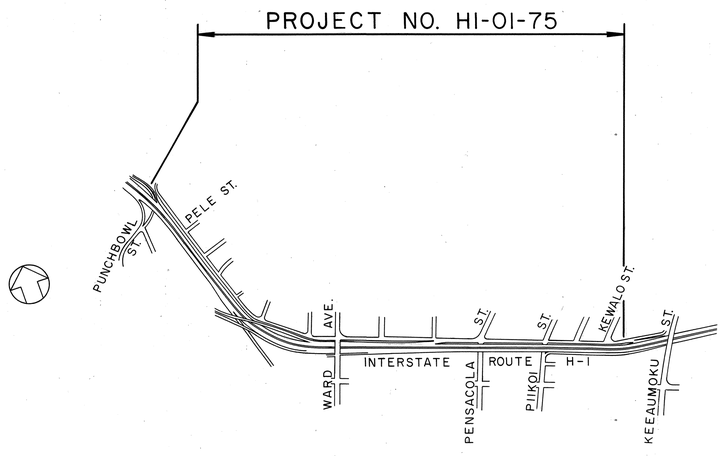

4 0 4 8 12 16 20
SCALE IN HUNDRED FEET

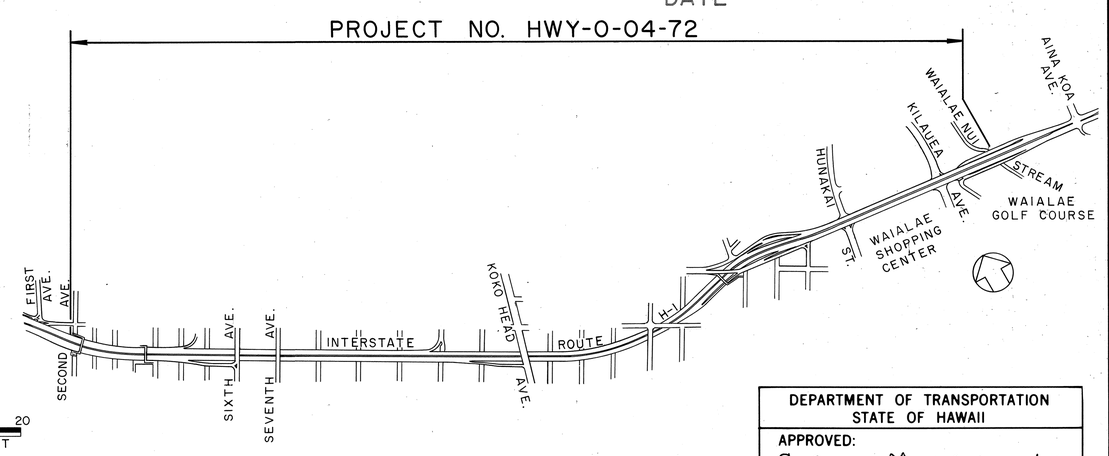

LAYOUT PLANS

DESIGNED BY	D. Bevier	PHONE	548-7537	DATE	Mar. 1975
P. S. & E. BY					

DEPARTMENT OF TRANSPORTATION
STATE OF HAWAII
APPROVED:
E. Alvey Wright 12/19/74
DIR. OF TRANSPORTATION DATE