
FED. ROAD DIST. NO.	STATE	PROJ. NO.	YEAR	SHEET NO.	TOTAL SHEETS
HAWAII	HAW.	I-HI-1(121)16	1975	195	207

Note:
Detour Profile Grade Shown = Mauka Fr. Rd. Profile Grade less 0.15' (See Typical Section)

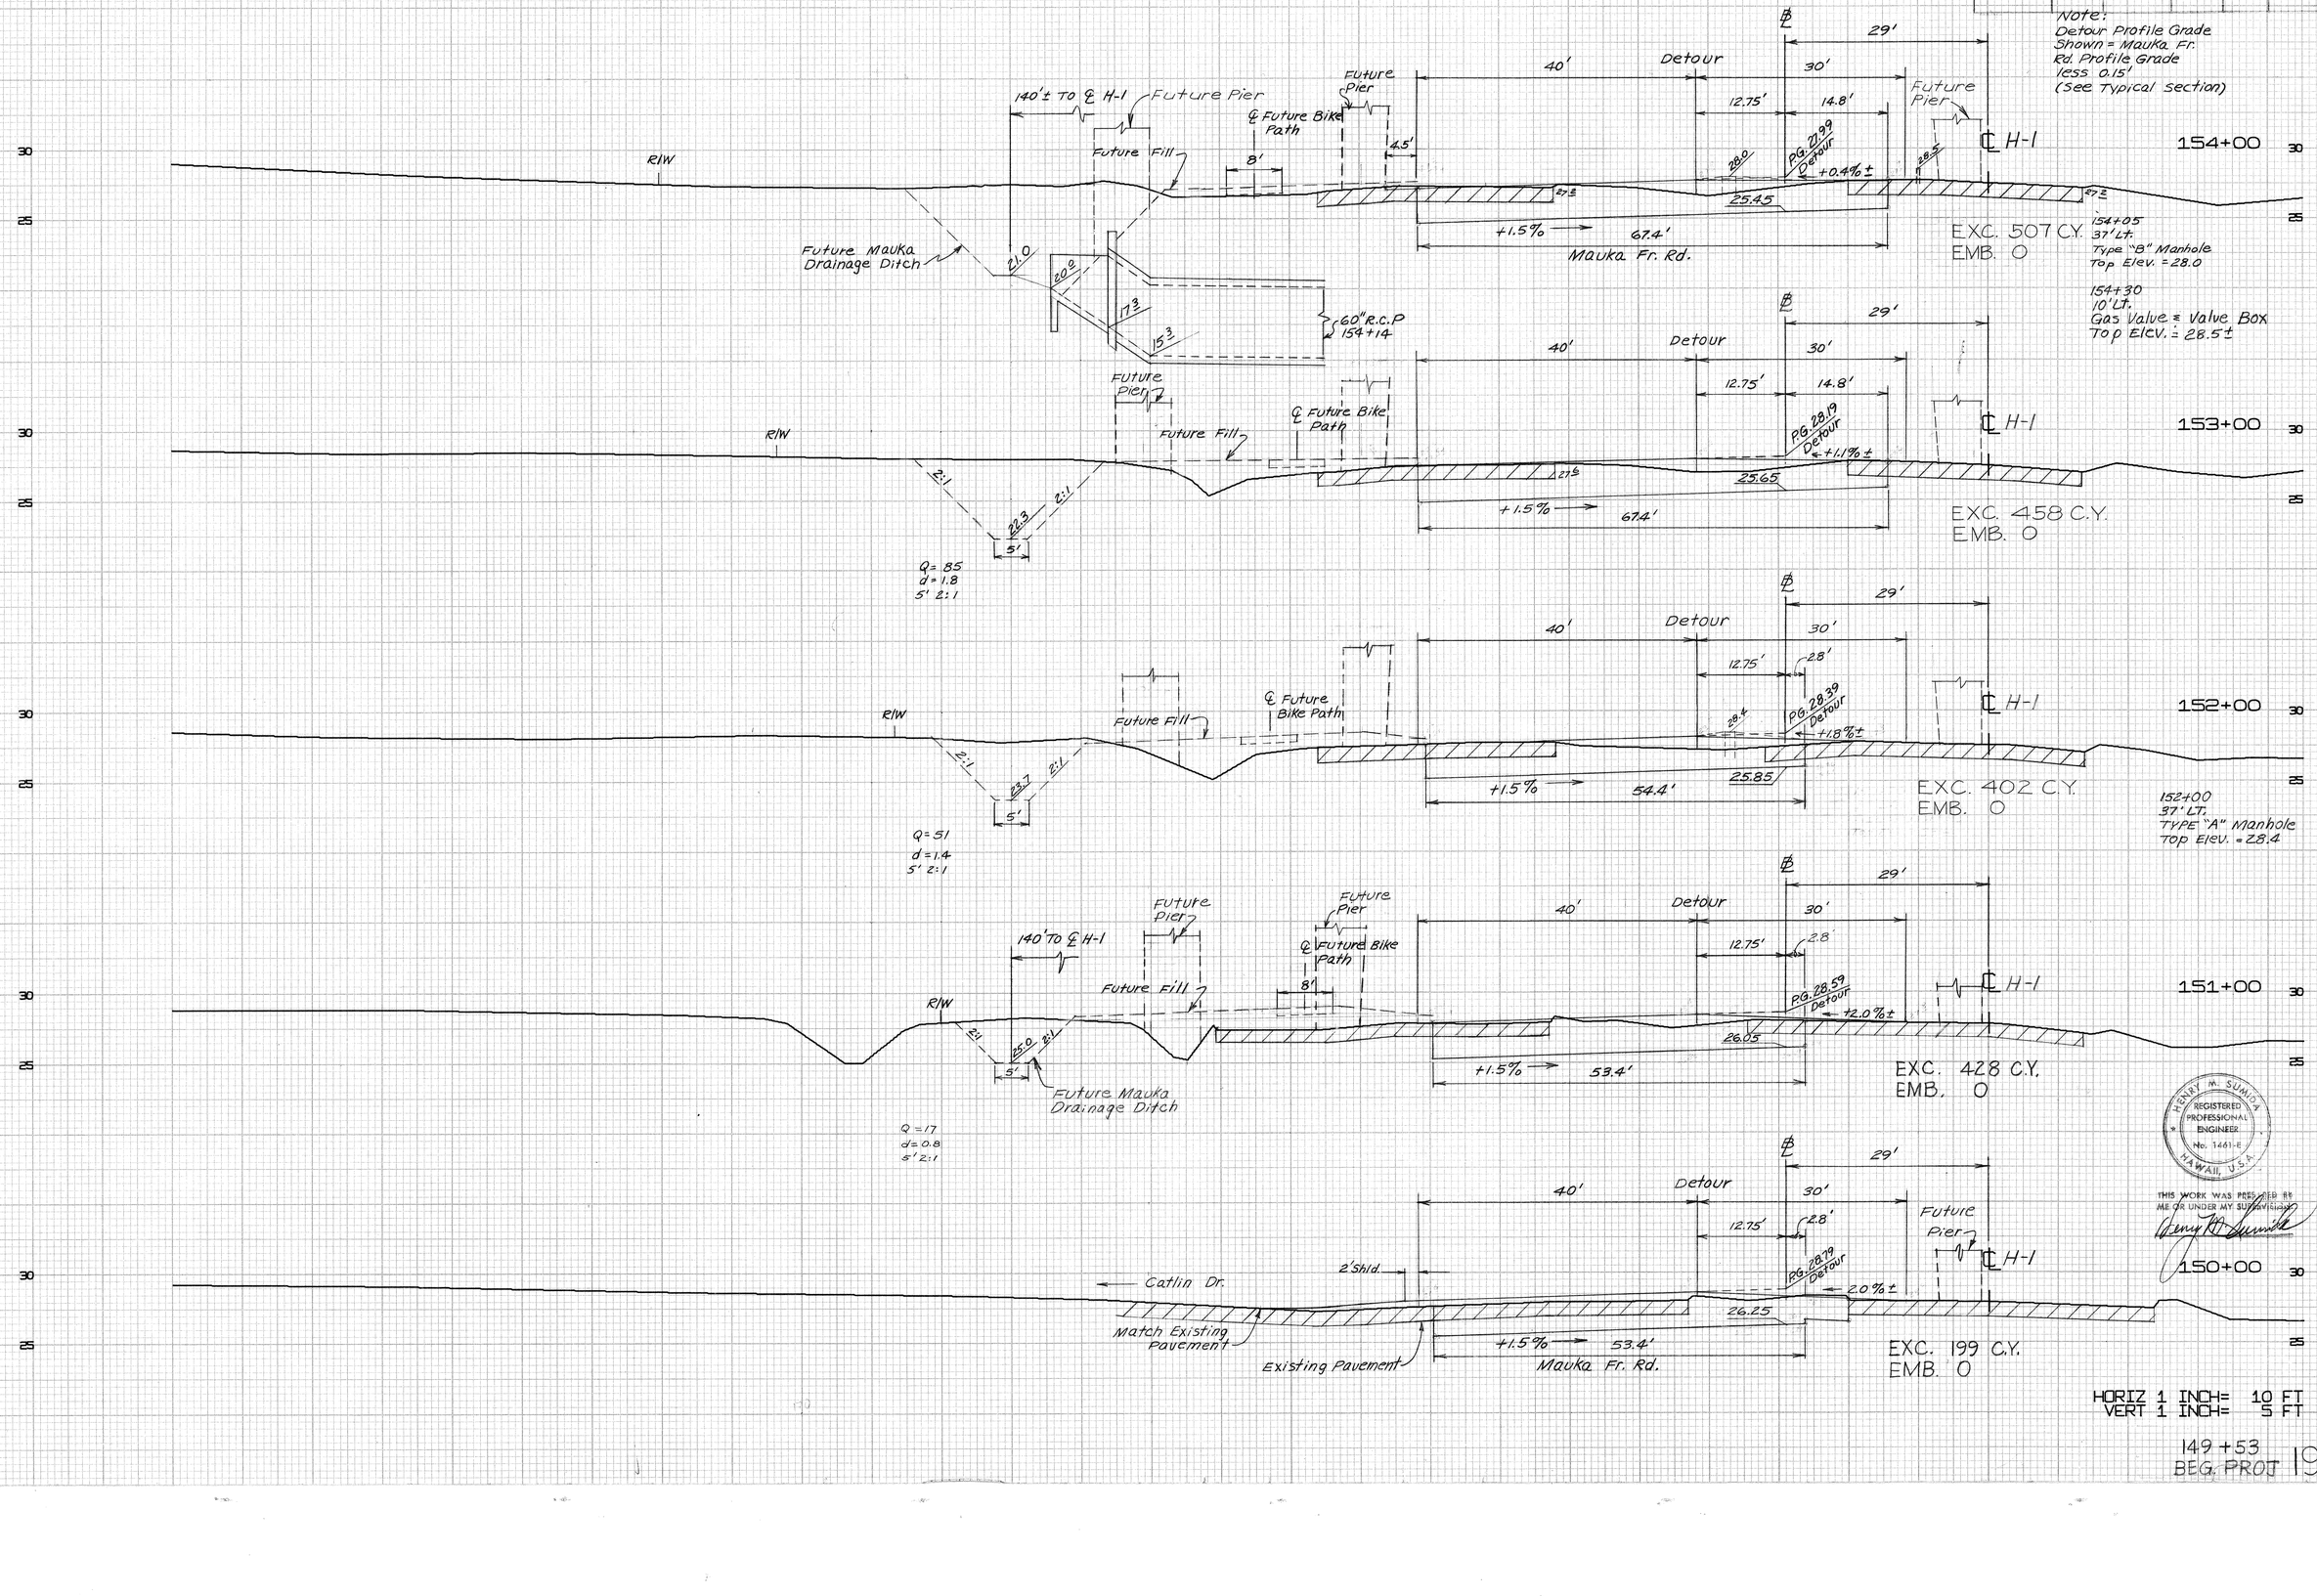

HENRY M. SUMIDA
REGISTERED PROFESSIONAL ENGINEER
No. 1461-E
HAWAII, U.S.A.

THIS WORK WAS PREPARED BY ME OR UNDER MY SUPERVISION

Henry M. Sumida


HORIZ 1 INCH= 10 FT
VERT 1 INCH= 5 FT

149+53
BEG. PROJ

195

STATE	PROJ. NO.	YEAR	NO.	SHEETS
HAWAII	HAW. I-HI-(121)16	1975	196	207

Note:
Detour Profile Grade Shown = Mauka Fr. Rd. Profile Grade Less 0.15' (See Typical Section)

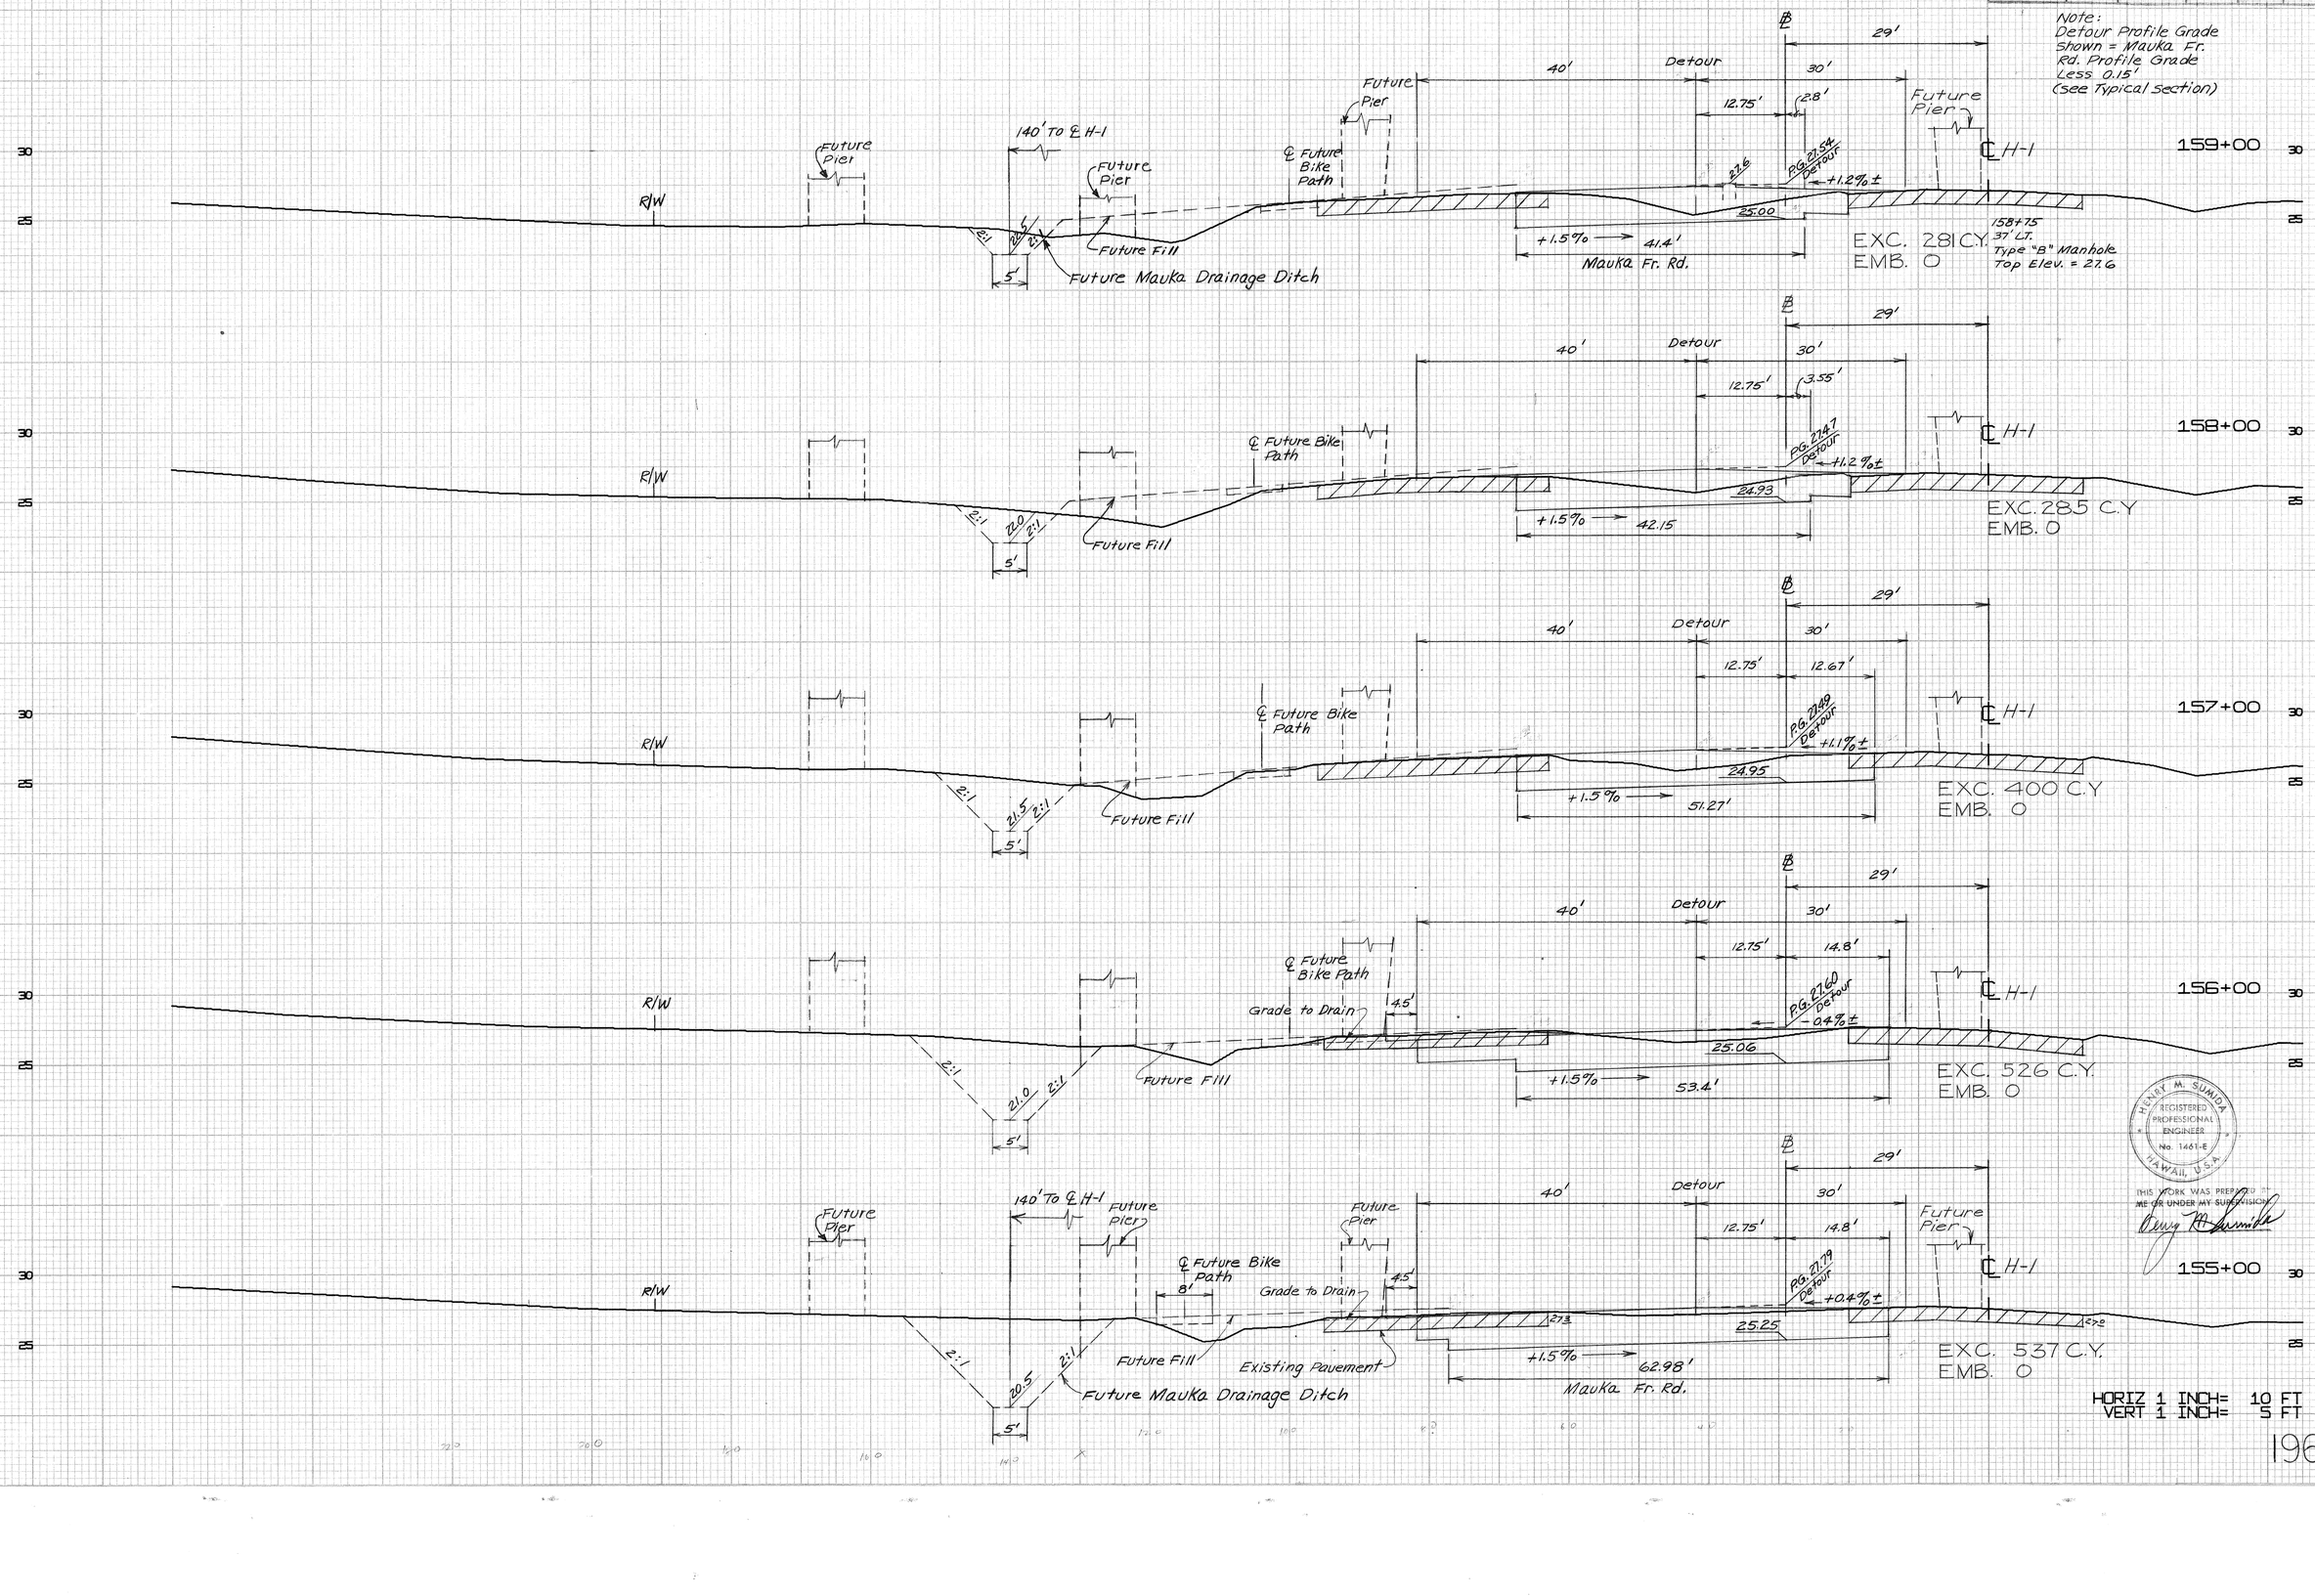


HENRY M. SUMIDA
REGISTERED PROFESSIONAL ENGINEER
No. 1461-E
HAWAII, U.S.A.

THIS WORK WAS PREPARED BY ME OR UNDER MY SUPERVISION

HORIZ 1 INCH= 10 FT
VERT 1 INCH= 5 FT

FED. ROAD DIST. NO.	STATE	FED. AID PROJ. NO.	FISCAL YEAR	SHEET NO.	TOTAL SHEETS
HAWAII	HAW.	FHI-1(12)16	1975	197	207

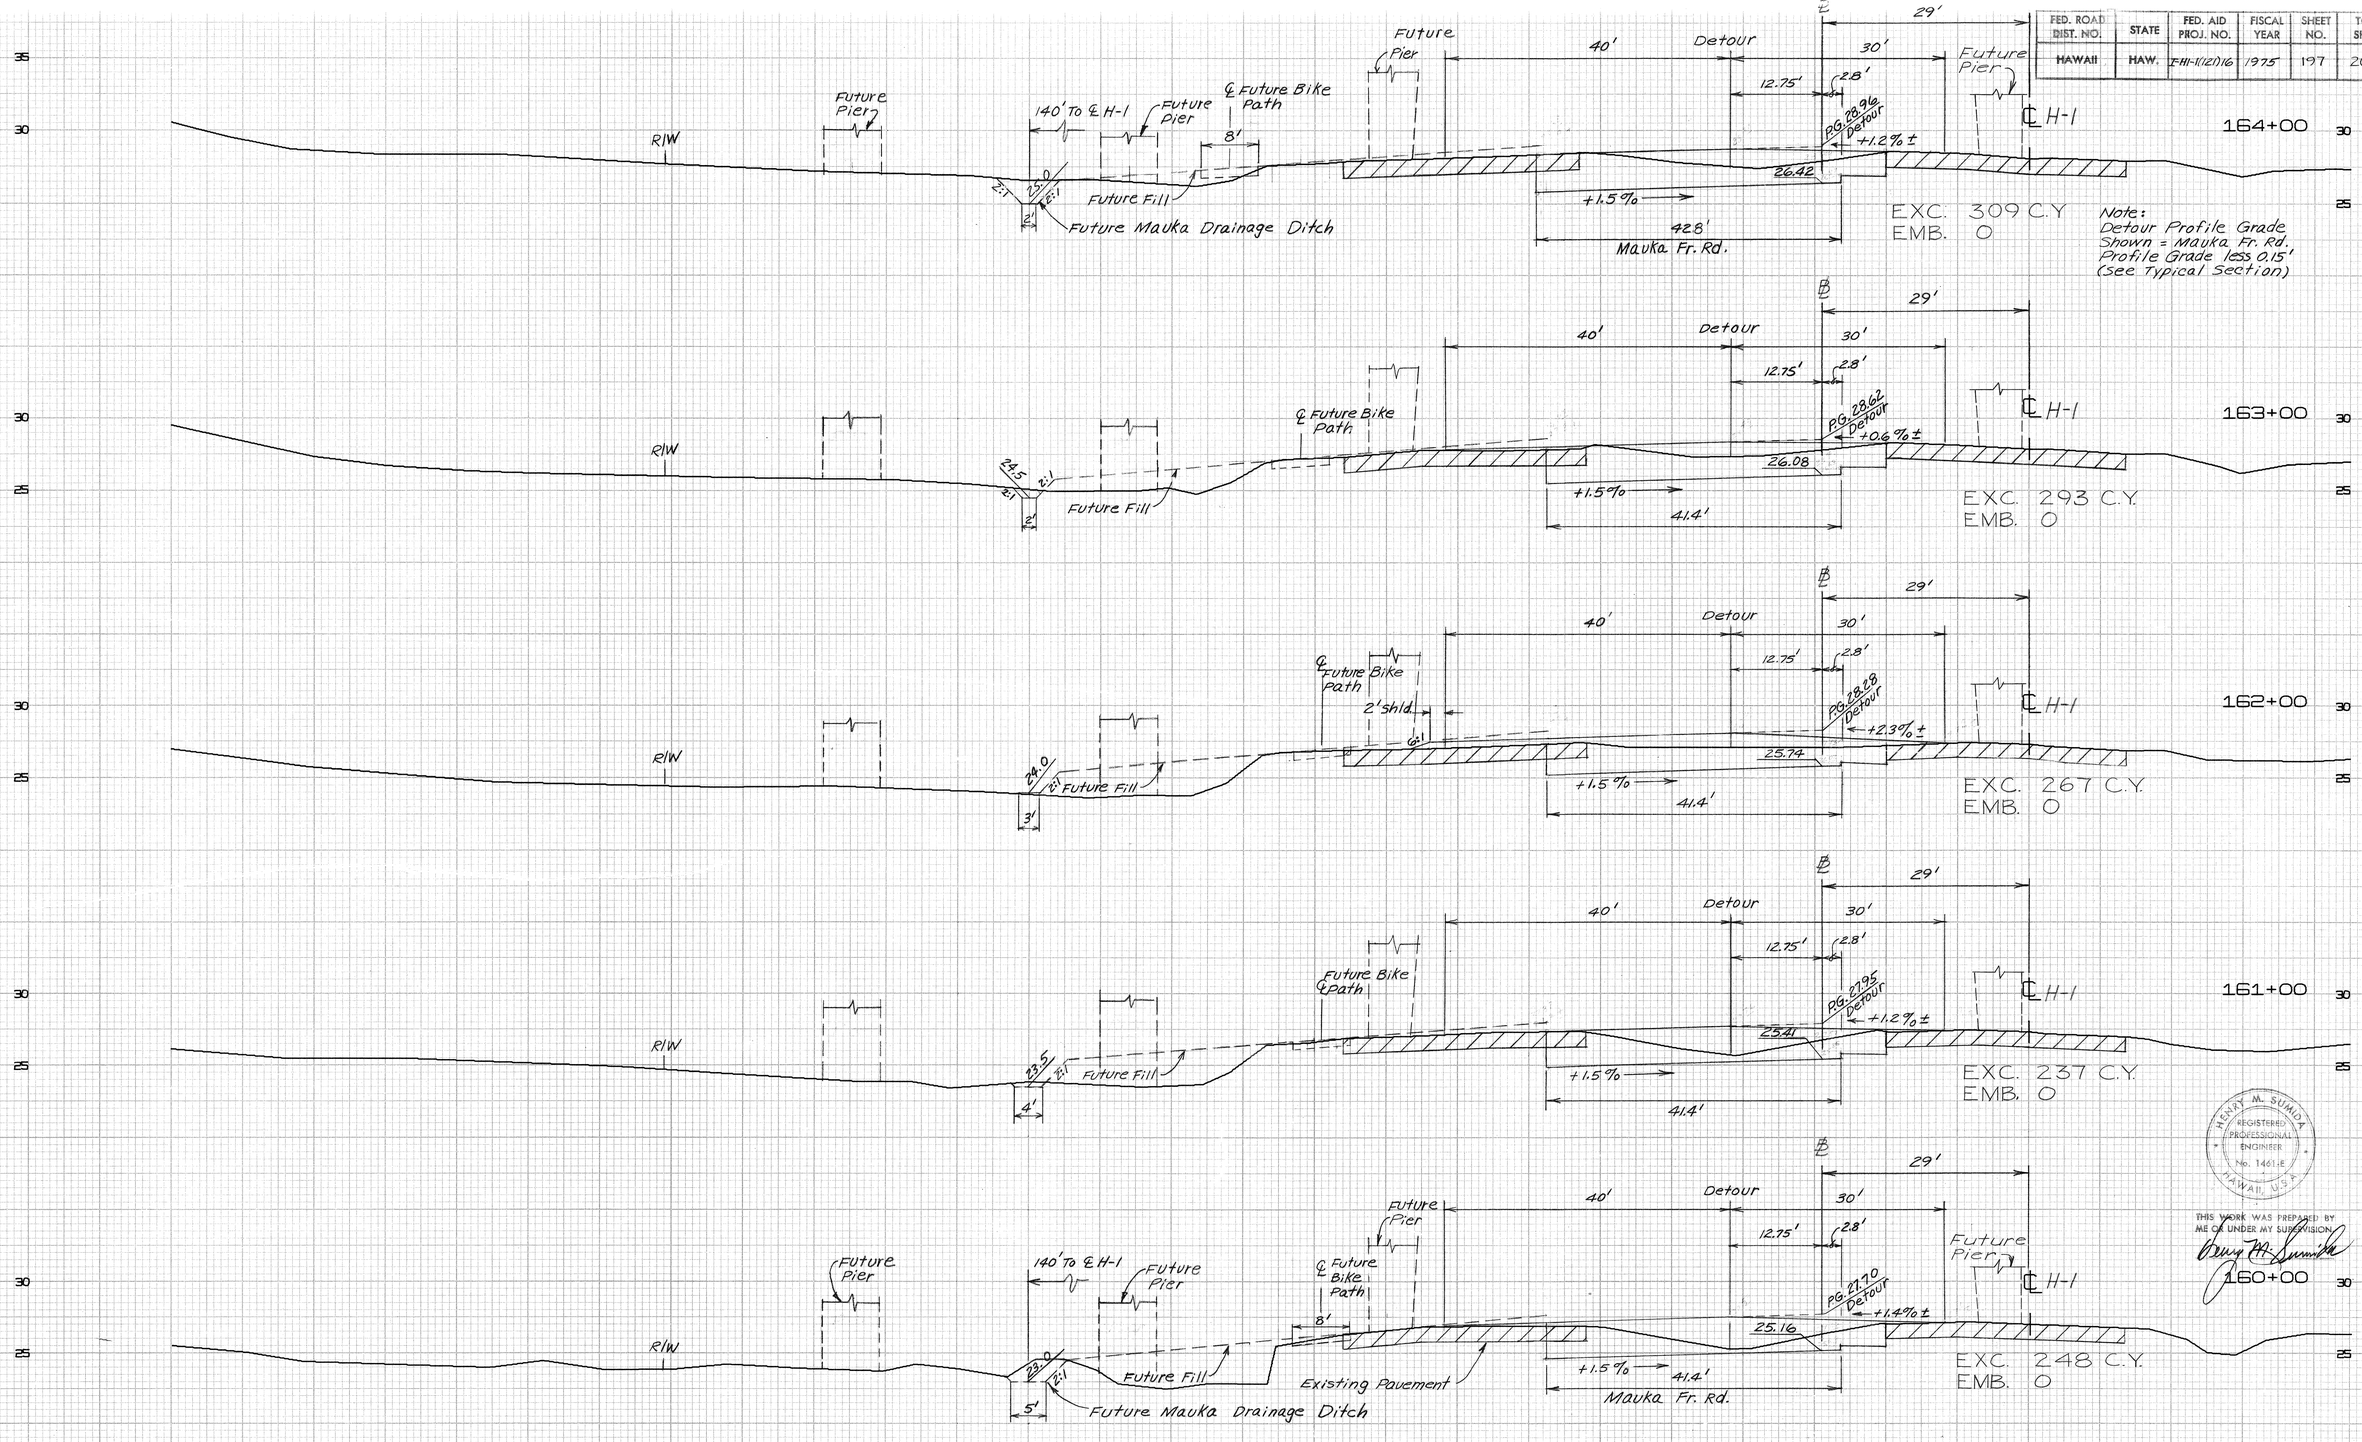


HENRY M. SUMIDA
REGISTERED PROFESSIONAL ENGINEER
No. 1461-E
HAWAII, U.S.A.

THIS WORK WAS PREPARED BY ME OR UNDER MY SUPERVISION.

HORIZ 1 INCH= 10 FT
VERT 1 INCH= 5 FT

FED. ROAD DIST. NO.	STATE	FED. AID PROJ. NO.	FISCAL YEAR	SHEET NO.	TOTAL SHEETS
HAWAII	HAW.	I-HI-1(12)16	1975	198	207

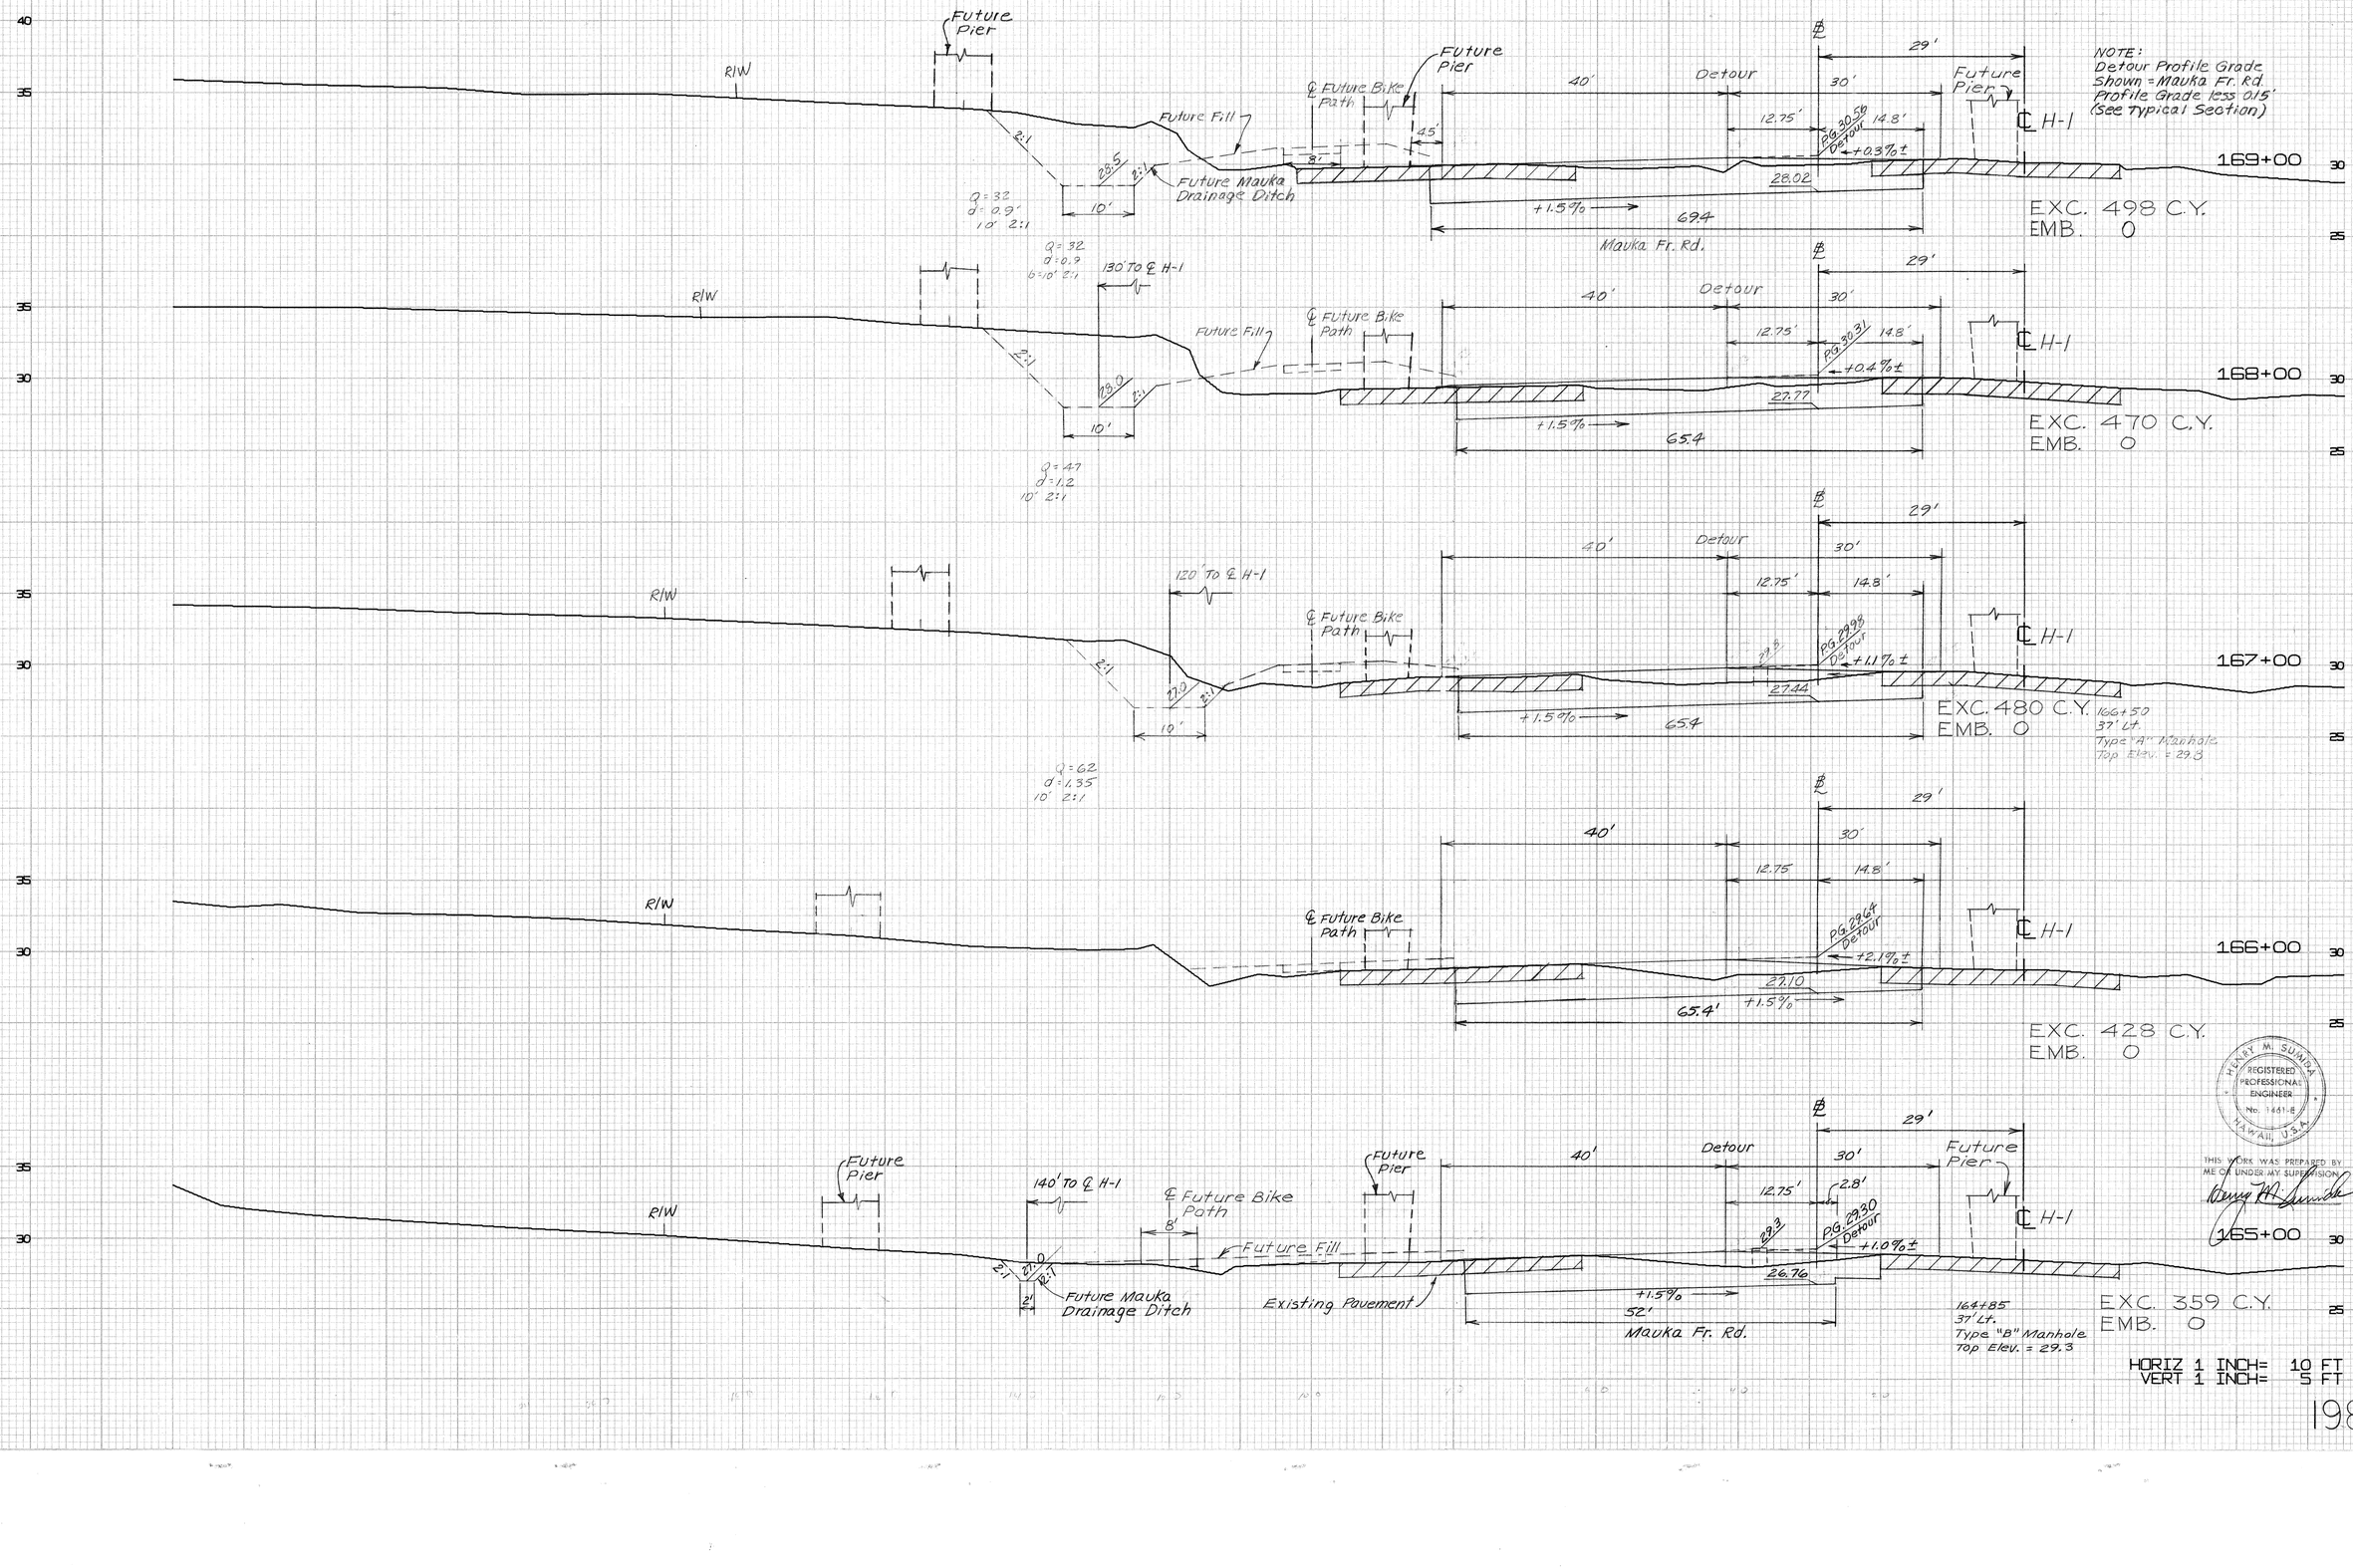


HENRY M. SUMIDA
REGISTERED PROFESSIONAL ENGINEER
No. 1461-E
HAWAII, U.S.A.

THIS WORK WAS PREPARED BY ME OR UNDER MY SUPERVISION

HORIZ 1 INCH= 10 FT
VERT 1 INCH= 5 FT

FED. ROAD DIST. NO.	STATE	FED. AID PROJ. NO.	FISCAL YEAR	SHEET NO.	TOTAL SHEETS
HAWAII	HAW.	I-HI-1(121)16	1975	199	207

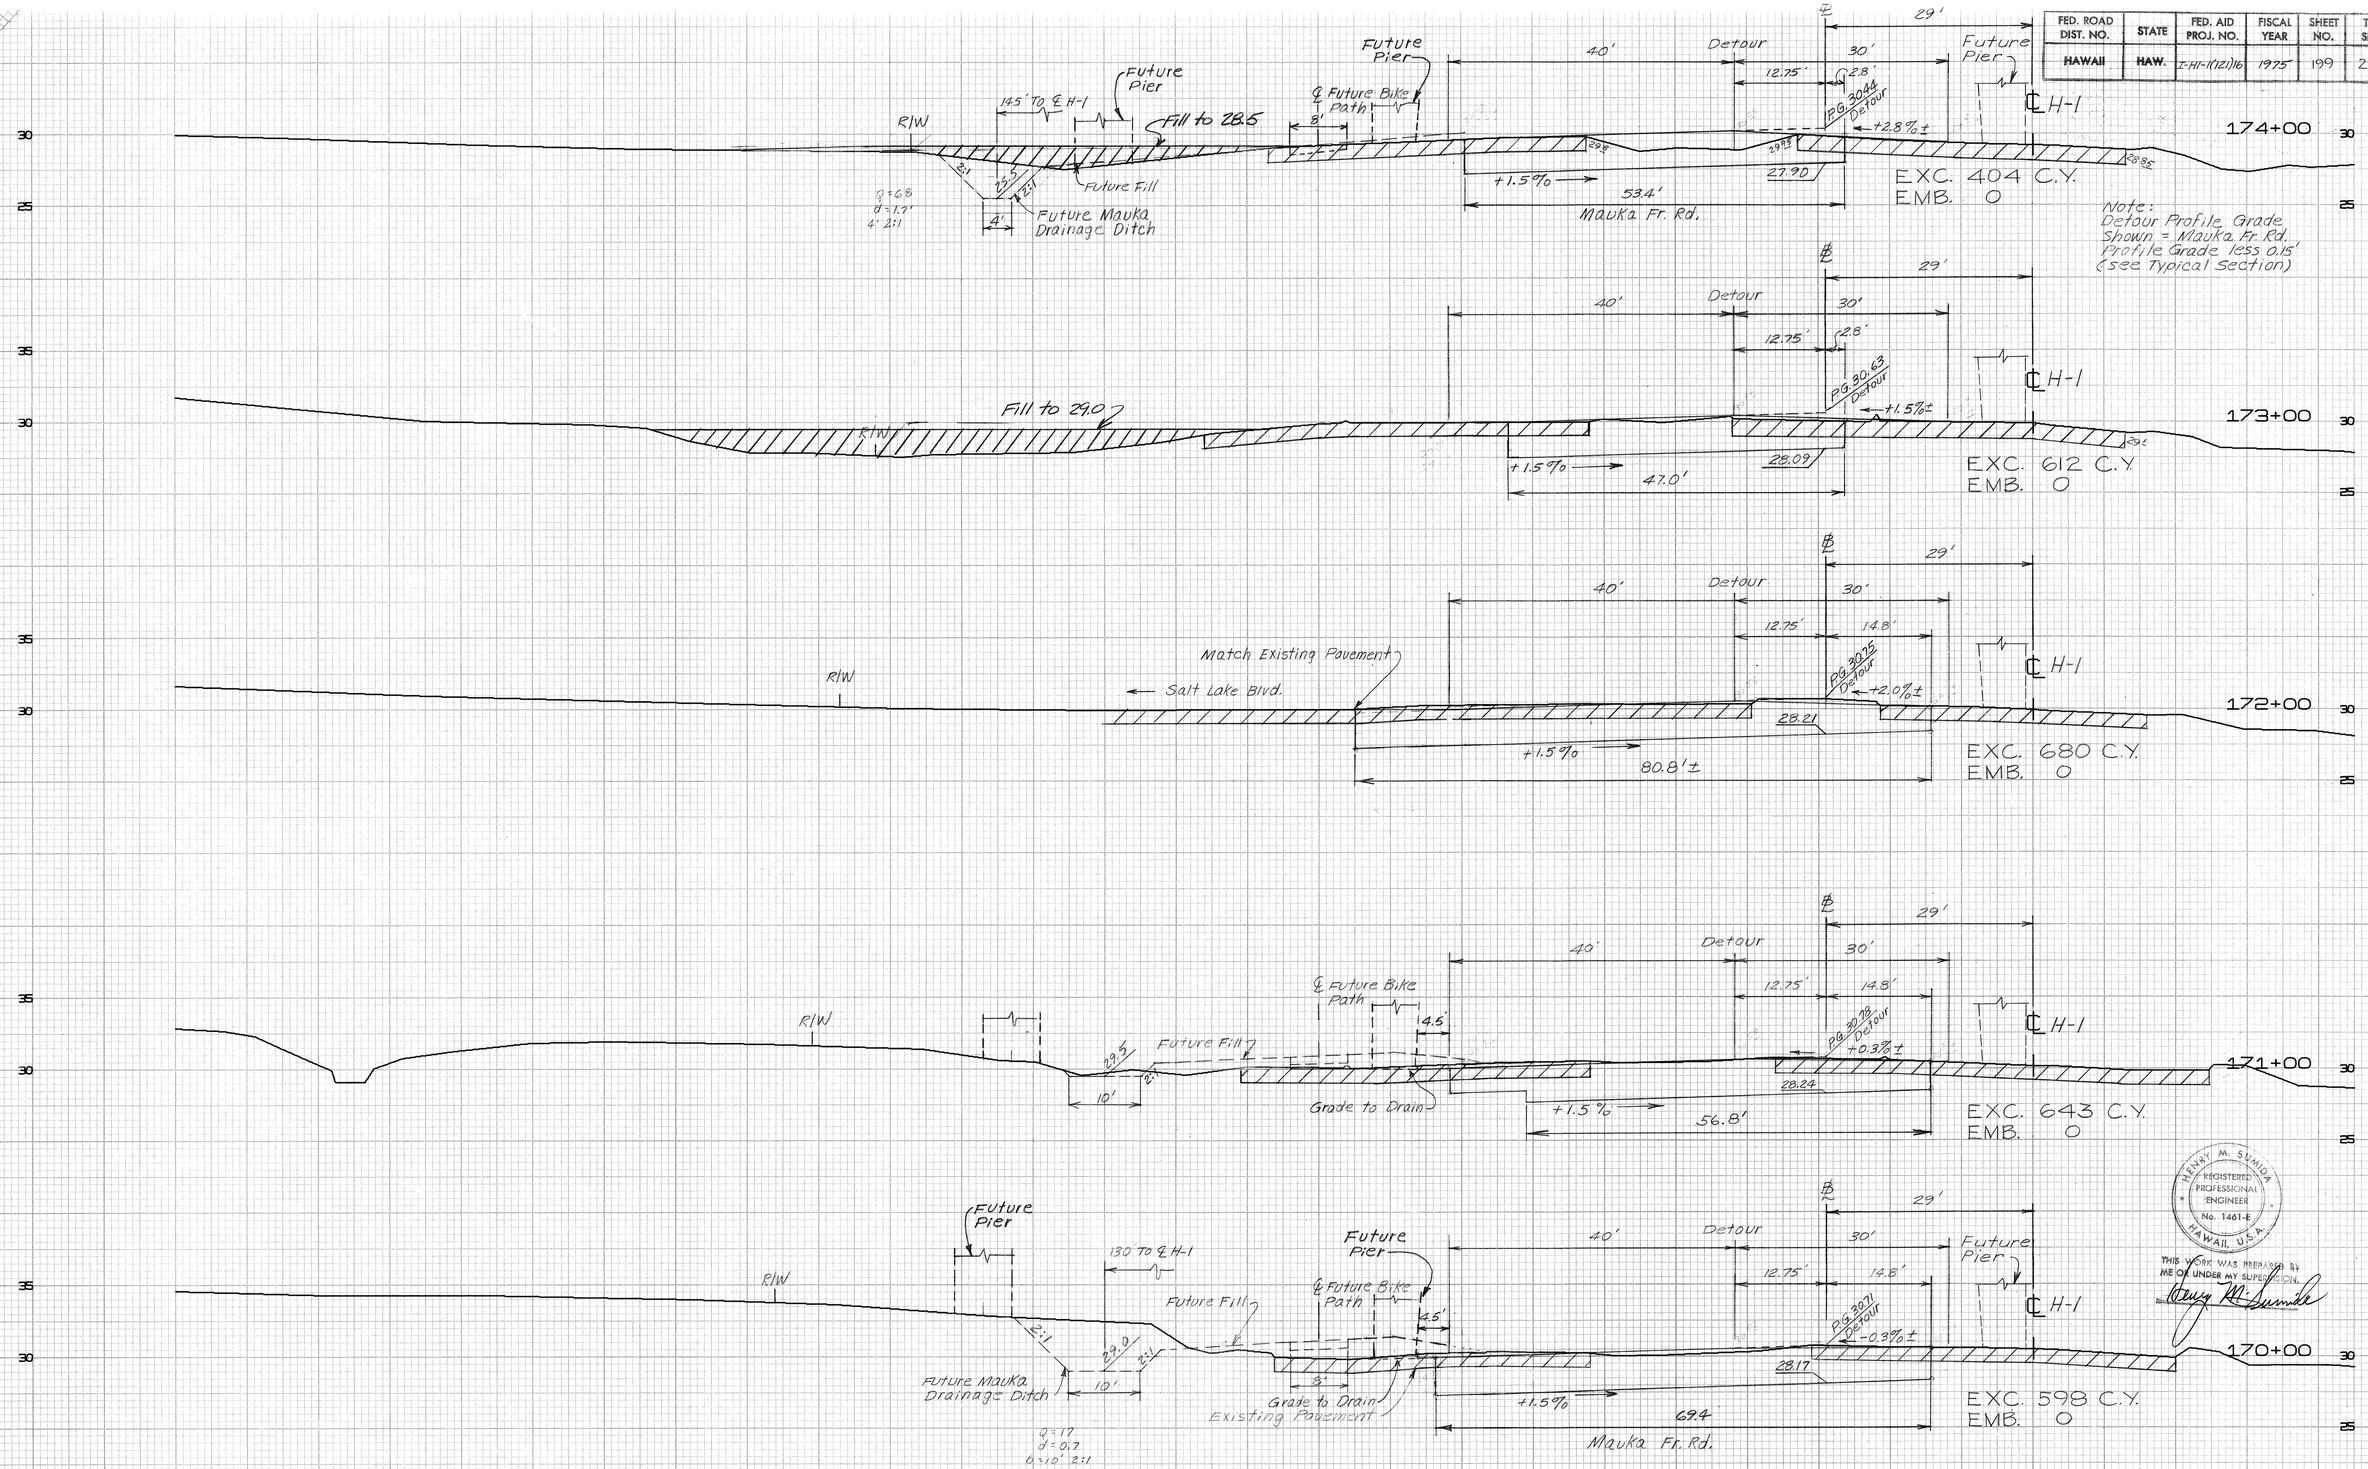


HENRY M. SUMIDA
REGISTERED PROFESSIONAL ENGINEER
No. 1461-E
HAWAII, U.S.A.
THIS WORK WAS PREPARED BY ME OR UNDER MY SUPERVISION.
Henry M. Sumida

HORIZ 1 INCH= 10 FT
VERT 1 INCH= 5 FT

FED. ROAD DIST. NO.	STATE	FED. AID PROJ. NO.	FISCAL YEAR	SHEET NO.	TOTAL SHEETS
HAWAII	HAW.	F-HI-1(12)16	1975	200	207

Note: Detour Profile Grade Shown = Mauka Fr. Rd. Profile Grade less 0.15' (See Typical Section)

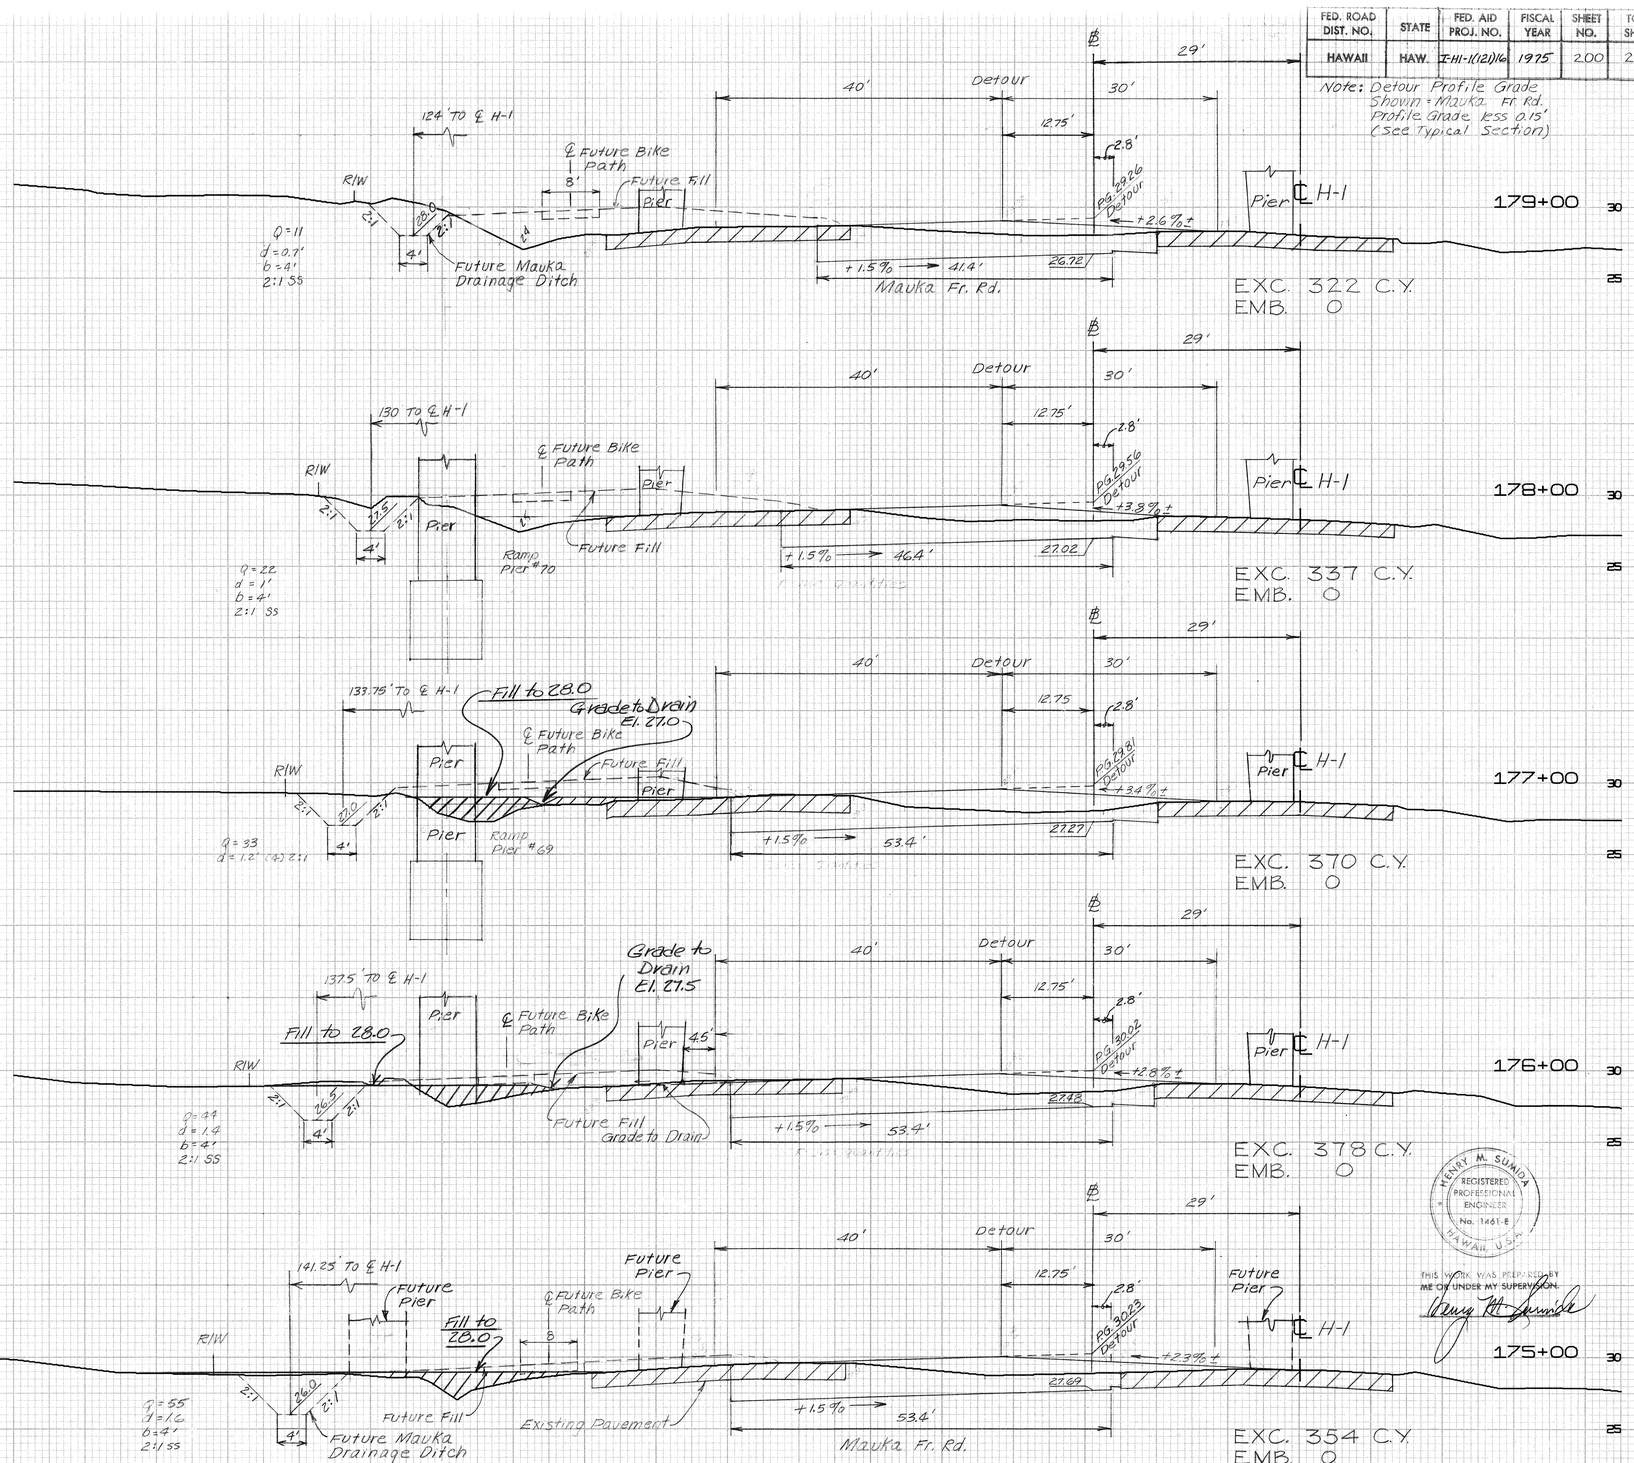


HENRY M. SUMIDA
REGISTERED PROFESSIONAL ENGINEER
No. 1461-E
HAWAII, U.S.A.

THIS WORK WAS PREPARED BY ME OR UNDER MY SUPERVISION.

HORIZ 1 INCH= 10 FT
VERT 1 INCH= 5 FT

FED. ROAD DIST. NO.	STATE	FED. AID PROJ. NO.	FISCAL YEAR	SHEET NO.	TOTAL SHEETS
HAWAII	HAW.	I-HI-1(12)16	1975	201	207

Note:
Detour Profile Grade Shown = Mauka Fr. Rd. Profile Grade less 0.15' (See Typical Section)

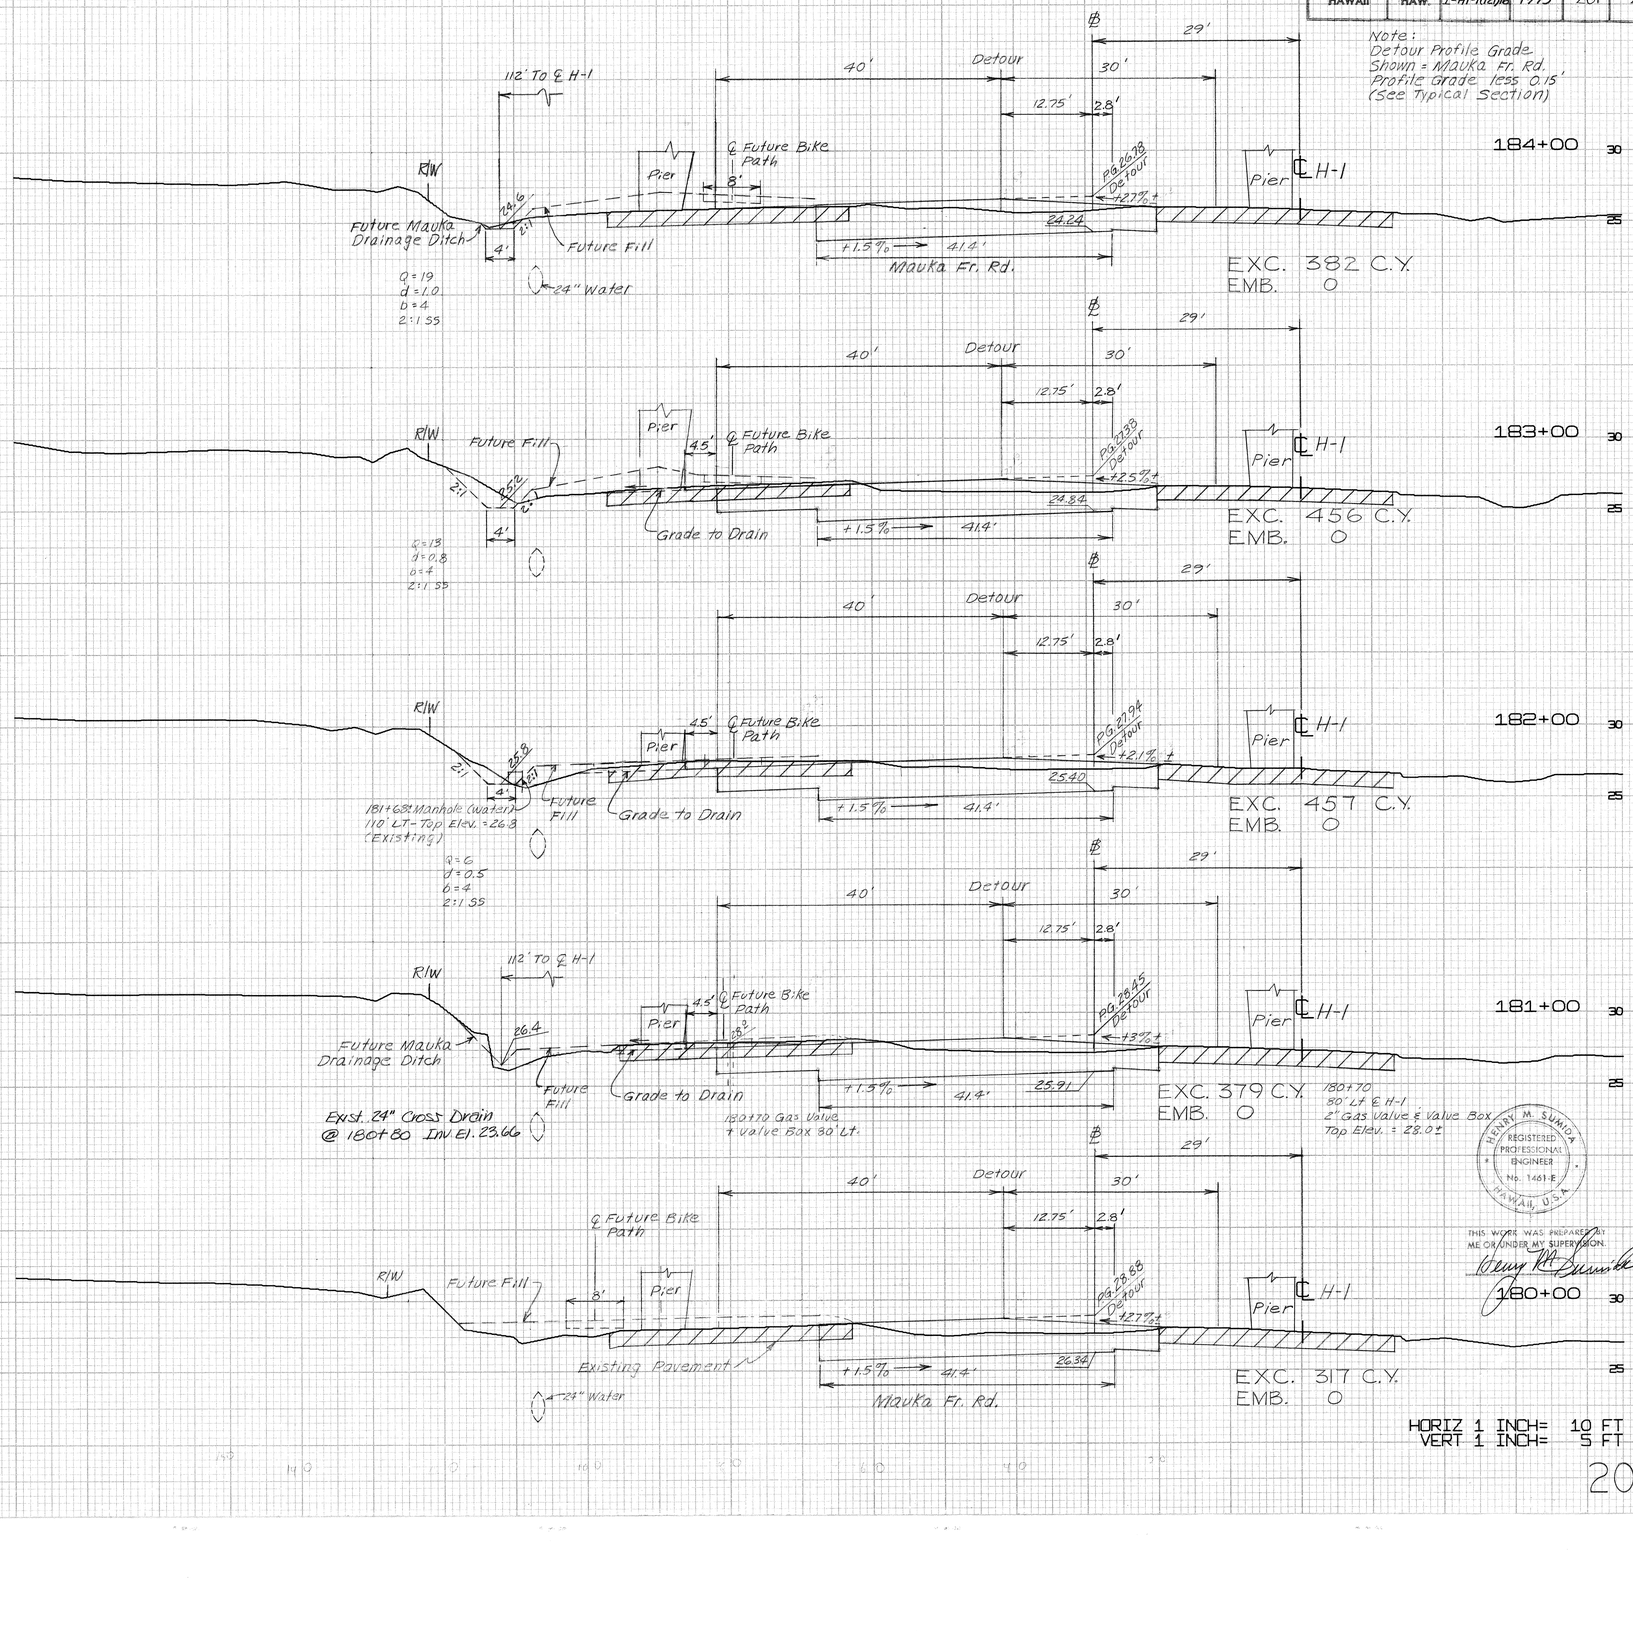


HENRY M. SUMIDA
REGISTERED PROFESSIONAL ENGINEER
No. 1461-E
HAWAII, U.S.A.

THIS WORK WAS PREPARED BY ME OR UNDER MY SUPERVISION.
Henry M. Sumida

HORIZ 1 INCH= 10 FT
VERT 1 INCH= 5 FT

FED. ROAD DIST. NO.	STATE	FED. AID PROJ. NO.	FISCAL YEAR	SHEET NO.	TOTAL SHEETS
HAWAII	HAW.	I-HI-1(12)16	1975	202	207

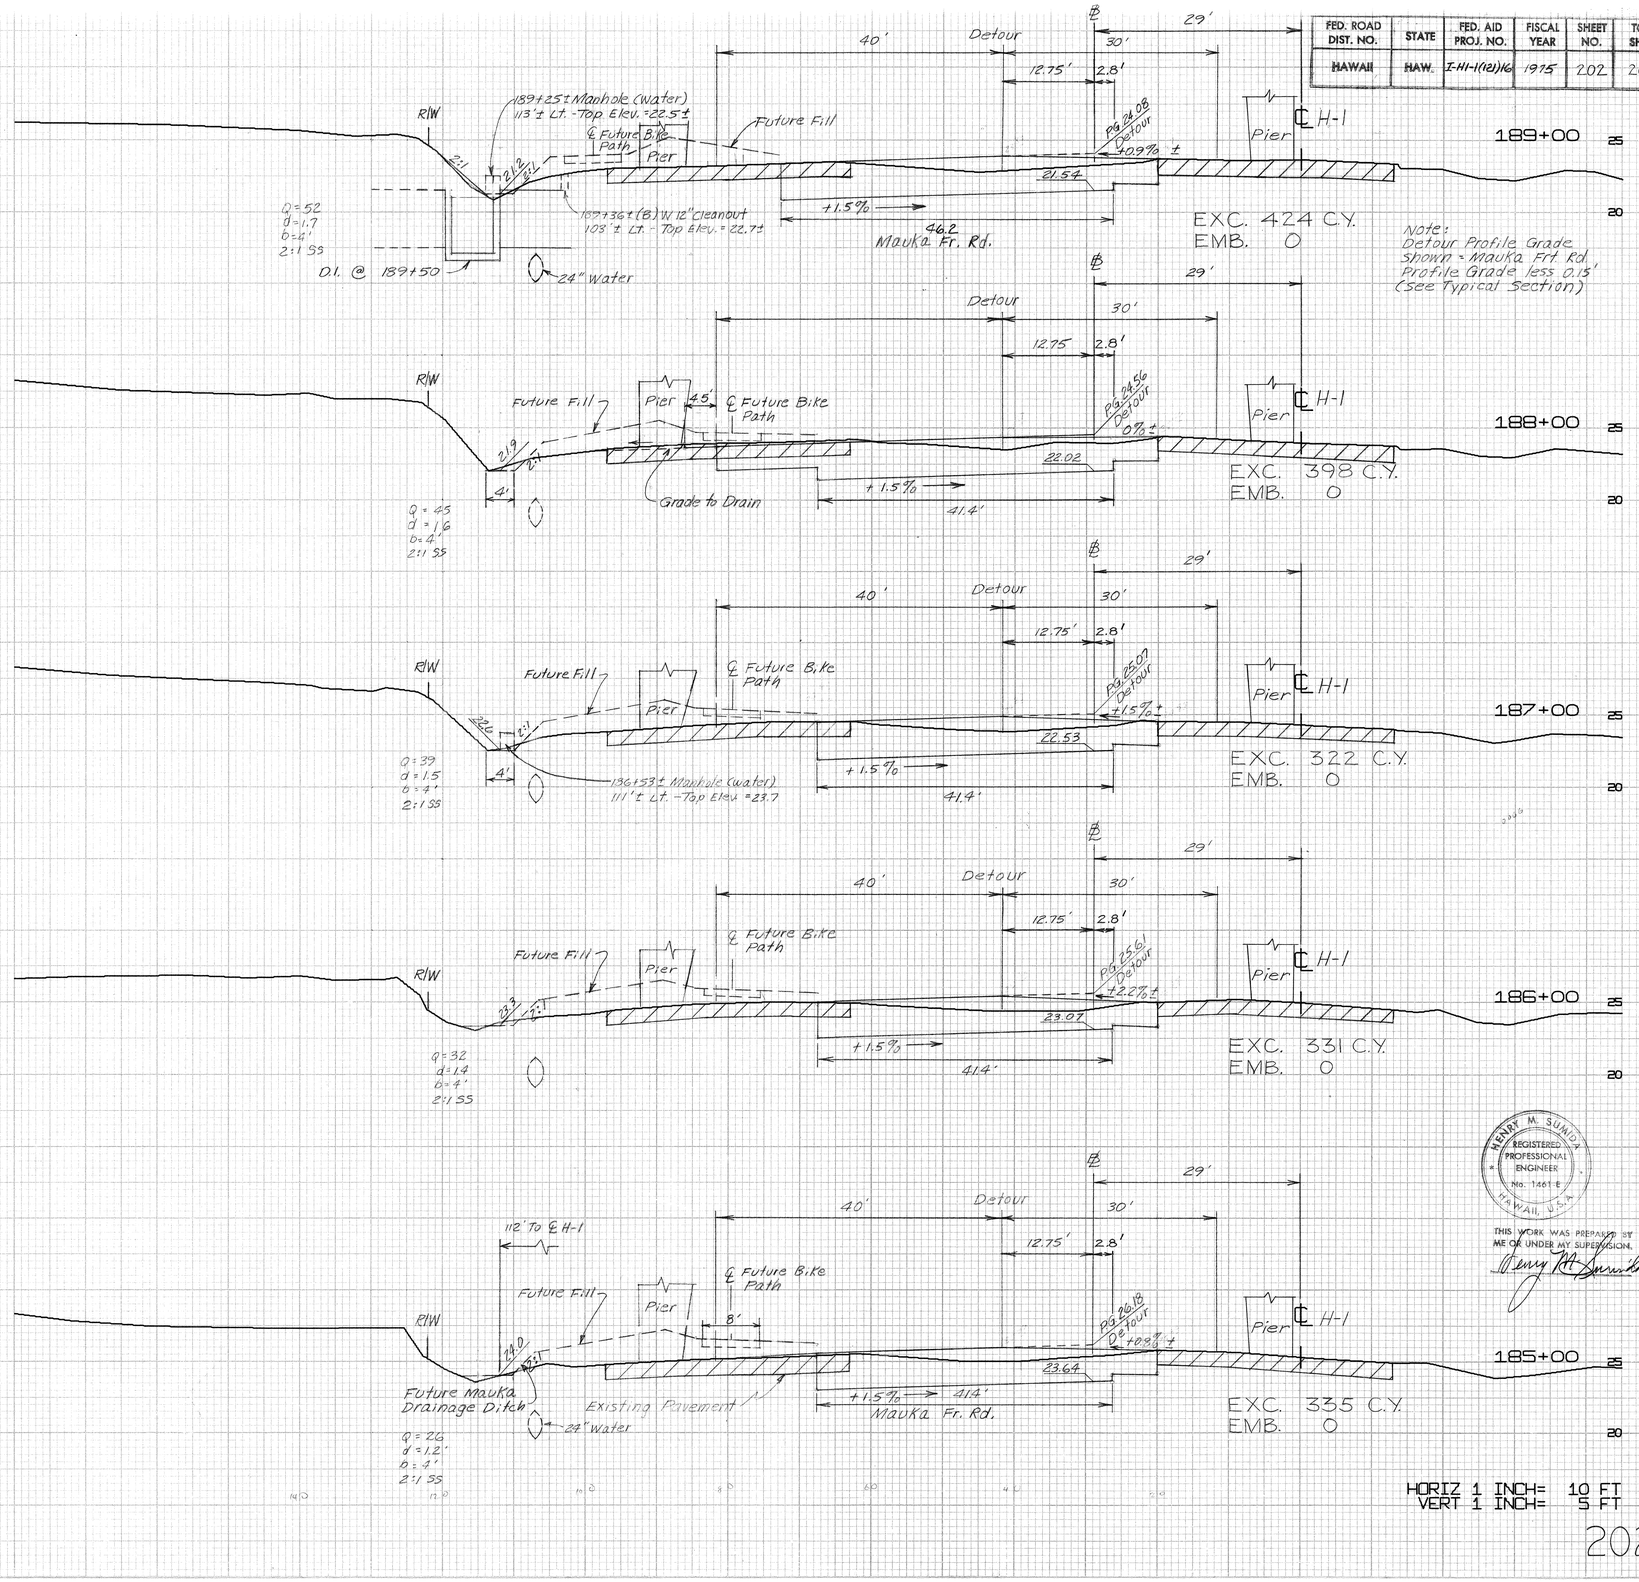


HENRY M. SUNIDA
REGISTERED PROFESSIONAL ENGINEER
No. 1461-E
HAWAII, U.S.A.

THIS WORK WAS PREPARED BY ME OR UNDER MY SUPERVISION.

202

FED. ROAD DIST. NO.	STATE	FED. AID PROJ. NO.	FISCAL YEAR	SHEET NO.	TOTAL SHEETS
HAWAII	HAW.	I-HI-1(121)16	1975	203	207

Note:
Detour Profile Grade Shown = Mauka Frt. Rd Profile Grade less 0.15' (See Typical Section)

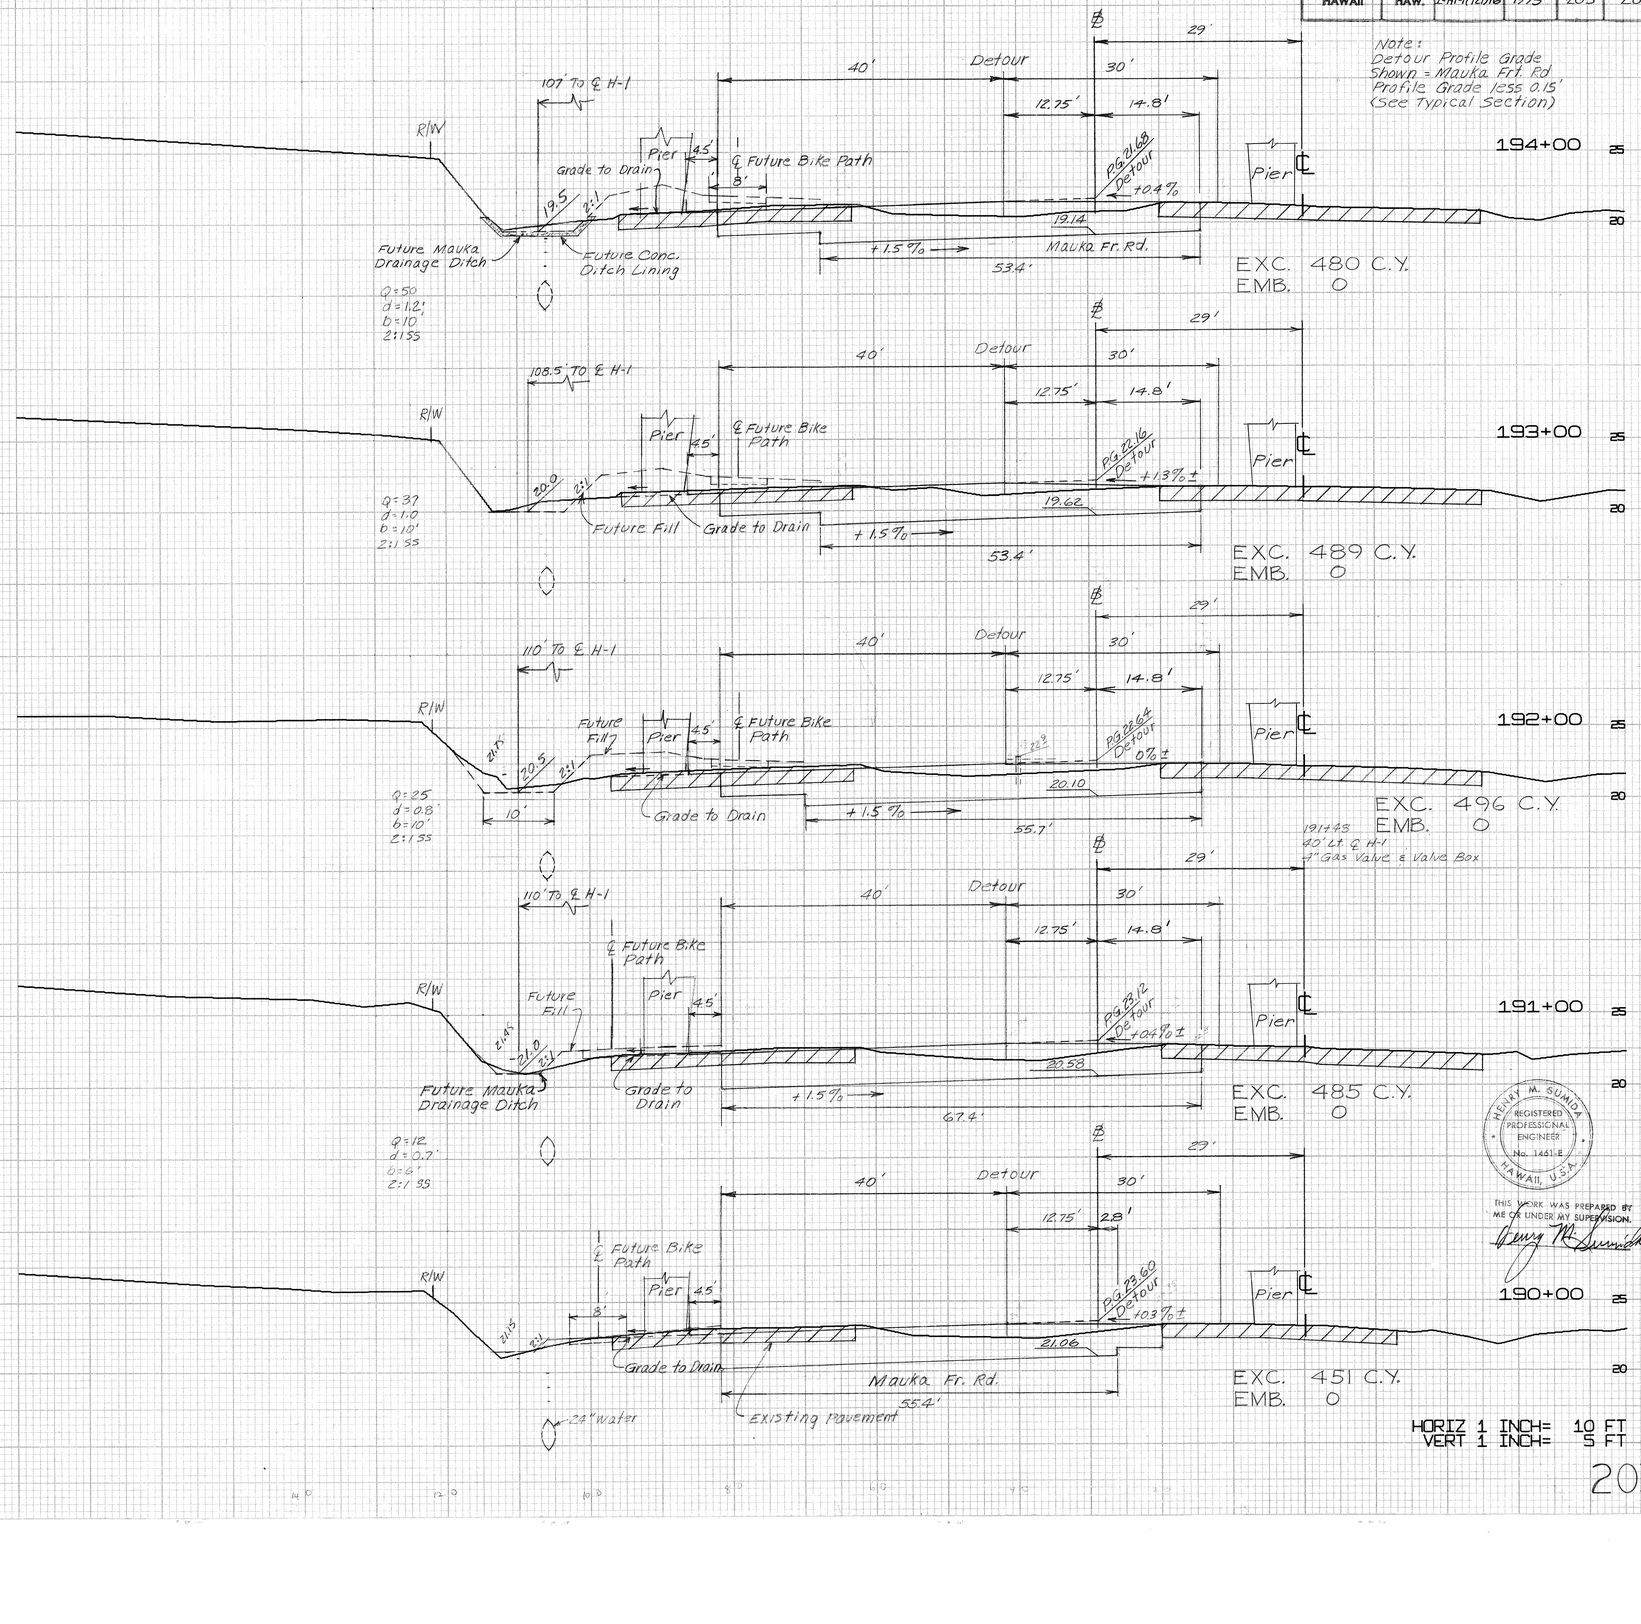


HENRY M. SUMIDA
REGISTERED PROFESSIONAL ENGINEER
No. 1461-E
HAWAII, U.S.A.

THIS WORK WAS PREPARED BY ME OR UNDER MY SUPERVISION.

Henry M. Sumida


203

FED. ROAD DIST. NO.	STATE	FED. AID PROJ. NO.	FISCAL YEAR	SHEET NO.	TOTAL SHEETS
HAWAII	HAW	I-HI-1(112)16	1975	204	207

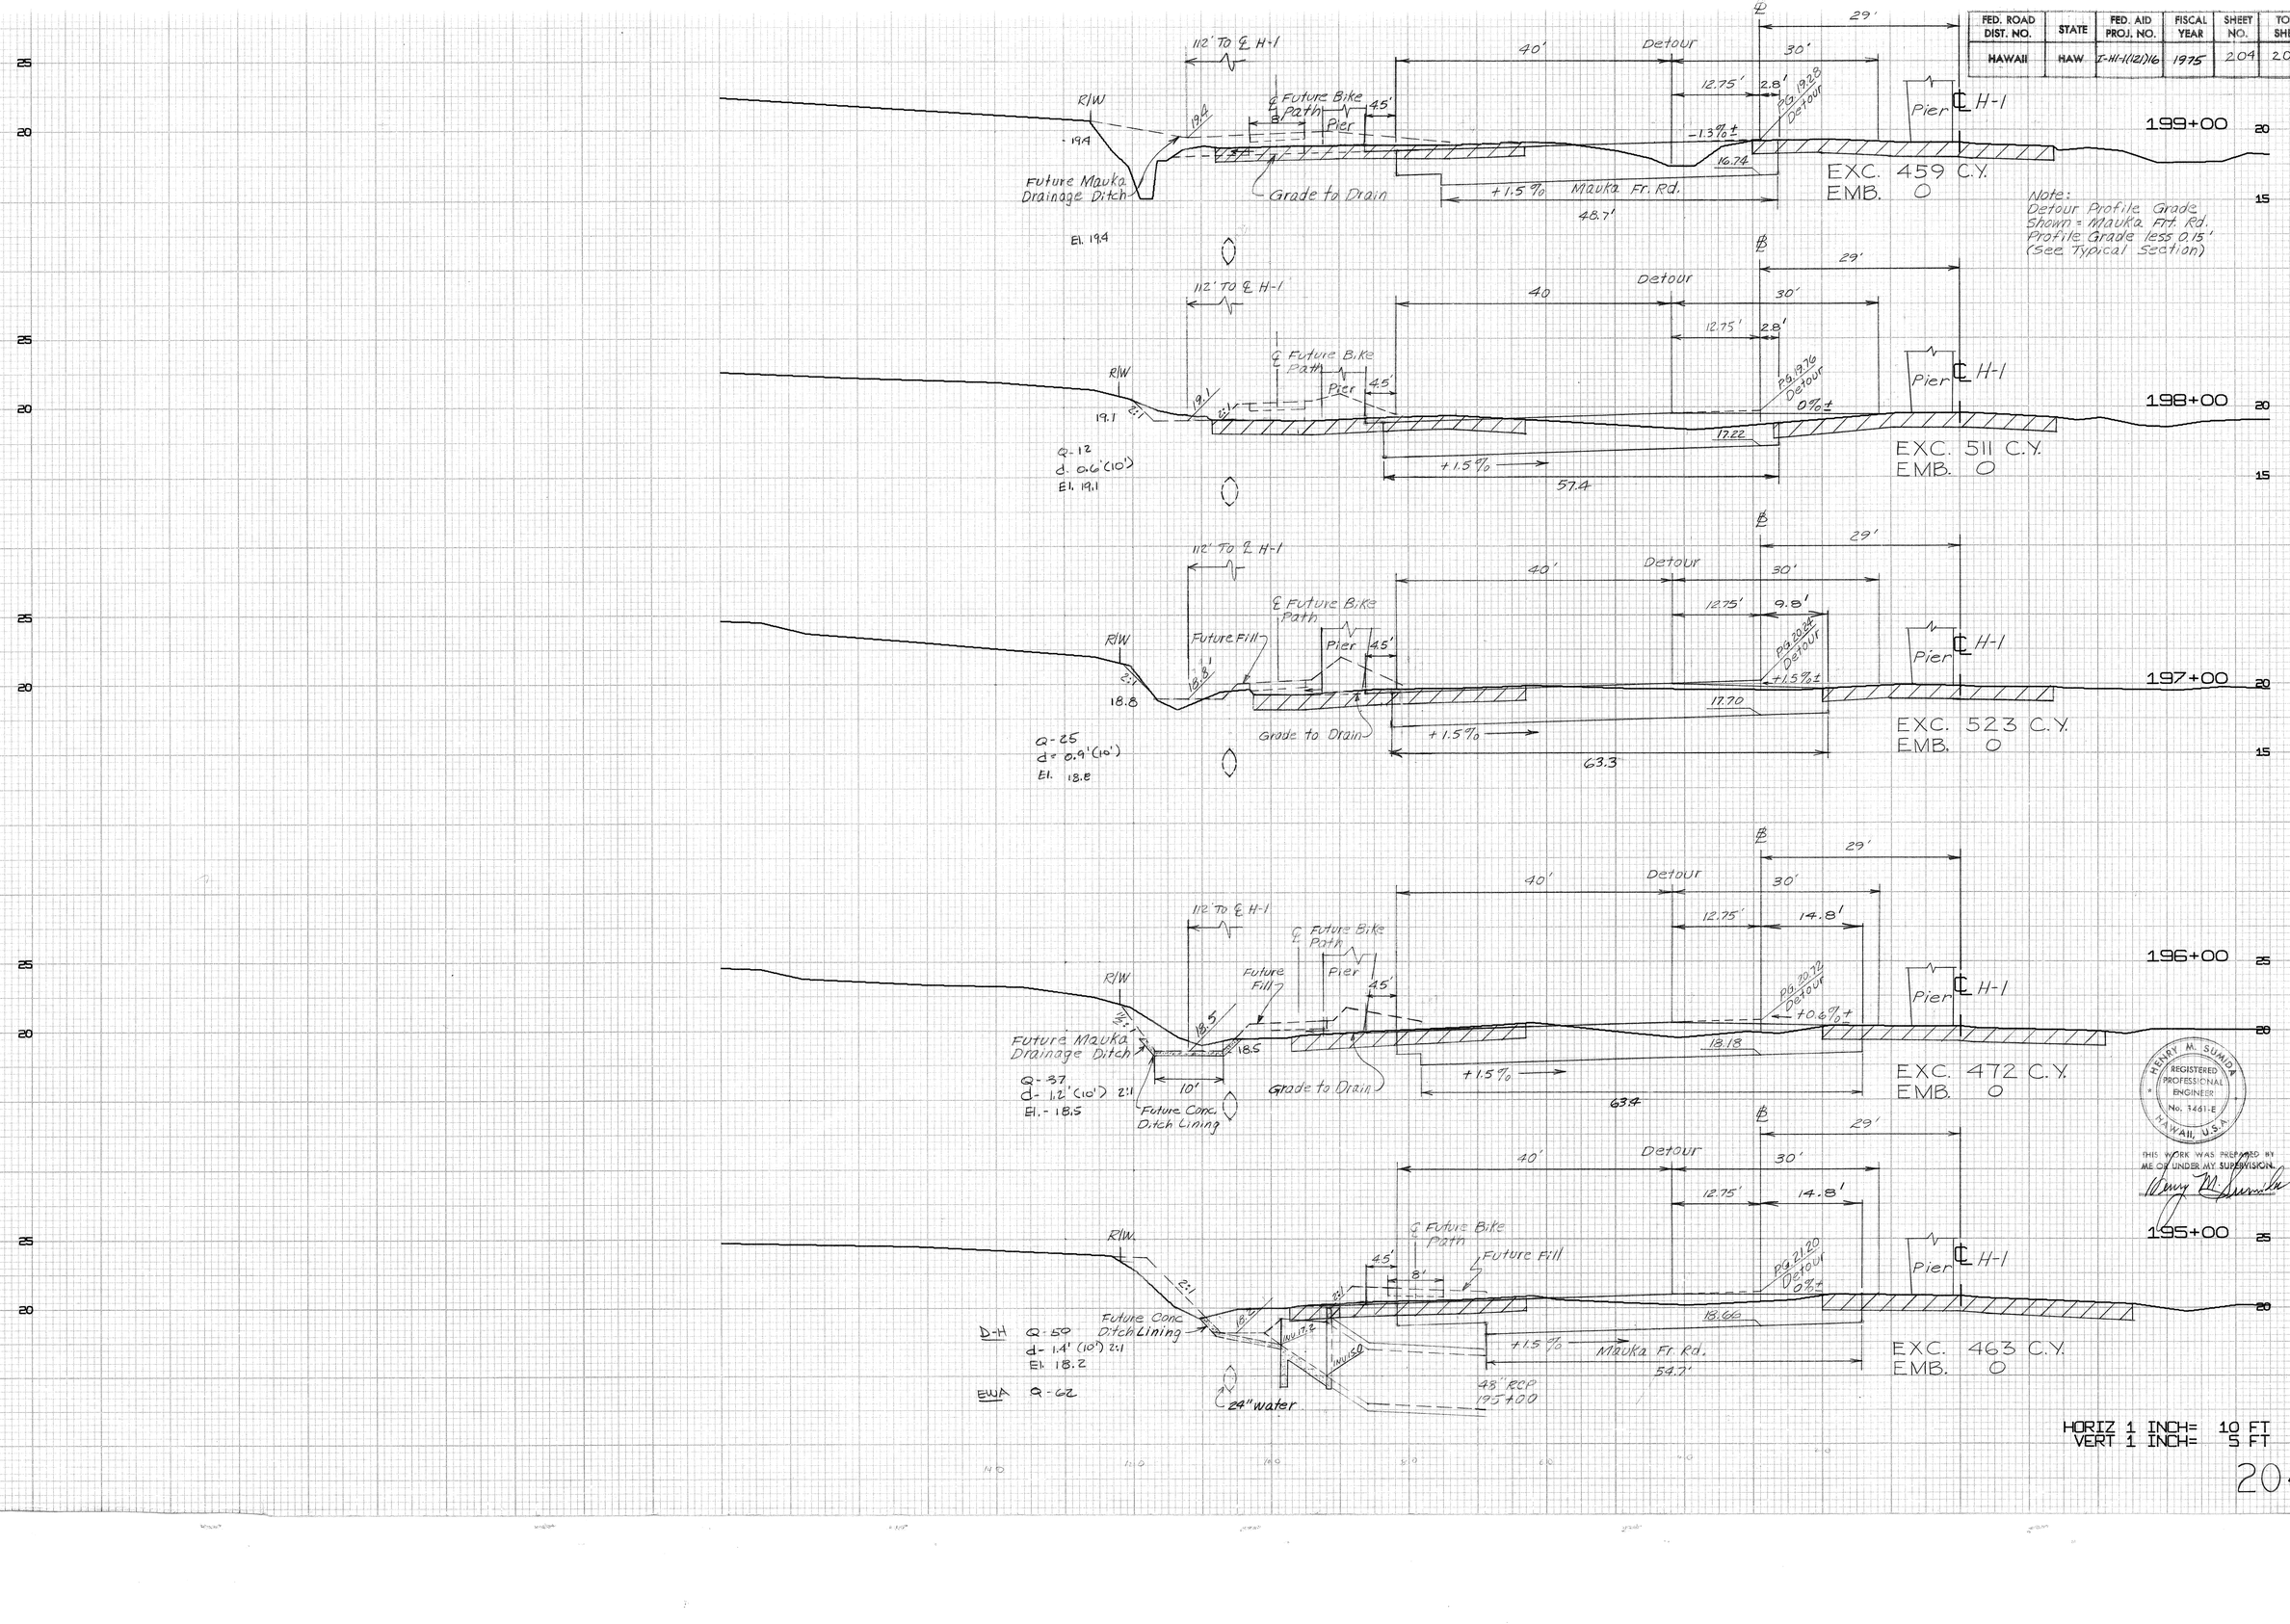

FED. ROAD DIST. NO.	STATE	FED. AID PROJ. NO.	FISCAL YEAR	SHEET NO.	TOTAL SHEETS
HAWAII	HAW.	I-HI-K(12)16	1975	205	207

Note:
Detour Profile Grade Shown = Mauka Frt. Rd. Profile Grade less 0.15' (see Typical Section)

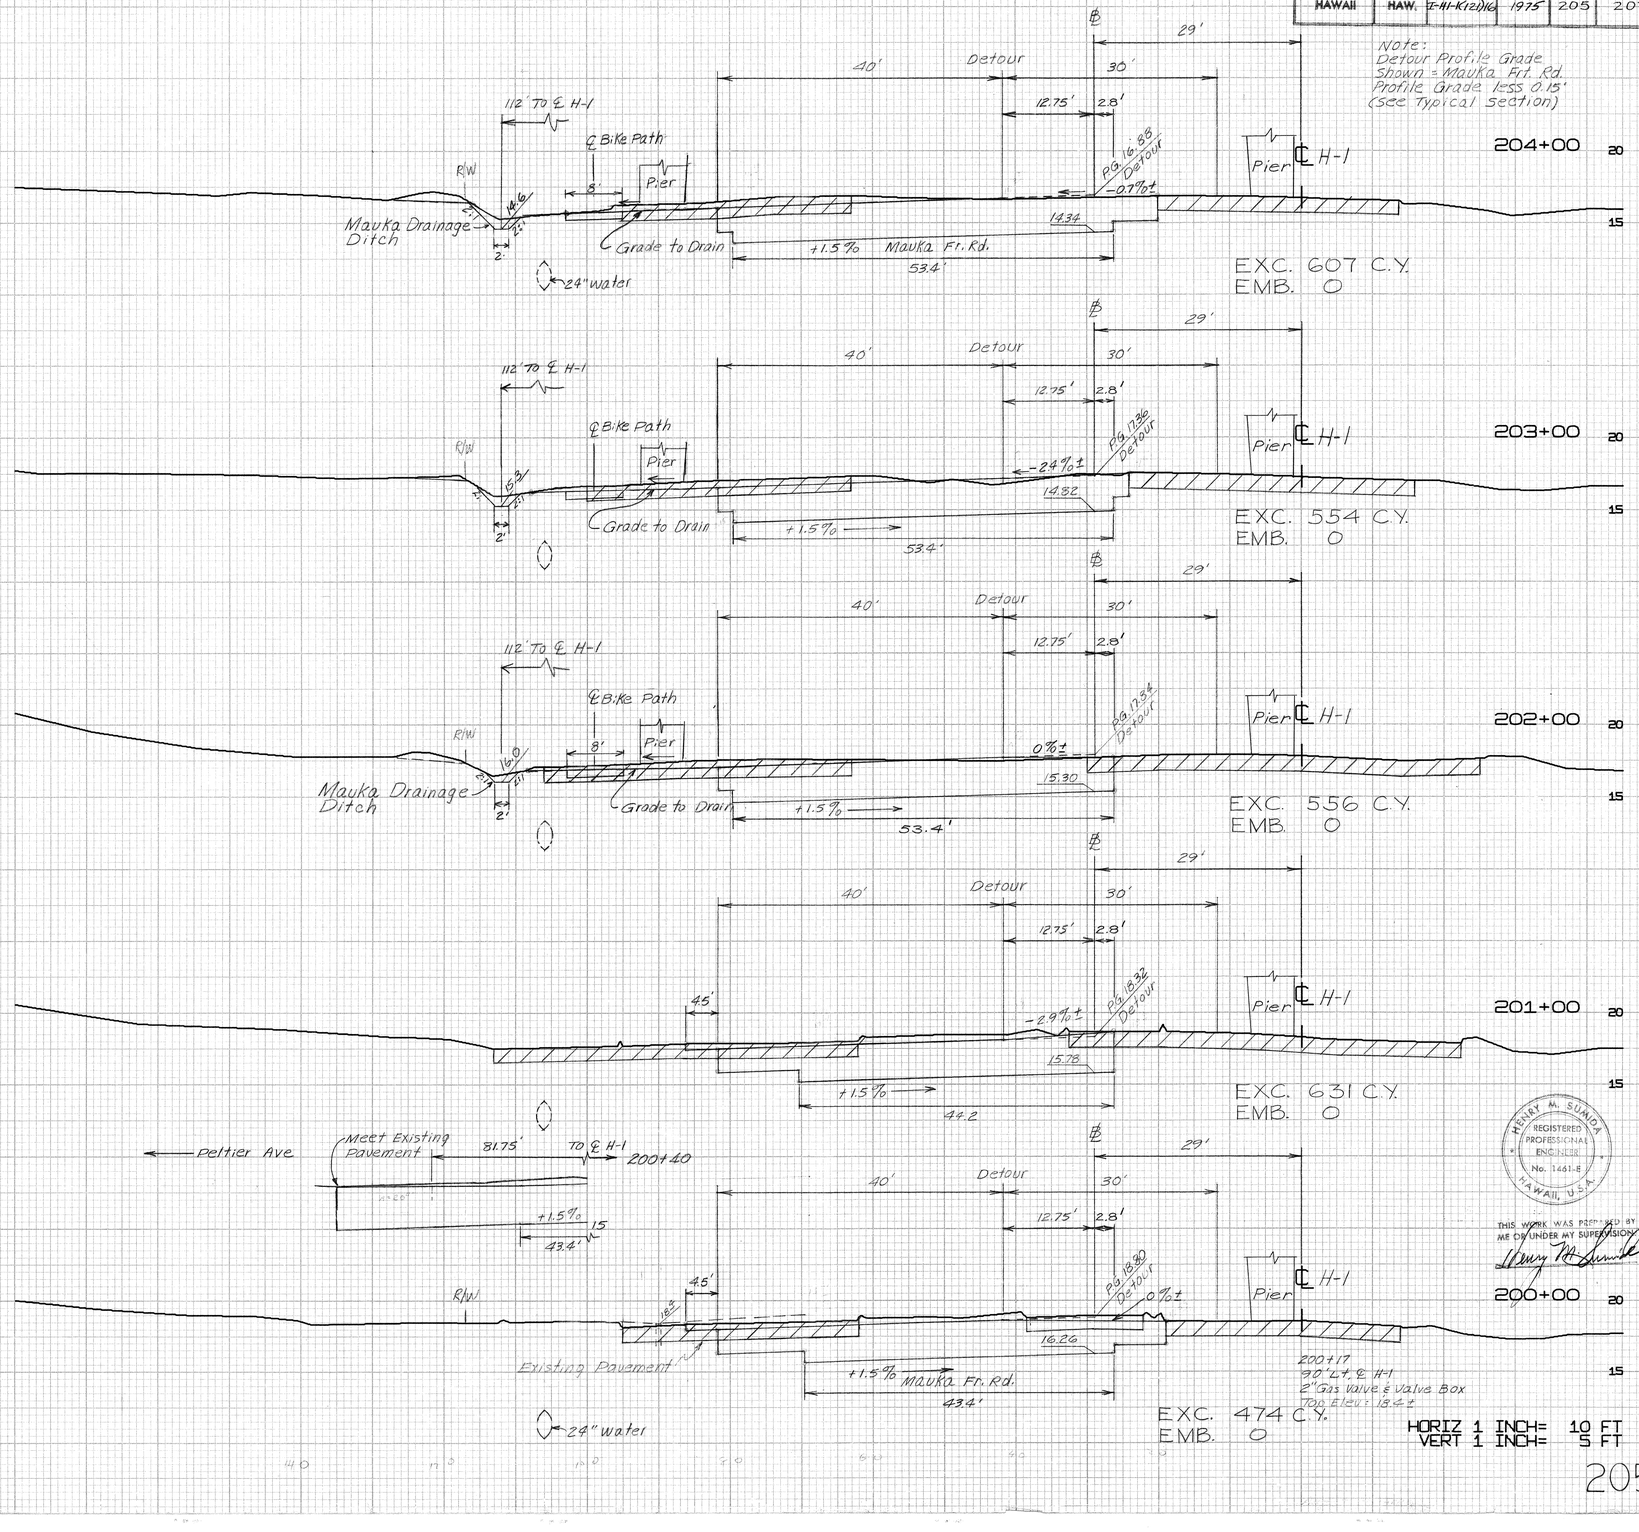


HENRY M. SUMIDA
REGISTERED PROFESSIONAL ENGINEER
No. 1461-E
HAWAII, U.S.A.

THIS WORK WAS PREPARED BY ME OR UNDER MY SUPERVISION

HORIZ 1 INCH= 10 FT
VERT 1 INCH= 5 FT

FED. ROAD DIST. NO.	STATE	FED. AID PROJ. NO.	FISCAL YEAR	SHEET NO.	TOTAL SHEETS
HAWAII	HAW.	I-HI-1(12)16	1975	206	207

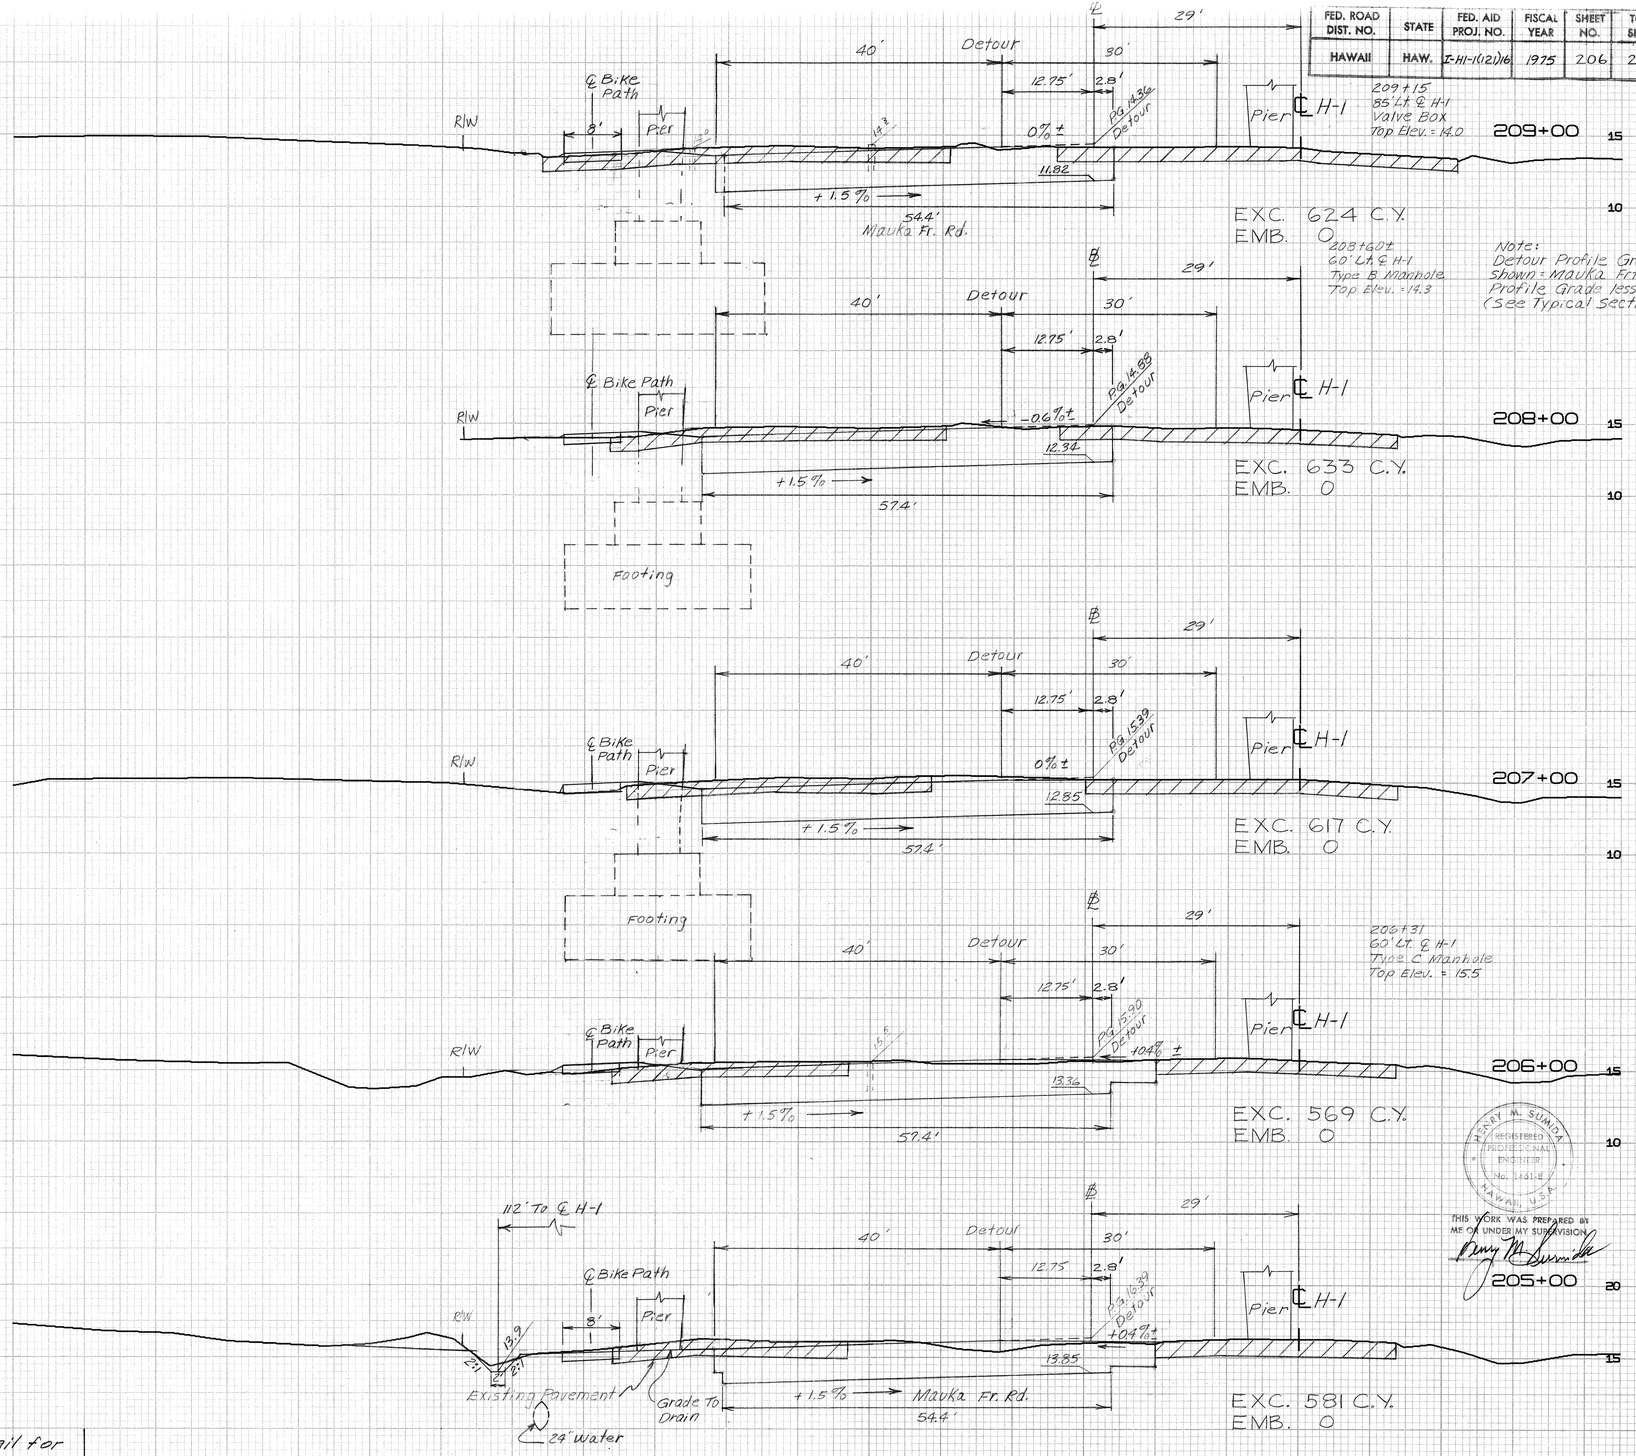


NO	DATE	REVISION
1	8-31-78	Revised Elev. of Bike Trail for Sta. 206+00 to 209+00

HORIZ 1 INCH= 10 FT
VERT 1 INCH= 5 FT

C0206

FED. ROAD DIST. NO.	STATE	FED. AID PROJ. NO.	FISCAL YEAR	SHEET NO.	TOTAL SHEETS
HAWAII	HAW.	I-HI-1(12)16	1975	207	207

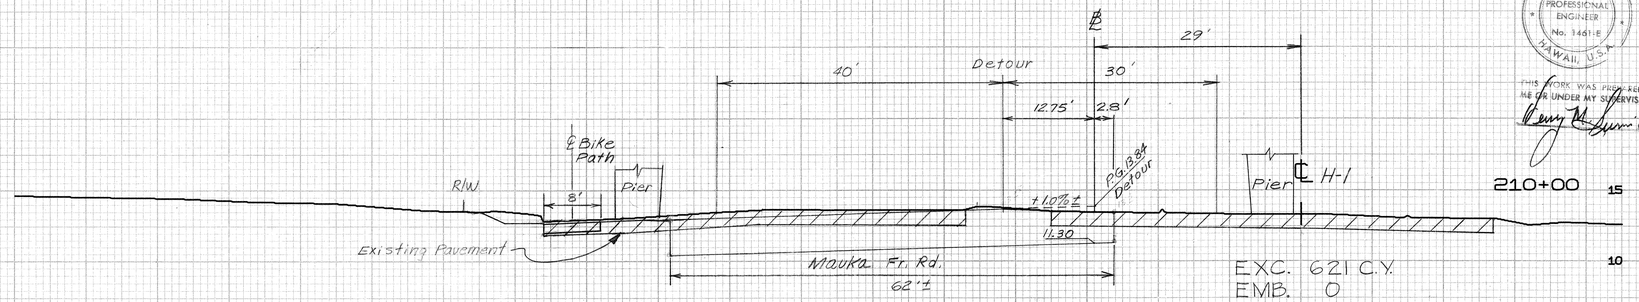

EXC. 621 C.Y.
EMB. 0

HORIZ 1 INCH= 10 FT
VERT 1 INCH= 5 FT

HENRY M. SUMIDA
REGISTERED PROFESSIONAL ENGINEER
No. 1461-E
HAWAII, U.S.A.

THIS WORK WAS PREPARED BY ME OR UNDER MY SUPERVISION

207