FED. ROAD DIST. NO.	STATE	FED. AID PROJ. NO.	FISCAL YEAR	SHEET NO.	TOTAL SHEETS
HAWAII	HAW.	BR-H1-1(225)	2000	1	37

STATE OF HAWAII

DEPARTMENT OF TRANSPORTATION

HIGHWAYS DIVISION

HONOLULU, HAWAII

"AS-BUILT"

PLANS FOR

INTERSTATE ROUTE H-1

SEISMIC RETROFIT FOR LUNALILO-VINEYARD OFF-RAMP, MAKIKI VIADUCT AND PALAMA SEPARATION

FEDERAL AID PROJECT NO. BR-H1-1(225)

DISTRICT OF HONOLULU

ISLAND OF OAHU

INDEX TO DRAWINGS

SHEET NO.	DESCRIPTION
1	TITLE SHEET
2	STANDARD PLANS SUMMARY
3	GENERAL NOTES
4 – 5	MAKIKI VIADUCT AIRSPACE, EXISTING CONDITIONS
6	PALAMA SEPARATION AIRSPACE, EXISTING CONDITONS
7	STRUCTURAL NOTES AND ABBREVIATIONS
	LUNALILO – VINEYARD OFF – RAMP
8	LAYOUT PLAN AND ESTIMATED QUANTITIES
9 – 11	ABUTMENT RETROFIT & METAL GUARDRAIL DETAILS
12 – 13	FIXED AND EXPANSION JOINT PLAN, ELEVATION AND DETAILS
14	PIER NO. 2 FOOTING RETROFIT DETAILS
	MAKIKI VIADUCT
15	LAYOUT PLAN AND ESTIMATED QUANTITIES
16	ABUT. NO. 1 AND NO. 2, PLAN AND ELEV.
17 – 19	FIXED AND EXPANSION JOINT RETROFIT DETAILS
	PALAMA SEPARATION
20	LAYOUT PLAN AND ESTIMATED QUANTITIES
21	COMPOSITE COLUMN RETROFIT AND CONCRETE FOOTING RETROFIT DETAILS
22	ABUT. NO. 1 AND NO. 2, PLAN AND ELEV., FOOTING AND COMPOSITE COLUMN RETROFIT DETAILS
23 – 24	ABUT. NO. 1 AND NO.2 RETROFIT DETAILS
25 – 27	FIXED JOINT RETROFIT DETAILS
28 – 29	EXPANSION JOINT RETROFIT DETAILS
30 – 31	MISCELLANEOUS DETAILS
32	LUNALILO-VINEYARD OFF-RAMP, EXISTING CONCRETE MEDIAN BARRIER
33	ROADWAY CONSTRUCTION PLAN TMK 2-4-12:21
34 – 35	CONSTRUCTION PHASING NOTES AND PLAN
36 – 37	PAVEMENT MARKING & SIGNING PLANS AND NOTES

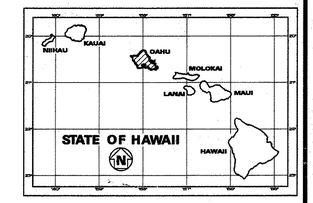

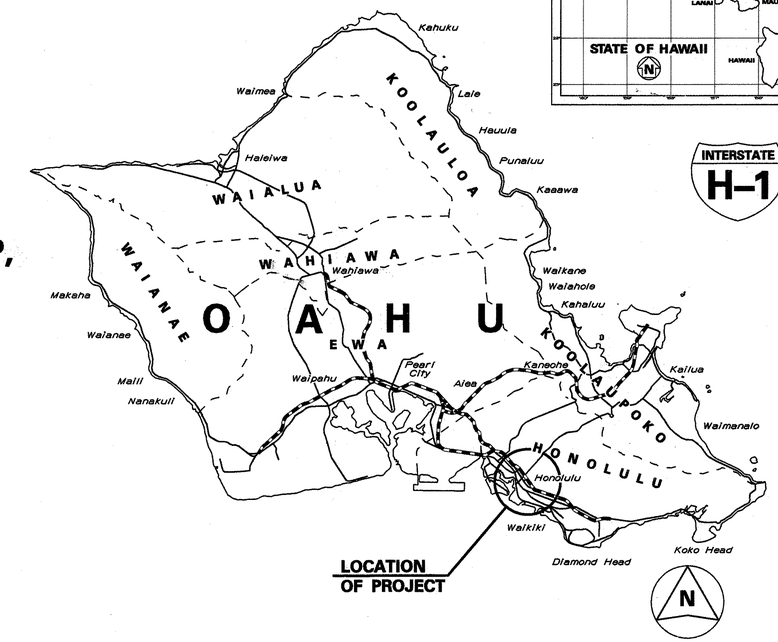

FEDERAL AID INTERSTATE PROJECTS PREVIOUSLY CONSTRUCTED OR UNDER CONSTRUCTION

PALAMA SEPARATION MILE POST 20.91 TO MILE POST 21.02

LUNALILO-VINEYARD OFF-RAMP MILE POST 22.48

MAKIKI VIADUCT MILE POST 22.93 TO MILE POST 23.22

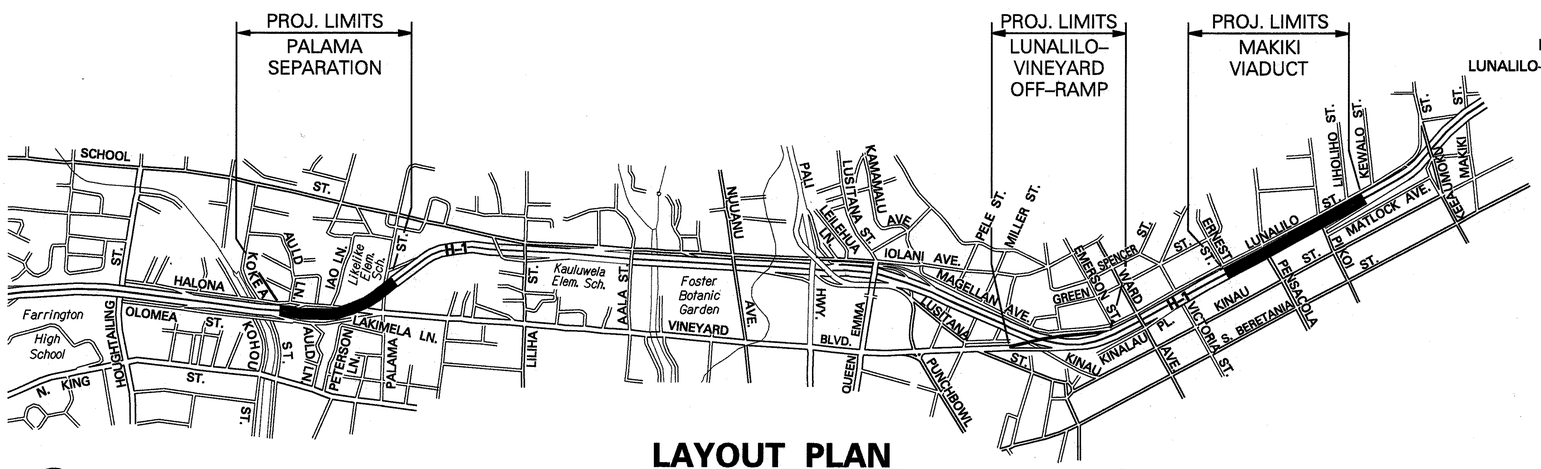

LAYOUT PLAN

GROSS LENGTH OF PROJECT..... 2.31 MILES

NET LENGTH OF PROJECT..... 0.5 MILES

CHANGES MADE DURING CONSTRUCTION HAVE BEEN INCORPORATED ON THESE PLANS EXCEPT CHANGES IN THE ORIGINAL THEORETICAL QUANTITIES. FOR ACTUAL QUANTITIES, REFER TO PROJECT LEDGER AND/OR COMPUTATION BOOK.

RESIDENT ENGINEER — DATE 10/31/05

DEPARTMENT OF TRANSPORTATION
STATE OF HAWAII

APPROVED: 8/18/99

DIR. OF TRANSPORTATION — DATE

HWY-DB/HWYDD DESIGNED BY	K. TATSUGUCHI P. S. & E. BY	692-7578 PHONE	AUG., 1999 DATE