

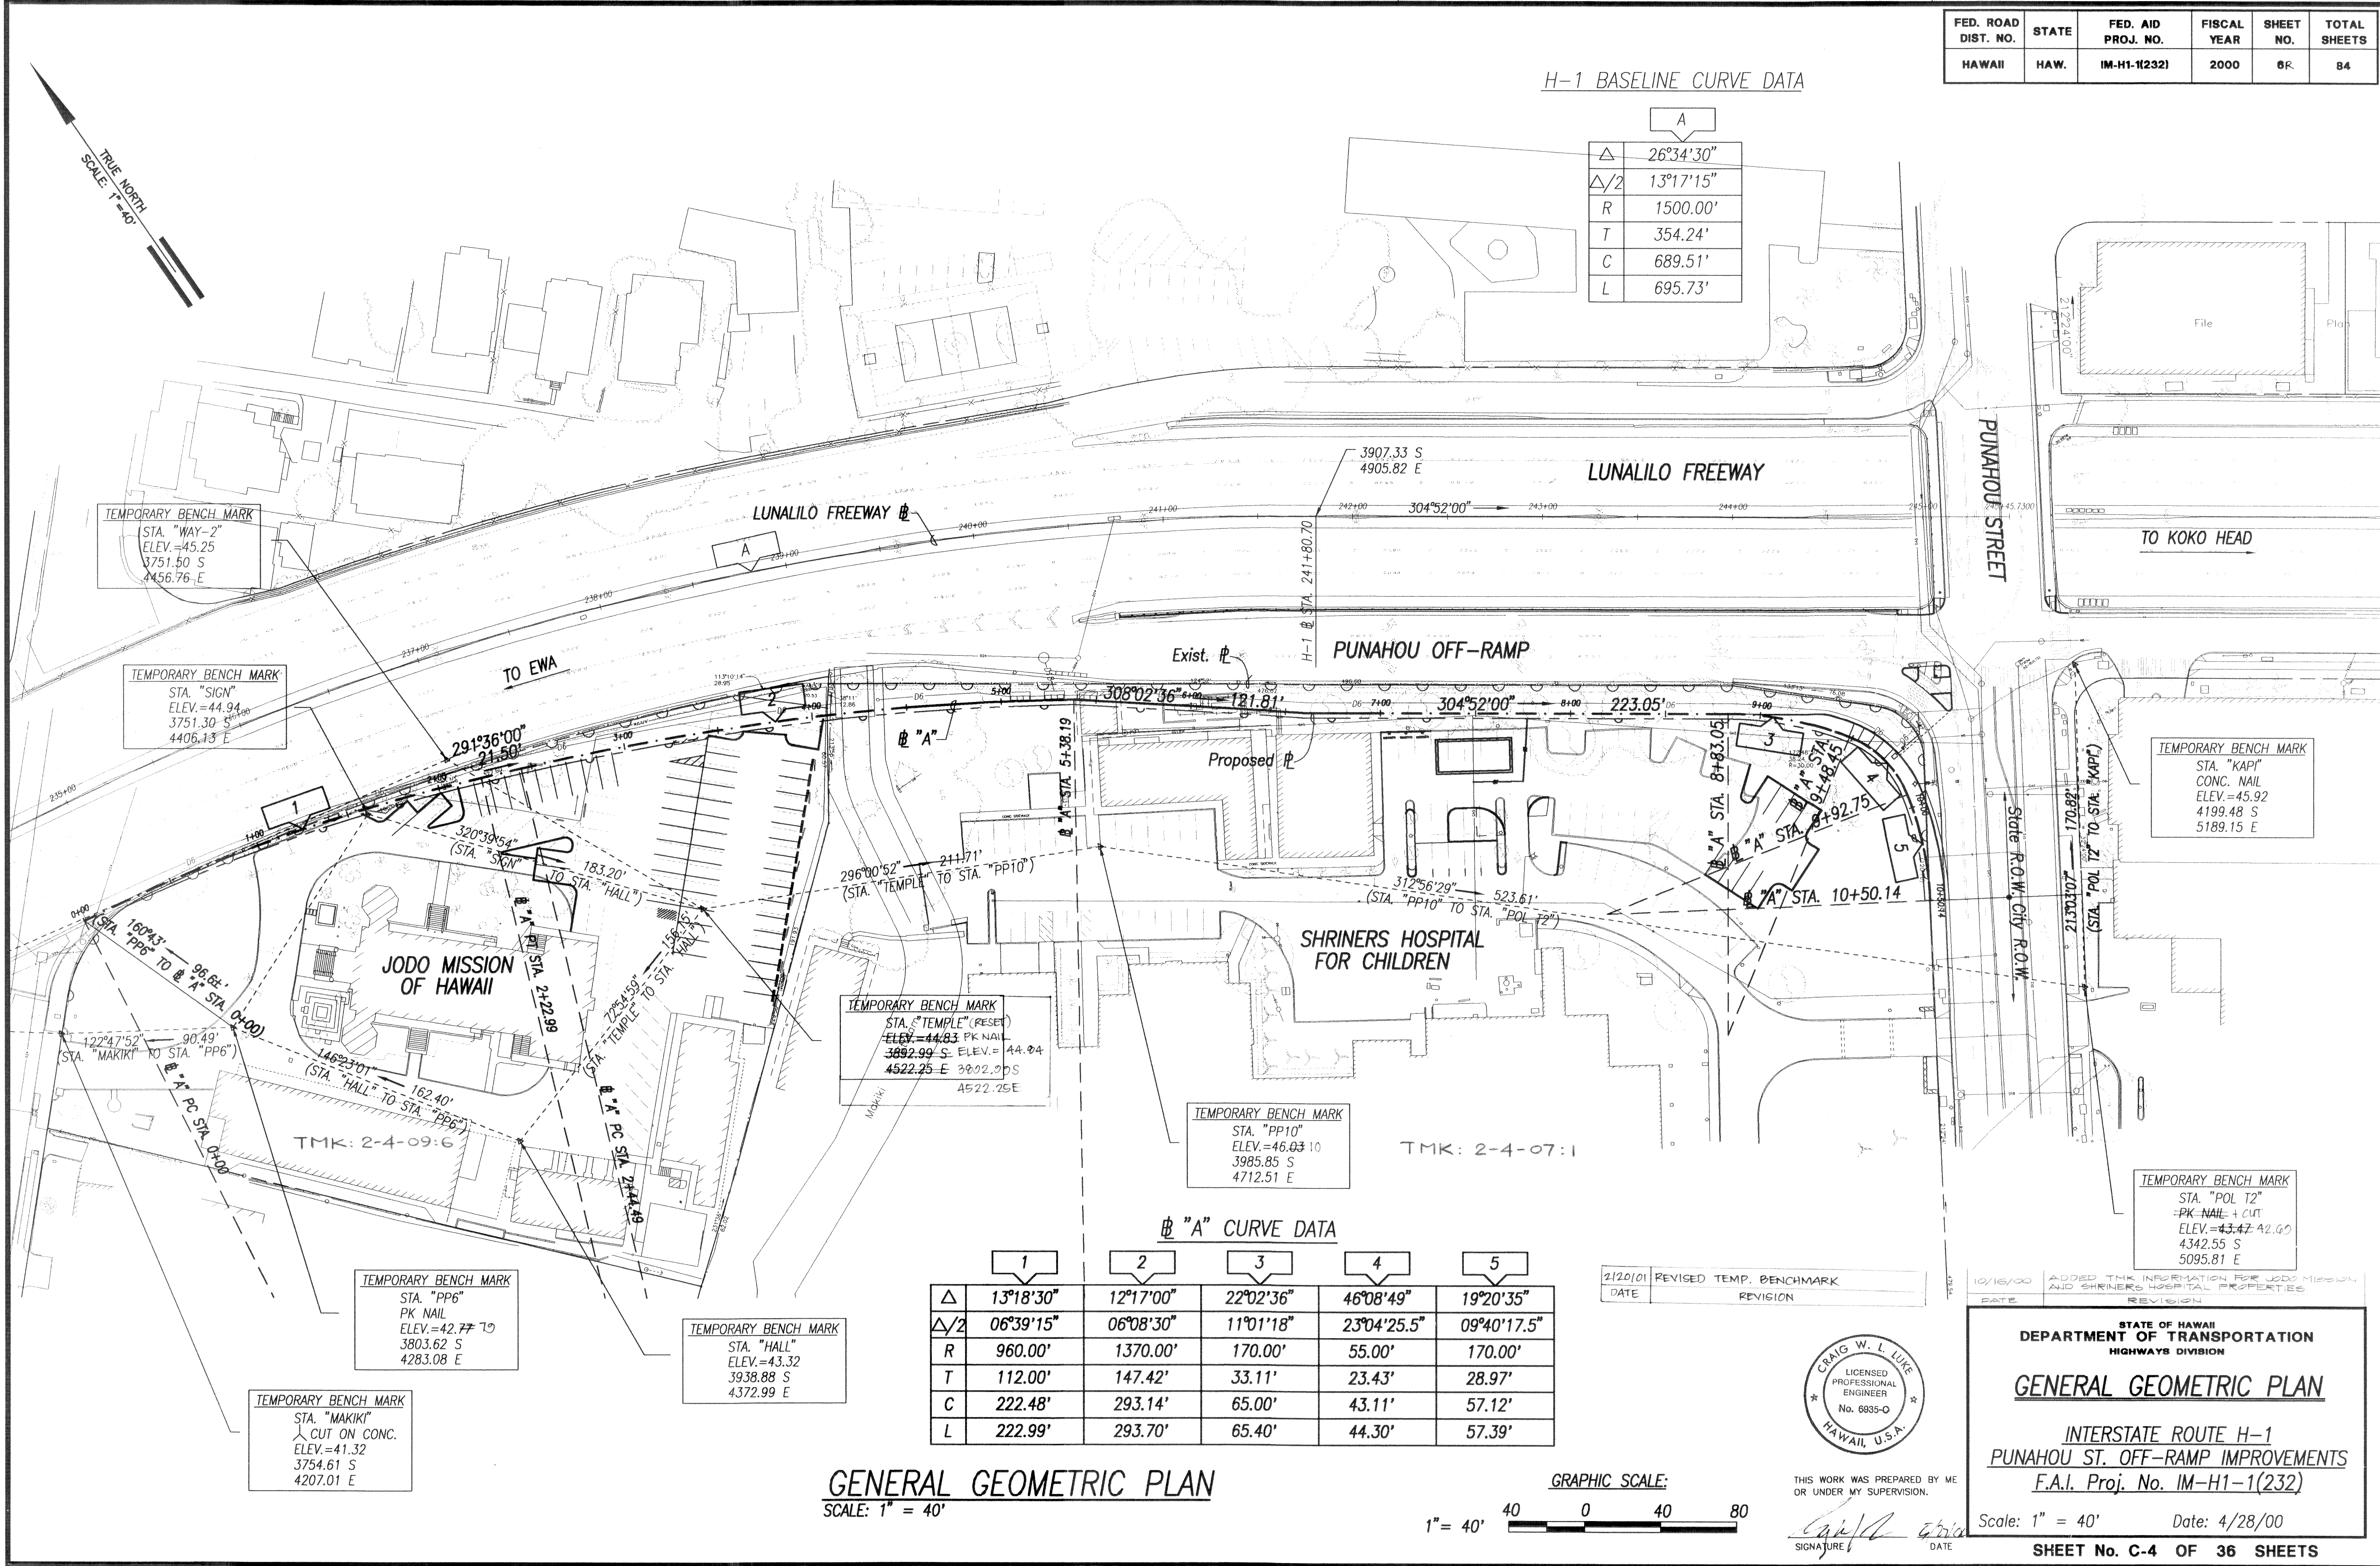


FED. ROAD DIST. NO.	STATE	FED. AID PROJ. NO.	FISCAL YEAR	SHEET NO.	TOTAL SHEETS
HAWAII	HAW.	IM-H1-1(232)	2000	6R	84

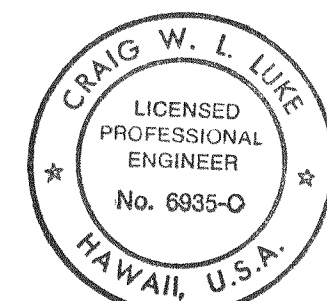


GENERAL GEOMETRIC PLAN
SCALE: 1" = 40'

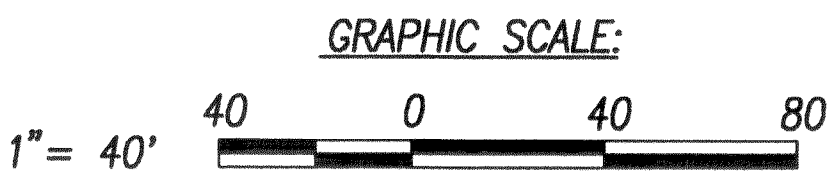

THIS WORK WAS PREPARED BY ME
OR UNDER MY SUPERVISION.

SIGNATURE DATE

STATE OF HAWAII
DEPARTMENT OF TRANSPORTATION
HIGHWAYS DIVISION

GENERAL GEOMETRIC PLAN

INTERSTATE ROUTE H-1
PUNAHOU ST. OFF-RAMP IMPROVEMENTS
F.A.I. Proj. No. IM-H1-1(232)

Scale: 1" = 40' Date: 4/28/00

SHEET No. C-4 OF 36 SHEETS