FED. ROAD DIST. NO.	STATE	FED. AID PROJ. NO.	FISCAL YEAR	SHEET NO.	TOTAL SHEETS
HAWAII	HAW.	IM-H1-1(232)	2000	21R	84

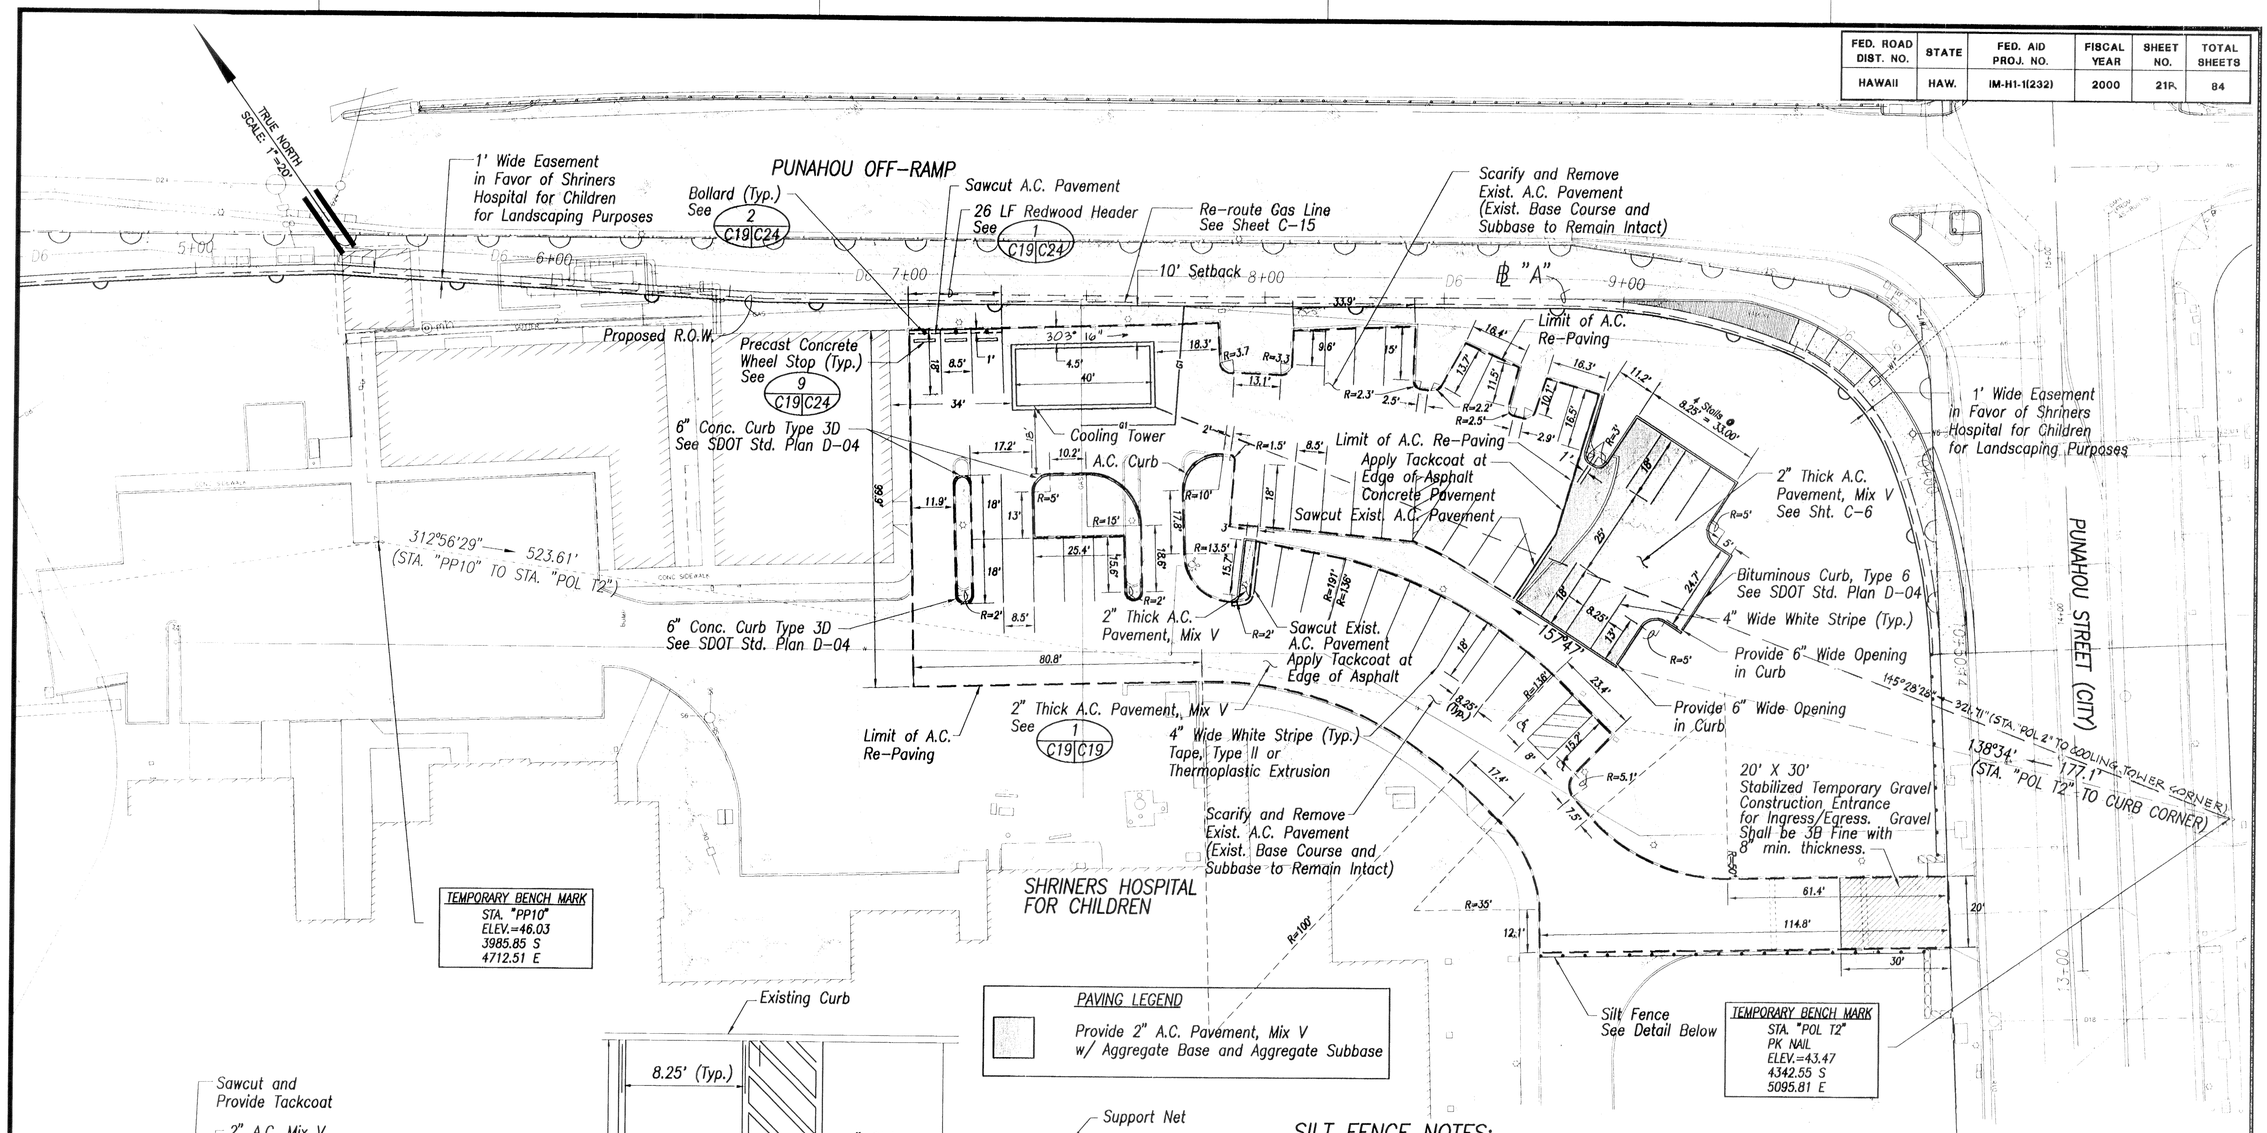

PAVING LEGEND

Provide 2" A.C. Pavement, Mix V w/ Aggregate Base and Aggregate Subbase

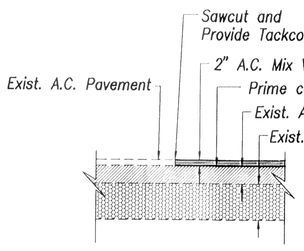

Note:
This detail shall only be used in areas of the parking lot that require resurfacing. Complete pavement sections shall be provided for shaded areas of the plan.

1 C19 C19 PARKING LOT RE-PAVING SECTION
SCALE: 1/2" = 1'-0"

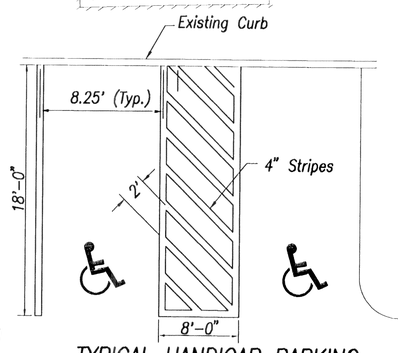

TYPICAL HANDICAP PARKING STALL MARKINGS
NOT TO SCALE

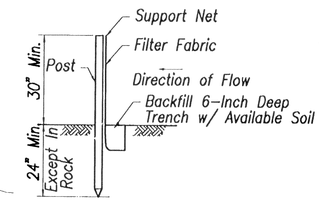

SILT FENCE DETAIL
NOT TO SCALE

SILT FENCE NOTES:

1. Filter fabric shall be approved and installed in combination with a support net of polyester netting or approved equal. The filter fabric shall be a minimum of 36 inches wide and the support net a minimum of 30 inches.
2. If silt fence is obtained from manufacturer as a package (i.e. fabric attached to posts) the manufacturers installation instructions shall be adhered to.
3. Posts shall be metal, wherever possible. Cross section of post will be substantial enough to support a loaded silt fence without bending. Post spacing shall be 4' to 8', depending on post size.

APPROVED:
Chief, Civil Engineering Branch, DPP — Date 5/25/00

CRAIG W. L. LUAE LICENSED PROFESSIONAL ENGINEER No. 6835-C HAWAII, U.S.A.

THIS WORK WAS PREPARED BY ME OR UNDER MY SUPERVISION.
SIGNATURE — DATE 5/22/00

STATE OF HAWAII
DEPARTMENT OF TRANSPORTATION
HIGHWAYS DIVISION

SHRINERS HOSPITAL FOR CHILDREN
SITE LAYOUT AND UTILITY PLAN

INTERSTATE ROUTE H-1
PUNAHOU ST. OFF-RAMP IMPROVEMENTS
F.A.I. Proj. No. IM-H1-1(232)

Scale: 1" = 20' Date: 4/28/00

SHEET No. C-19 OF 36 SHEETS

DATE	REVISION
12/27/00	ADDED DIMENSION TO COOLING TOWER. ADD TIE TO COOLING TOWER CORNER.

SHRINERS HOSPITAL FOR CHILDREN
SITE LAYOUT AND UTILITY PLAN
SCALE: 1" = 20'

GRAPHIC SCALE:
1"= 20' 20 0 20 40

ORIGINAL PLAN | SURVEY PLOTTED BY | PLANS BY | PROJECT BY | DESIGNED BY | QUANTITIES BY | CHECKED BY | NOTE BOOK | No. | DATE

21R