FED. ROAD DIST. NO.	STATE	FED. AID PROJ. NO.	FISCAL YEAR	SHEET NO.	TOTAL SHEETS
HAWAII	HAW.	I-HI-1(120)16	1976	2	173

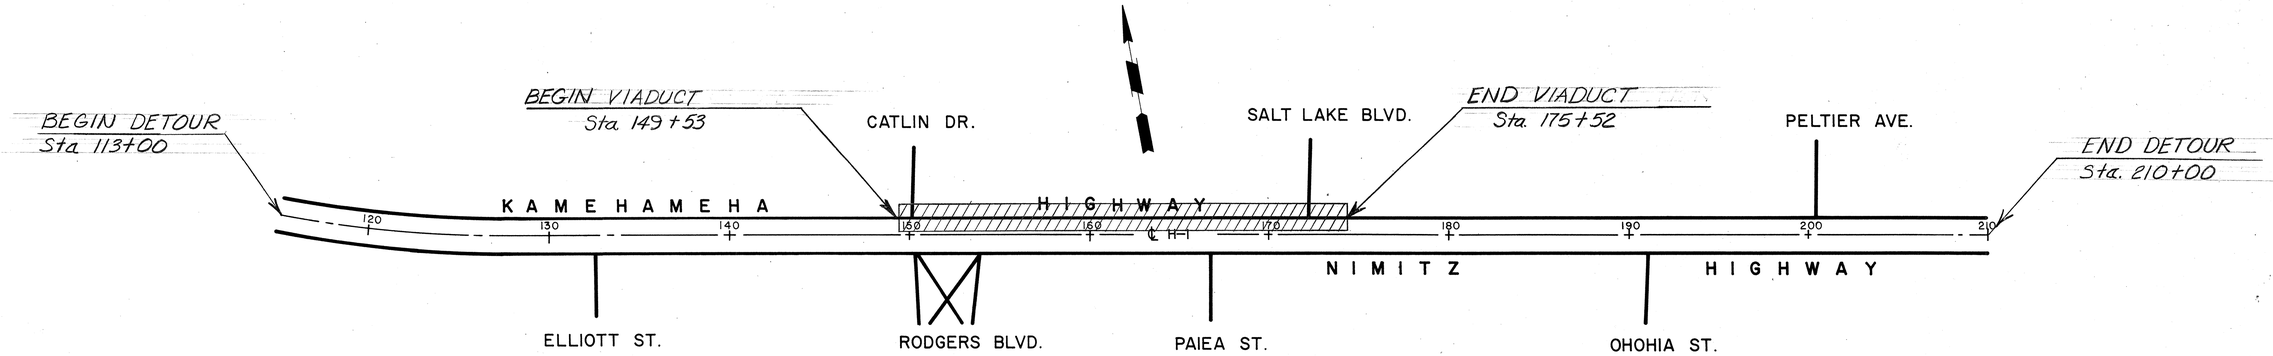

RECOMMENDED CONSTRUCTION PHASING

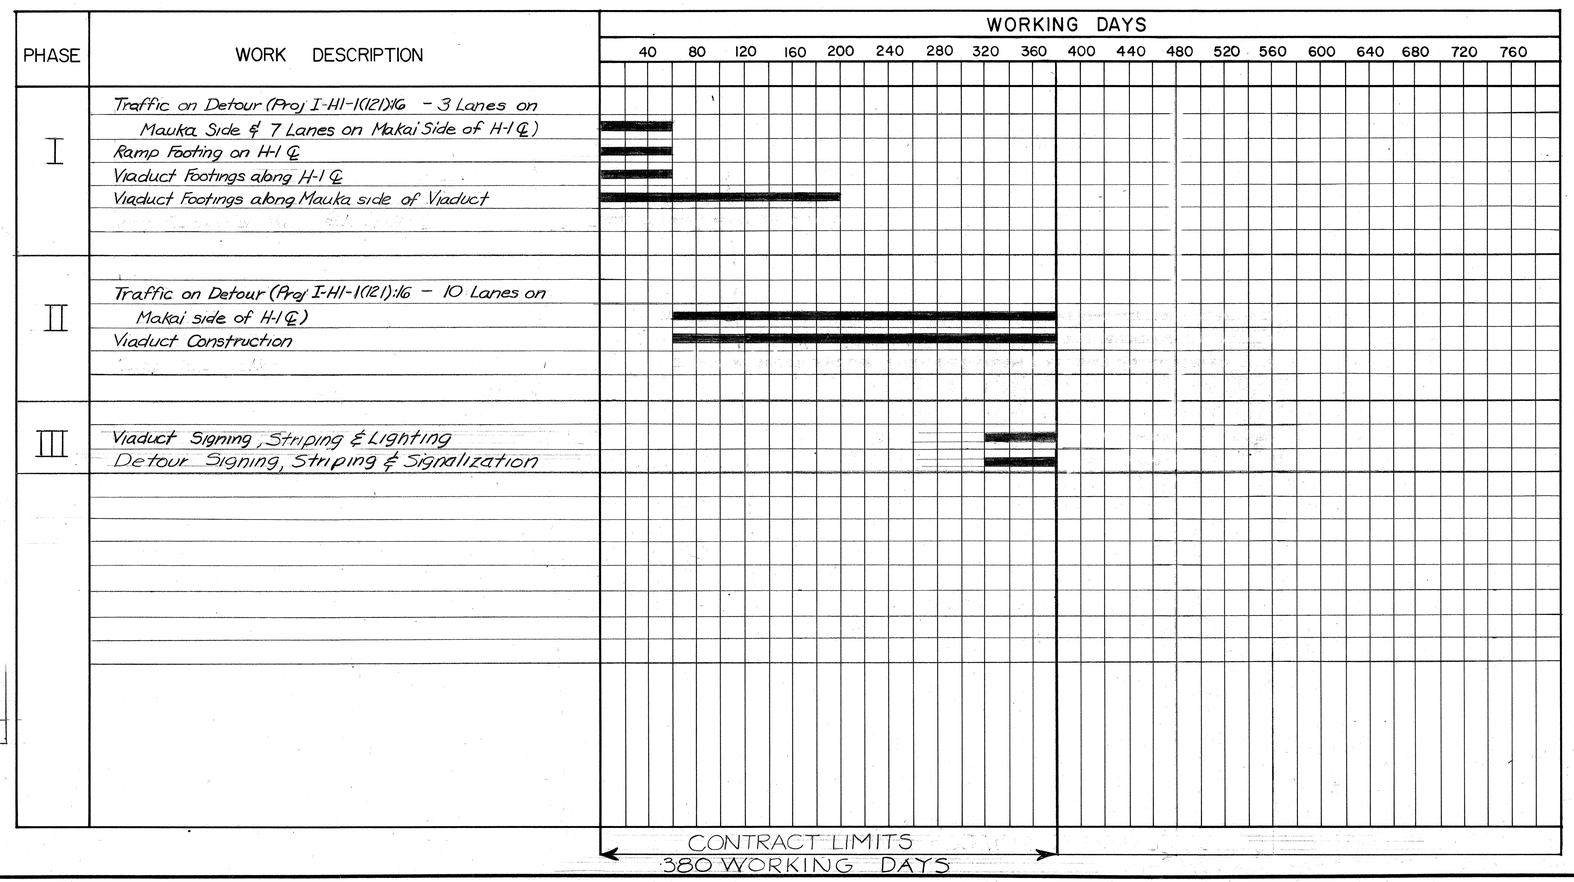

REVISED COMPLETION
380 WORKING DAYS

DATE	REVISION
5-10-76	Working Days Changed to 380.

ORIGINAL PLAN	SURVEY PLOTTED BY	DATE
	DRAWN BY	
	TRACED BY	
NOTE BOOK	DESIGNED BY	
No.	QUANTITIES BY	
	CHECKED BY	

HENRY M. SUMIDA
REGISTERED PROFESSIONAL ENGINEER
No. 1461-E
HAWAII, U.S.A.

THIS WORK WAS PREPARED BY ME OR UNDER MY SUPERVISION.

Henry M. Sumida

STATE OF HAWAII
DEPARTMENT OF TRANSPORTATION
HIGHWAYS DIVISION

CONSTRUCTION PHASING

AIRPORT INTERCHANGE
F.A.I. PROJECT I-HI-1(120)16

SCALE: NONE DATE: NOV. 1, 1975

SHEET No. 1 OF 1 SHEETS

ADD 2