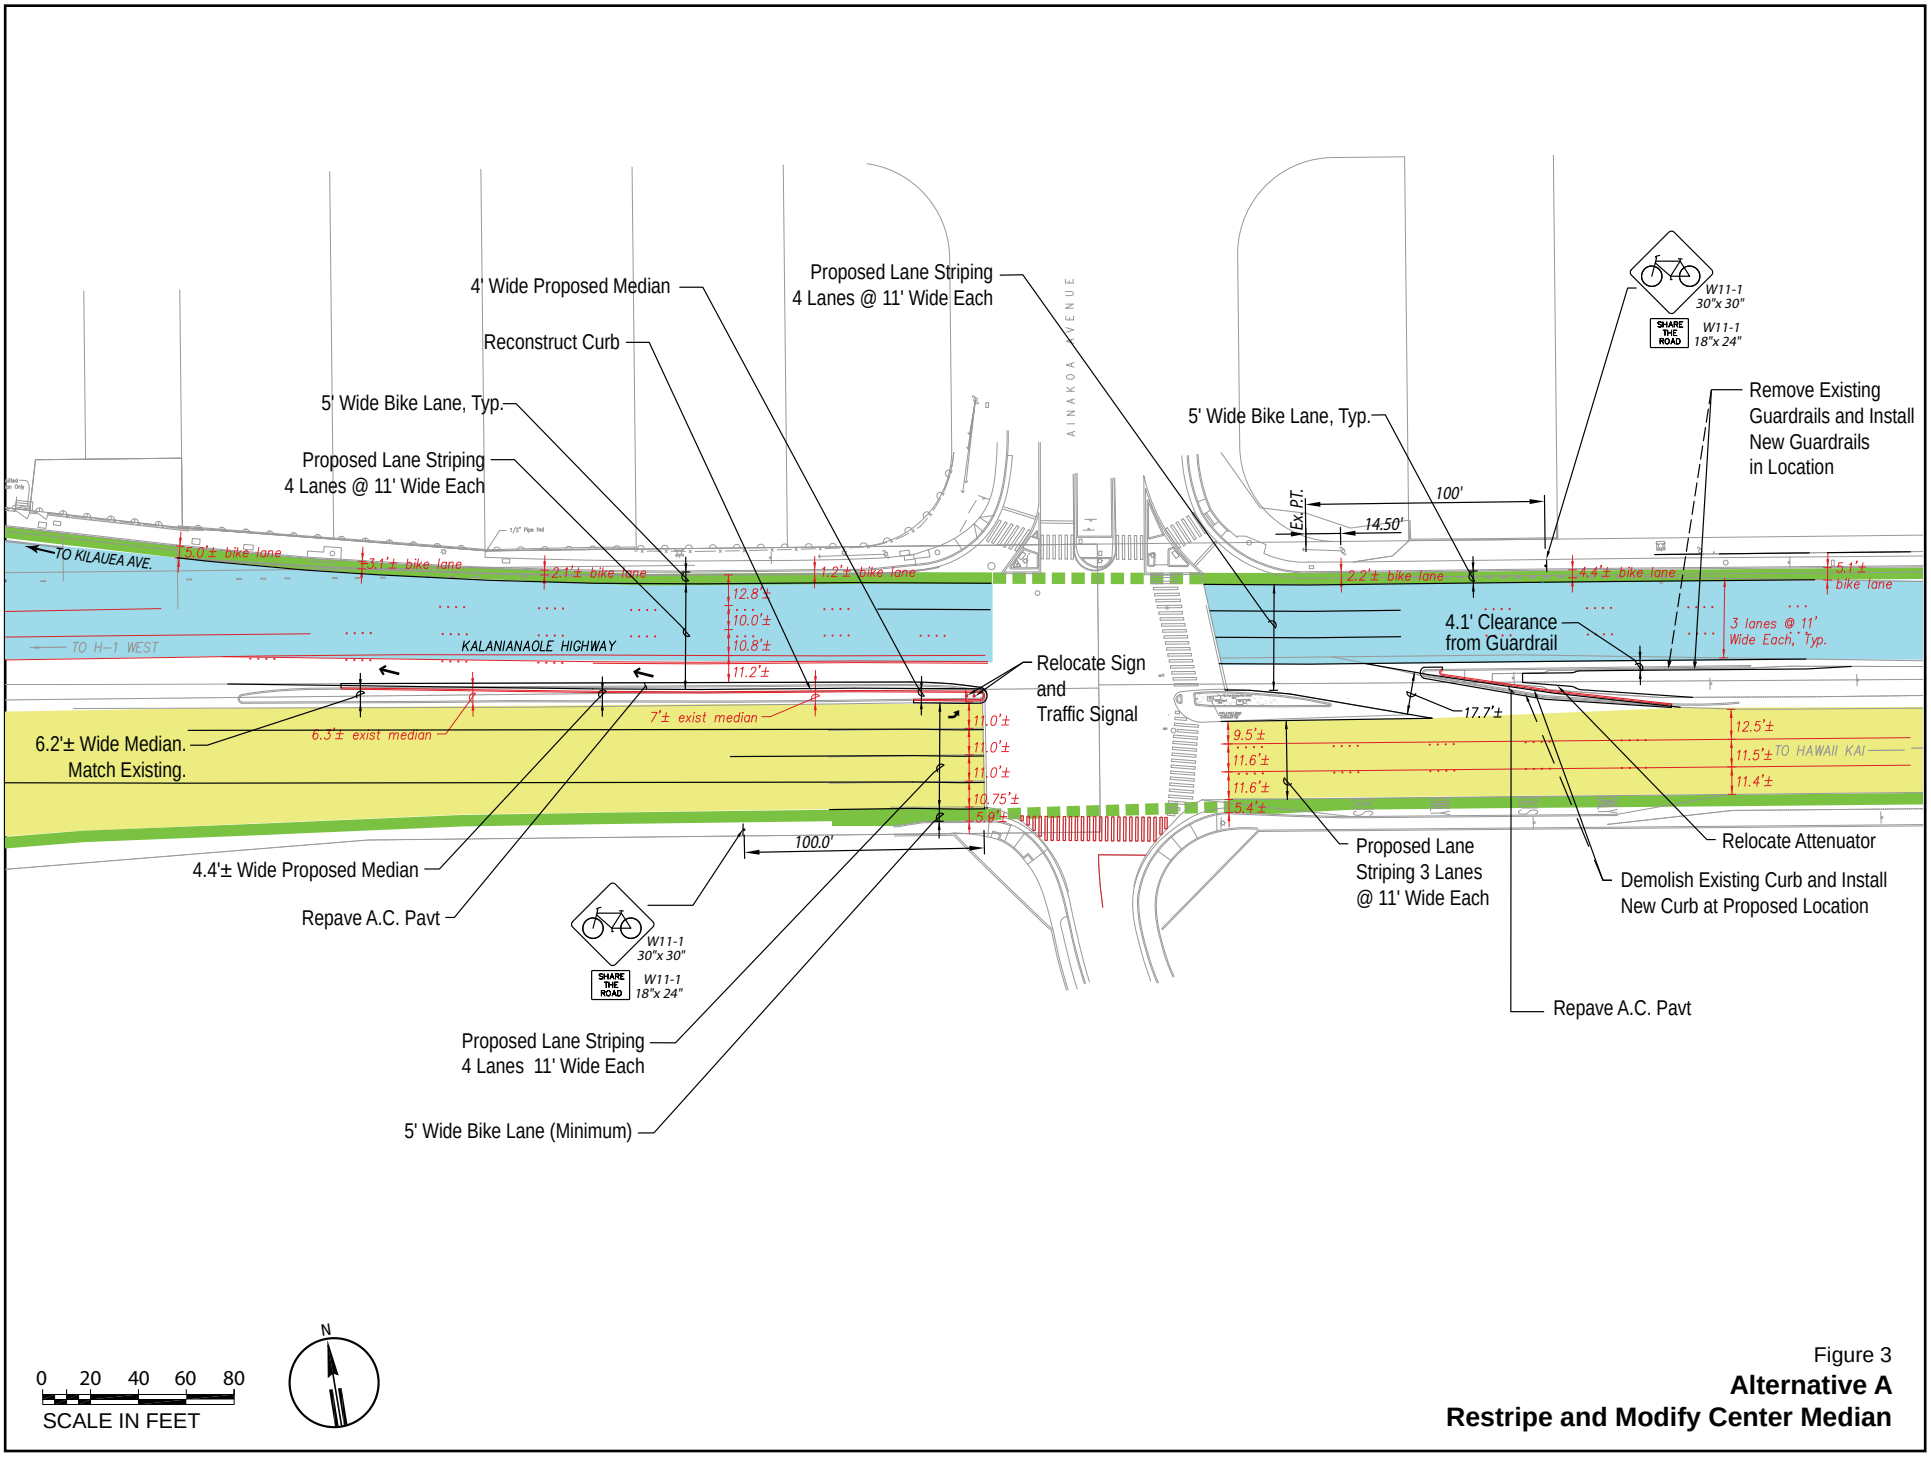

Figure 3
Alternative A
Restripe and Modify Center Median

090501/003 121311 r4