INDEX TO DRAWINGS	
SHEET NO.	DESCRIPTION
1	TITLE SHEET & VICINITY MAP
2, 2A	ESTIMATED QUANTITIES
3	LOCATION PLAN TEST AREAS 1A AND 1B
4	LOCATION PLAN & UTILITIES TEST AREA 2
C.O. 5	PILE LAYOUT, FIELD INSTRUMENTATION & UTILITIES AREAS 1A AND 1B
6, 6A	SAND DRAIN LAYOUT & FIELD INSTRUMENTATION AREA 2
C.O. 7	TYP. PILE DETAILS FOR 12" SQ. AND 16½" OCT. PILES
C.O. 8, 8A	SPLICE DETAILS SIMPLE AND MOMENT
C.O. 9	PILE INSTRUMENTATION PILES 1, 2 AND 4
C.O. 10	PILE INSTRUMENTATION PILE 5
C.O. 11	PILE INSTRUMENTATION PILES 6, 7, 8 AND 9
C.O. 12	STEEL SLEEVE DETAILS
13	PILES 3 AND J DETAILS - 20" COMPOSITE PILE
C.O. 14	PILE INSTRUMENTATION PILE 3
15	LOADING FRAME PLAN - ALTERNATIVE BID ITEM NO. 1
16	LOADING FRAME SECTIONS - ALTERNATIVE BID ITEM NO. 1
17	TABULATION OF FIELD INSTRUMENT LOCATIONS AND ELEVATIONS
18	INSTRUMENTS SUPPLIED BY CONTRACTOR
19	INSTRUMENTS SUPPLIED BY ENGINEER
20	SEQUENCE OF OPERATIONS
21	TEST DRIVING PILES A THRU J IN AREA 1B
22	BORING LOGS
23	TYPICAL SECTION AND GENERALIZED SOIL PROFILE AREA 1
24	TYPICAL SECTION AND GENERALIZED SOIL PROFILE AREA 2
C.O. 25	MASTER PILE SCHEDULE
26	DETAILS - CHAIN LINK FENCE
27-31	STANDARD DETAILS - FIELD OFFICE & PROJECT SITE LABORATORY
32	LOADING FRAME - ALTERNATIVE BID ITEM NO. 2
33	INSTRUMENT INSTALLATION PLATFORM
34	INSTRUMENT READING PLATFORM
35	PILE LOAD TEST SEQUENCES
C.O. 35 S-1	CASTING OF CENTRAL HOLE FOR PILES 1-9

STATE OF HAWAII

DEPARTMENT OF TRANSPORTATION
HIGHWAYS DIVISION

HONOLULU, HAWAII

AS BUILT PLAN

FIELD TESTING PROGRAM

FOR

INTERSTATE ROUTE H-1

KEEHI INTERCHANGE

FEDERAL AID INTERSTATE PROJECT NO. I-H1-1(85)

DISTRICT OF HONOLULU
ISLAND OF OAHU

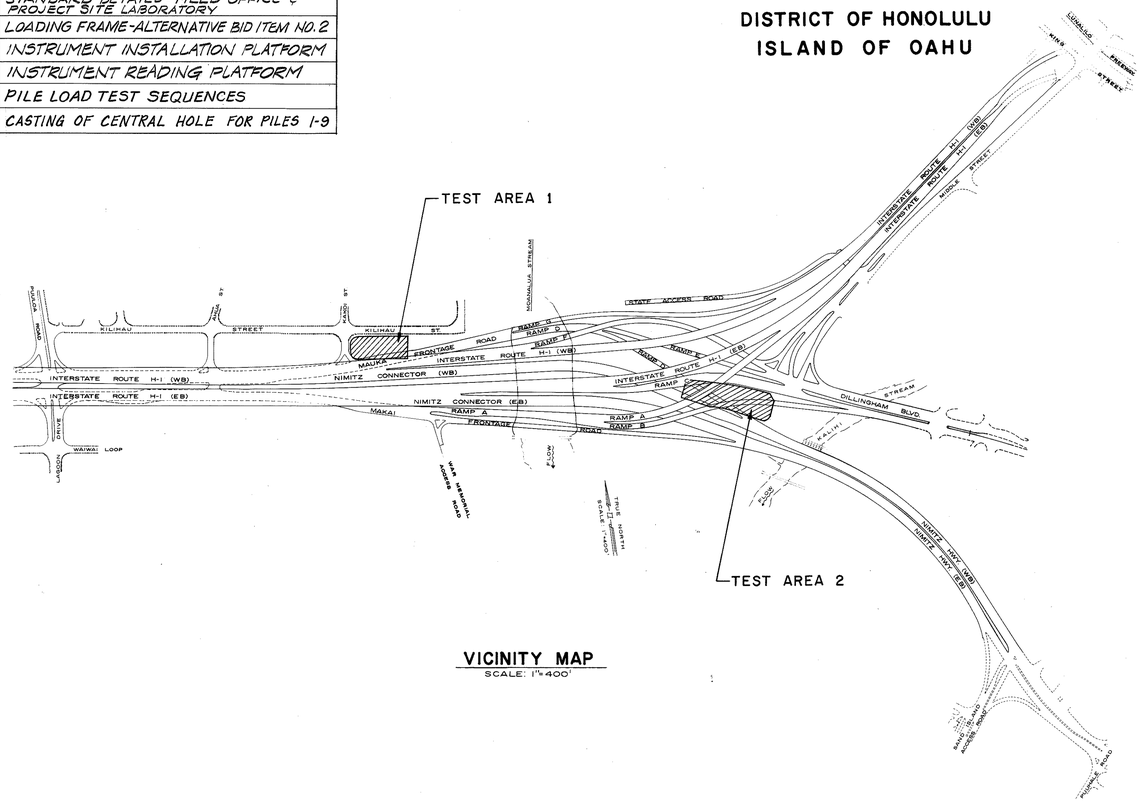

VICINITY MAP
SCALE: 1"=400'

FED. ROAD DIST. NO.	STATE	FED. AID PROJ. NO.	FISCAL YEAR	SHEET NO.	TOTAL SHEETS
HAWAII	HAW.	I-H1-1(85)	1976	1	38

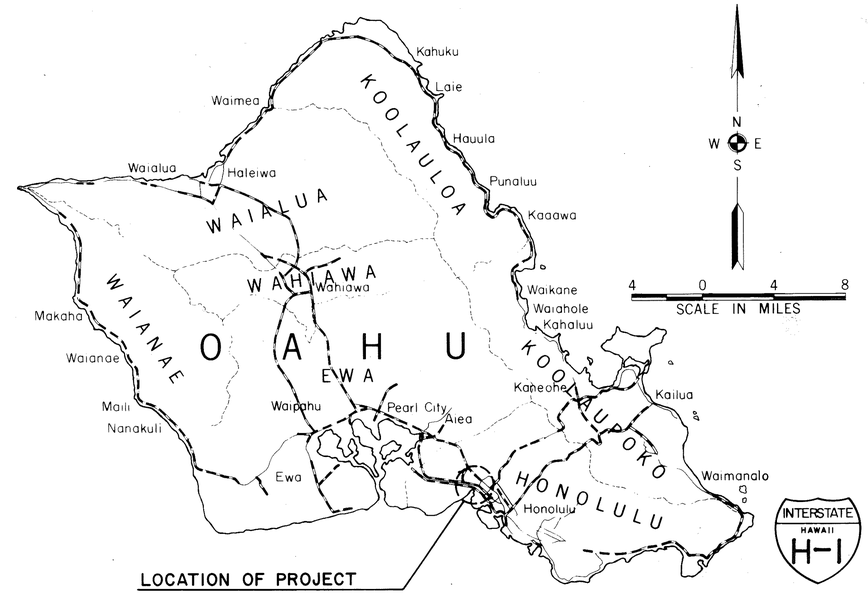

Federal Aid Projects Previously Constructed or Under Construction

ALL CHANGES MADE DURING CONSTRUCTION HAVE BEEN INCORPORATED ON THESE PLANS EXCEPT CHANGES IN THE ORIGINAL THEORETICAL QUANTITIES.

Robert Muronaka 3/8/79
ROBERT MURONAKA DATE

DEPARTMENT OF TRANSPORTATION FEDERAL HIGHWAY ADMINISTRATION	
APPROVED:	
DIVISION ENGINEER	6.29.76 DATE

DEPARTMENT OF TRANSPORTATION STATE OF HAWAII	
APPROVED:	
for DIR. OF TRANSPORTATION	R Higashionna 4/20/76 DATE

PARSONS, BRINCKERHOFF, HIROTA-ASSOCIATES DESIGNED BY
FRANK M. CLEMENTE, PE. P S & E BY
531-7094 PHONE
31MARCH76 DATE

D-3-4