



FED. ROAD DIST. NO.	STATE	FED. AID PROJ. NO.	FISCAL YEAR	SHEET NO.	TOTAL SHEETS
HAWAII	HAW.	TC-HI-K(258)	2006	22	89

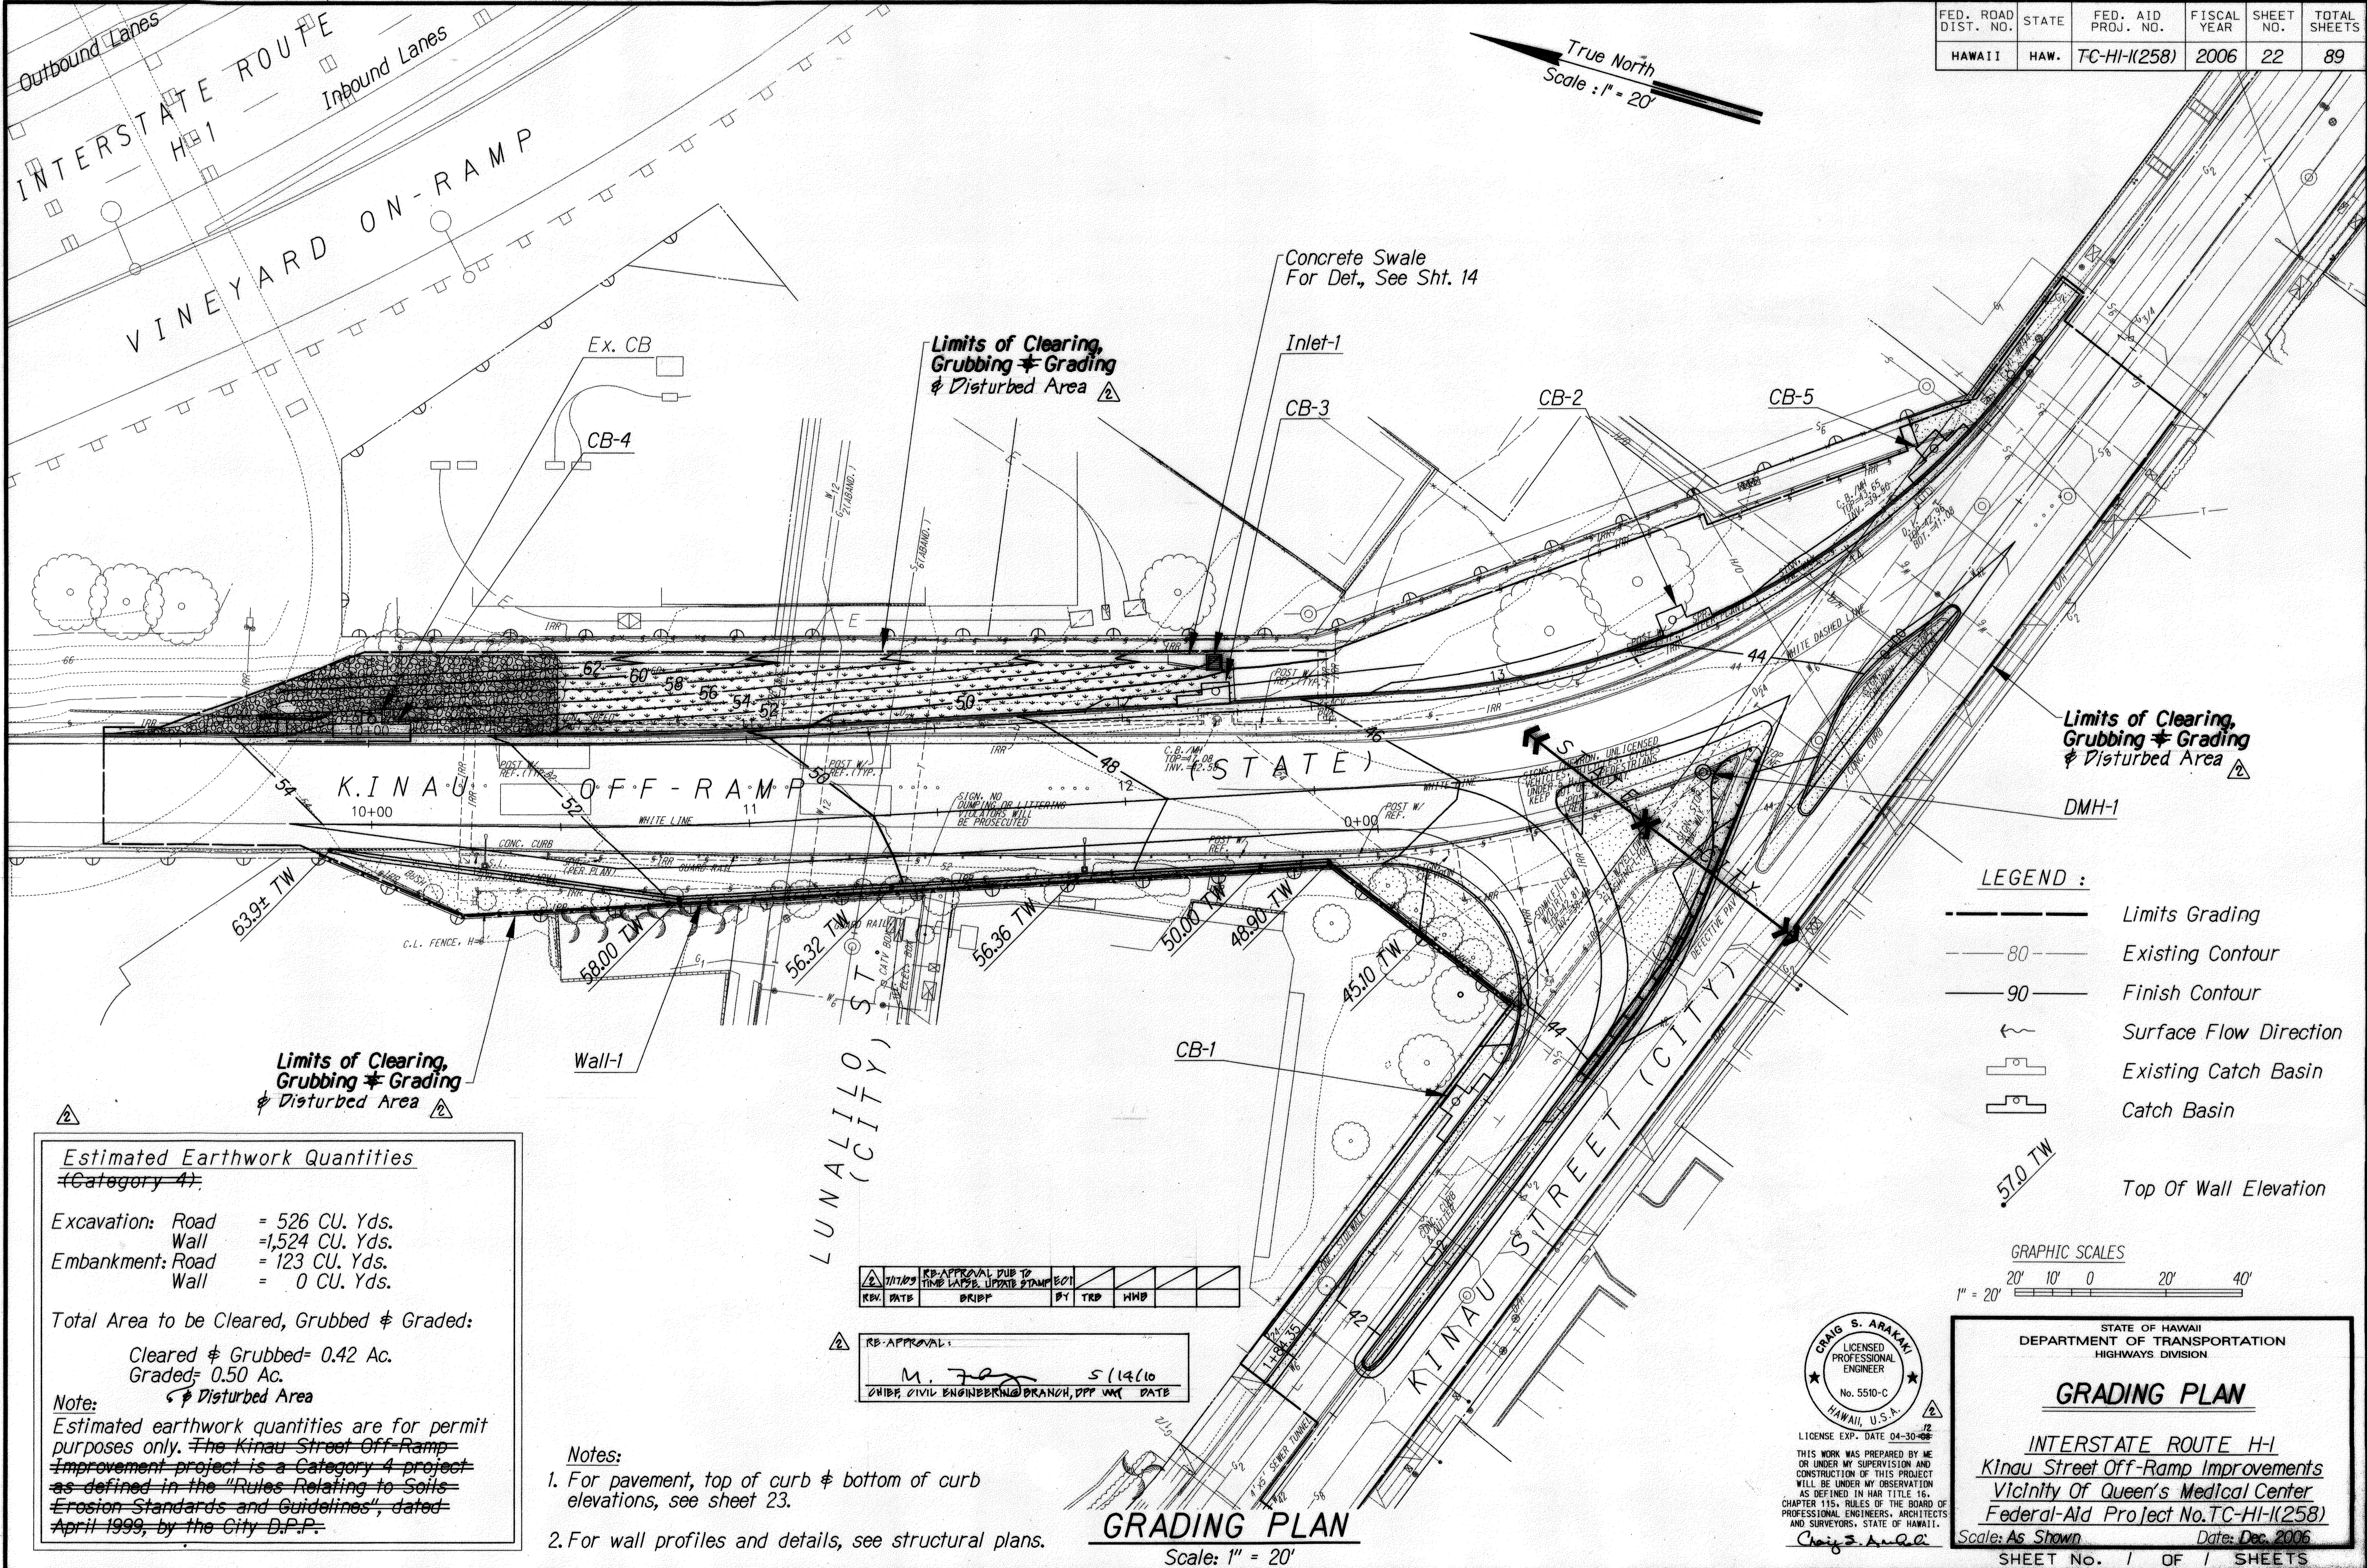

FED. ROAD DIST. NO.	STATE	FED. AID PROJ. NO.	FISCAL YEAR	SHEET NO.	TOTAL SHEETS
HAWAII	HAW.	TC-HI-K258	2006	23	89

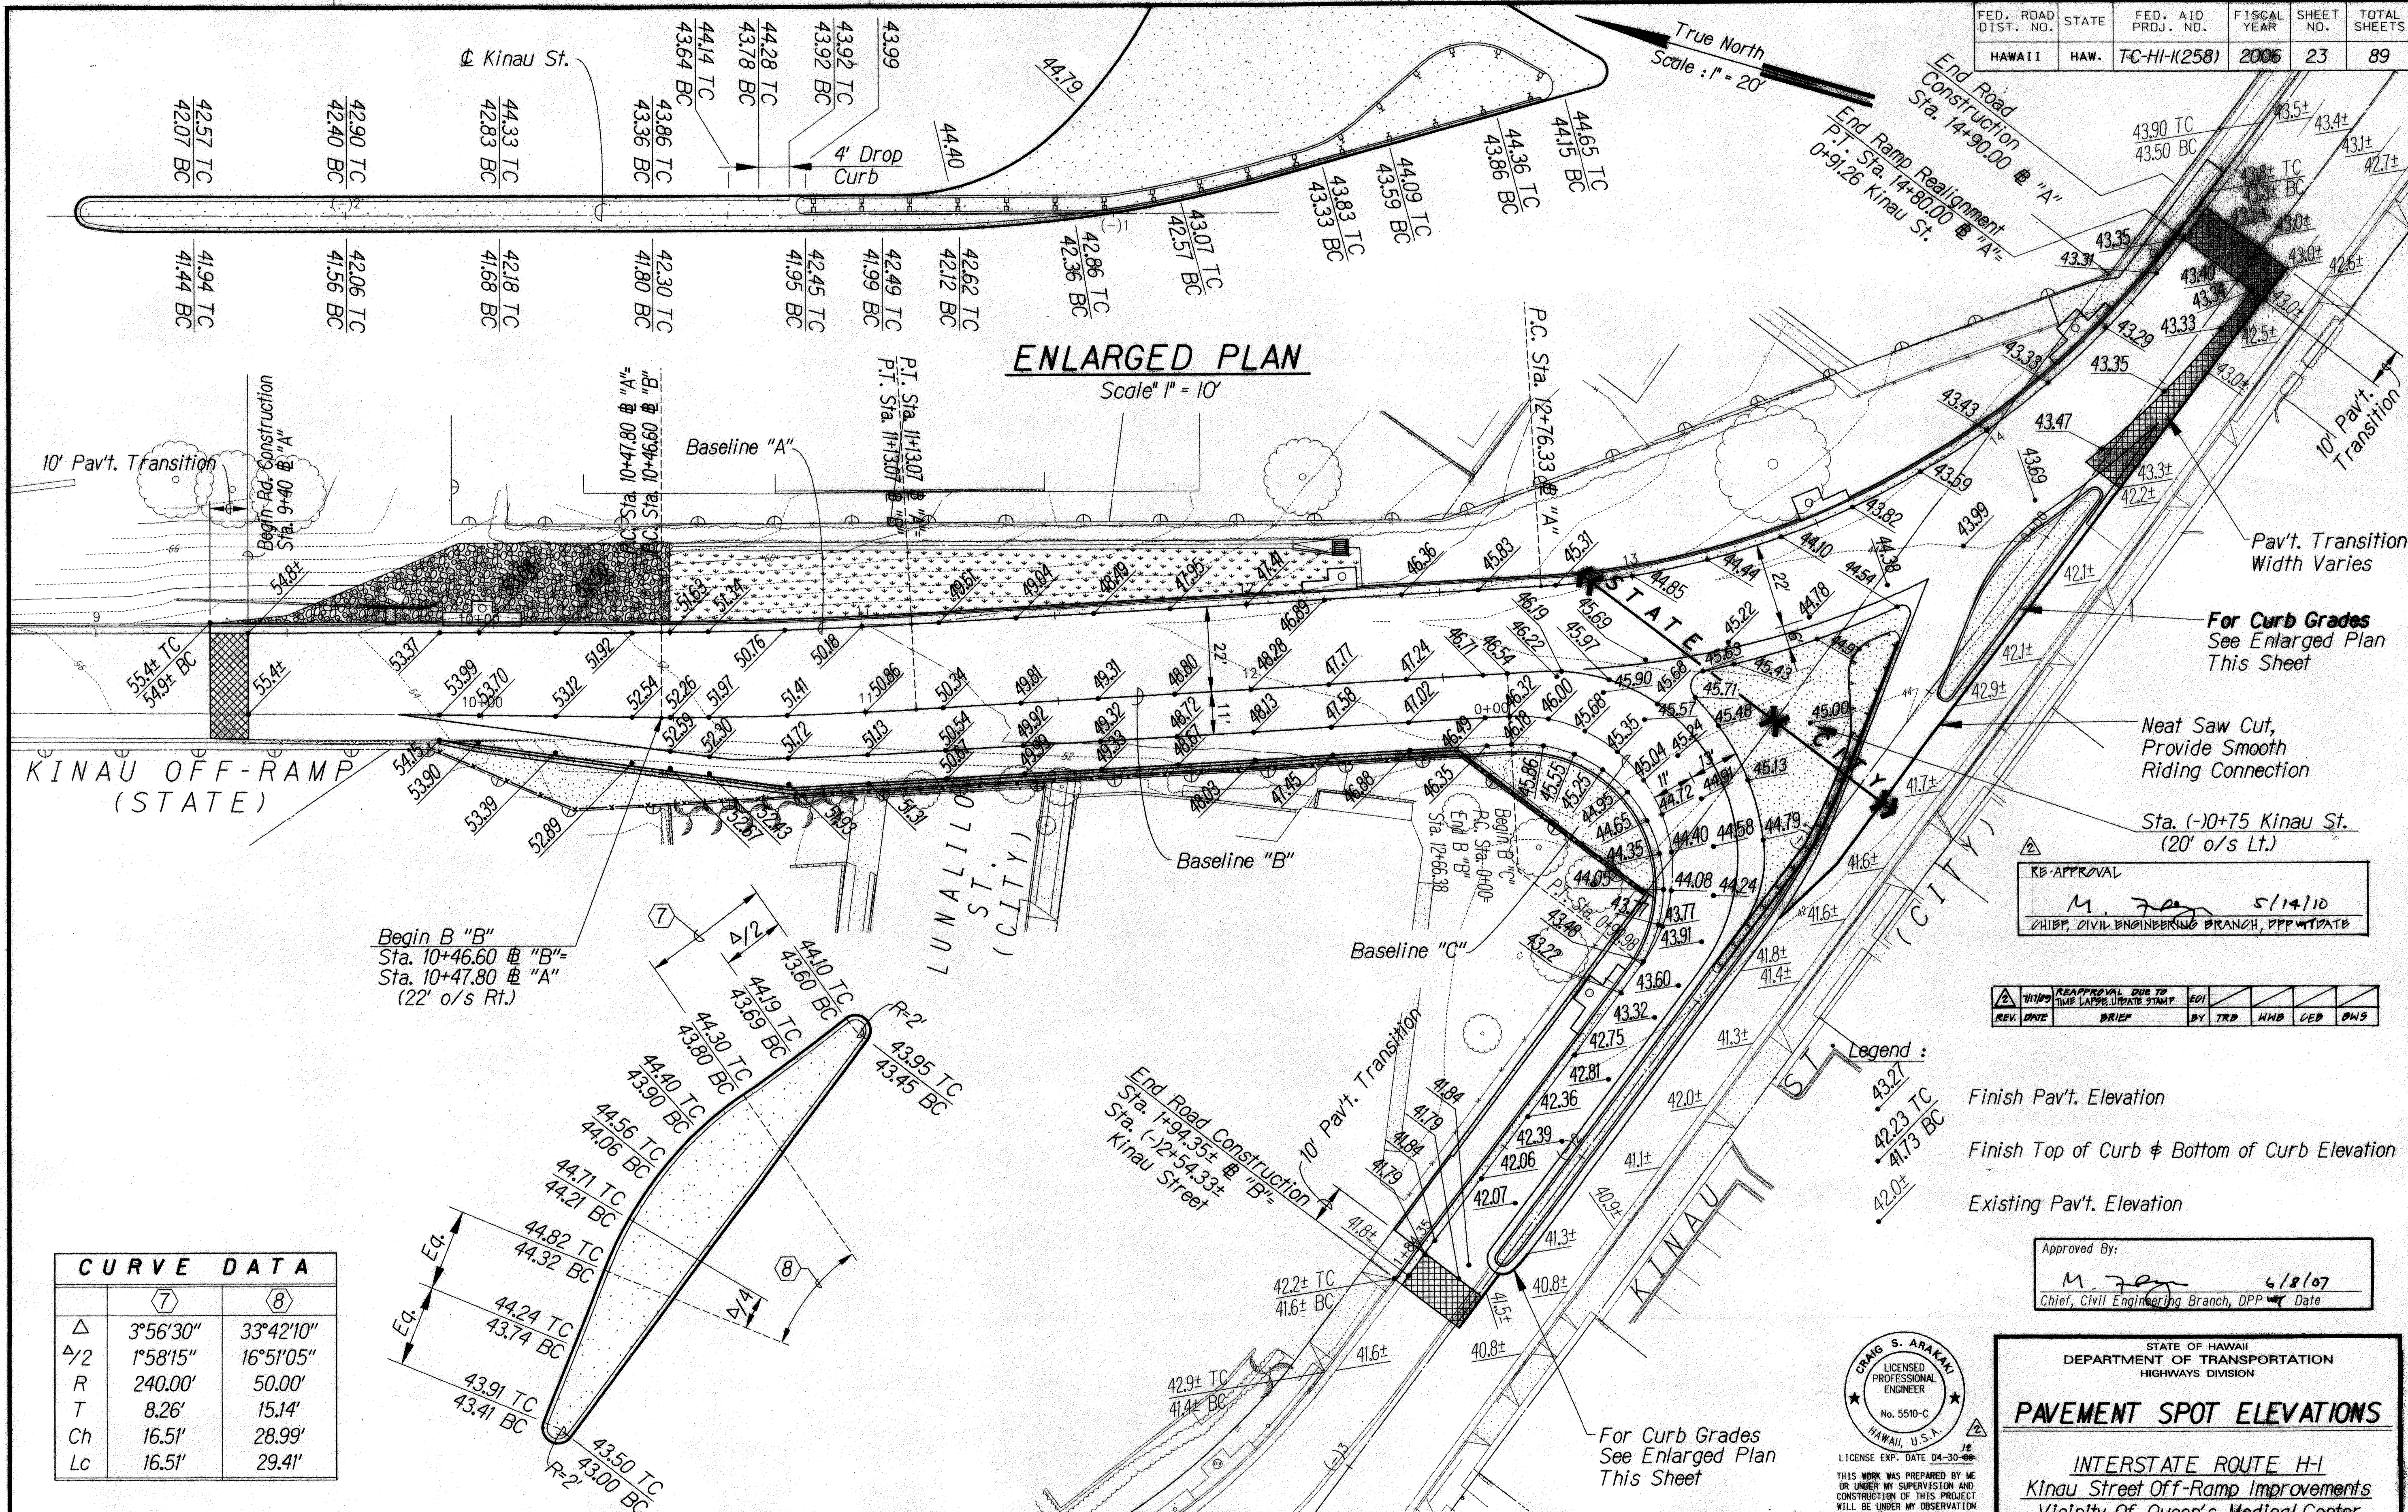

CURVE DATA		
	(7)	(8)
Δ	3°56'30"	33°42'10"
Δ/2	1°58'15"	16°51'05"
R	240.00'	50.00'
T	8.26'	15.14'
Ch	16.51'	28.99'
Lc	16.51'	29.41'

DATE	
DESIGNED BY	
TRACED BY	
QUANTITIES BY	
CHECKED BY	
ORIGINAL PLAN	
NOTE BOOK	

ENLARGED PLAN
Scale: 1" = 10'


PAVEMENT SPOT ELEVATIONS
Scale: 1" = 20'

RE-APPROVAL
M. 7/14/10
CHIEF, CIVIL ENGINEERING BRANCH, DPP W/DATE

REV.	DATE	BRIEF	BY	TRD	HMB	LED	DWS
------	------	-------	----	-----	-----	-----	-----

Legend:
 43.27 TC
 42.23 BC
 41.73 BC
 42.0±
 Finish Pav't. Elevation
 Finish Top of Curb & Bottom of Curb Elevation
 Existing Pav't. Elevation

Approved By:
Chief, Civil Engineering Branch, DPP W/DATE

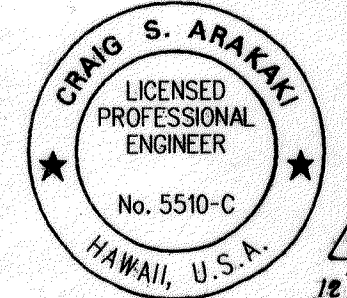

STATE OF HAWAII
DEPARTMENT OF TRANSPORTATION
HIGHWAYS DIVISION

PAVEMENT SPOT ELEVATIONS

INTERSTATE ROUTE H-1
Kinau Street Off-Ramp Improvements
Vicinity Of Queen's Medical Center
Federal-Aid Project No. TC-HI-K258

Scale: As Shown Date: Dec. 2006

SHEET No. 1 OF 1 SHEETS