FED. ROAD DIST. NO.	STATE	FED. AID PROJ. NO.	FISCAL YEAR	SHEET NO.	TOTAL SHEETS
HAWAII	HAW.	I-H1-1(136)17	1976	1	124

INDEX TO DRAWINGS

SHEET NO.	DESCRIPTION
1	TITLE
2-3	UTILITY NOTES & LEGEND
4-9	UTILITY PLANS
10	EXISTING LIGHTING AND DETOUR TRAFFIC SIGNALS
11-16	UTILITY PLAN DETAILS
17-18	UTILITY SECTION DETAILS
19-31	UTILITY PROFILES
32-36 (1)	MANHOLE WALL ELEV. HTCO
37-39	MANHOLE WALL ELEV. HECO
40-54	HTCO DETAILS
55-71 (2)	HECO DETAILS
72-73	GAS DETAILS
74-80 (3)	WATER DETAILS
81	FIRE ALARM DETAILS
82-93	BIKEWAY/WATERMAIN BRIDGE PLANS
94-107	BORING PLANS
108 (4)	GRADING PLAN
109-116 (5)	MISCELLANEOUS DETAIL PLANS
117-124 (6)	CROSS SECTIONS

(1) 33S-1, (2) 63S-1, (3) 80S-1, (4) C.O. 108S-1, (5) C.O. 110S-1, ADD. 116S-1 TO ADD. 116S-8, (6) C.O. 124S-1, C.O. 124S-2 ARE SUPPLEMENT SHEETS TO THE CONTRACT PLANS.
NEW TOTAL 139 SHEETS

STATE OF HAWAII

DEPARTMENT OF TRANSPORTATION
HIGHWAYS DIVISION

HONOLULU, HAWAII

"AS-BUILT"

PLANS FOR

CONSTRUCTION OF A PORTION OF

INTERSTATE ROUTE H-1

KEEHI INTERCHANGE

FEDERAL AID INTERSTATE PROJECT NO. I-H1-1 (136):17

DISTRICT OF HONOLULU
ISLAND OF OAHU

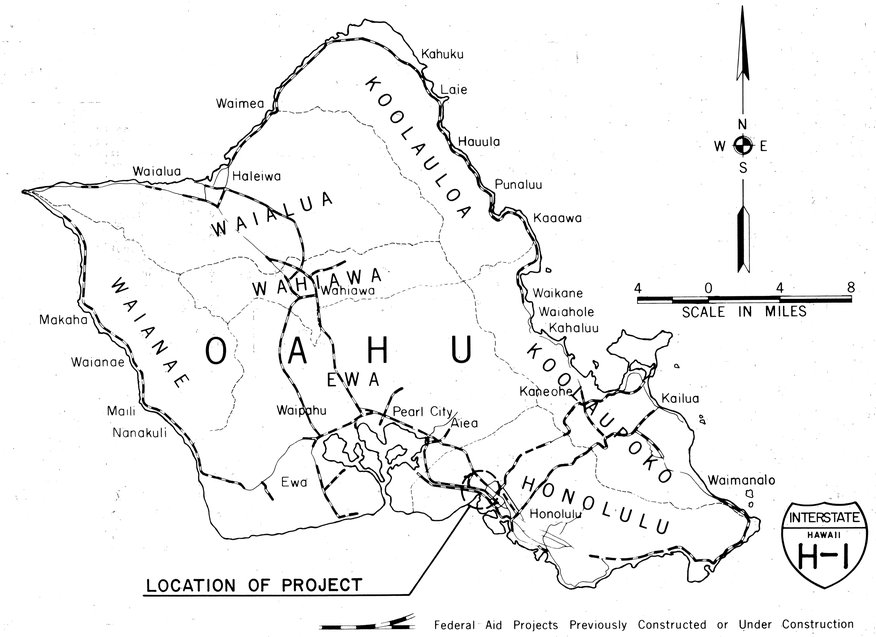

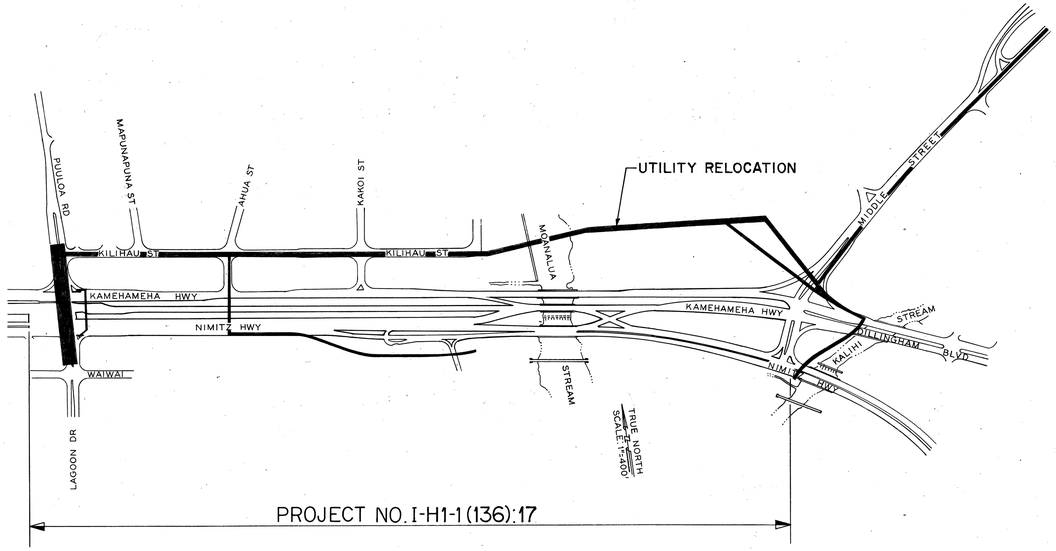

LAYOUT PLAN
SCALE 1"=400'

DESIGN CLASSIFICATION

DESIGN ADT (1994) 98,000
DHV 10,800
D 60/40
T 5%
V ..... 60 MPH

CHANGES MADE DURING CONSTRUCTION HAVE BEEN INCORPORATED ON THESE PLANS EXCEPT CHANGES IN THE ORIGINAL THEORETICAL QUANTITIES. FOR ACTUAL QUANTITIES, REFER TO PROJECT LEDGER AND/OR COMPUTATION BOOK.

Phil Alencastro — RESIDENT ENGINEER — 6/6/84 DATE

DATE	JULY 15, 1976
PHONE	521-3051
P S & E BY	GEORGE ASATO
DESIGNED BY	PARSONS BRINCKERHOFF-HIROTA ASSOC.

DEPARTMENT OF TRANSPORTATION
FEDERAL HIGHWAY ADMINISTRATION
APPROVED: 9-23-76
DIVISION ADMINISTRATOR — DATE

DEPARTMENT OF TRANSPORTATION
STATE OF HAWAII
APPROVED: R Higashionna 9/10/76
for DIR. OF TRANSPORTATION — DATE

DD-C-3-10