FED. ROAD DIST. NO.	STATE	FED. AID PROJ. NO.	FISCAL YEAR	SHEET NO.	TOTAL SHEETS
HAWAII	HAW.	I-HI-I(145):16	1976	1	136

INDEX TO DRAWINGS

SHEET NO.	DESCRIPTION
1	TITLE SHEET
2	CONSTRUCTION PHASING
3-4	HIGHWAY LIGHTING
5-7	UTILITY LOCATION LAYOUT
8-12	STANDARD PLANS
	RAMPS EA & IW
13-14	INDEX OF DRAWINGS & QUANTITIES
15	GENERAL NOTES
16-57	RAMP IW
58-132	RAMP EA
133-136	STANDARD DRAWINGS

STATE OF HAWAII

DEPARTMENT OF TRANSPORTATION
HIGHWAYS DIVISION

HONOLULU, HAWAII

"AS BUILT"

PLANS FOR

CONSTRUCTION OF A PORTION OF

INTERSTATE ROUTE H-1

AIRPORT INTERCHANGE

FEDERAL AID INTERSTATE PROJECT I-HI-I(145):16

DISTRICT OF HONOLULU
ISLAND OF OAHU

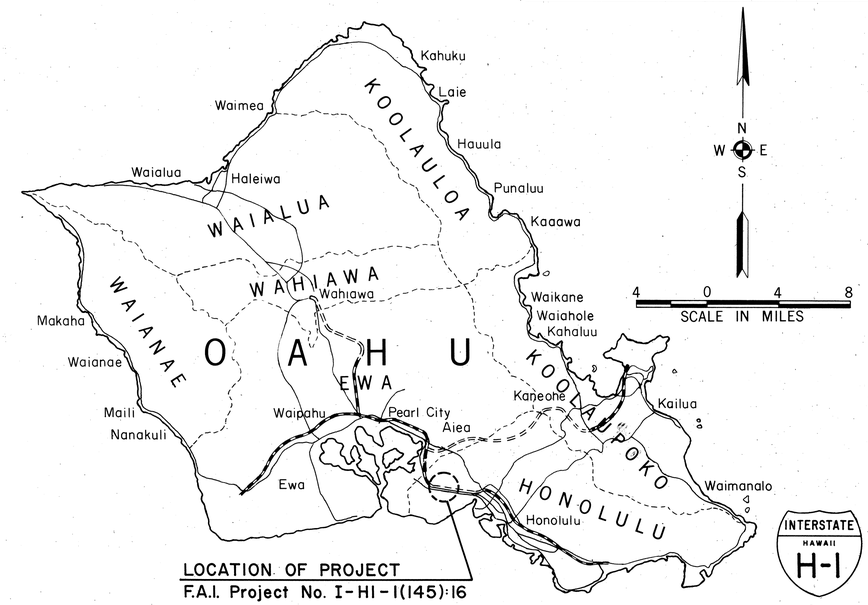

DESIGN CLASSIFICATION

DESIGN ADT (1994)	102,675
DHV	11%
D	60/40
T	5%
V	60 M.P.H.

SCALES:

PLANS	HOR.	1" = 50'
PROFILES	HOR.	1" = 50'
	VER.	1" = 10'
DETAIL ROADWAY PLANS	HOR.	1" = 20'
CROSS SECTIONS	HOR.	1" = 10'
	VER.	1" = 5'

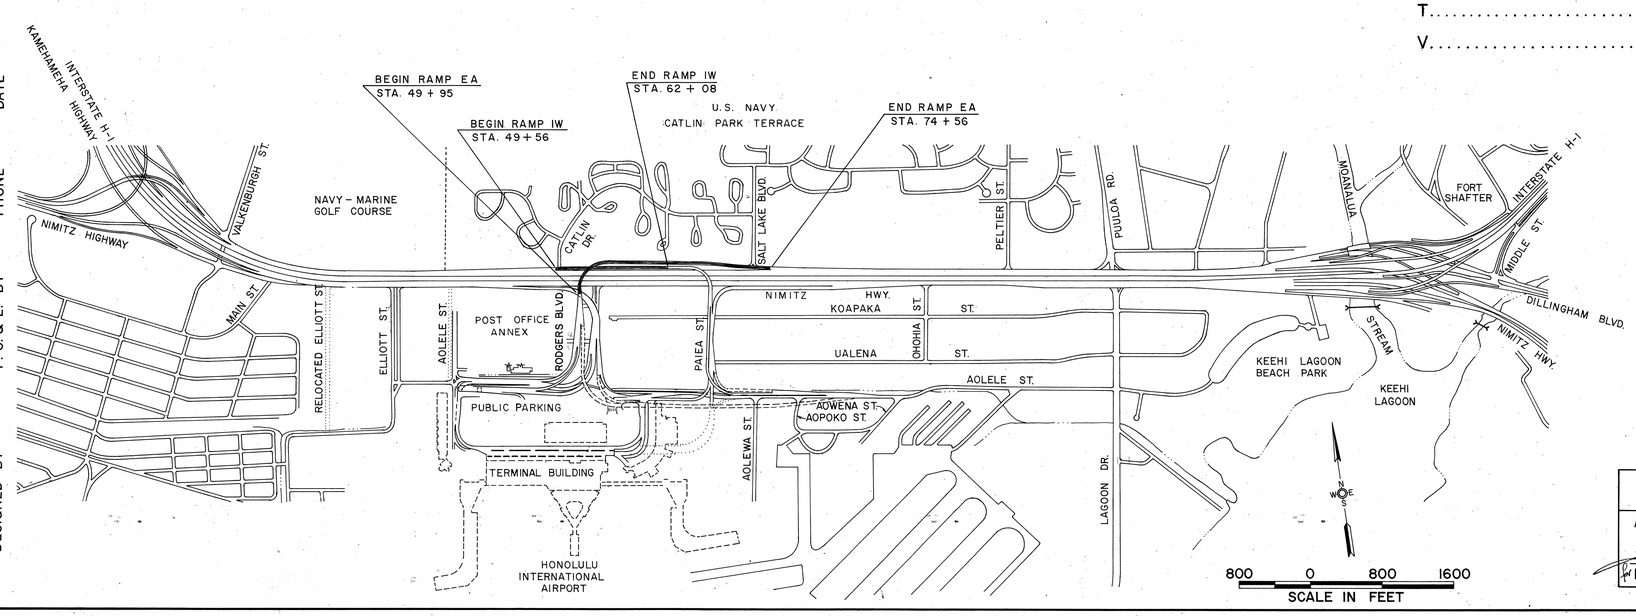

ALL CHANGES MADE DURING CONSTRUCTION HAVE BEEN INCORPORATED ON THESE PLANS EXCEPT CHANGES IN THE ORIGINAL THEORETICAL QUANTITIES.

D. Tamashiro — 9-29-79
PROJECT ENGINEER — DATE

DEPARTMENT OF TRANSPORTATION FEDERAL HIGHWAY ADMINISTRATION	
APPROVED: H. Iwasuma	9-22-76
DIVISION ENGINEER	DATE

DEPARTMENT OF TRANSPORTATION STATE OF HAWAII	
APPROVED: R. Higashionna	9-3-76
for DIR. OF TRANSPORTATION	DATE

URS COMPANY HAWAII	
DESIGNED BY	
STAN UEHARA	8-1-76
P. S. & E. BY	DATE
521-3051	
PHONE	