FED. ROAD DIST. NO.	STATE	FED. AID PROJ. NO.	FISCAL YEAR	SHEET NO.	TOTAL SHEETS
HAWAII	HAW.	NH-H1-1(275)	2021	ADD. 40	65

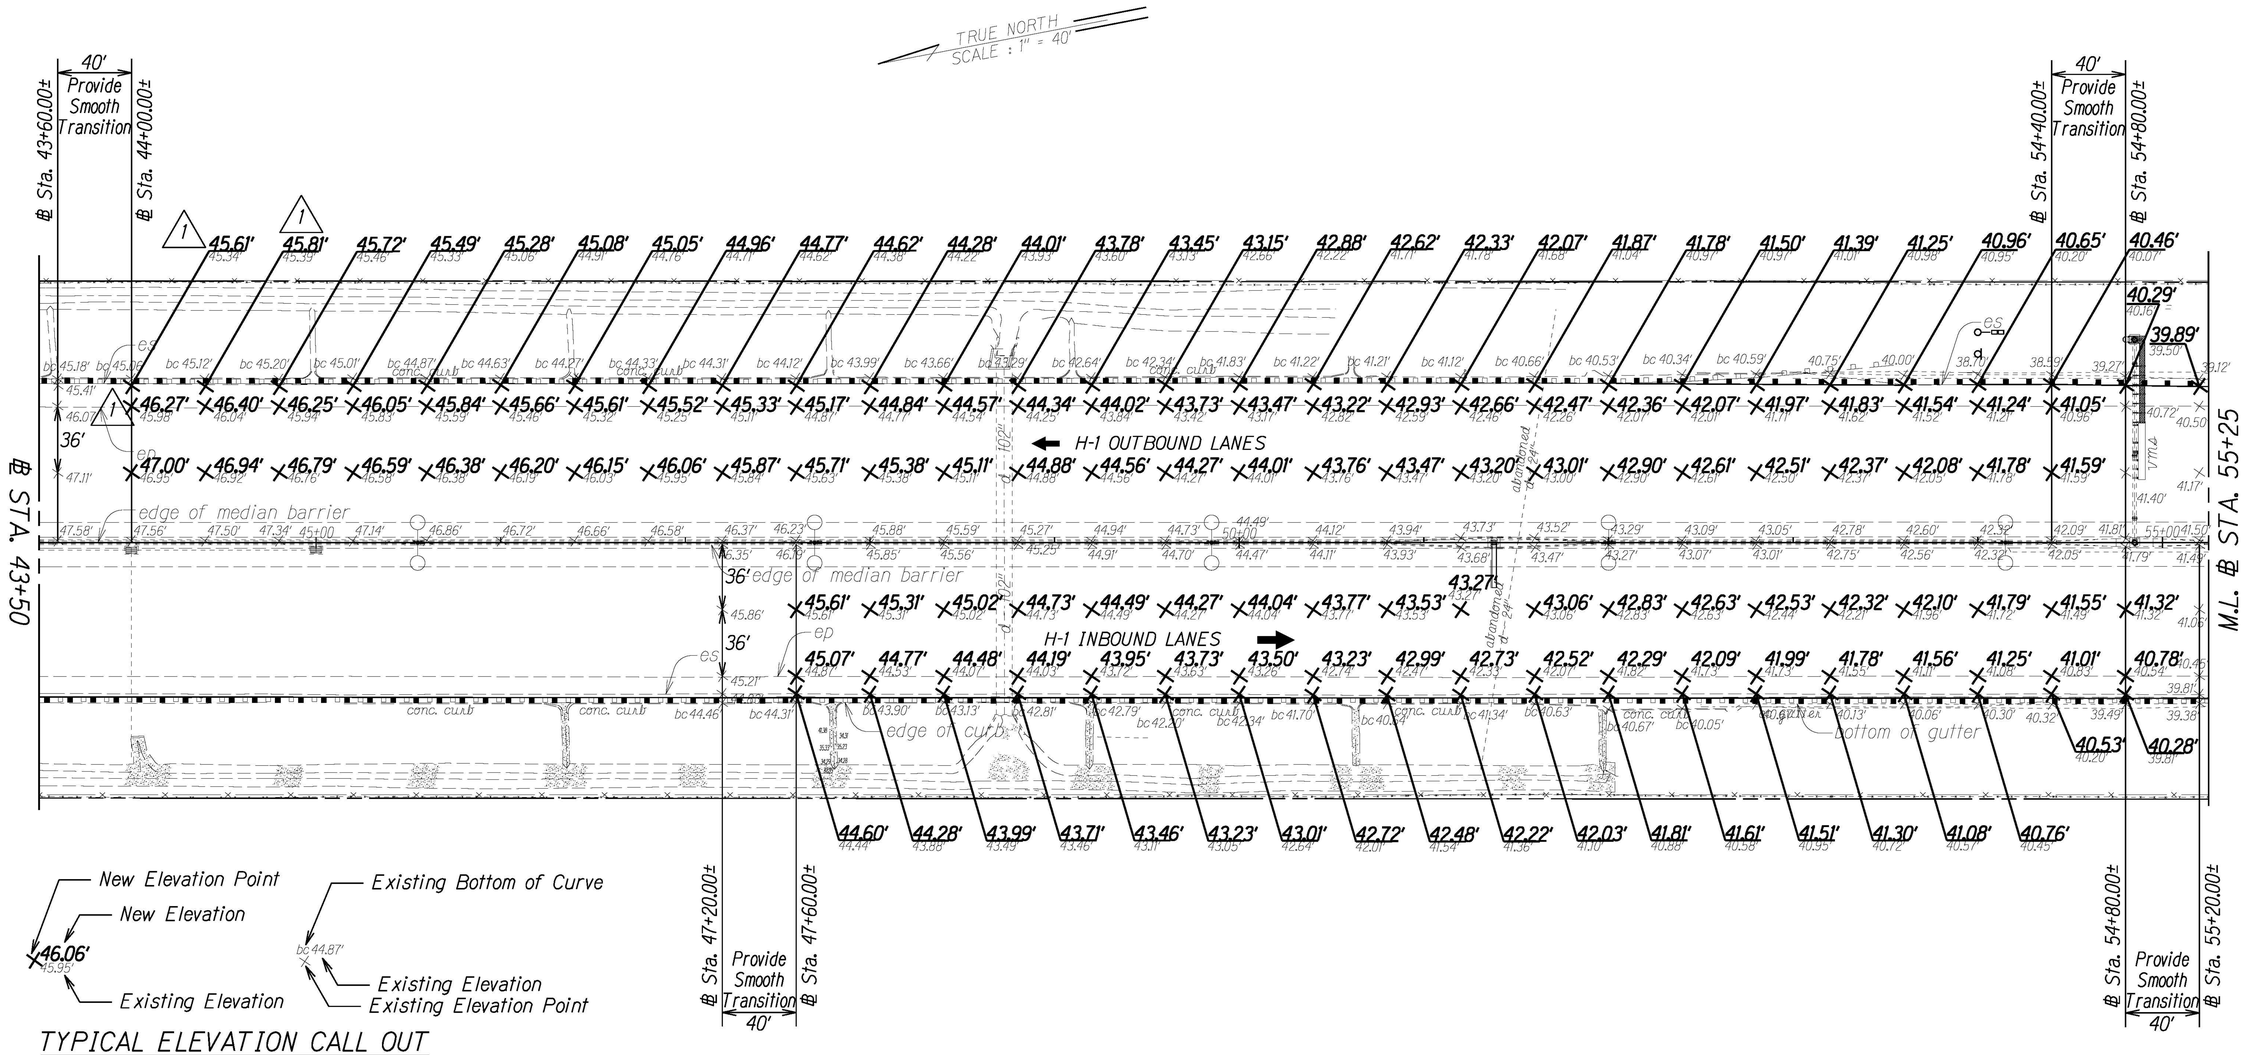

TYPICAL ELEVATION CALL OUT

Notes:

1. See General Note #30.
2. Contractor to provide all necessary equipment and services (including surveyor) needed to construct pavement to shown finish grades. All costs shall be incidental to the contract work.
3. Spot elevations shown are spaced at 40' o.c.

DATE	REVISION
11/10/21	Added Note 3. Revised Various New Grade Elevation Points. Added smooth transition callout at ℄ Sta. 54+40 (Outbound).

STATE OF HAWAII
DEPARTMENT OF TRANSPORTATION
HIGHWAYS DIVISION

PAVEMENT GRADE PLANS

INTERSTATE ROUTE H-1 REHABILITATION
SALT LAKE BOULEVARD TO AIRPORT VIADUCT
FEDERAL-AID PROJECT NO. NH-H1-1(275)

Scale: 1" = 40' Date: October, 2021

SHEET No. 1 OF 2 SHEETS

ORIGINAL PLANS — SURVEY PLOTTED BY / DRAWN BY / TRACED BY / DESIGNED BY / QUANTITIES BY / CHECKED BY / DATE
NOTE BOOK No.

FED. ROAD DIST. NO.	STATE	FED. AID PROJ. NO.	FISCAL YEAR	SHEET NO.	TOTAL SHEETS
HAWAII	HAW.	NH-H1-1(275)	2021	ADD. 41	65

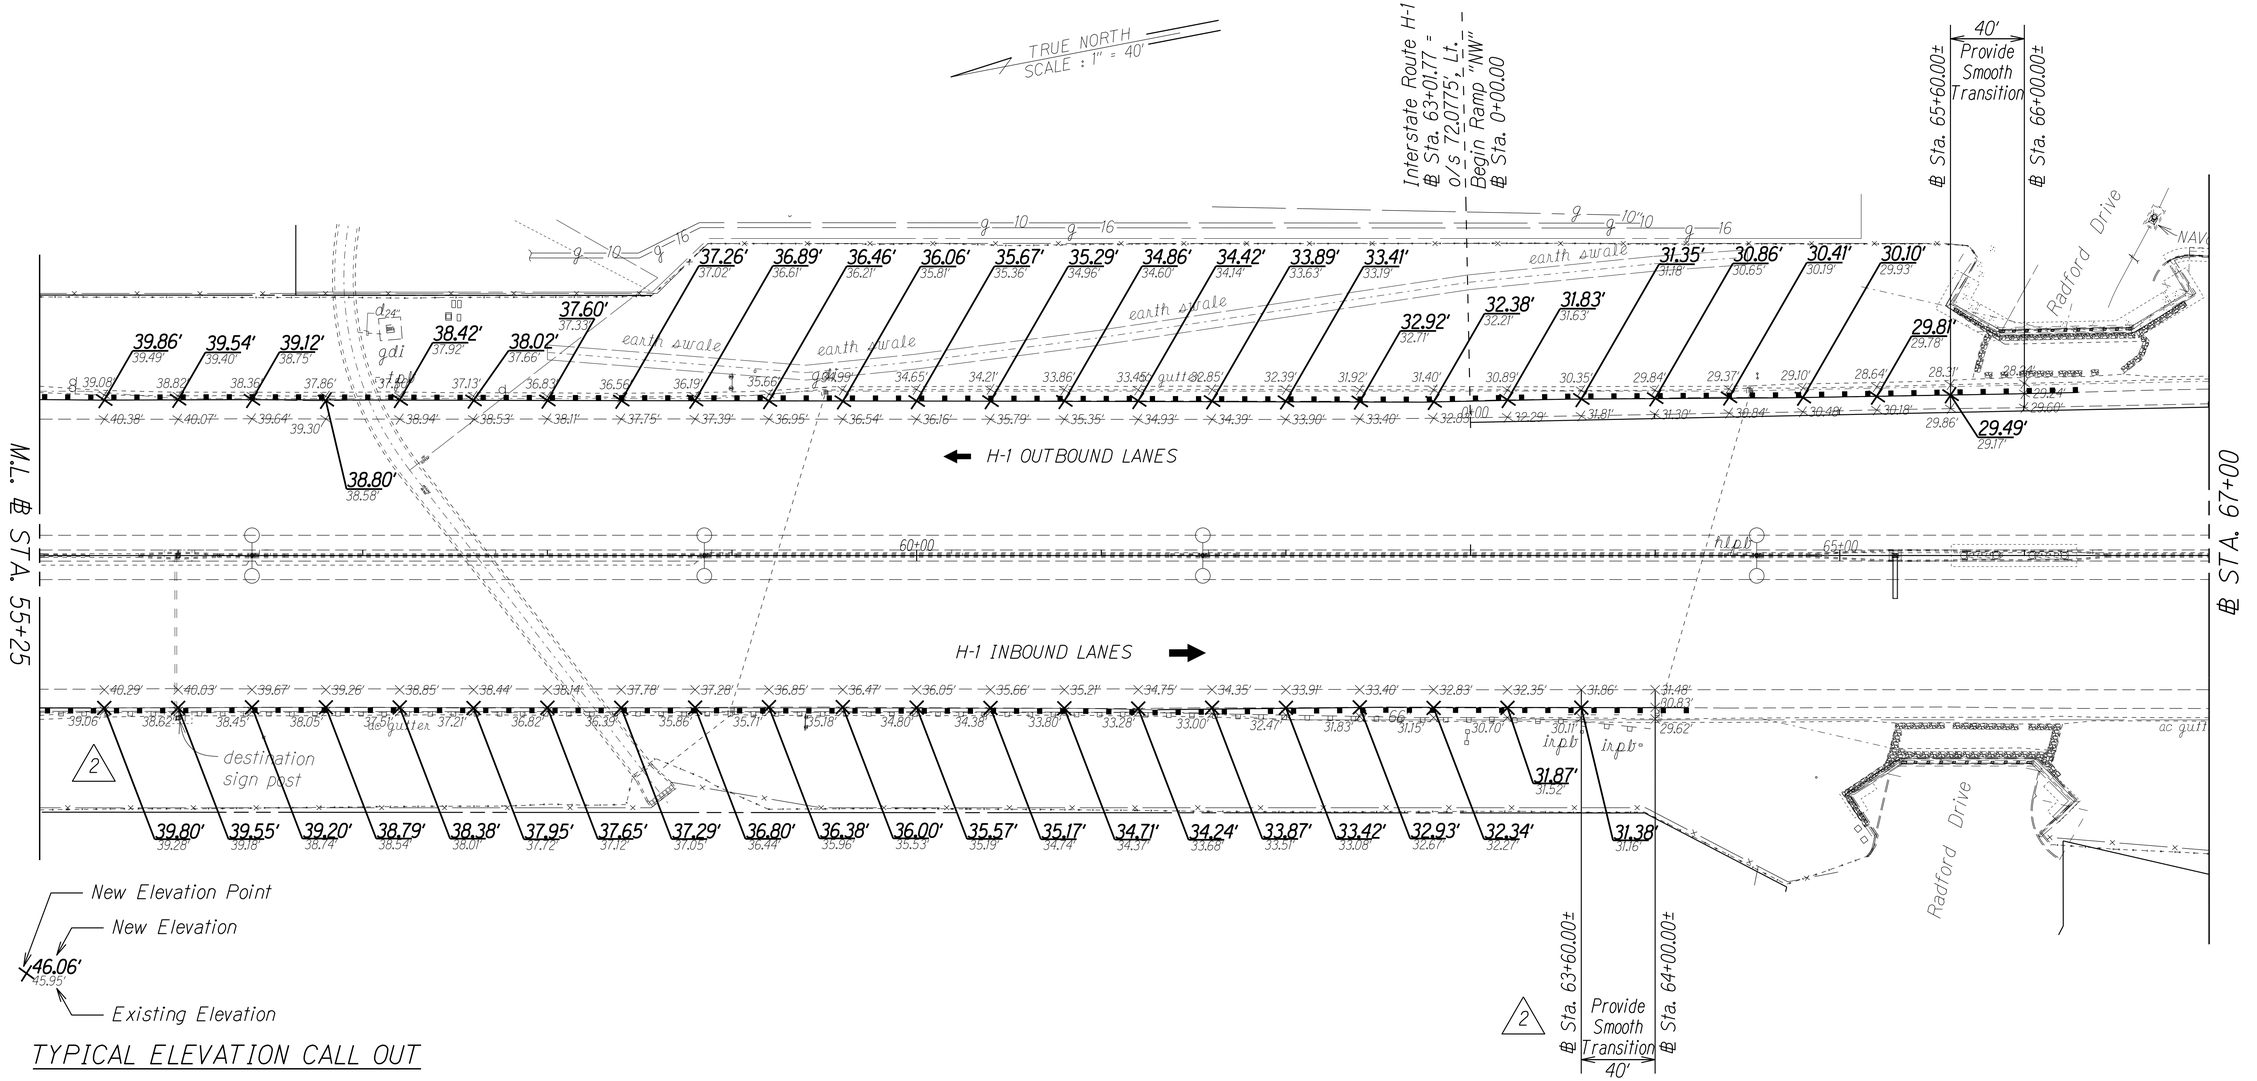

New Elevation Point

New Elevation

46.06'
45.95'

Existing Elevation

TYPICAL ELEVATION CALL OUT

Notes:

1. See General Note #30.
2. Contractor to provide all necessary equipment and services (including surveyor) needed to construct pavement to shown finish grades. All costs shall be incidental to the contract work.
3. Spot elevations shown are spaced at 40' o.c.

DATE	REVISION
11/30/21	Added additional grading points along inbound right shoulder.
11/10/21	Added Note 3.

STATE OF HAWAII
DEPARTMENT OF TRANSPORTATION
HIGHWAYS DIVISION

PAVEMENT GRADE PLANS

INTERSTATE ROUTE H-1 REHABILITATION
SALT LAKE BOULEVARD TO AIRPORT VIADUCT
FEDERAL-AID PROJECT NO. NH-HI-1(275)

Scale: 1" = 40' Date: October, 2021

SHEET No. 2 OF 2 SHEETS

ORIGINAL PLAN | SURVEY PLOTTED BY | DRAWN BY | TRACED BY | DESIGNED BY | QUANTITIES BY | CHECKED BY | DATE | NOTE BOOK | N.