


FED. ROAD DIST. NO.	STATE	FED. AID PROJ. NO.	FISCAL YEAR	SHEET NO.	TOTAL SHEETS
HAWAII	HAW.	I-H-1(99)15	1977	334	350

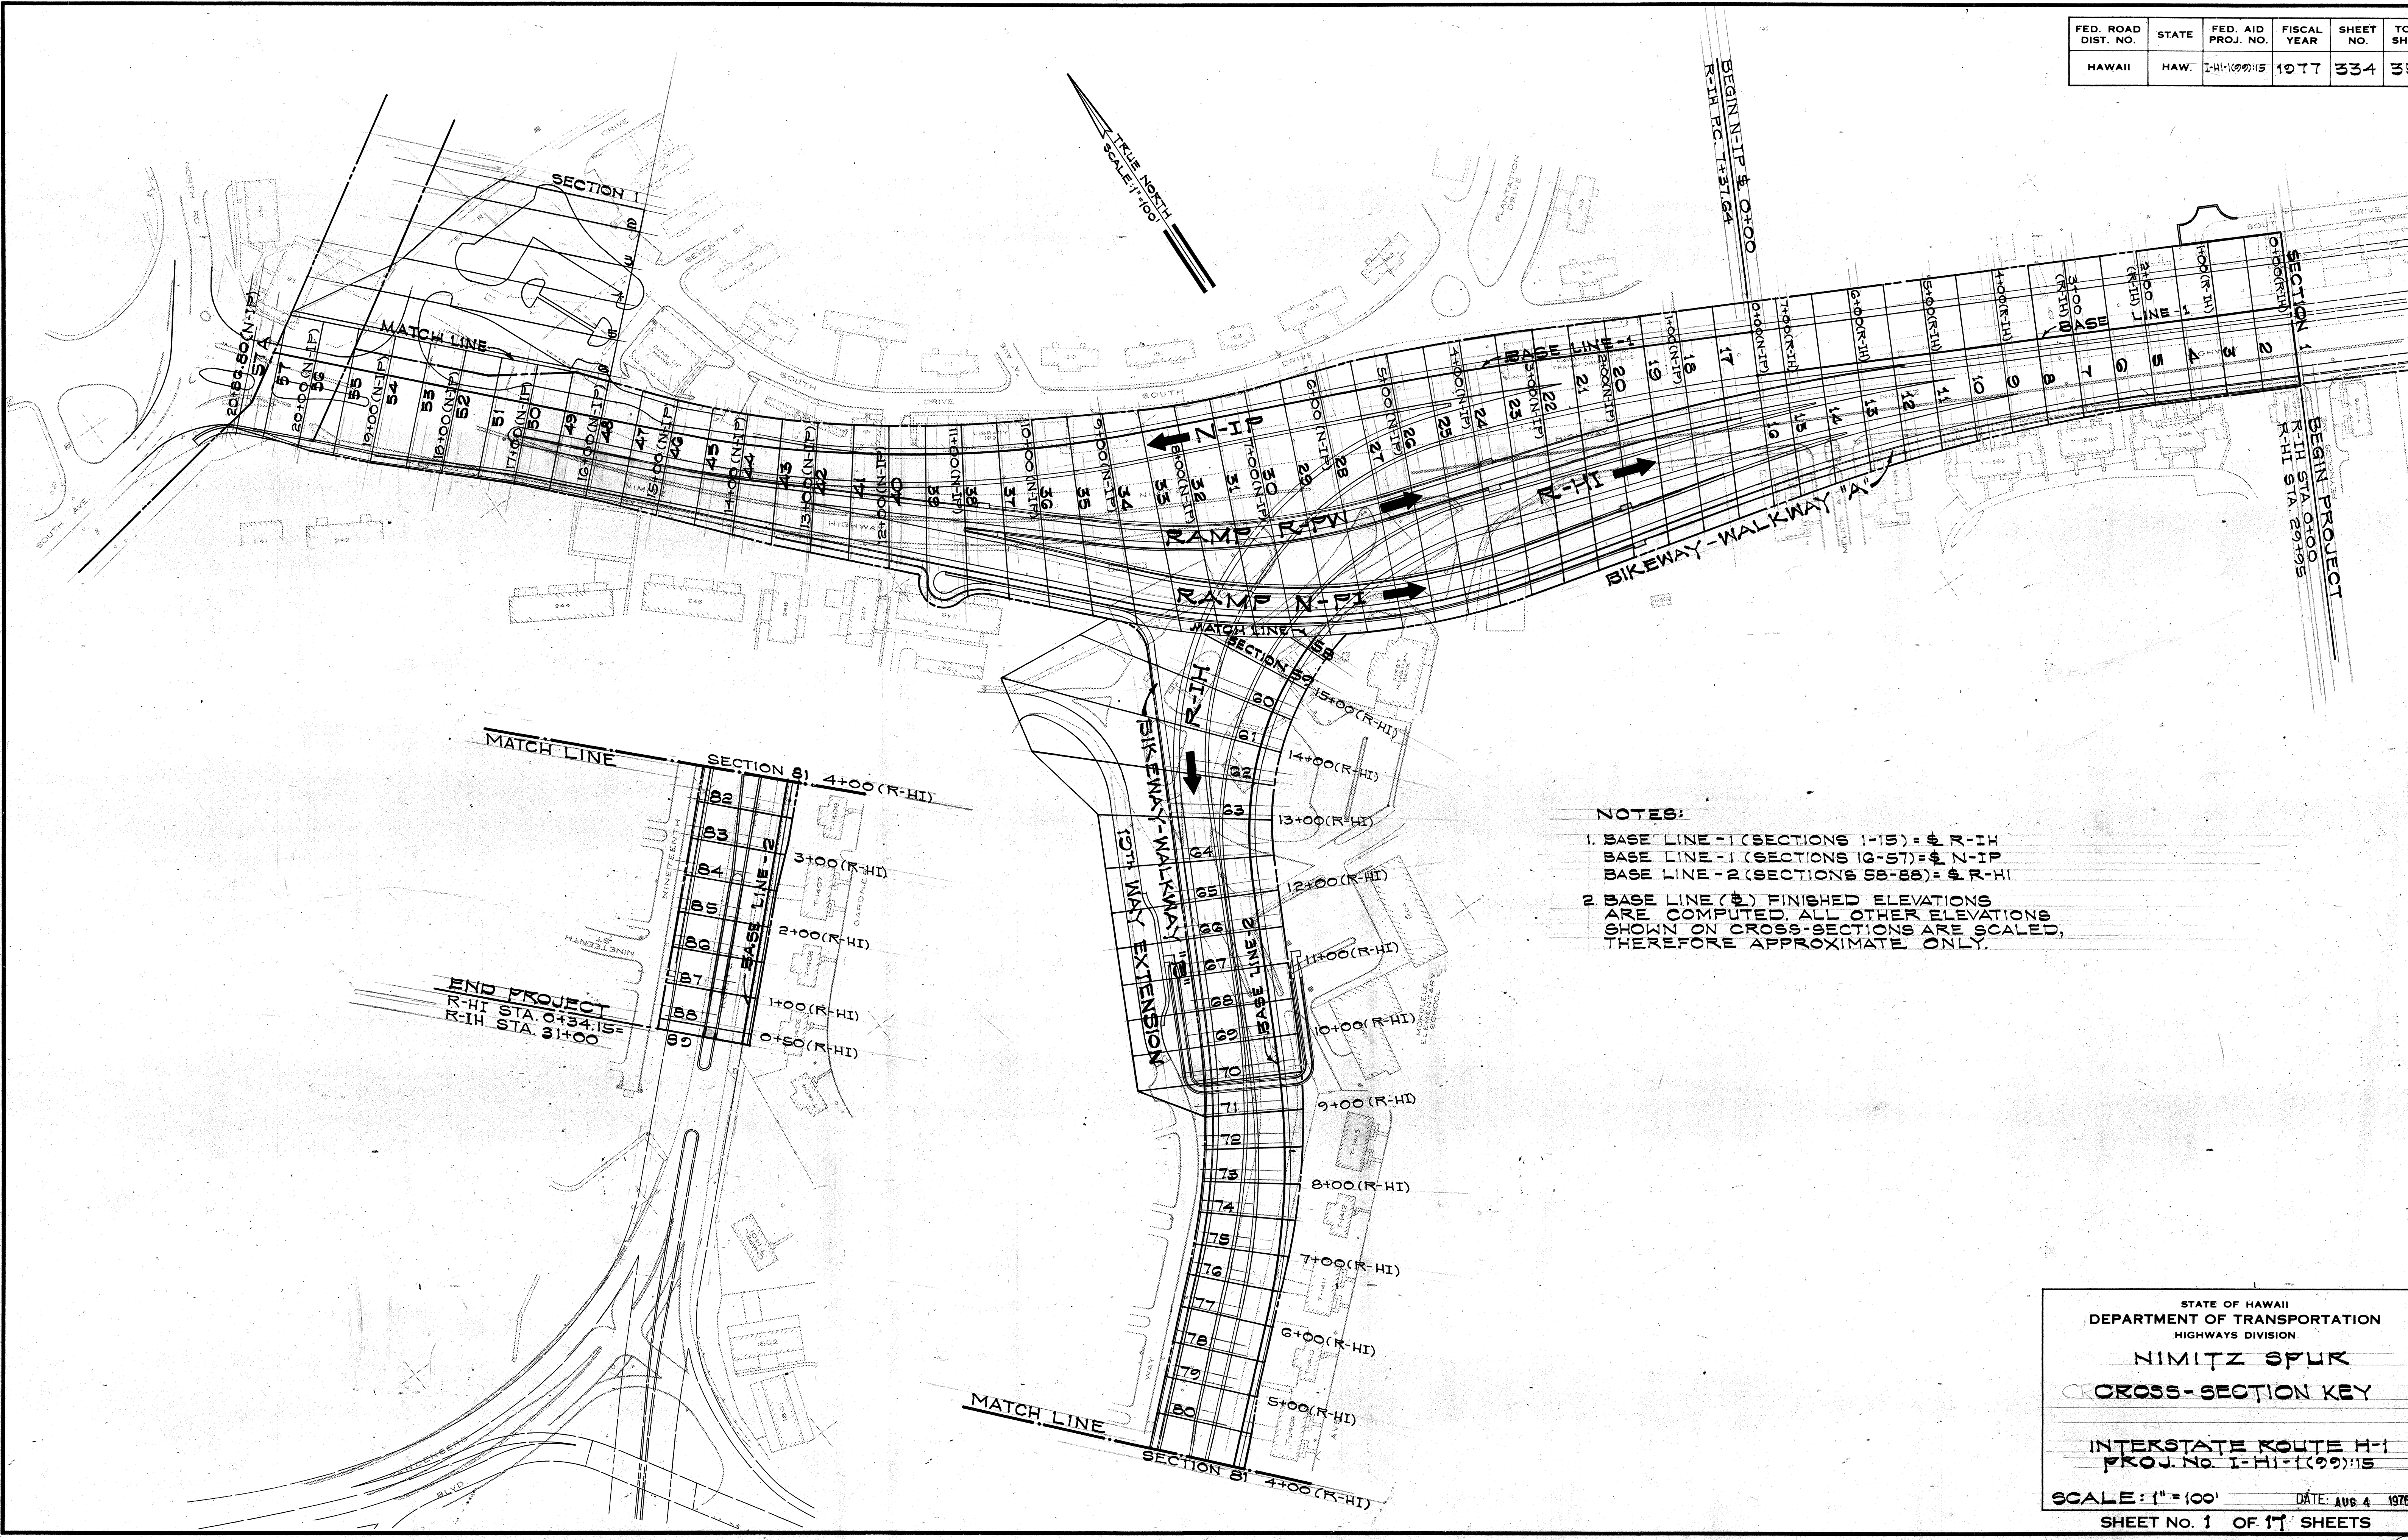

- NOTES:
 2. BASE LINE (\$) FINISHED ELEVATIONS ARE COMPUTED. ALL OTHER ELEVATIONS, SHOWN ON CROSS-SECTIONS ARE SCALED, THEREFORE APPROXIMATE ONLY.

SURVEY PLOTTED BY	DATE
DRAWN BY	
TRACED BY	
NOTES BY	
CHECKED BY	
NO.	

STATE OF HAWAII
DEPARTMENT OF TRANSPORTATION
HIGHWAYS DIVISION

NIMITZ SPUR

CROSS-SECTION KEY


INTERSTATE ROUTE H-1
PROJ. NO. I-H-1(99)15

SCALE: 1"=100' DATE: AUG 4 1976


FED. ROAD DIST. NO.	STATE	FED. AID PROJ. NO.	FISCAL YEAR	SHEET NO.	TOTAL SHEETS
HAWAII	HAW.	1-H-1(00):15	1977	335	350


ORIGINAL SURVEY	SURVEYED	BY	DATE
NOTE BOOK	PLOTTED		
	TEMPLATE		
	AREAS		
	AREAS CHECKED		

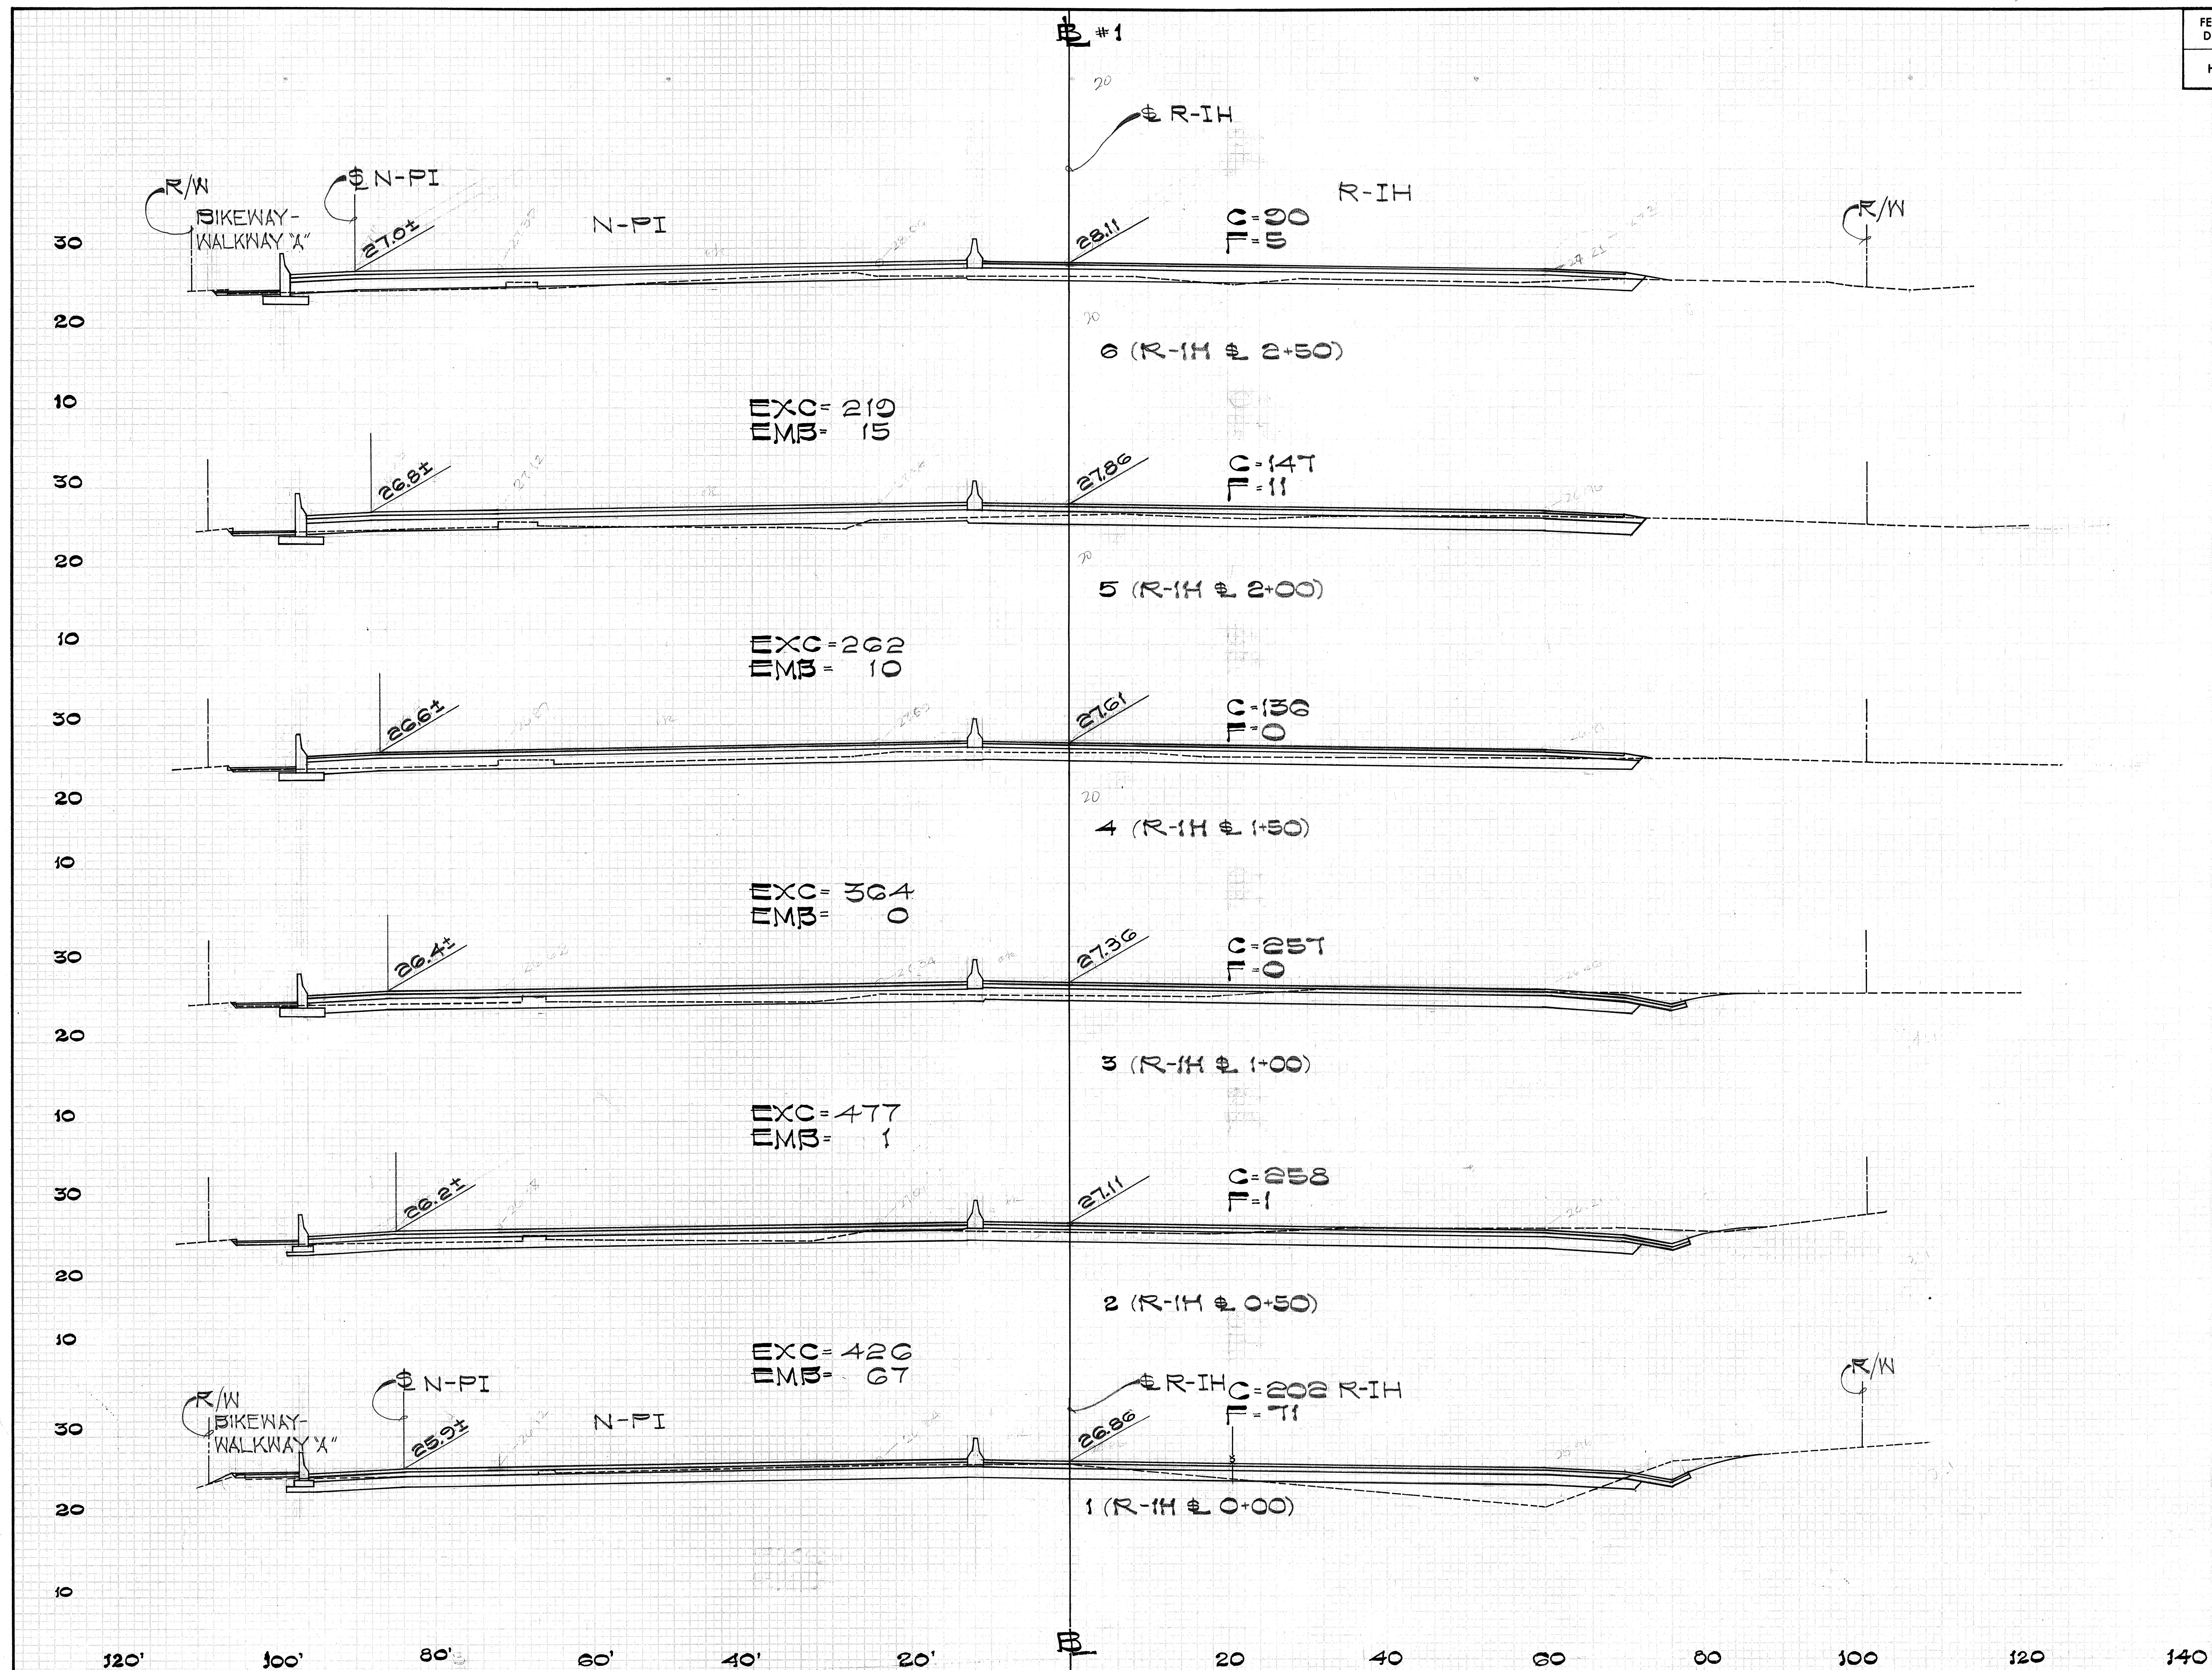


SHT. 2
OF 17 SHTS.


335

FED. ROAD DIST. NO.	STATE	FED. AID PROJ. NO.	FISCAL YEAR	SHEET NO.	TOTAL SHEETS
HAWAII	HAW.	1-41-1(99)-15	1977	336	350

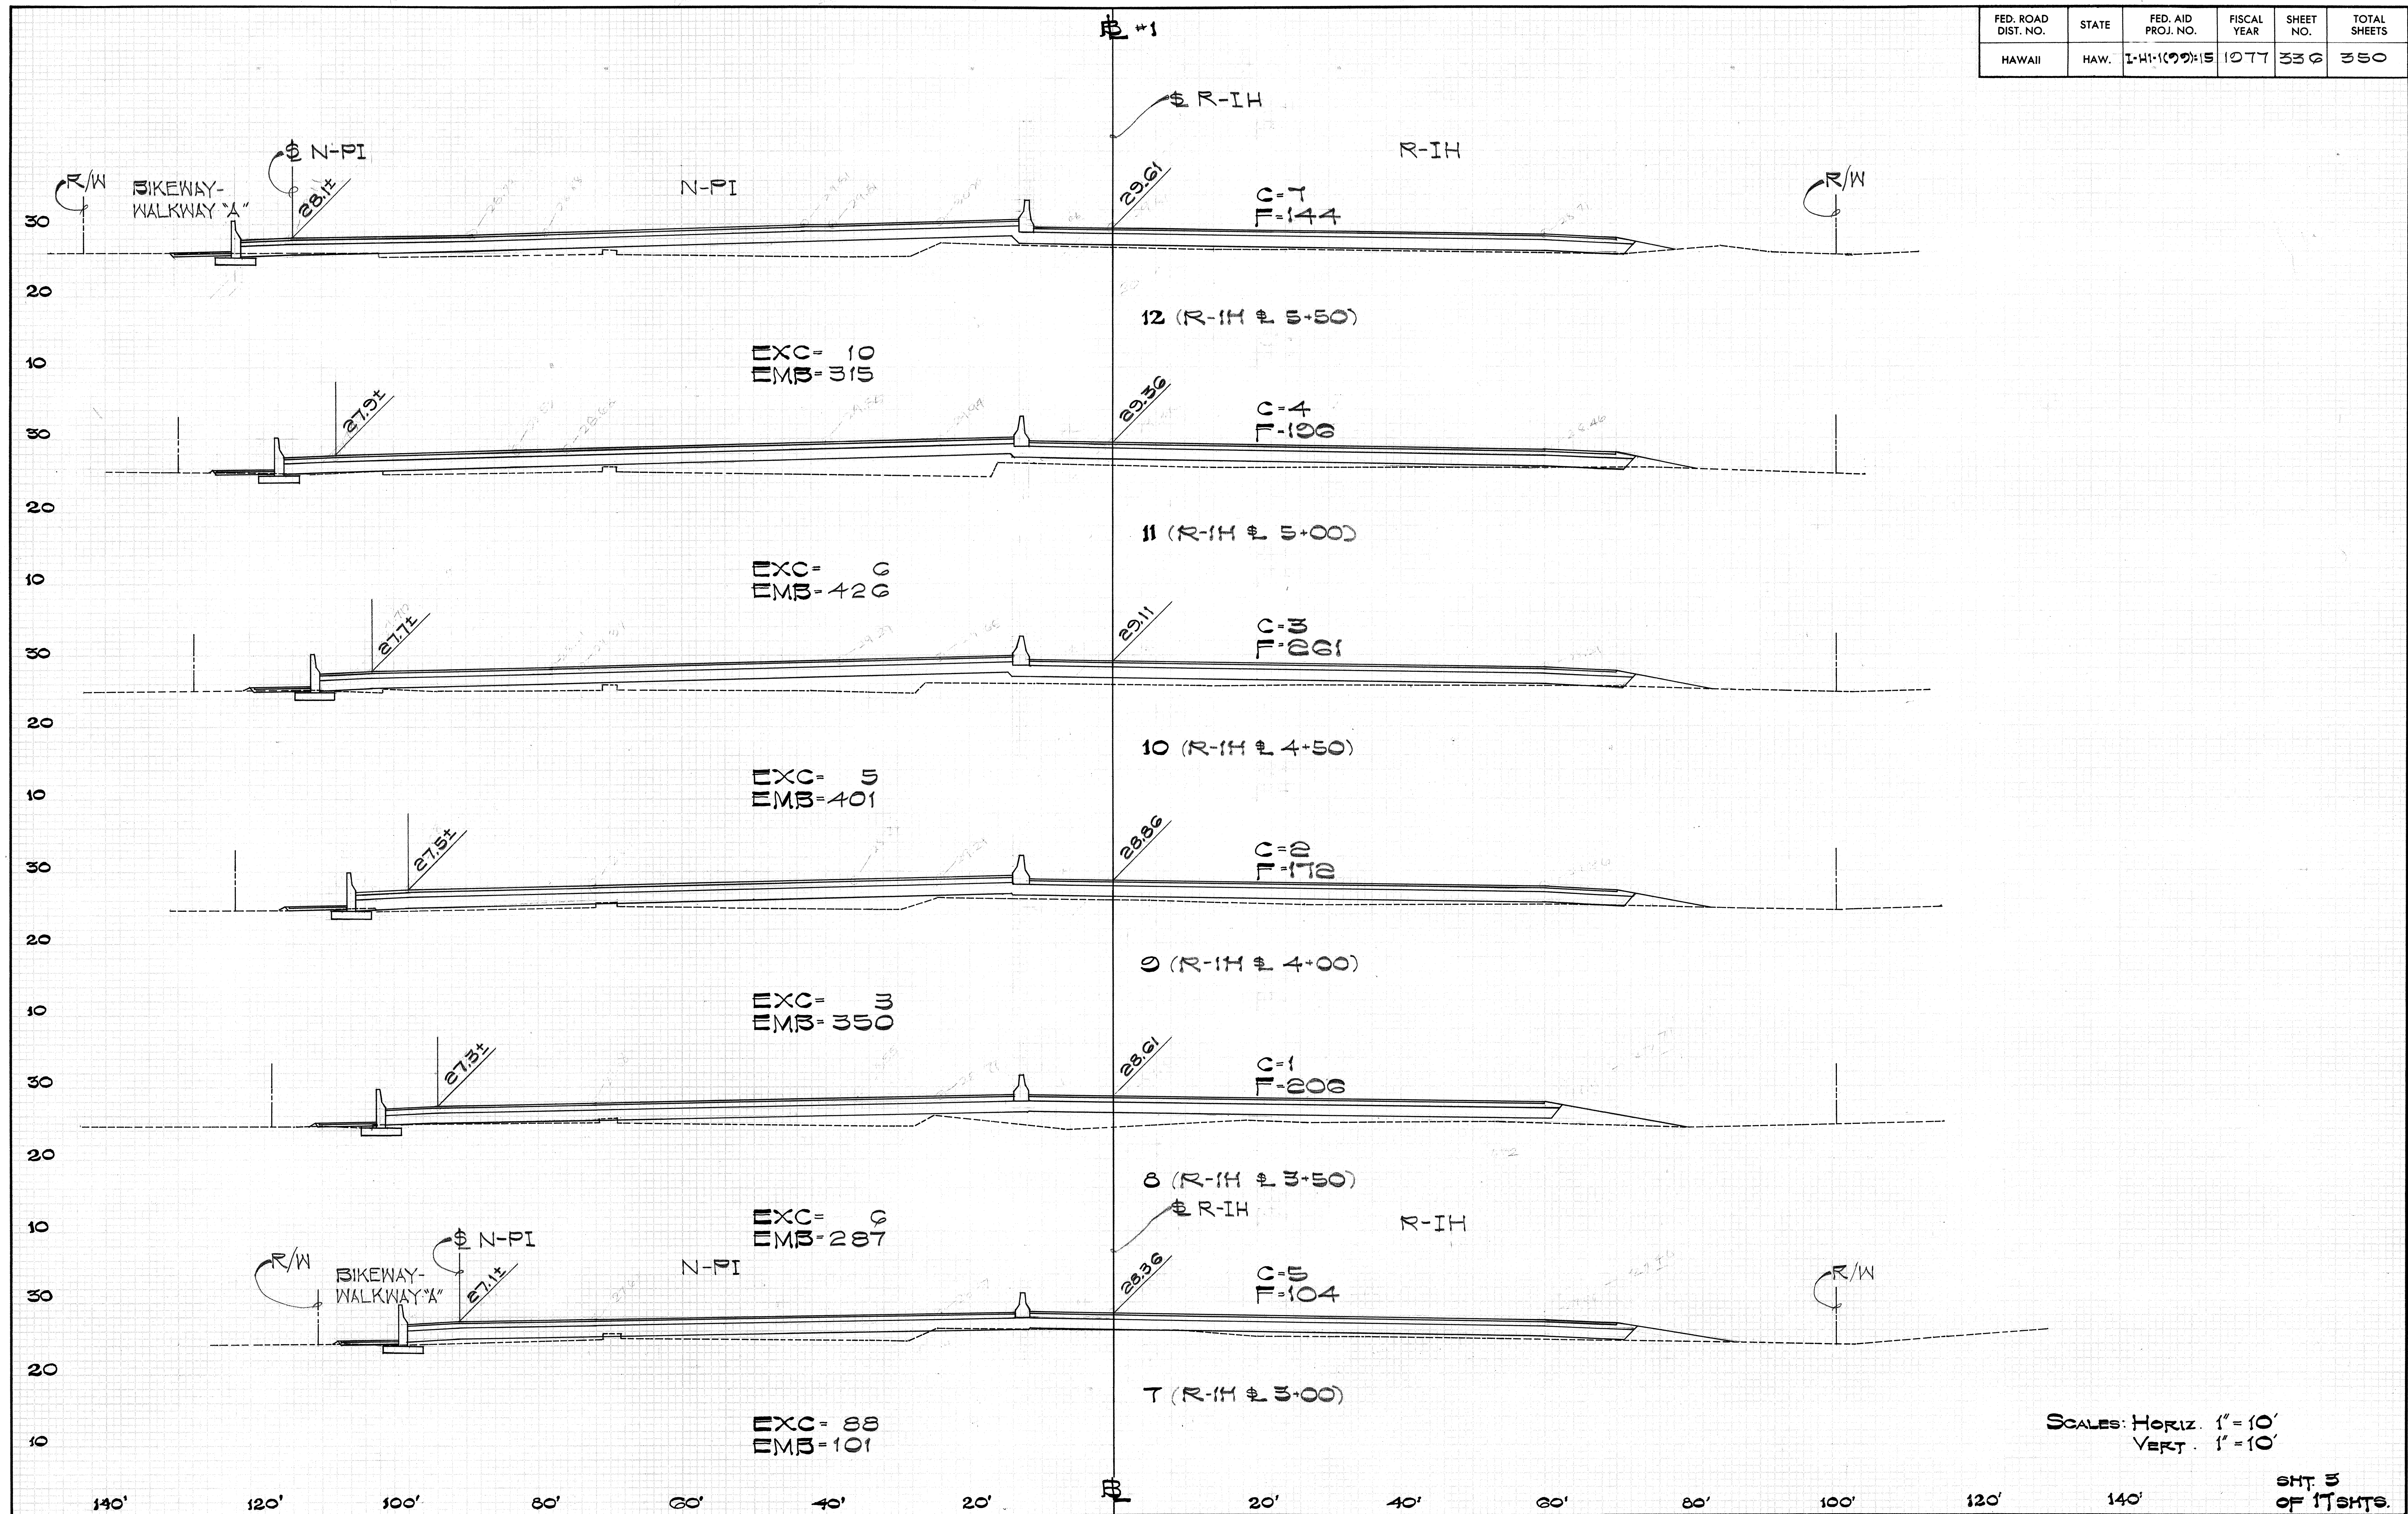


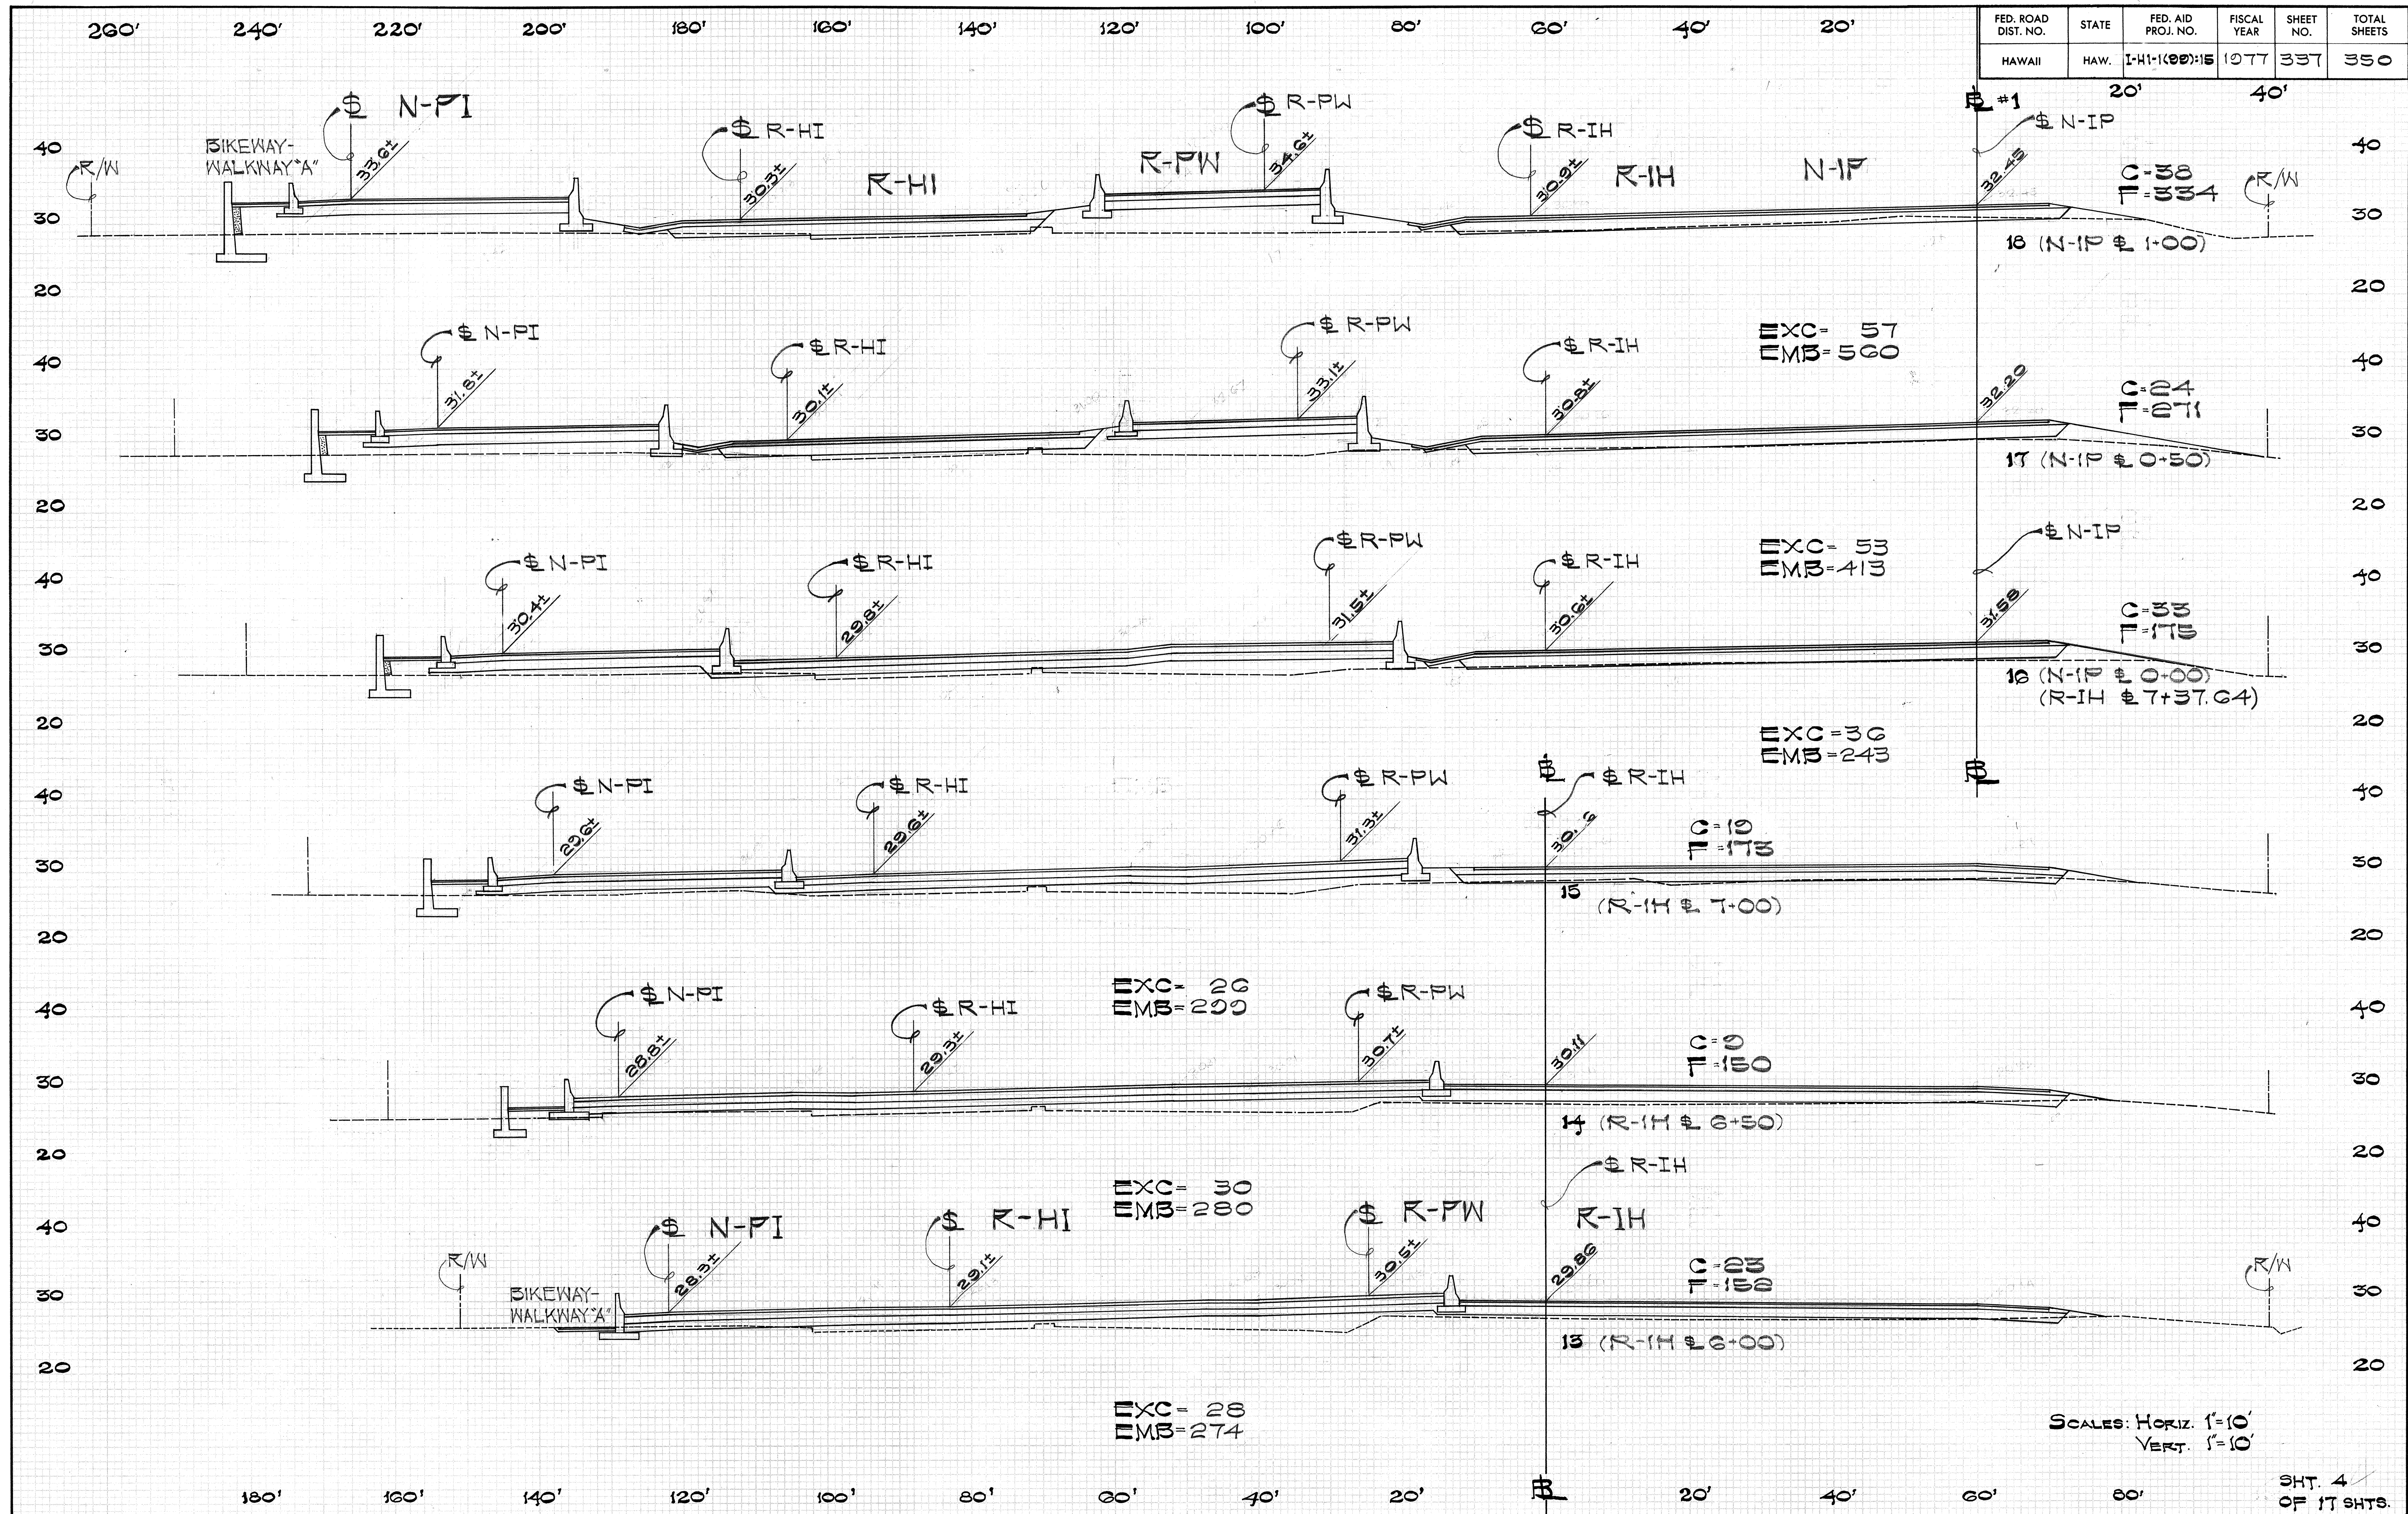

FED. ROAD DIST. NO.	STATE	FED. AID PROJ. NO.	FISCAL YEAR	SHEET NO.	TOTAL SHEETS
HAWAII	HAW.	I-41-(00):15	1977	338	350

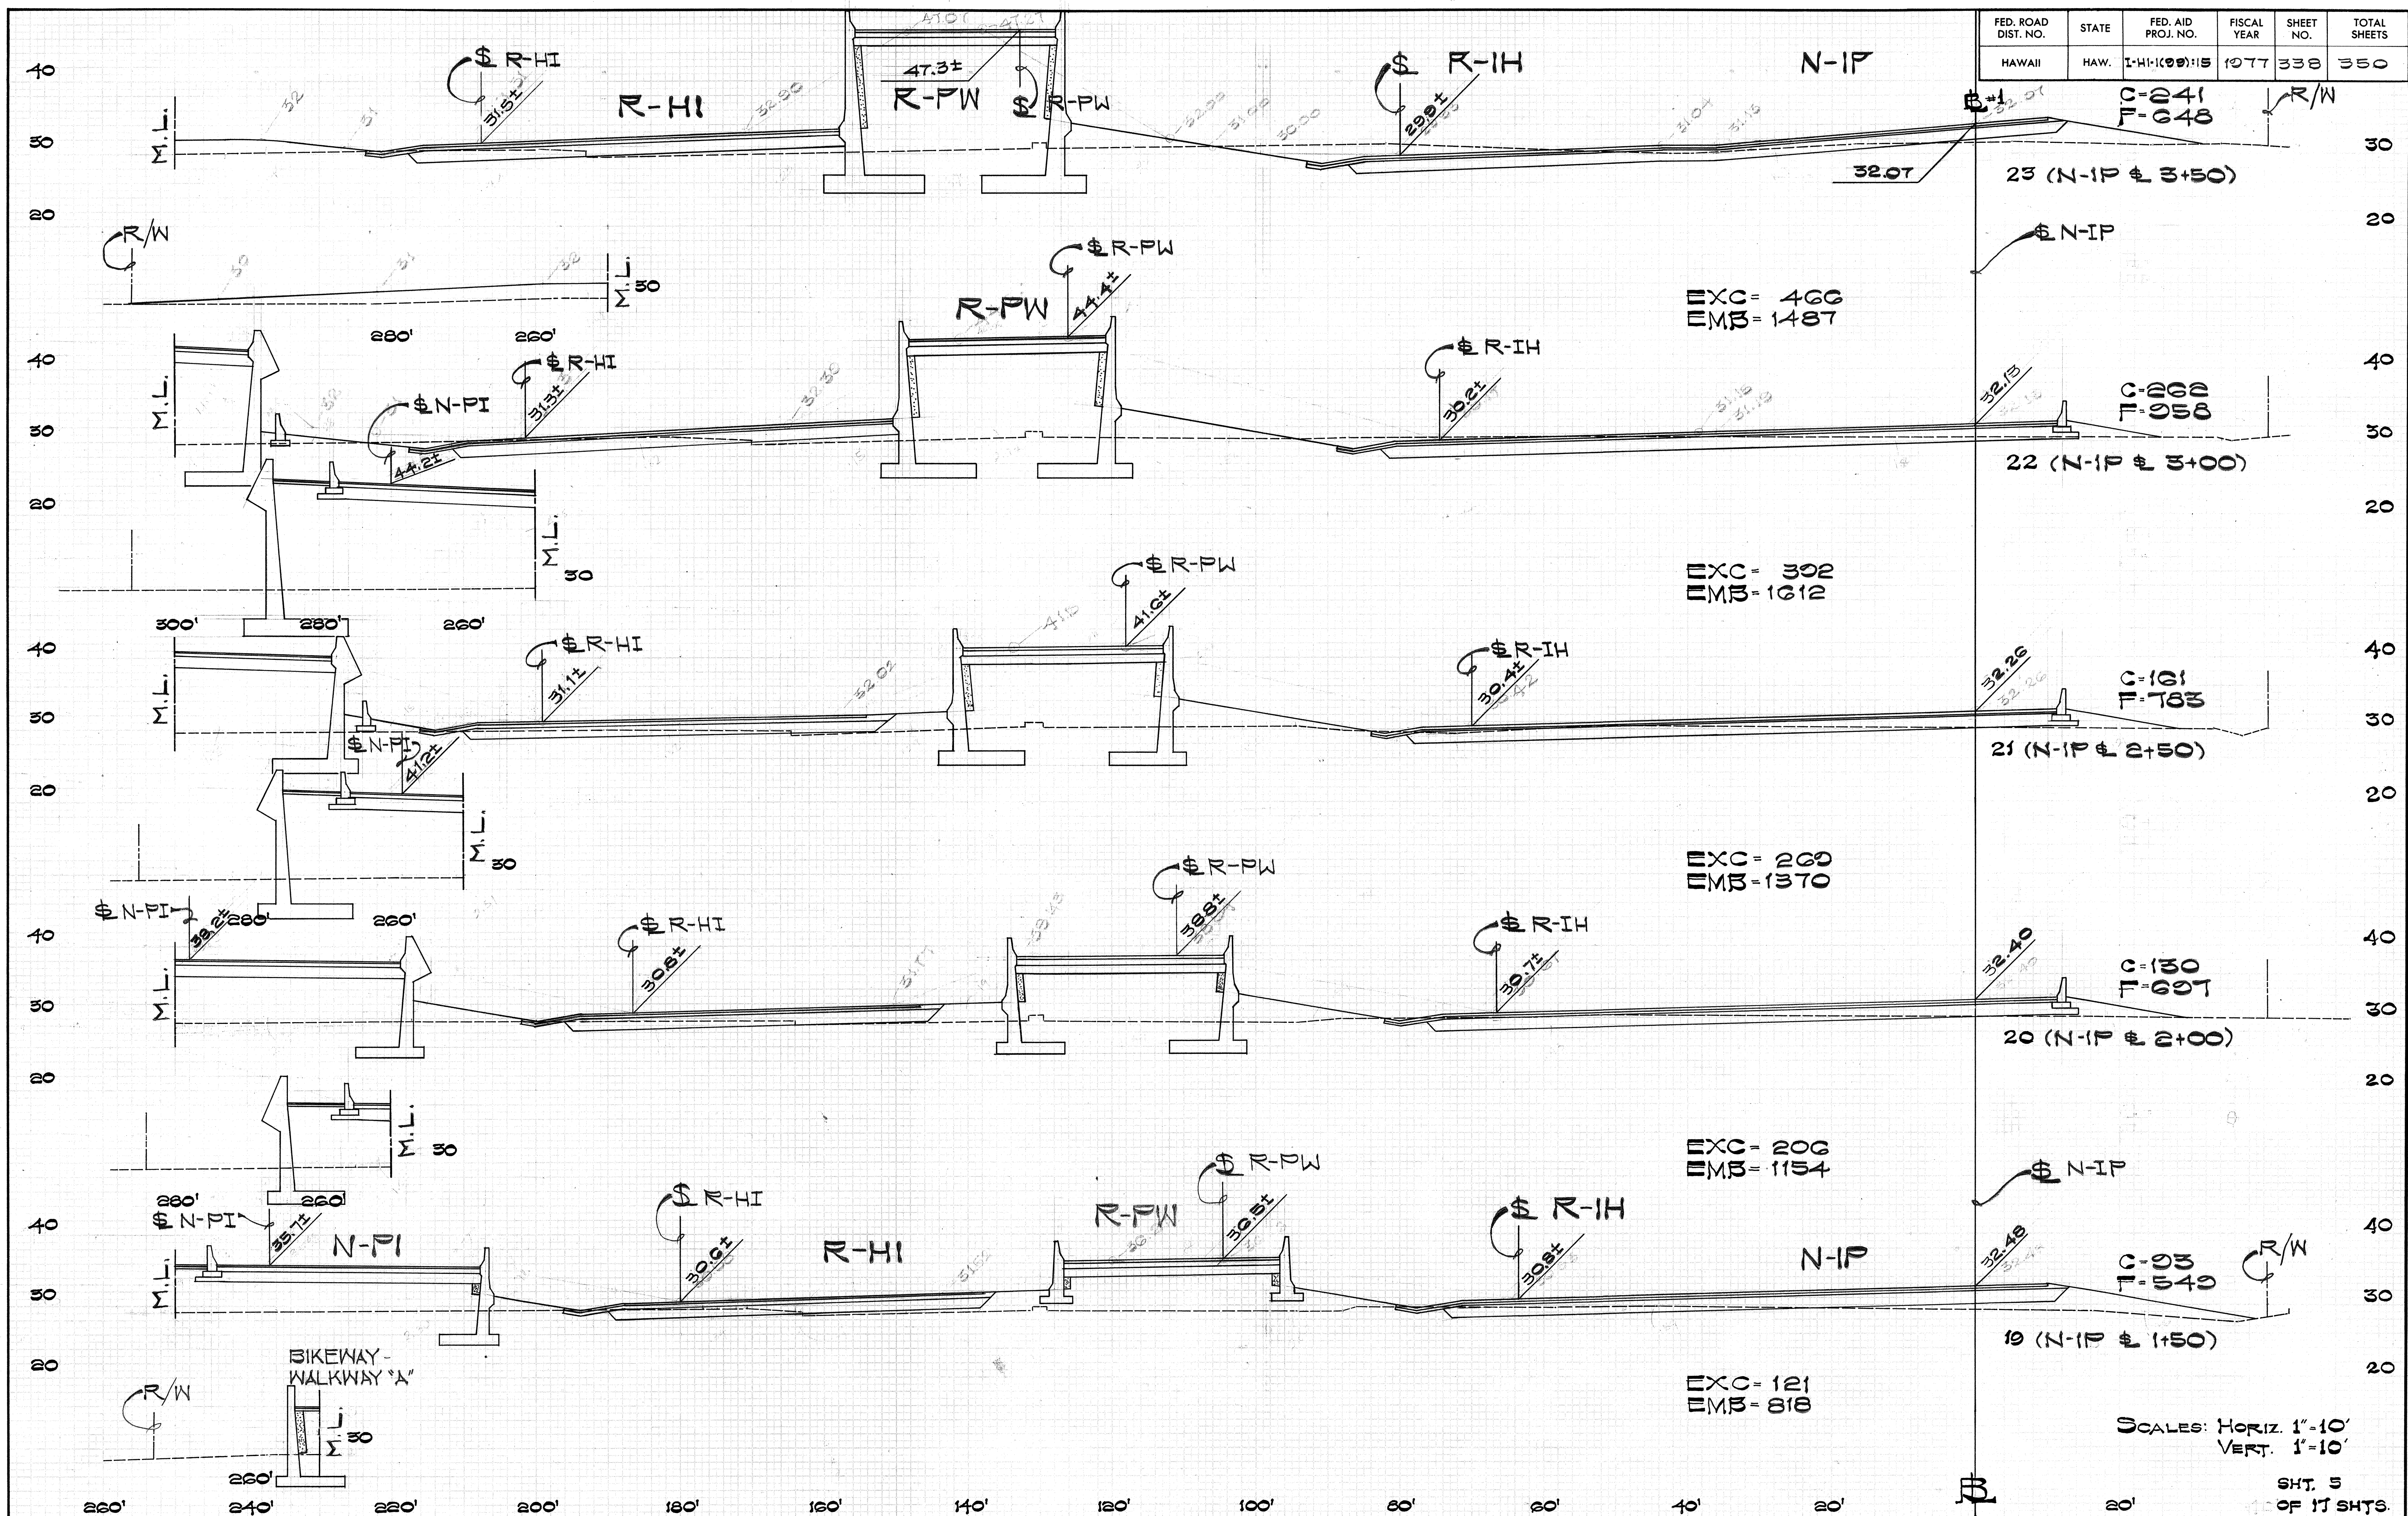


FED. ROAD DIST. NO.	STATE	FED. AID PROJ. NO.	FISCAL YEAR	SHEET NO.	TOTAL SHEETS
HAWAII	HAW.	I-H-1(99)15	1977	340	350

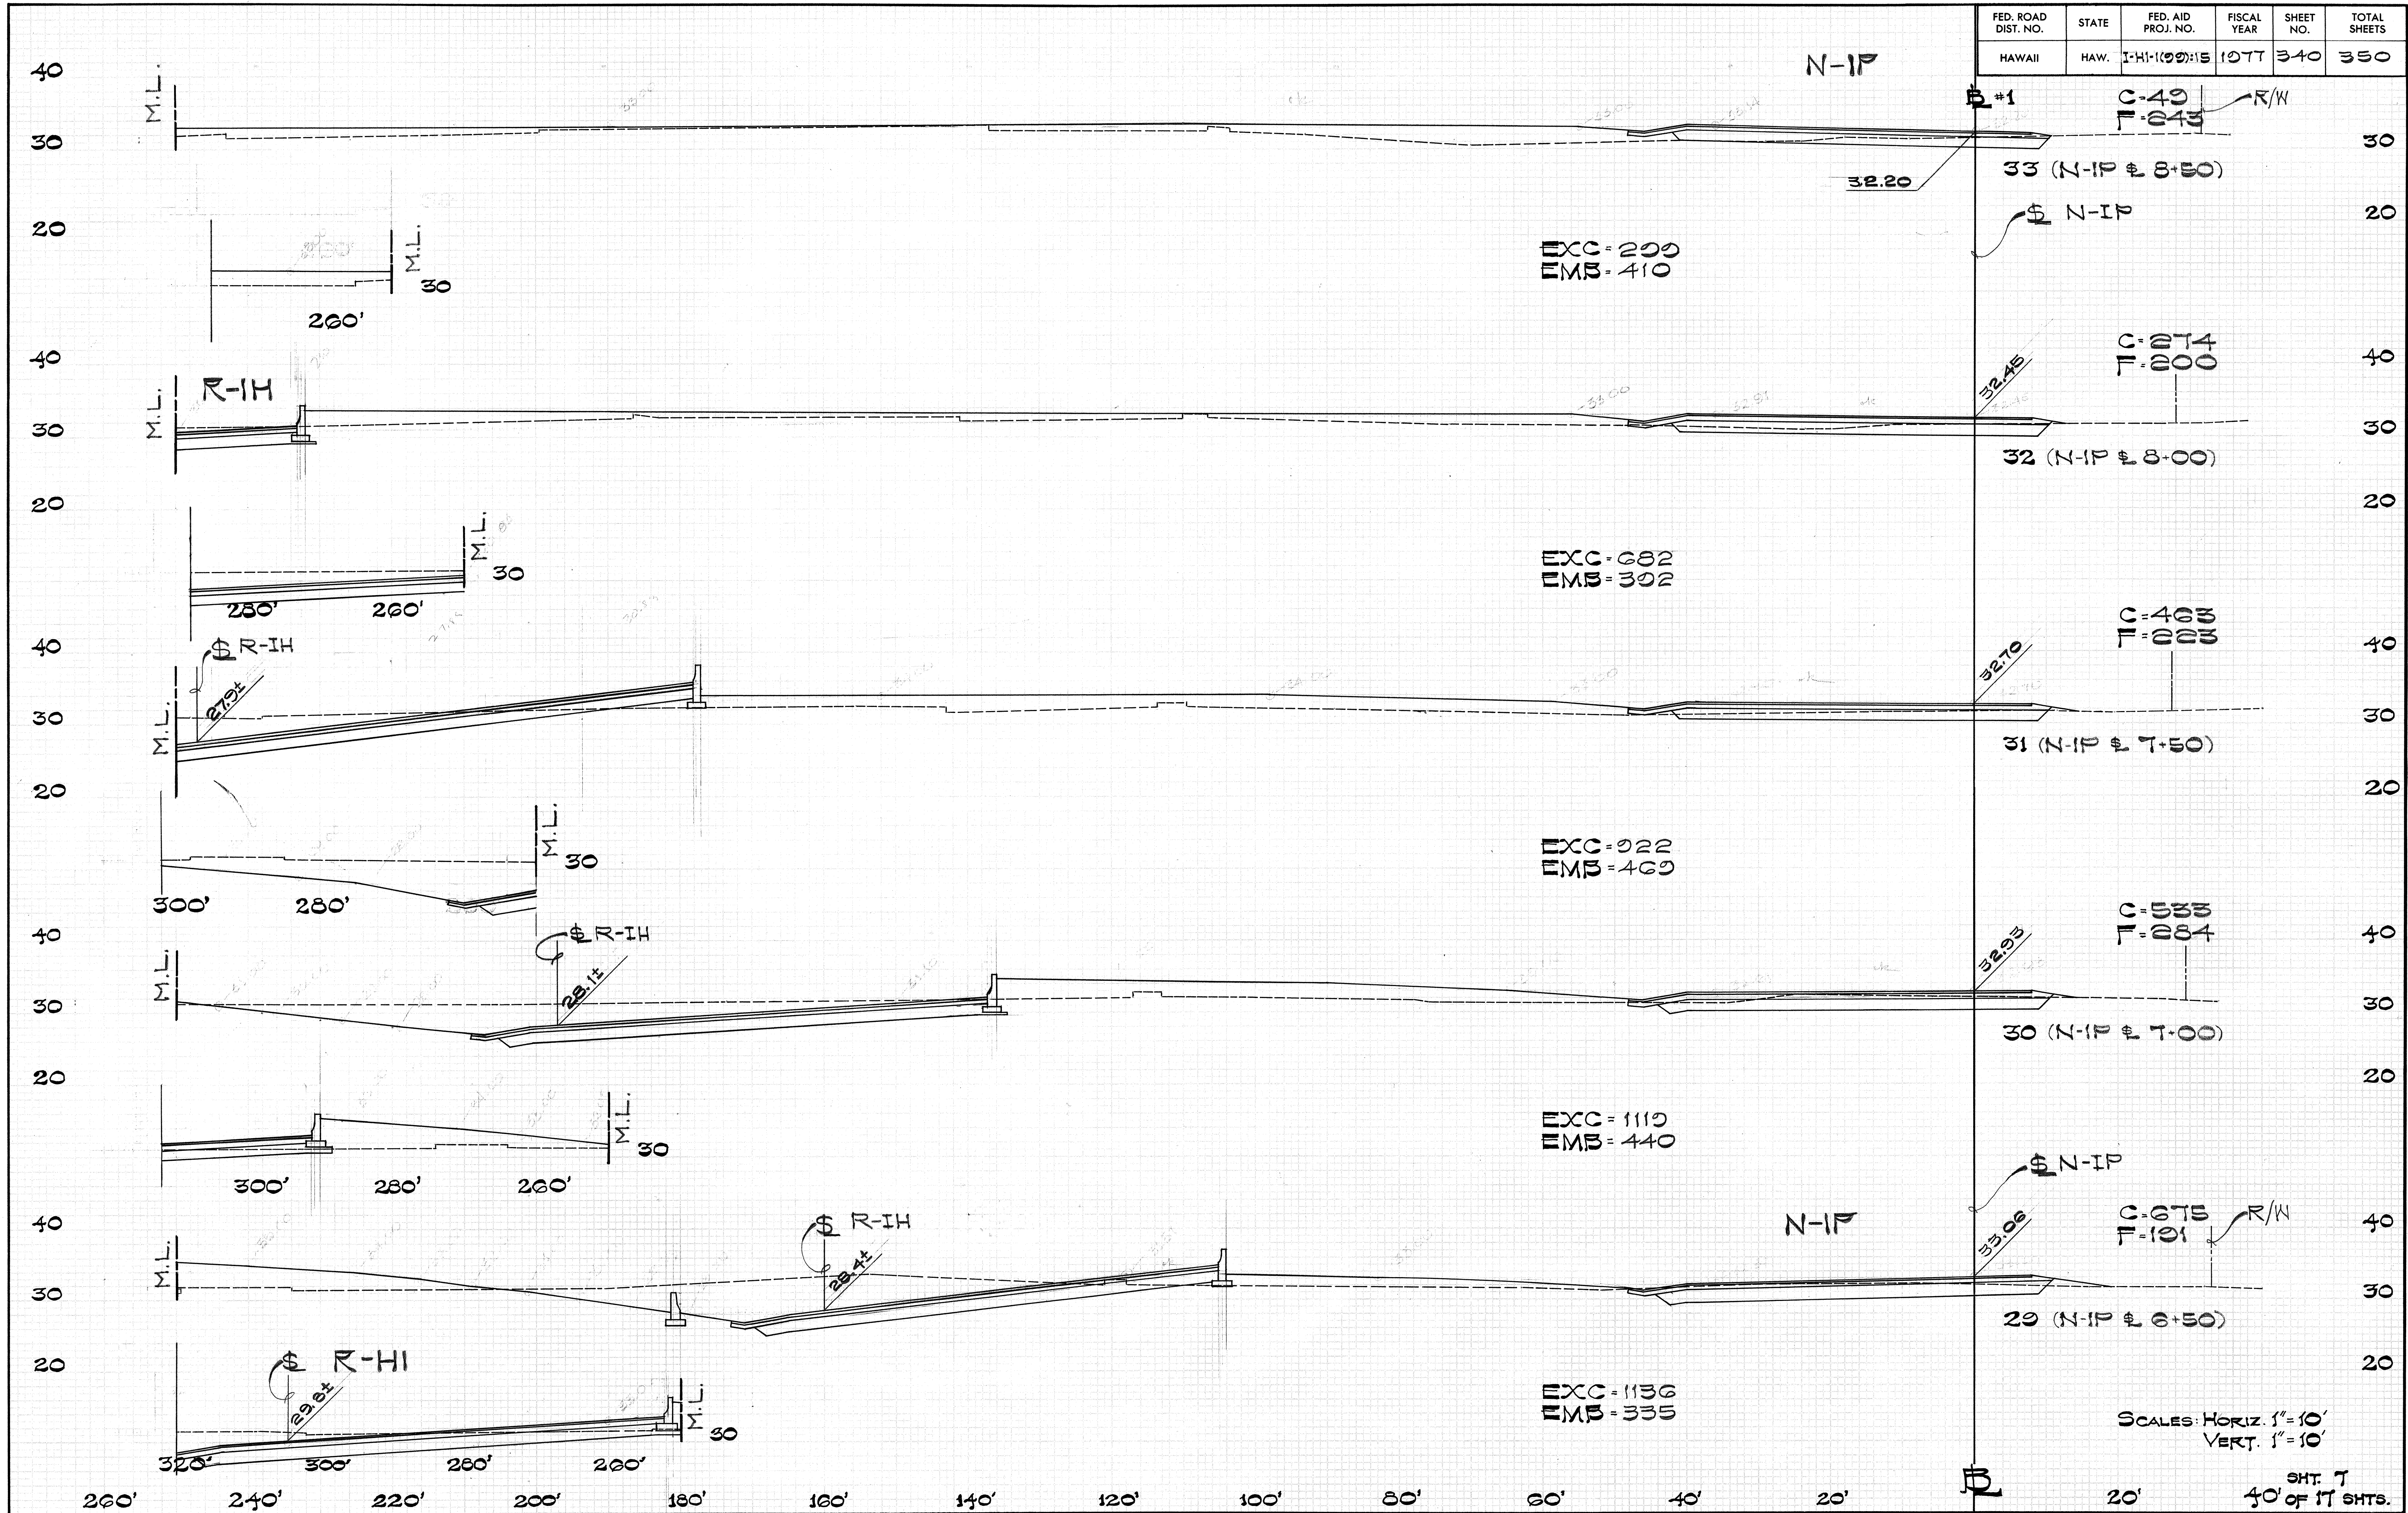

SCALES: HORIZ. 1"=10'
VERT. 1"=10'


SHT. 7
40' OF 17 SHTS.

FED. ROAD DIST. NO.	STATE	FED. AID PROJ. NO.	FISCAL YEAR	SHEET NO.	TOTAL SHEETS

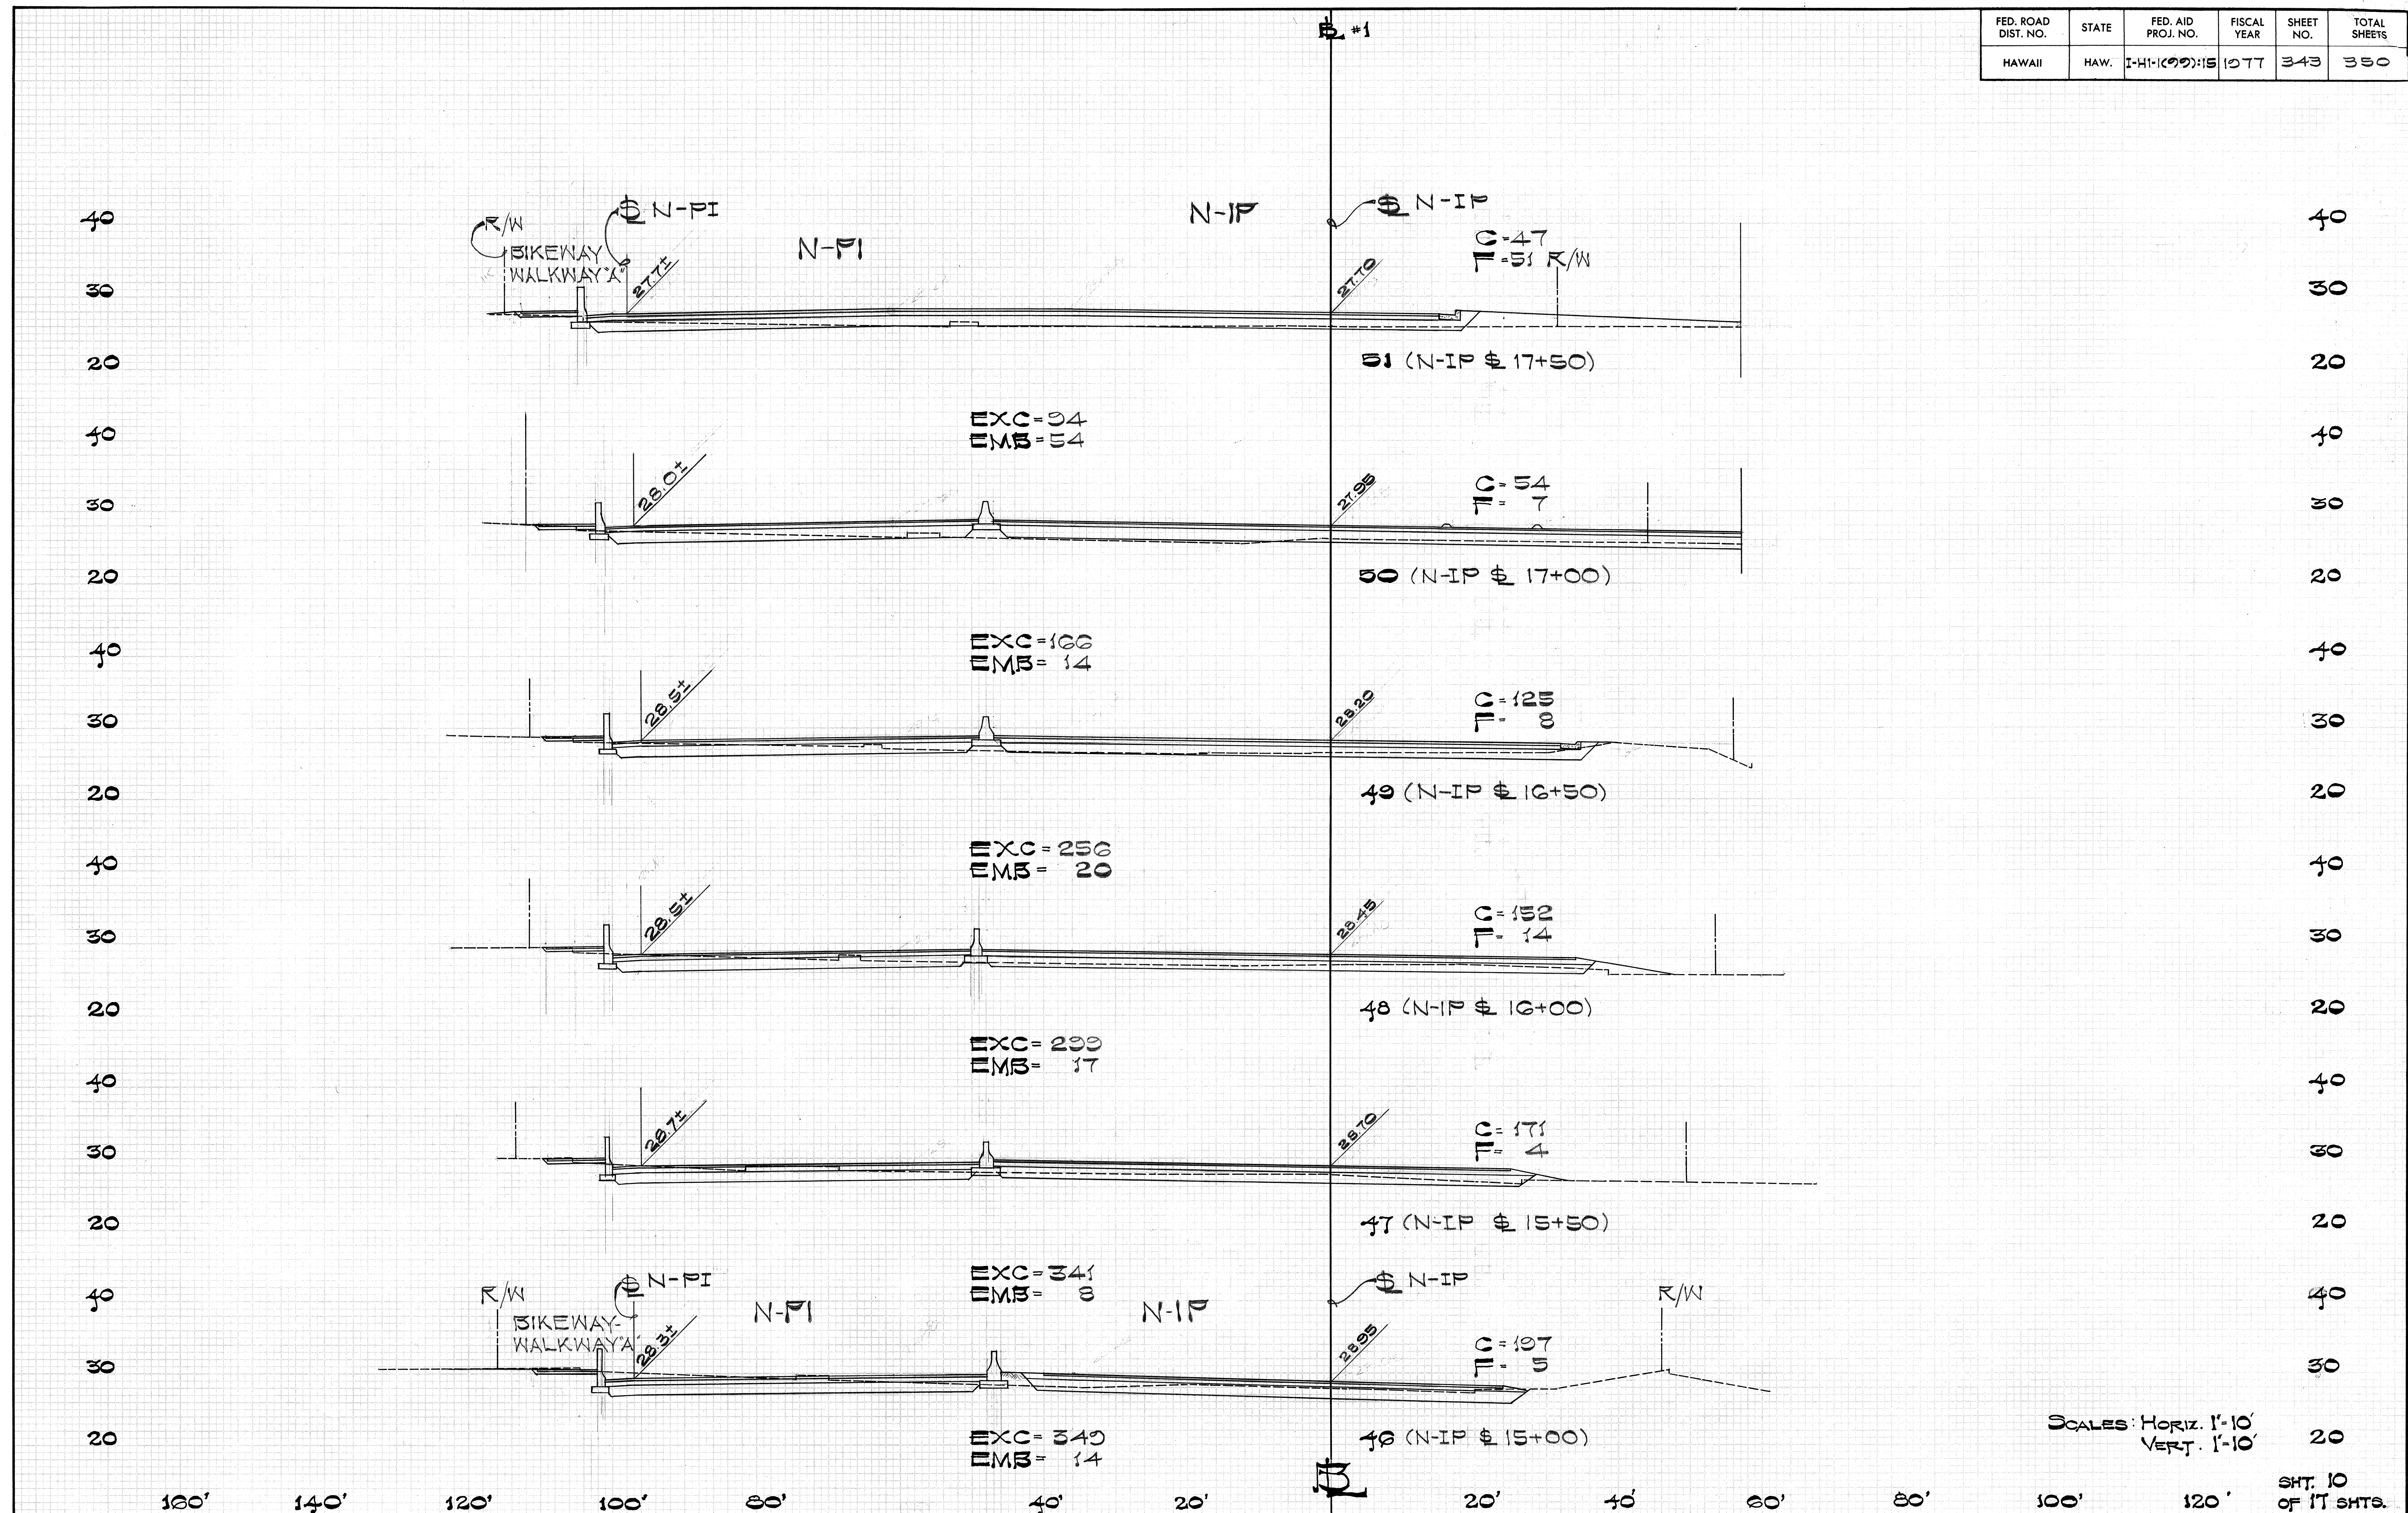

DATE	
BY	
ORIGINAL SURVEY	
NOTED	
PLOTTED	
NOTE BOOK	
AREAS	
NO	

DATE	
BY	
ORIGINAL SURVEY	
NOTED	
PLOTTED	
NOTE BOOK	
AREAS	
NO	

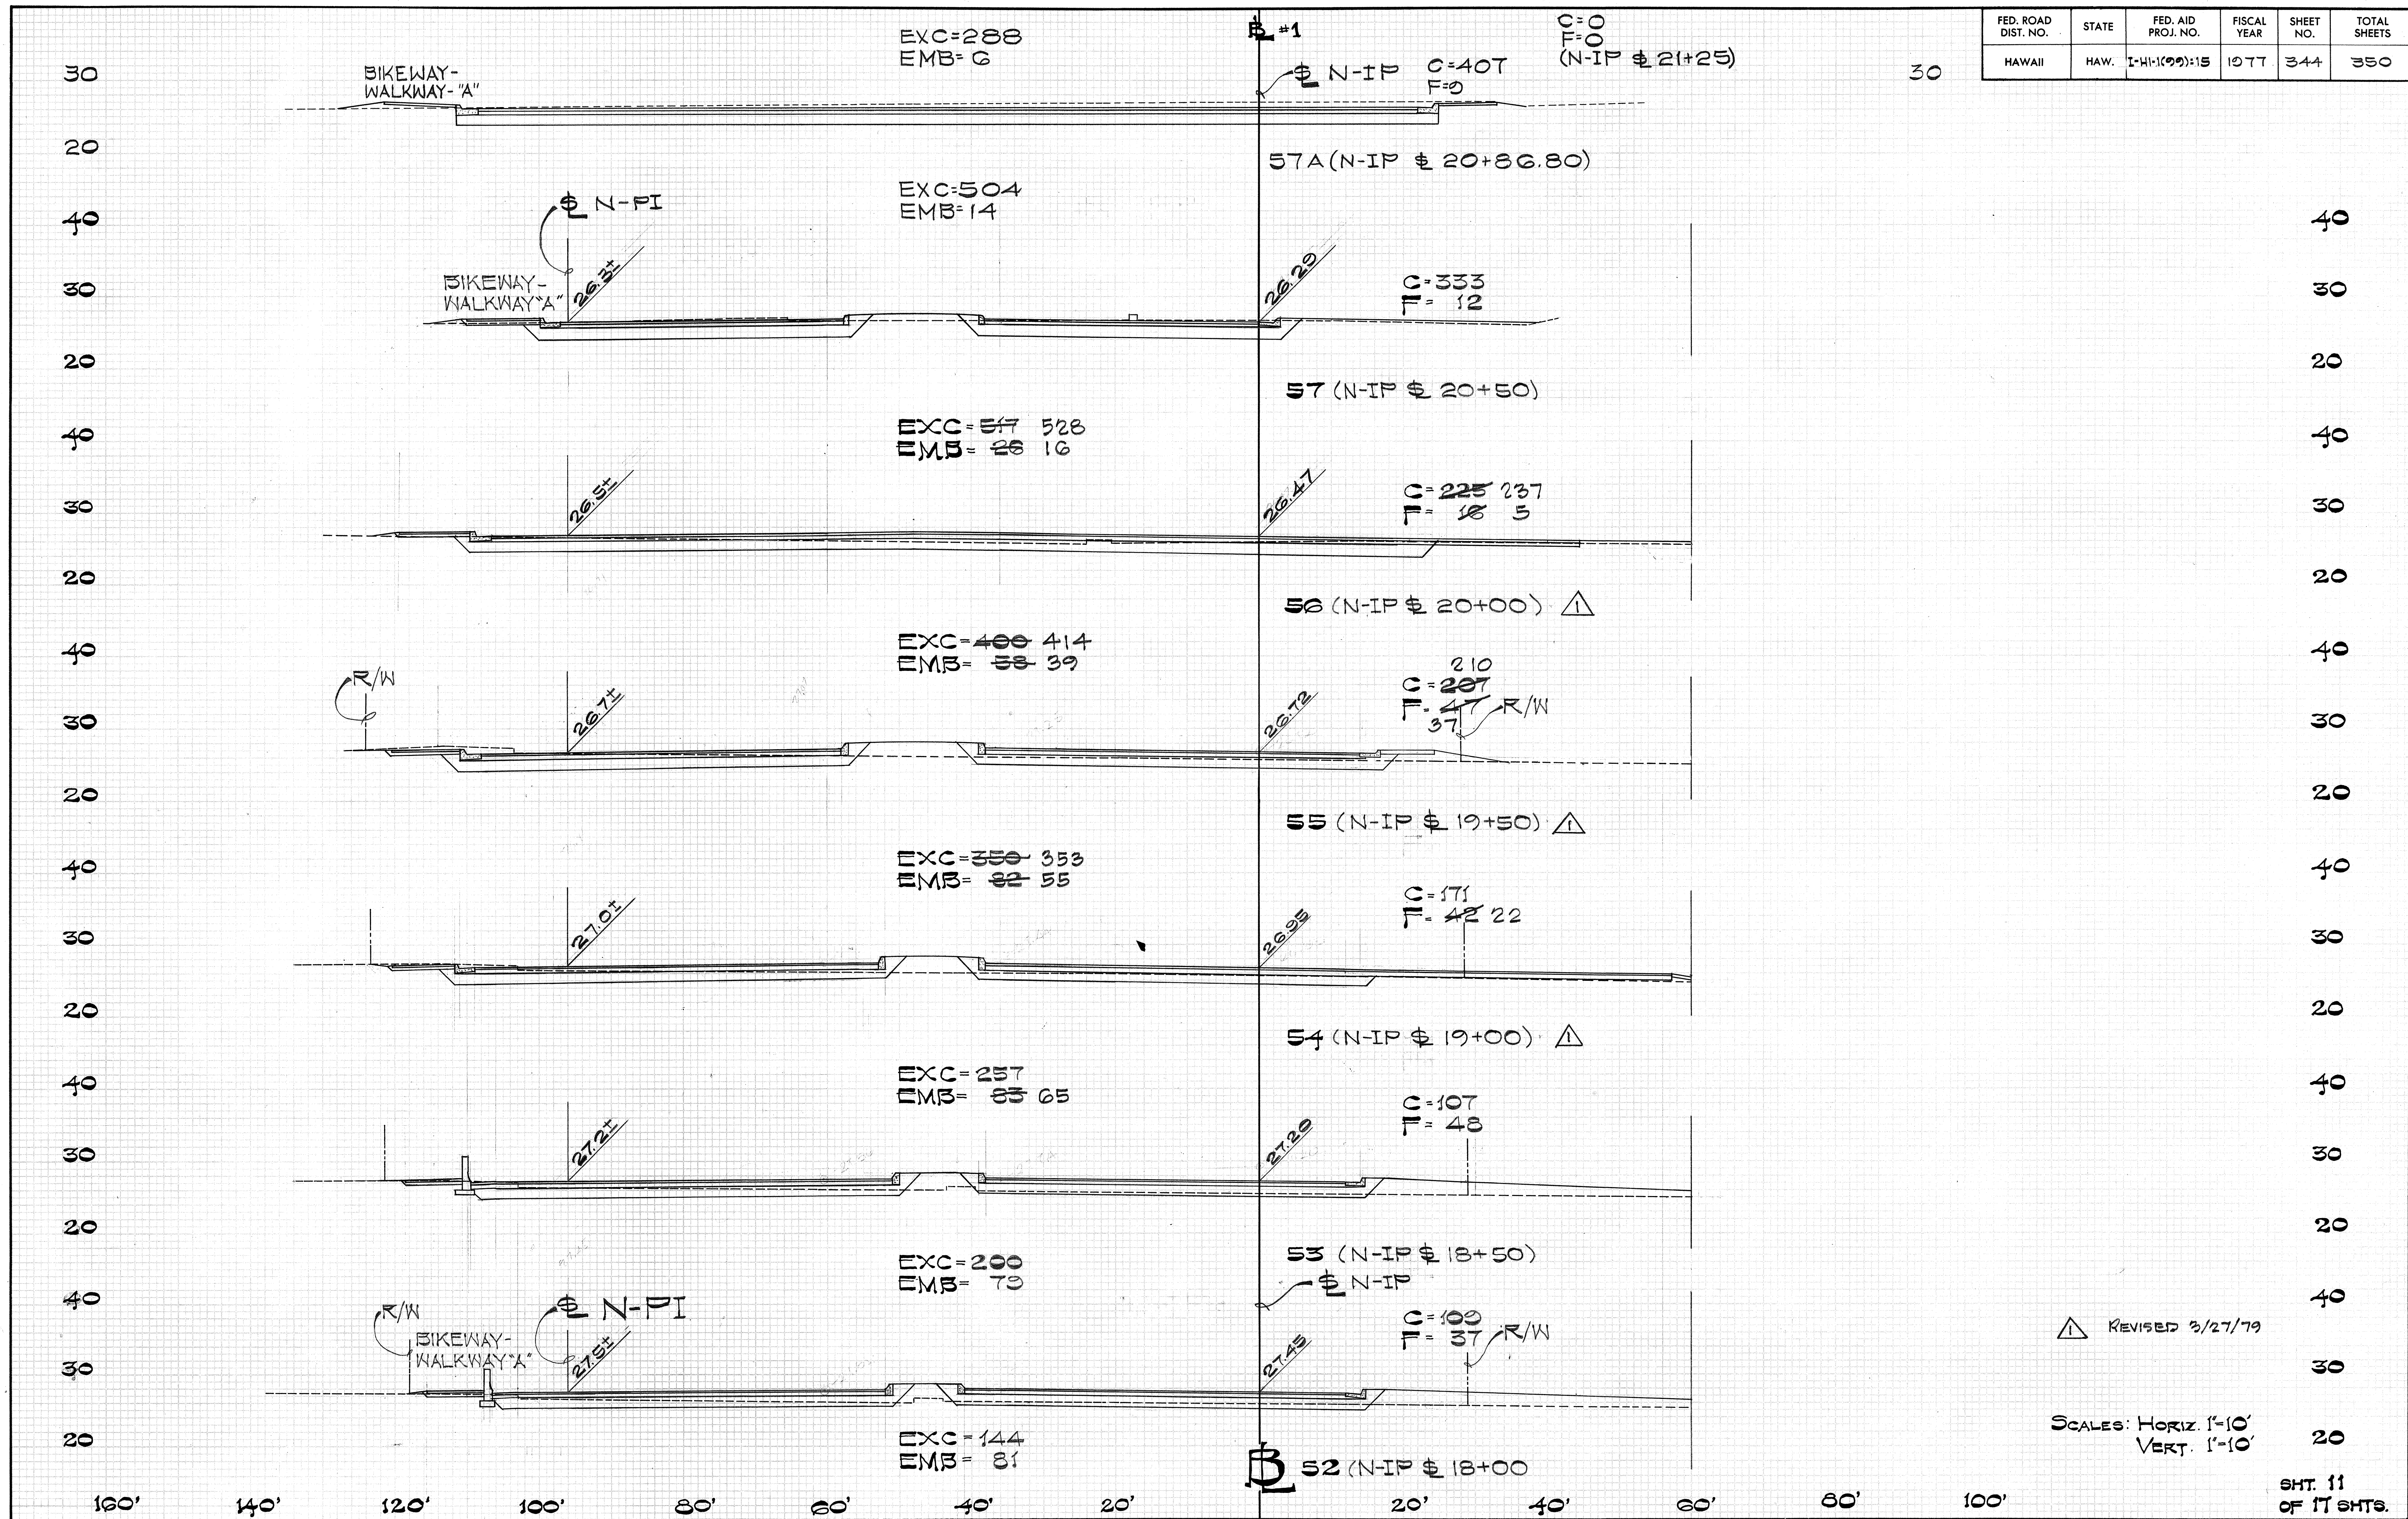

FED. ROAD DIST. NO.	STATE	FED. AID PROJ. NO.	FISCAL YEAR	SHEET NO.	TOTAL SHEETS
HAWAII	HAW.	I-41-1(99):15	1977	344	350

△ REVISED 3/27/79


SCALES: HORIZ. 1"=10'
VERT. 1"=10'

SHT. 11
OF 17 SHTS.


FED. ROAD DIST. NO.	STATE	FED. AID PROJ. NO.	FISCAL YEAR	SHEET NO.	TOTAL SHEETS
HAWAII	HAW.	I-HI-1(99)-15	1977	345	350

DATE	BY	FINAL SURVEY	NO. _____
		NOTE BOOK	NO. _____
		AREAS CHECKED	

DATE	BY	ORIGINAL SURVEY	NO. _____
		NOTE BOOK	NO. _____
		AREAS CHECKED	

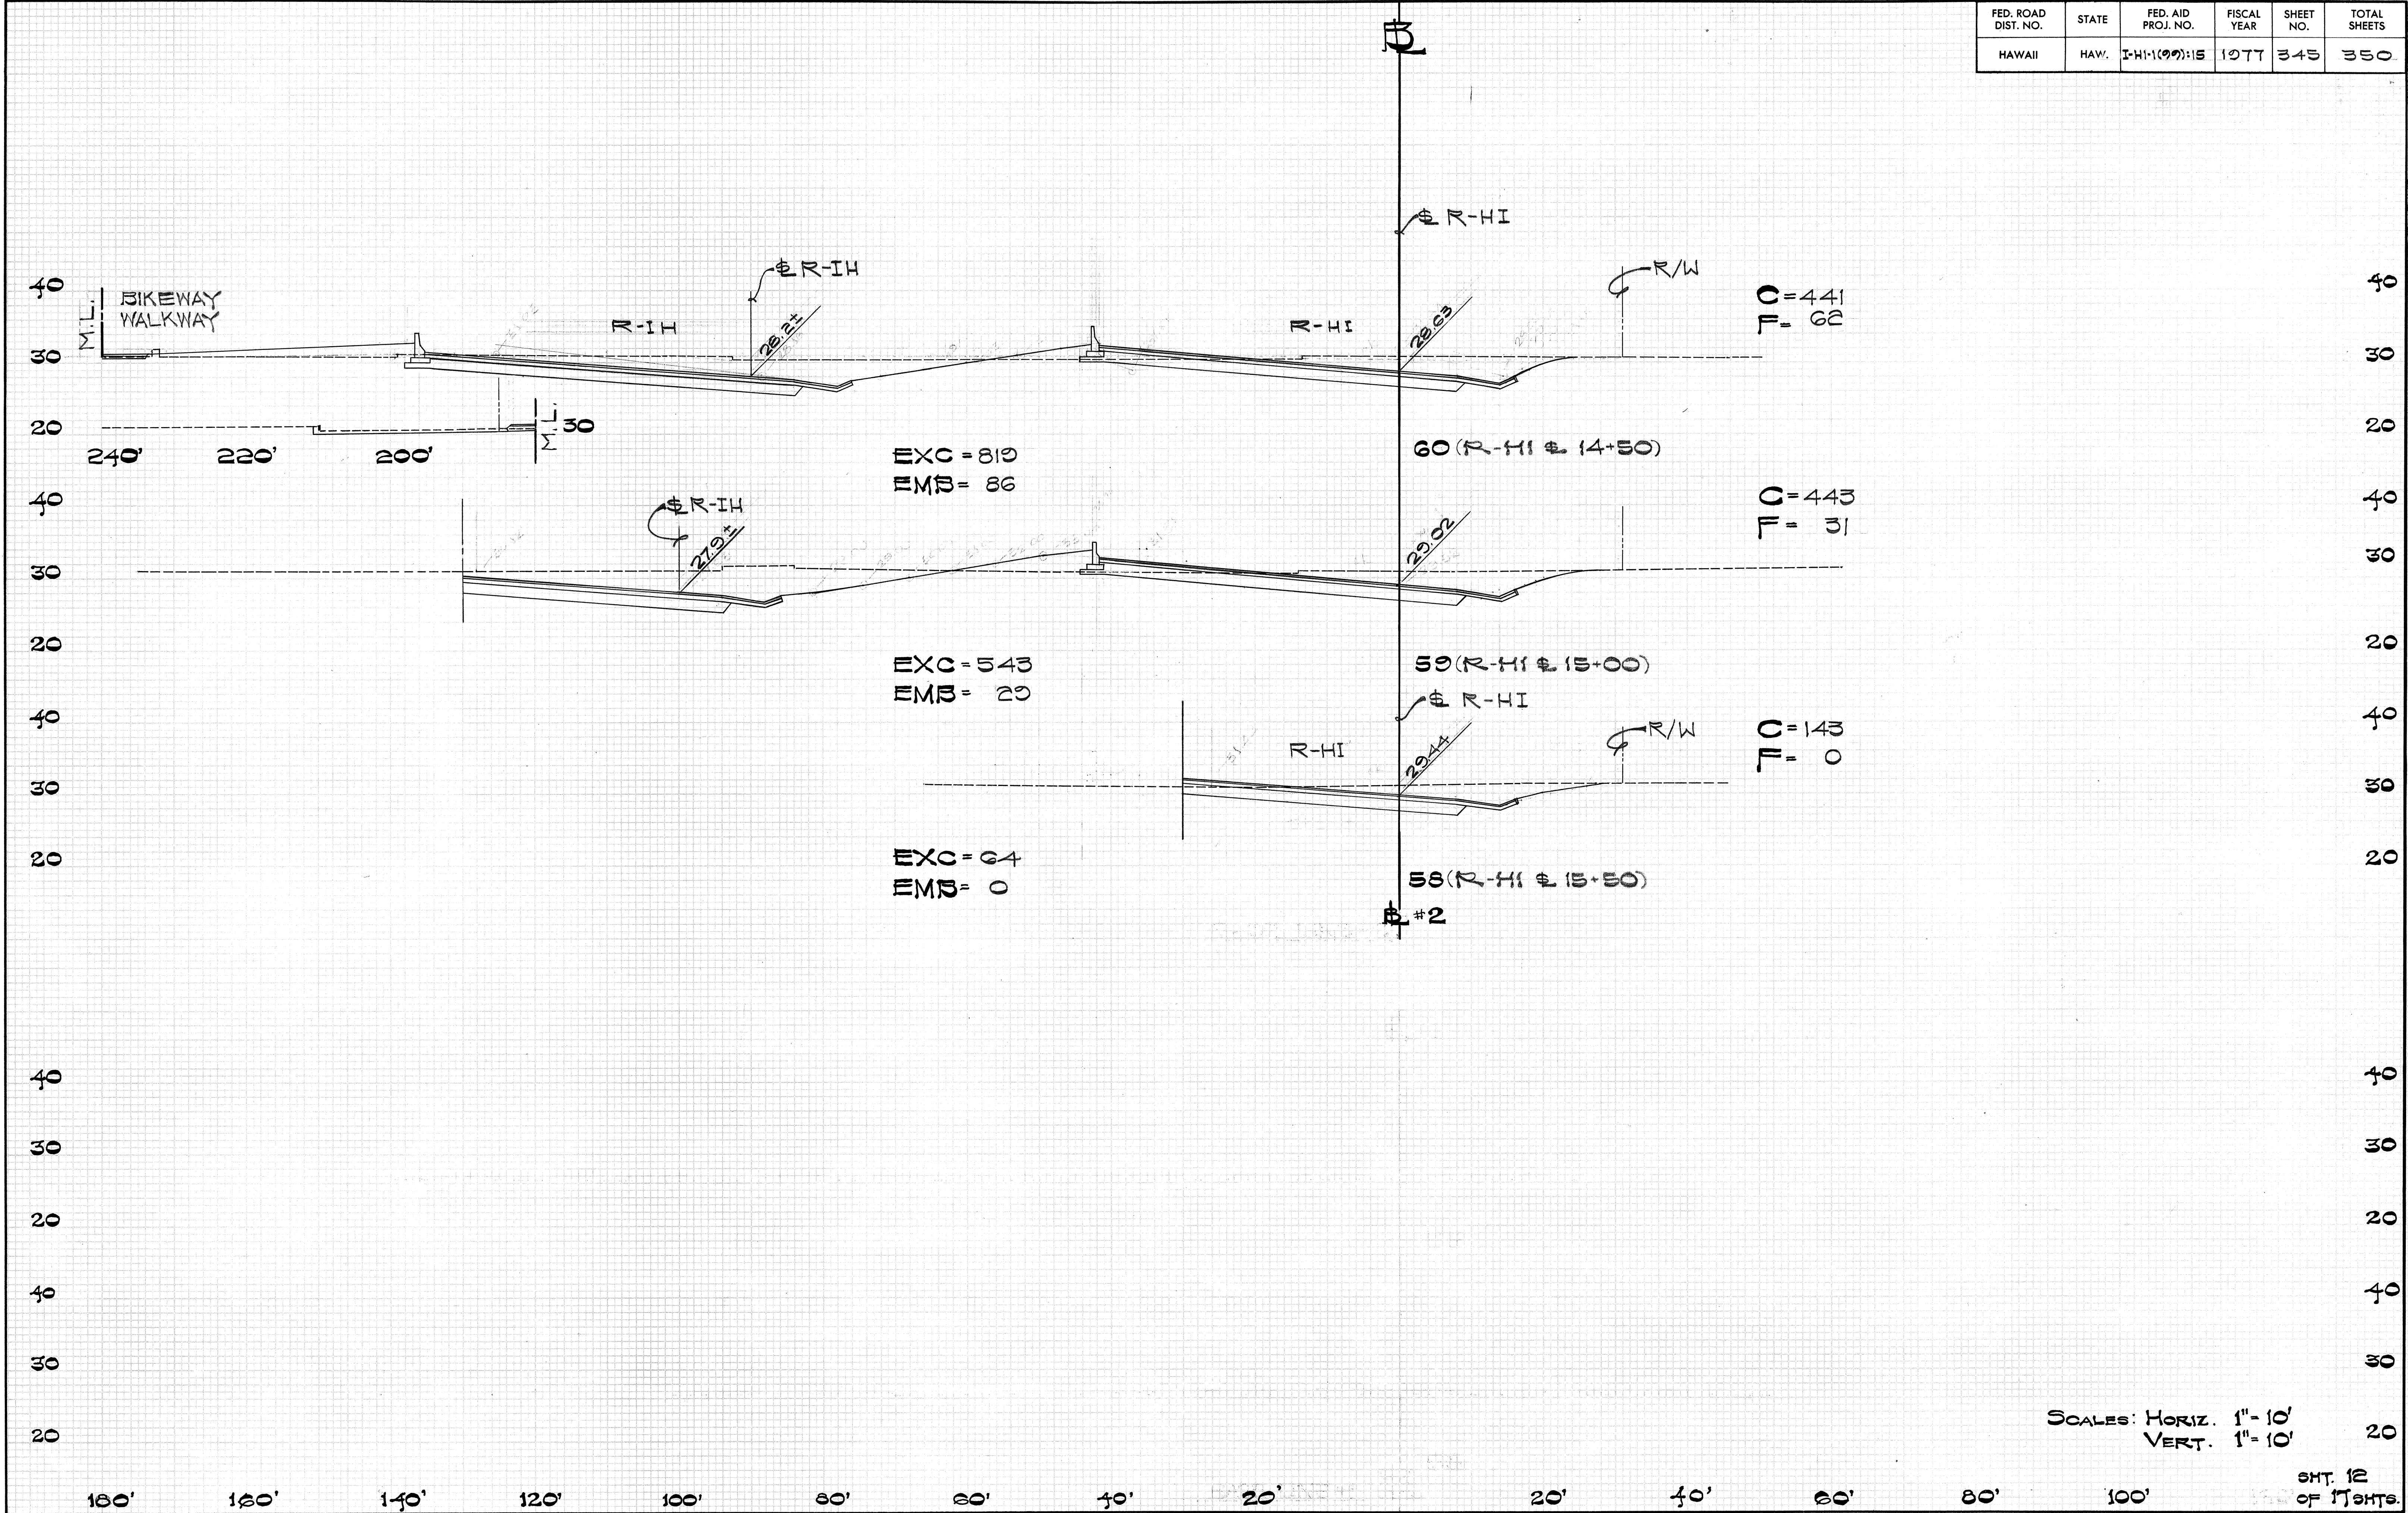


FED. ROAD DIST. NO.	STATE	FED. AID PROJ. NO.	FISCAL YEAR	SHEET NO.	TOTAL SHEETS
HAWAII	HAW.	I-41-1(99)-15	1977	347	350

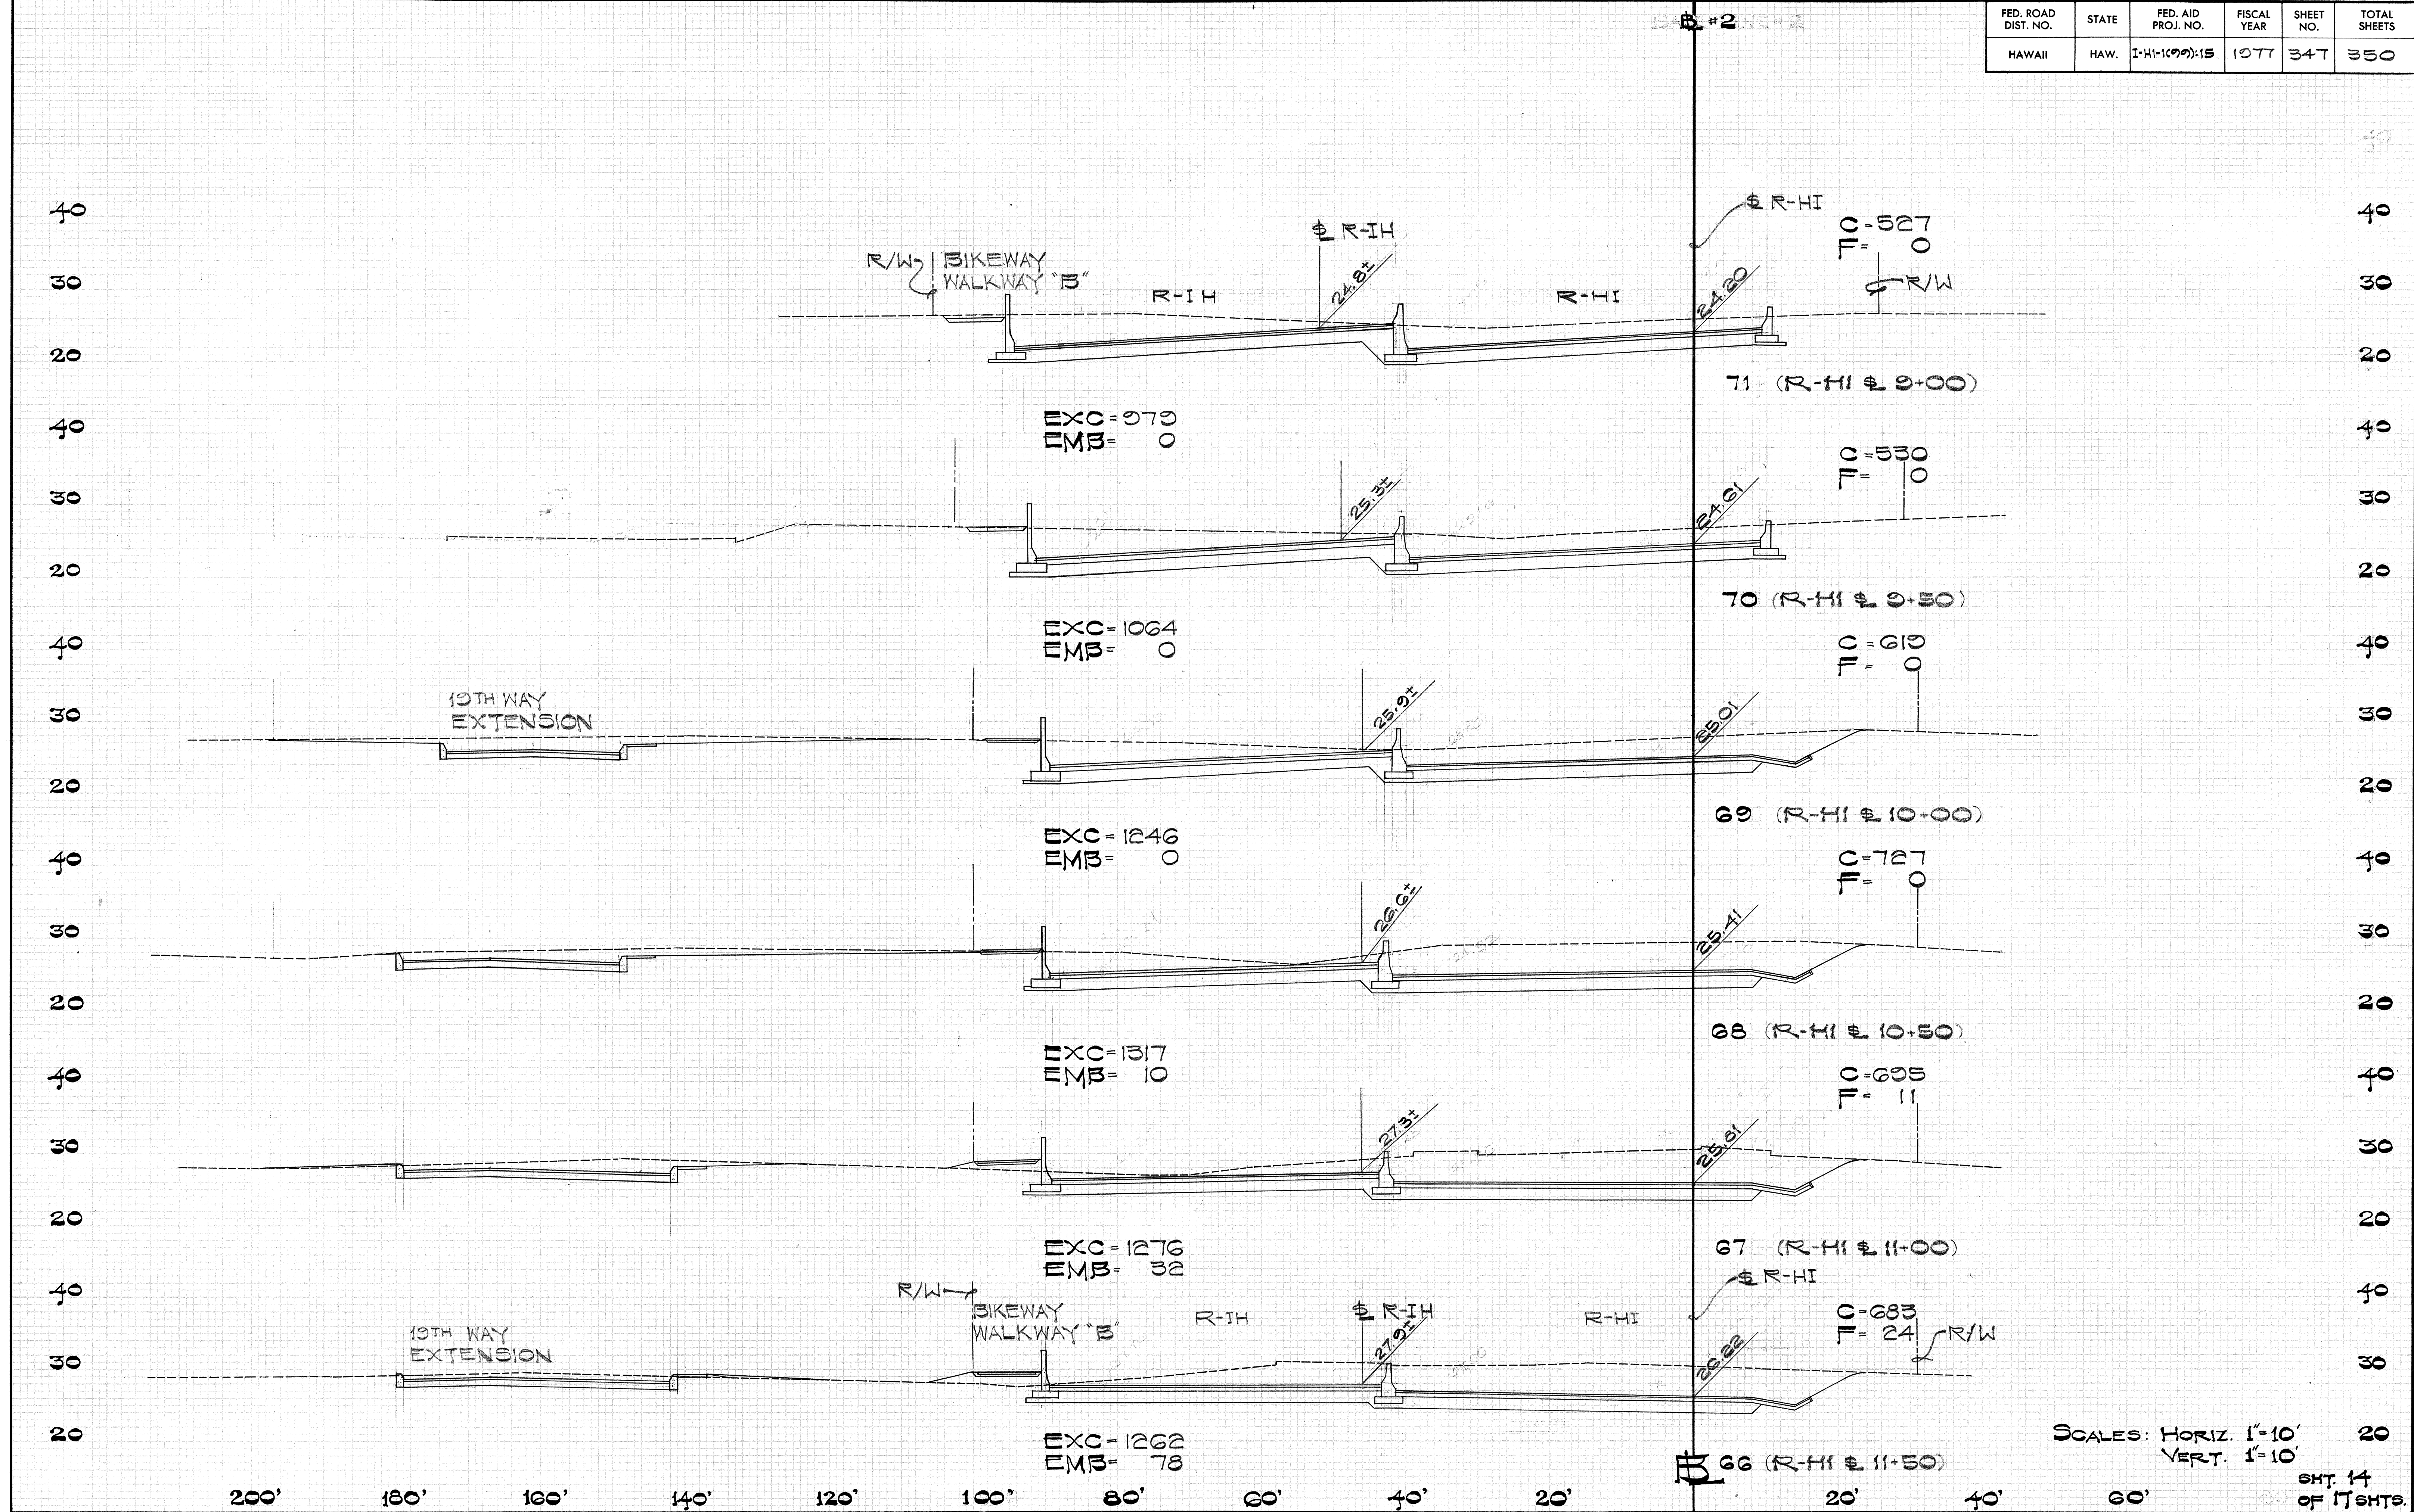

SCALES: HORIZ. 1"=10'
 VERT. 1"=10'



SHT. 14
 OF 17 SHTS.

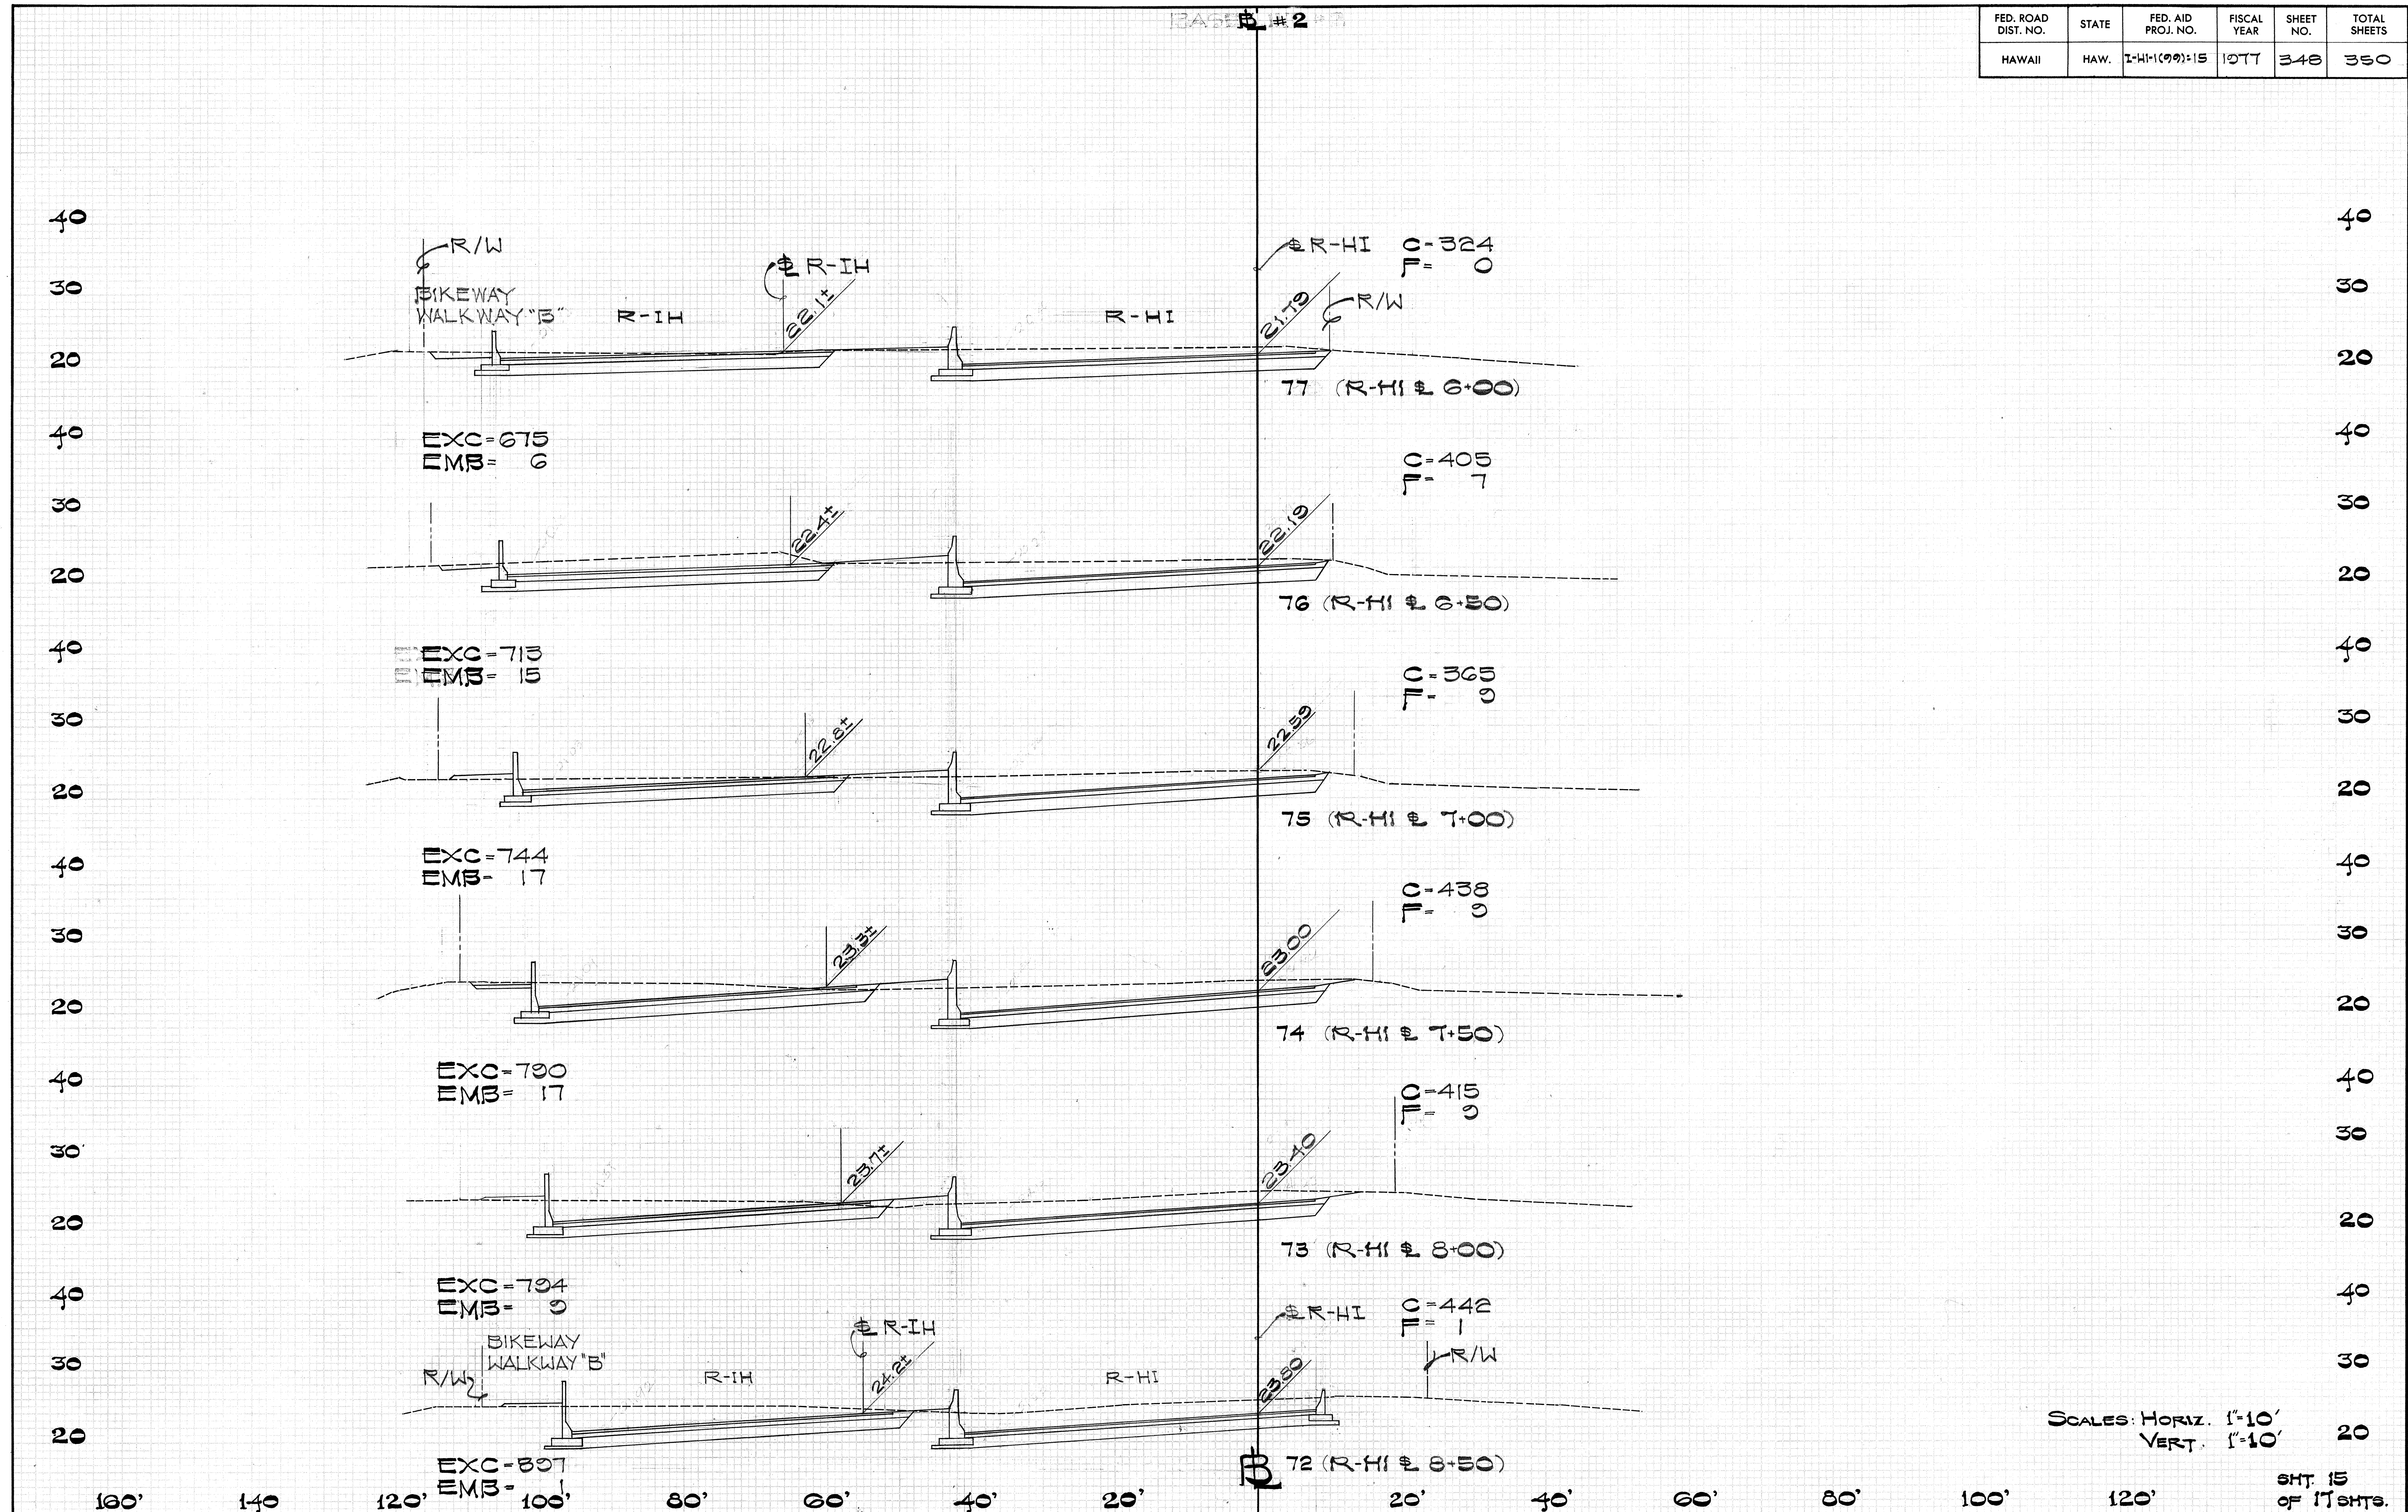



FED. ROAD DIST. NO.	STATE	FED. AID PROJ. NO.	FISCAL YEAR	SHEET NO.	TOTAL SHEETS
HAWAII	HAW.	I-HI-1(99):15	1977	340	350

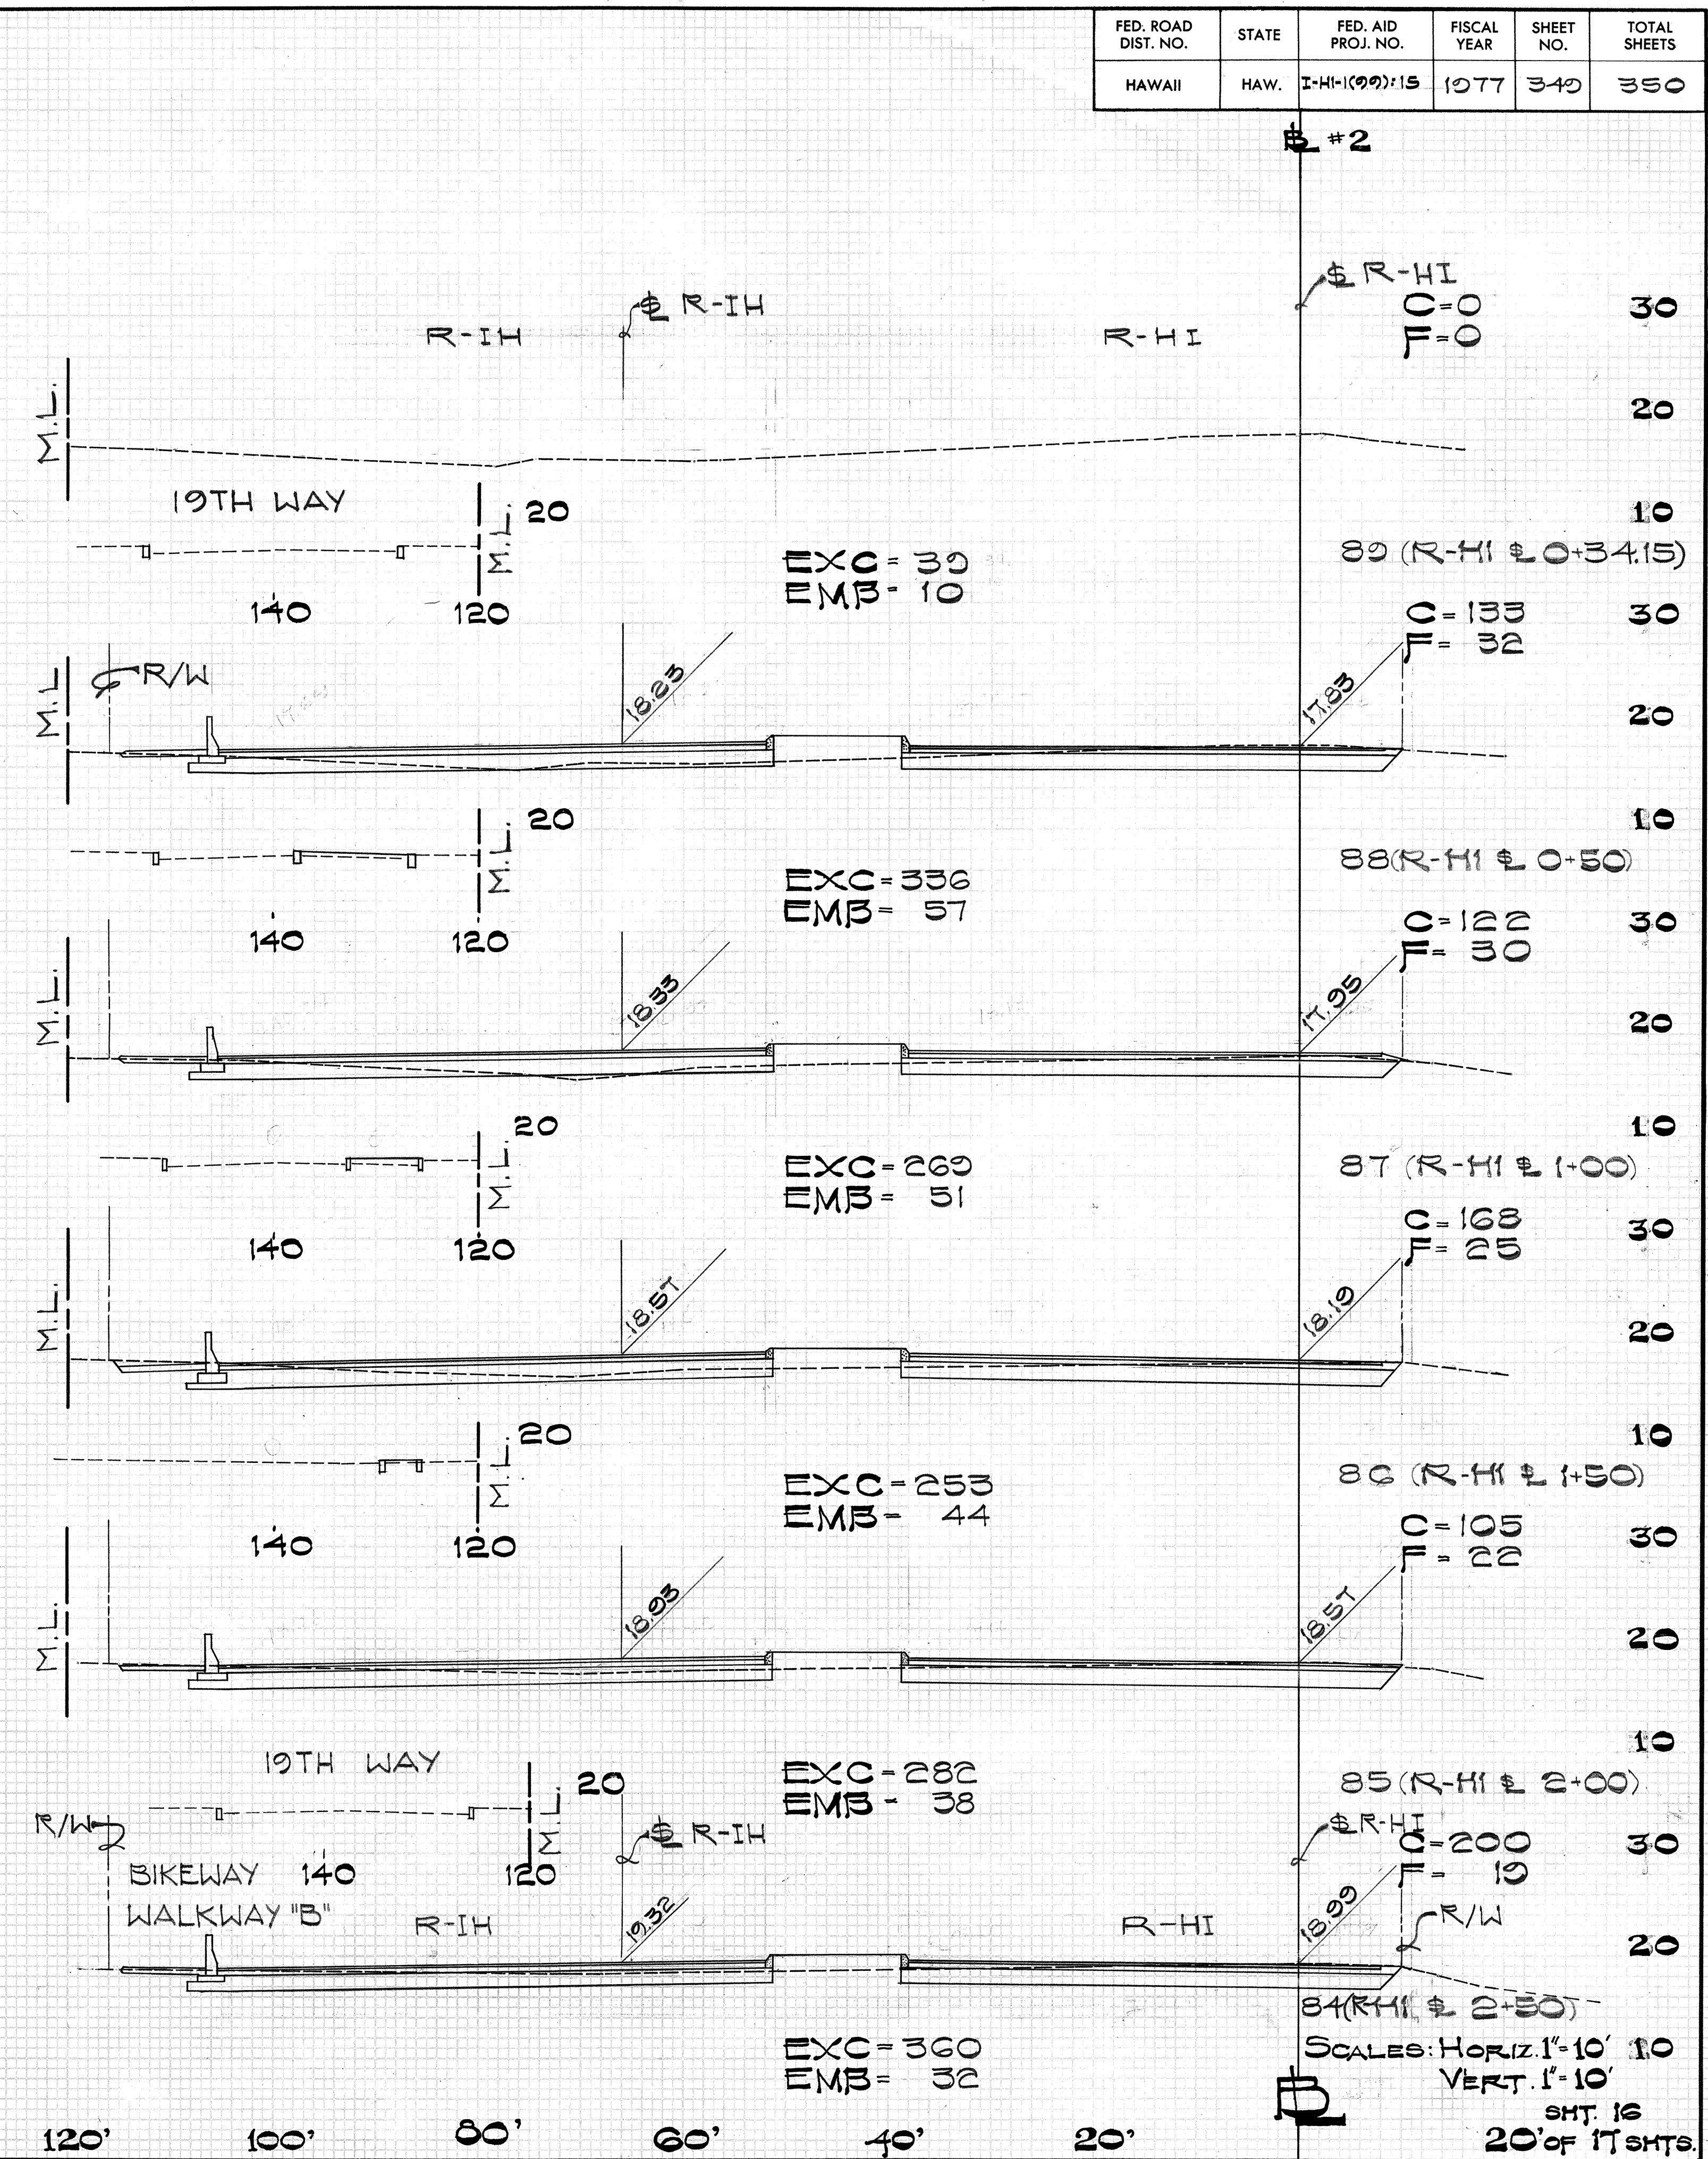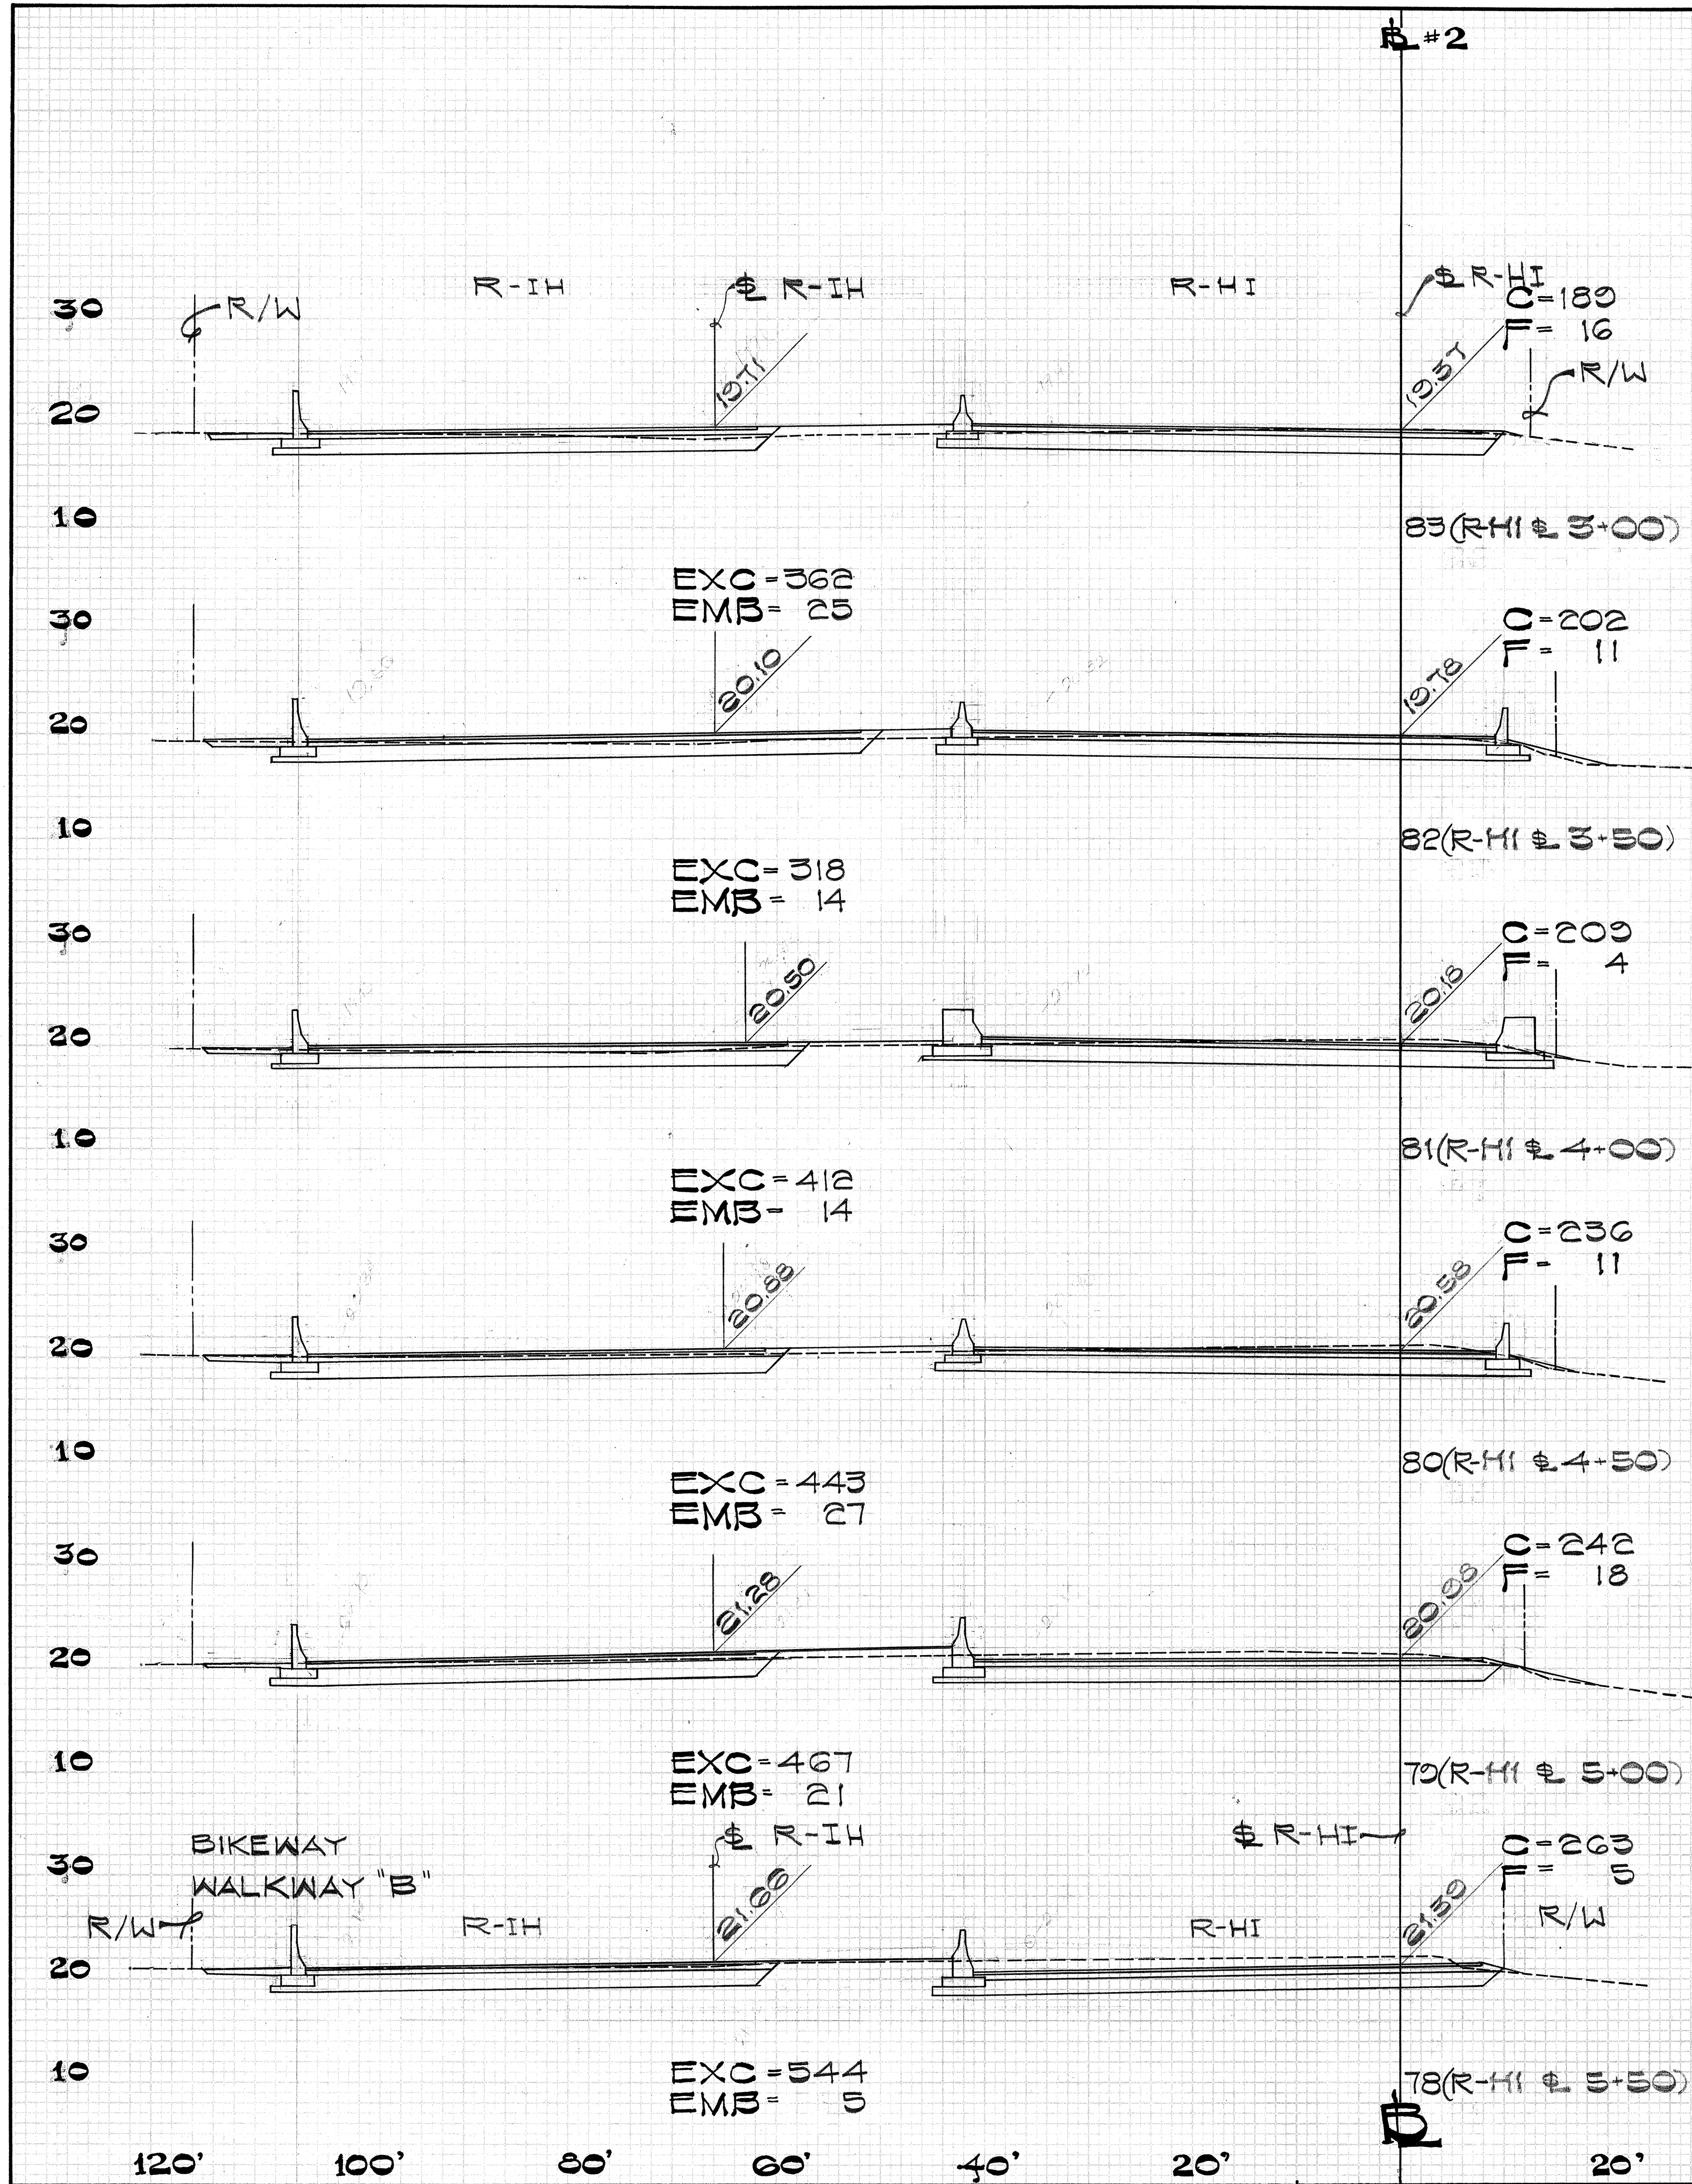

FED. ROAD DIST. NO.	STATE	FED. AID PROJ. NO.	FISCAL YEAR	SHEET NO.	TOTAL SHEETS

