FED. ROAD DIST. NO.	STATE	FED. AID PROJ. NO.	FISCAL YEAR	SHEET NO.	TOTAL SHEETS
HAWAII	HAW.	I-HI-I(22)16	1977	1	181

INDEX TO DRAWINGS

SHEET NO.	DESCRIPTION
1	TITLE
2	CONSTRUCTION PHASING
3-5	TYPICAL SECTIONS
6-9	PLAN SHEETS - SURFACE ROADS
10	PROFILES - SURFACE ROADS
11	DETOUR - RODGERS BLVD.
12	DRAINAGE PLAN & PROFILE
13-18	DRAINAGE STRUCTURES & DETAILS
19-21	DRAINAGE SUMMARY
22-26	SIGNING & STRIPING
27	TRAFFIC SIGNAL
28-33	MISCELLANEOUS DETAILS
34-58	STANDARD PLANS
59-69	UTILITIES
70-79	HIGHWAY LIGHTING
80-95	LANDSCAPING
96-100	PARKING LOT
	RAMPS EA & ED
101-102	INDEX OF DRAWINGS
103-148	RAMPS EA & ED
149-153	RETAINING WALLS
154-169	DETAILS
170-181	CROSS SECTIONS

STATE OF HAWAII

DEPARTMENT OF TRANSPORTATION
LAND TRANSPORTATION FACILITIES DIVISION

HONOLULU, HAWAII

"AS BUILT"

PLANS FOR

CONSTRUCTION OF A PORTION OF

INTERSTATE ROUTE H-1

AIRPORT INTERCHANGE
RODGERS BOULEVARD RAMPS EA/ED
FEDERAL AID INTERSTATE PROJECT I-HI-I(122):16

DISTRICT OF HONOLULU
ISLAND OF OAHU

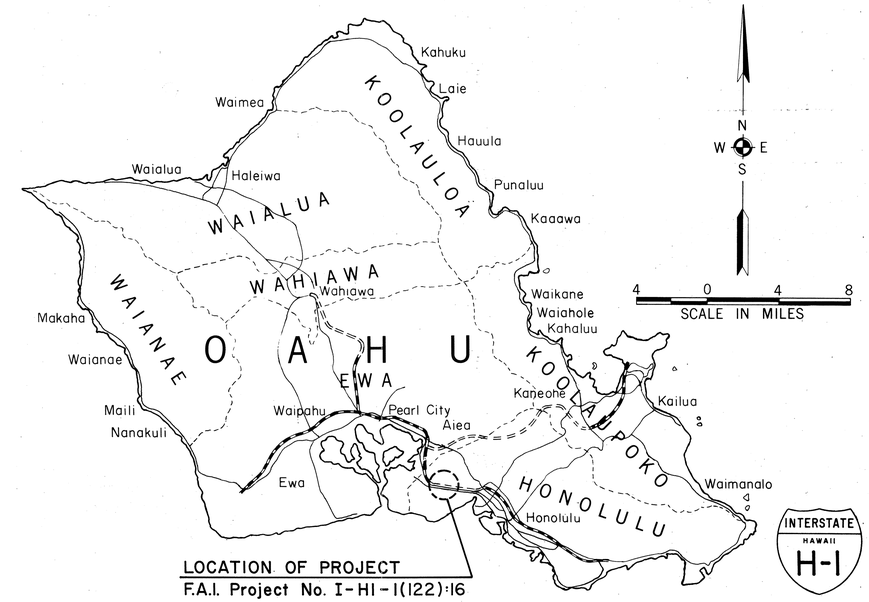

DESIGN CLASSIFICATION

DESIGN ADT (1994)	102,675
DHV	11%
D	60/40
T	5%
V	60 M.P.H.

SCALES:

PLANS	HOR.	1" = 50'
PROFILES	HOR.	1" = 50'
	VER.	1" = 10'
DETAIL ROADWAY PLANS	HOR.	1" = 20'
CROSS SECTIONS	HOR.	1" = 10'
	VER.	1" = 5'

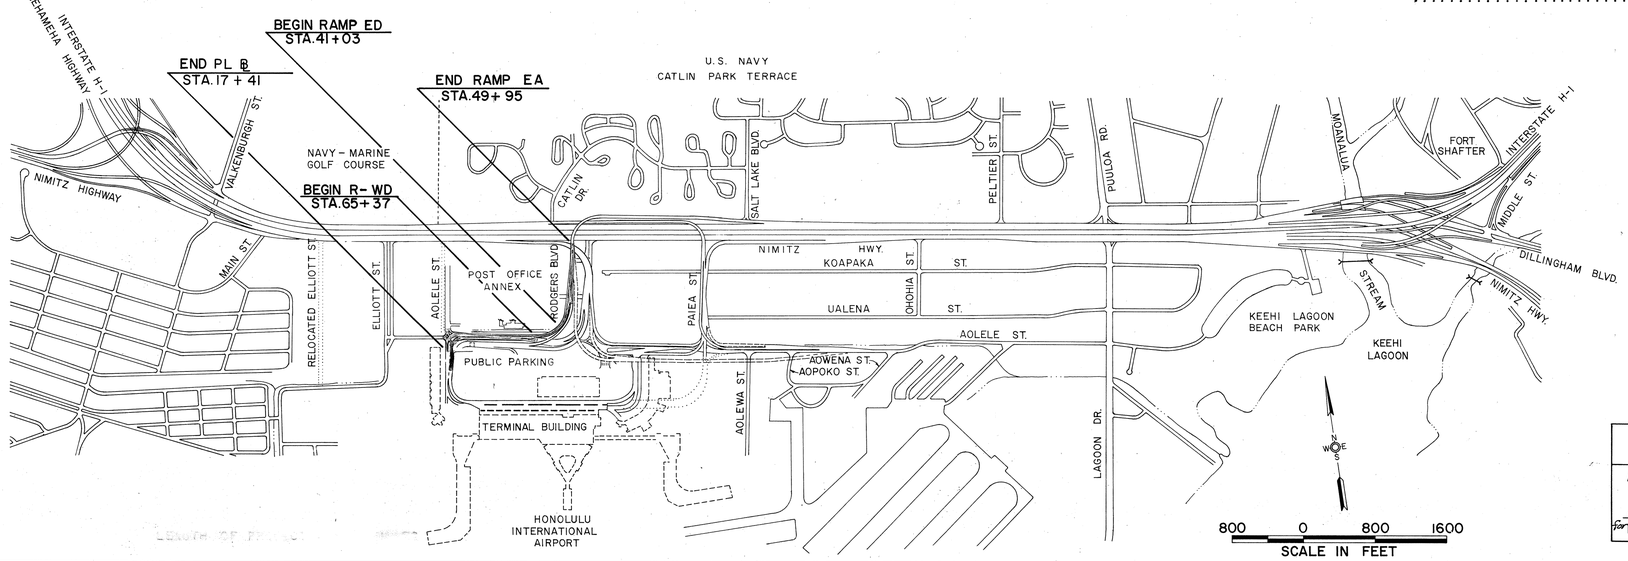

ALL CHANGES MADE DURING CONSTRUCTION HAVE BEEN INCORPORATED ON THESE PLANS EXCEPT CHANGES IN THEORETICAL QUANTITIES

RESIDENT ENGINEER

5-1-77	DATE
521-3051	PHONE
BEN TANAKA	P. S. & E. BY
URS COMPANY-HAWAII	DESIGNED BY

DEPARTMENT OF TRANSPORTATION FEDERAL HIGHWAY ADMINISTRATION	
APPROVED:	
for DIVISION ADMINISTRATOR	7-27-77 DATE

DEPARTMENT OF TRANSPORTATION STATE OF HAWAII	
APPROVED:	
for DIR. OF TRANSPORTATION	7/7/77 DATE