FED. ROAD DIST. NO.	STATE	PROJ. NO.	FISCAL YEAR	SHEET NO.	TOTAL SHEETS
HAWAII	HAW.	I-IR-HI -1(153):19	1978	1	27

INDEX TO DRAWINGS

SHEET NO.	DESCRIPTION
1	TITLE SHEET
2 - 4	TYPICAL SECTIONS
5 - 10	PLANS
11 - 13	MISCELLANEOUS DETAILS
14 - 20	PAVEMENT MARKING AND STRIPING PLANS
21 - 27	TYPICAL & STANDARD DETAILS

STATE OF HAWAII

DEPARTMENT OF TRANSPORTATION
LAND TRANSPORTATION FACILITIES DIVISION
HONOLULU, HAWAII

PLANS OF

INTERSTATE ROUTE H-1 RESURFACING MIDDLE STREET TO PALI HIGHWAY

PROJECT NO. I-IR-HI-1(153):19

DISTRICT OF HONOLULU
ISLAND OF OAHU

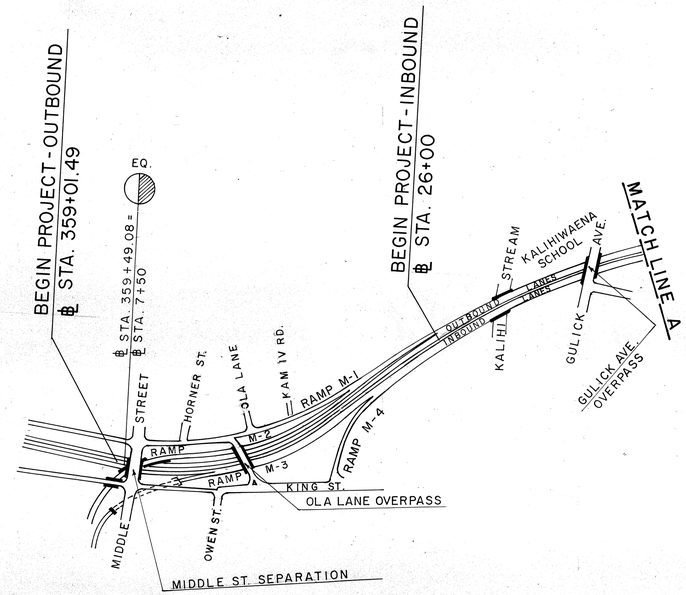

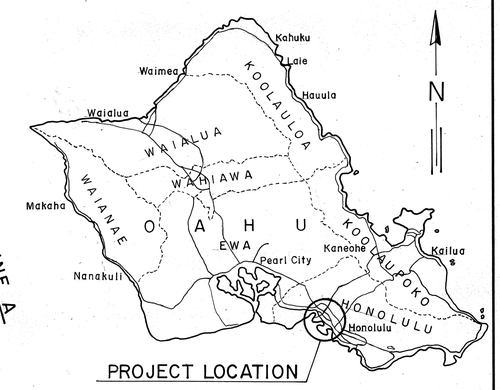

DESIGN CLASSIFICATION

CURRENT ADT (1978)	129,600
DESIGN ADT (1998)	152,600
DHV	15,000
T_{24}	3%
V	50MPH

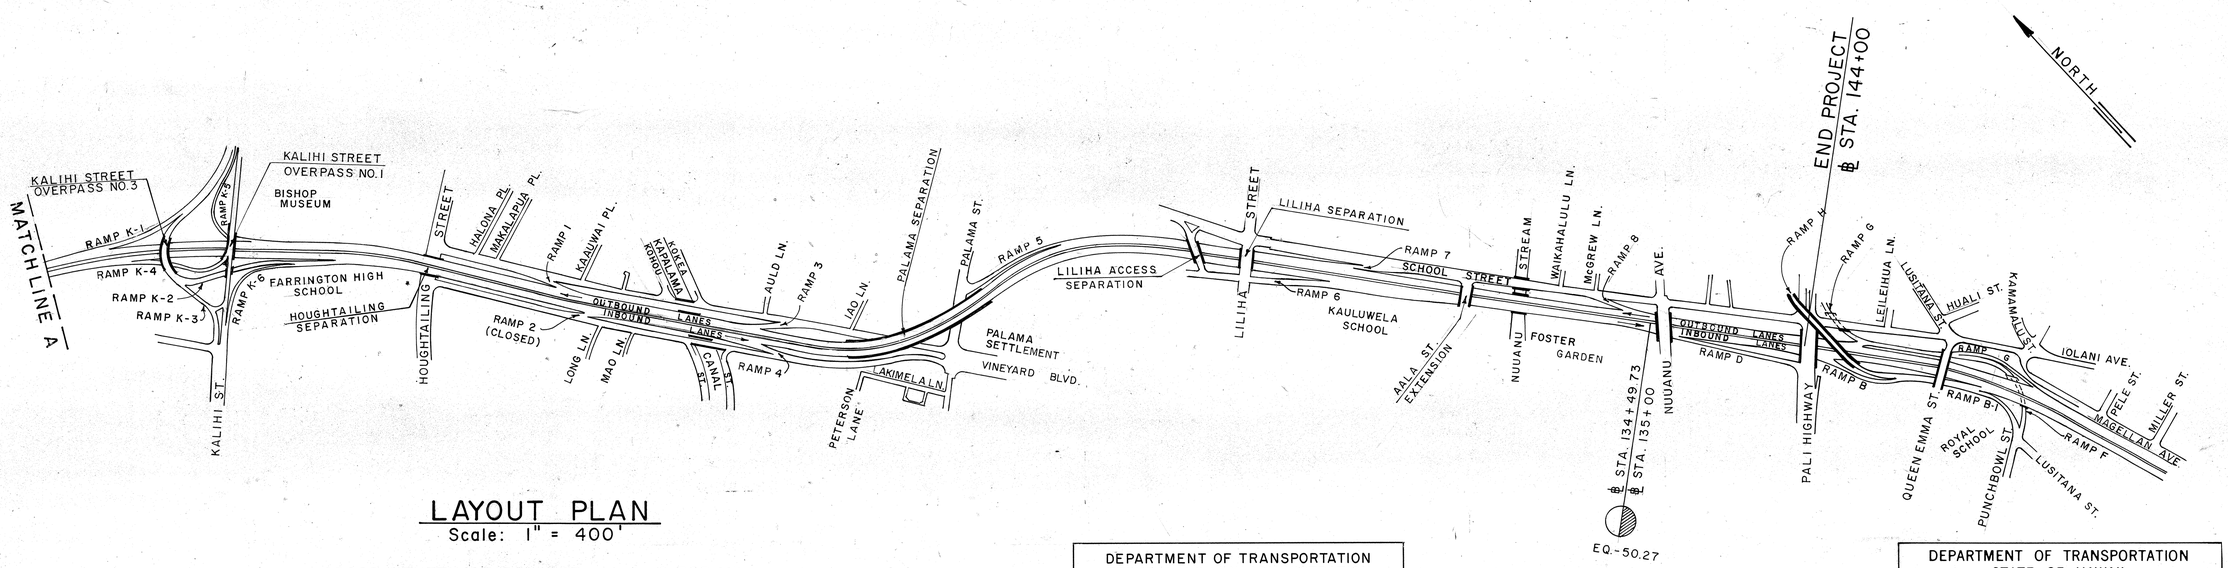

LAYOUT PLAN

Scale: 1" = 400'

GROSS LENGTH OF PROJECT ..... 2.585 Miles

DEPARTMENT OF TRANSPORTATION
FEDERAL HIGHWAY ADMINISTRATION
APPROVED:
H. Yamamoto 5-22-78
DIVISION ADMINISTRATOR — DATE

DEPARTMENT OF TRANSPORTATION
STATE OF HAWAII
APPROVED:
Ryokichi Higashionna 5/18/78
DIR. OF TRANSPORTATION — DATE

DESIGN UNIT "A" — DESIGNED BY
R. MIKAMI — P. S. & E. BY
548-7534 — PHONE
DATE

DD-D-3-7 6/54-2/22