


FED. ROAD DIST. NO.	STATE	FED. AID PROJ. NO.	FISCAL YEAR	SHEET NO.	TOTAL SHEETS
HAWAII	HAW.	<i>I-HI-1(135):14</i>	<i>1982</i>	<i>1</i>	<i>11</i>

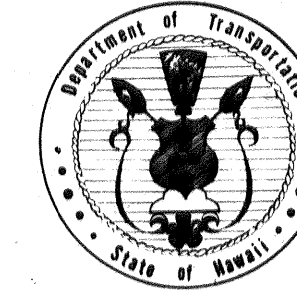


 FEDERAL AID INTERSTATE PROJECTS PREVIOUSLY CONSTRUCTED
OR UNDER CONSTRUCTION

DESIGN ADT (1993)	73,214
DHV	10 %
D.....	65/35
T.....	4%
V.....	60 MPH

11-20-84
DATE

APPROVED: [Signature] 10-29-
DIVISION ADMINISTRATOR DATE

APPROVED: James R. Carras 10/5/8
for DIR. OF TRANSPORTATION DATE

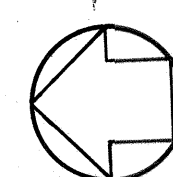

LENGTH OF PROJECT.... 0.265 MILE

8 0 8 16

SCALE IN HUNDRED FEET

Ronaldl Tsuzuki	Ronald Tsuzuki	548-2456	Sept., 1981
DESIGNED BY	P. S. & E. BY	PHONE	DATE