FED. ROAD DIST. NO.	STATE	FED. AID PROJ. NO.	FISCAL YEAR	SHEET NO.	TOTAL SHEETS
HAWAII	HAW.	I-HI-1(86).17	1981	18	207

NOTES:

1. For General Notes see Roadway Construction Plans (Sheet C-2).
2. For Drainage Facilities and Grading see sheet C.0.26.

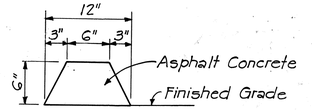

CURB, TYPE 6
N.T.S.

LEGEND:

- Temporary Pavement: 2 ½"-Asphalt Conc. Pavement, Mix No. III; 6"-Aggregate Base; 6"-Aggregate Subbase
- Portable Conc. Guard Rail
- Existing Portable Conc. Guard Rail
- Guard Rail Type 3
- Existing Guard Rail Type 3
- Provide Smooth Riding Connection (See Typical Section on Sheet TS-1)
- (II) Construction Phase II
- ===== Existing Pipe Culvert

DETOUR A PAVEMENT ELEVATIONS			DETOUR C PAVEMENT ELEVATIONS		
DETOUR A STATION	BASELINE	LEFT EDGE OF PAV'T	DETOUR C STATION	RIGHT EDGE OF PAV'T	LEFT EDGE OF PAV'T
10+00	—	—	10+00	—	—
+25	—	—	+25	14.4	—
+50	14.4	14.6	+50	13.3	—
+75	13.2	13.4	+75	—	—
11+00	12.0	12.2	11+00	12.6	—
+25	10.9	11.0	+25	11.8	14.5
+50	9.8	9.8	+50	10.6	13.8
+75	8.9	8.6	+75	12.6	12.8
12+00	8.2	7.7	12+00	11.5	11.7
+25	7.7	7.0	+25	10.3	10.5
+50	7.3	6.4	+50	9.2	9.2
+75	7.1	6.2	+75	—	8.1
13+00	7.0	6.1	13+00	—	8.0
+25	6.9	6.1	+25	—	—
+50	—	6.2			
+75	—	6.3			
14+00	—	6.3			

DATE	REVISION
8/10/83 R	Revised Alignment & Pavement Elevations of Detour A.

STATE OF HAWAII
DEPARTMENT OF TRANSPORTATION
LAND TRANSPORTATION FACILITIES DIVISION

DETOUR CONSTRUCTION

INTERSTATE ROUTE H-1
PROJECT NO. I-HI-1(86).17

SCALE: 1" = 50' DATE: 6/15/81

SHEET No. C-1 OF 8 SHEETS

WERNER BEUGGERT
REGISTERED PROFESSIONAL ENGINEER
No. 3383-E
HAWAII, U.S.A.

THIS WORK WAS PREPARED BY ME OR UNDER MY SUPERVISION.

SURVEY PLOTTED BY: DRAWN BY: TRACED BY: DESIGNED BY: QUANTITIES BY: CHECKED BY: DATE:
ORIGINAL PLAN
NOTE BOOK No.

C.0.18

N5B 4/1/83